


general notes

- 1. IT SHALL BE THE RESPONSIBILITY OF THE CONTRACTOR OR PERMITEE TO CONTACT "UNDERGROUND SERVICE ALERT U.S.A." TOLL FREE AT 1-800-227-2600 FORTY-EIGHT (48) HOURS PRIOR TO START OF CONSTRUCTION, FOR LOCATION OF POWER, TELEPHONE, OIL AND NATURAL GAS UNDERGROUND FACILITIES. CONTRACTOR OR PERMITEE SHALL ALSO CONTACT THE APPROPRIATE AGENCY FOR THE LOCATION OF CABLE T.V., WATER, SEWER, DRAINAGE OR UNDERGROUND FACILITIES.
- 2. THE CONTRACTOR SHALL POSSESS A CLASS "A or C34" LICENSE AT THE TIME THE CONTRACT IS AWARDED.

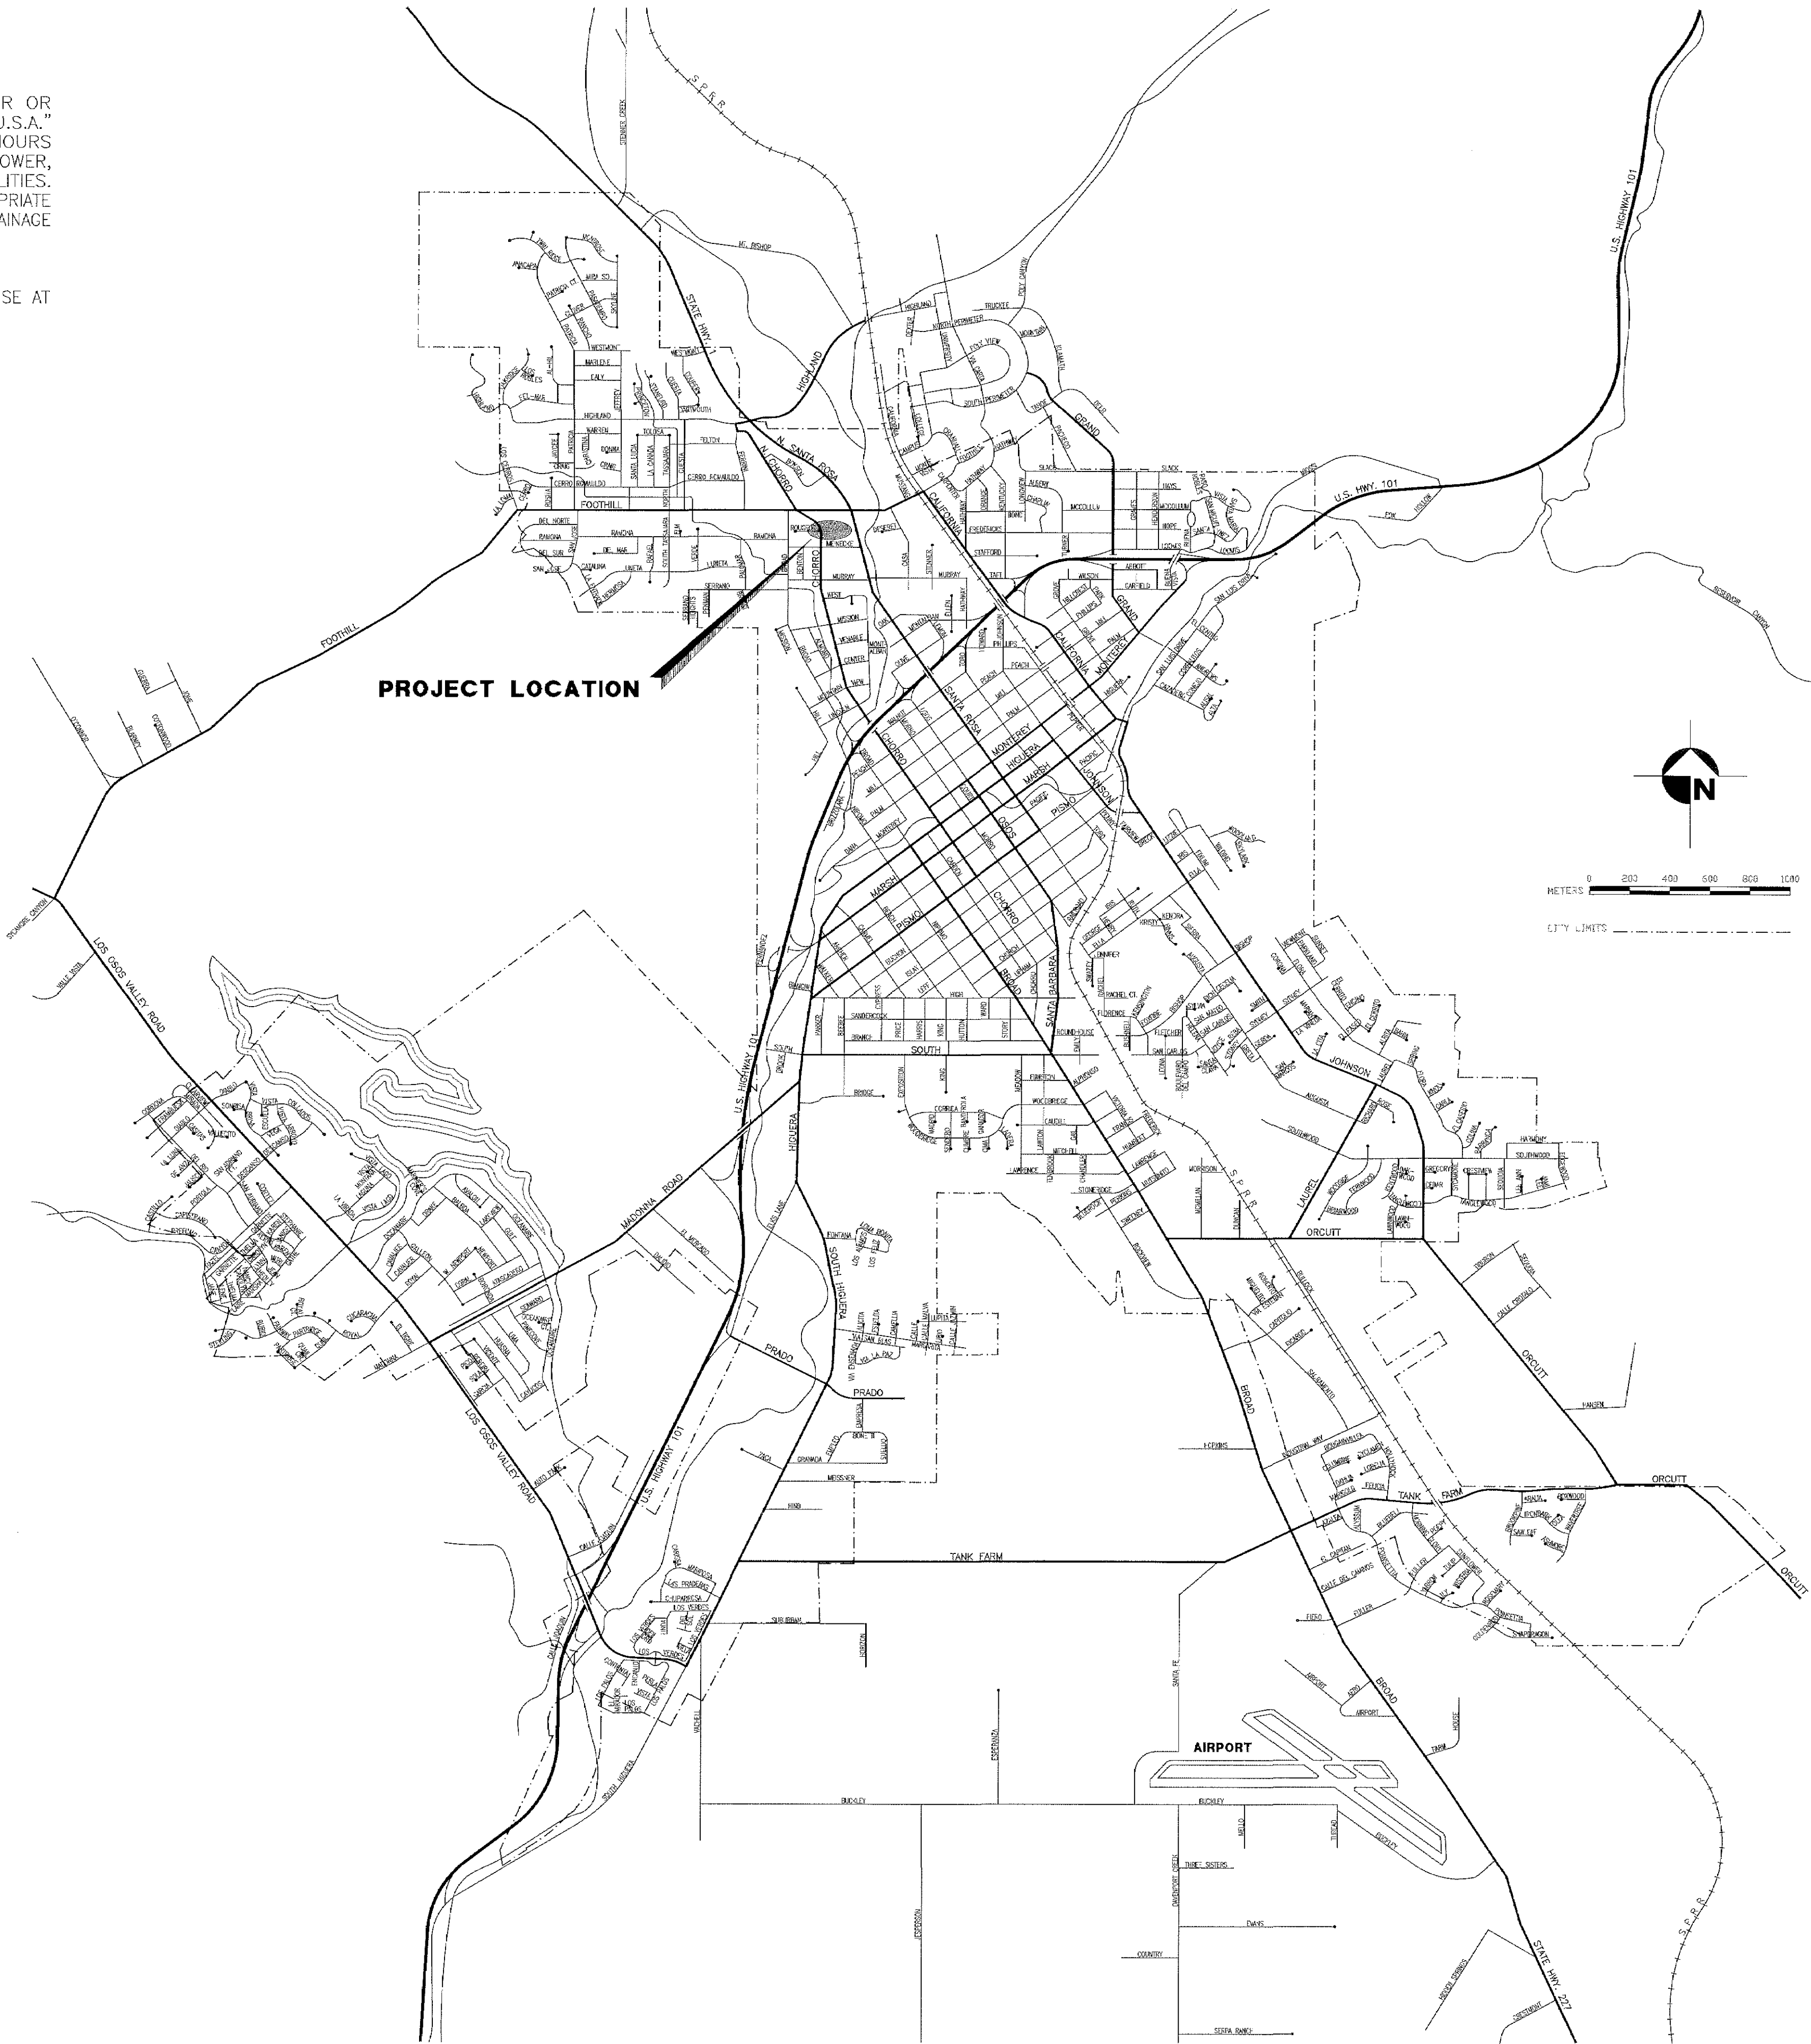

index to plans

sheet no.	description
1.	Project Loctions & Notes
2.	Rougeot Plan & Profile



WATER & STORMDRAIN
IMPROVEMENT PROJECT

ROUGEOT & CHORRO

RECORD DRAWING

DATE: July 19, 1999 BY: CC






SPECIFICATION NO. 98-78

APPROVED BY

Wayne A. Peterson
City Engineer
R.C.E. 18598




DATE
OCT. 1997
FILE NO./LOCATION
0010/B
SHEET
1 OF 2

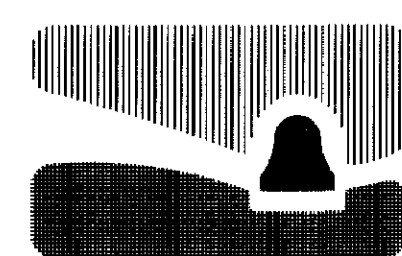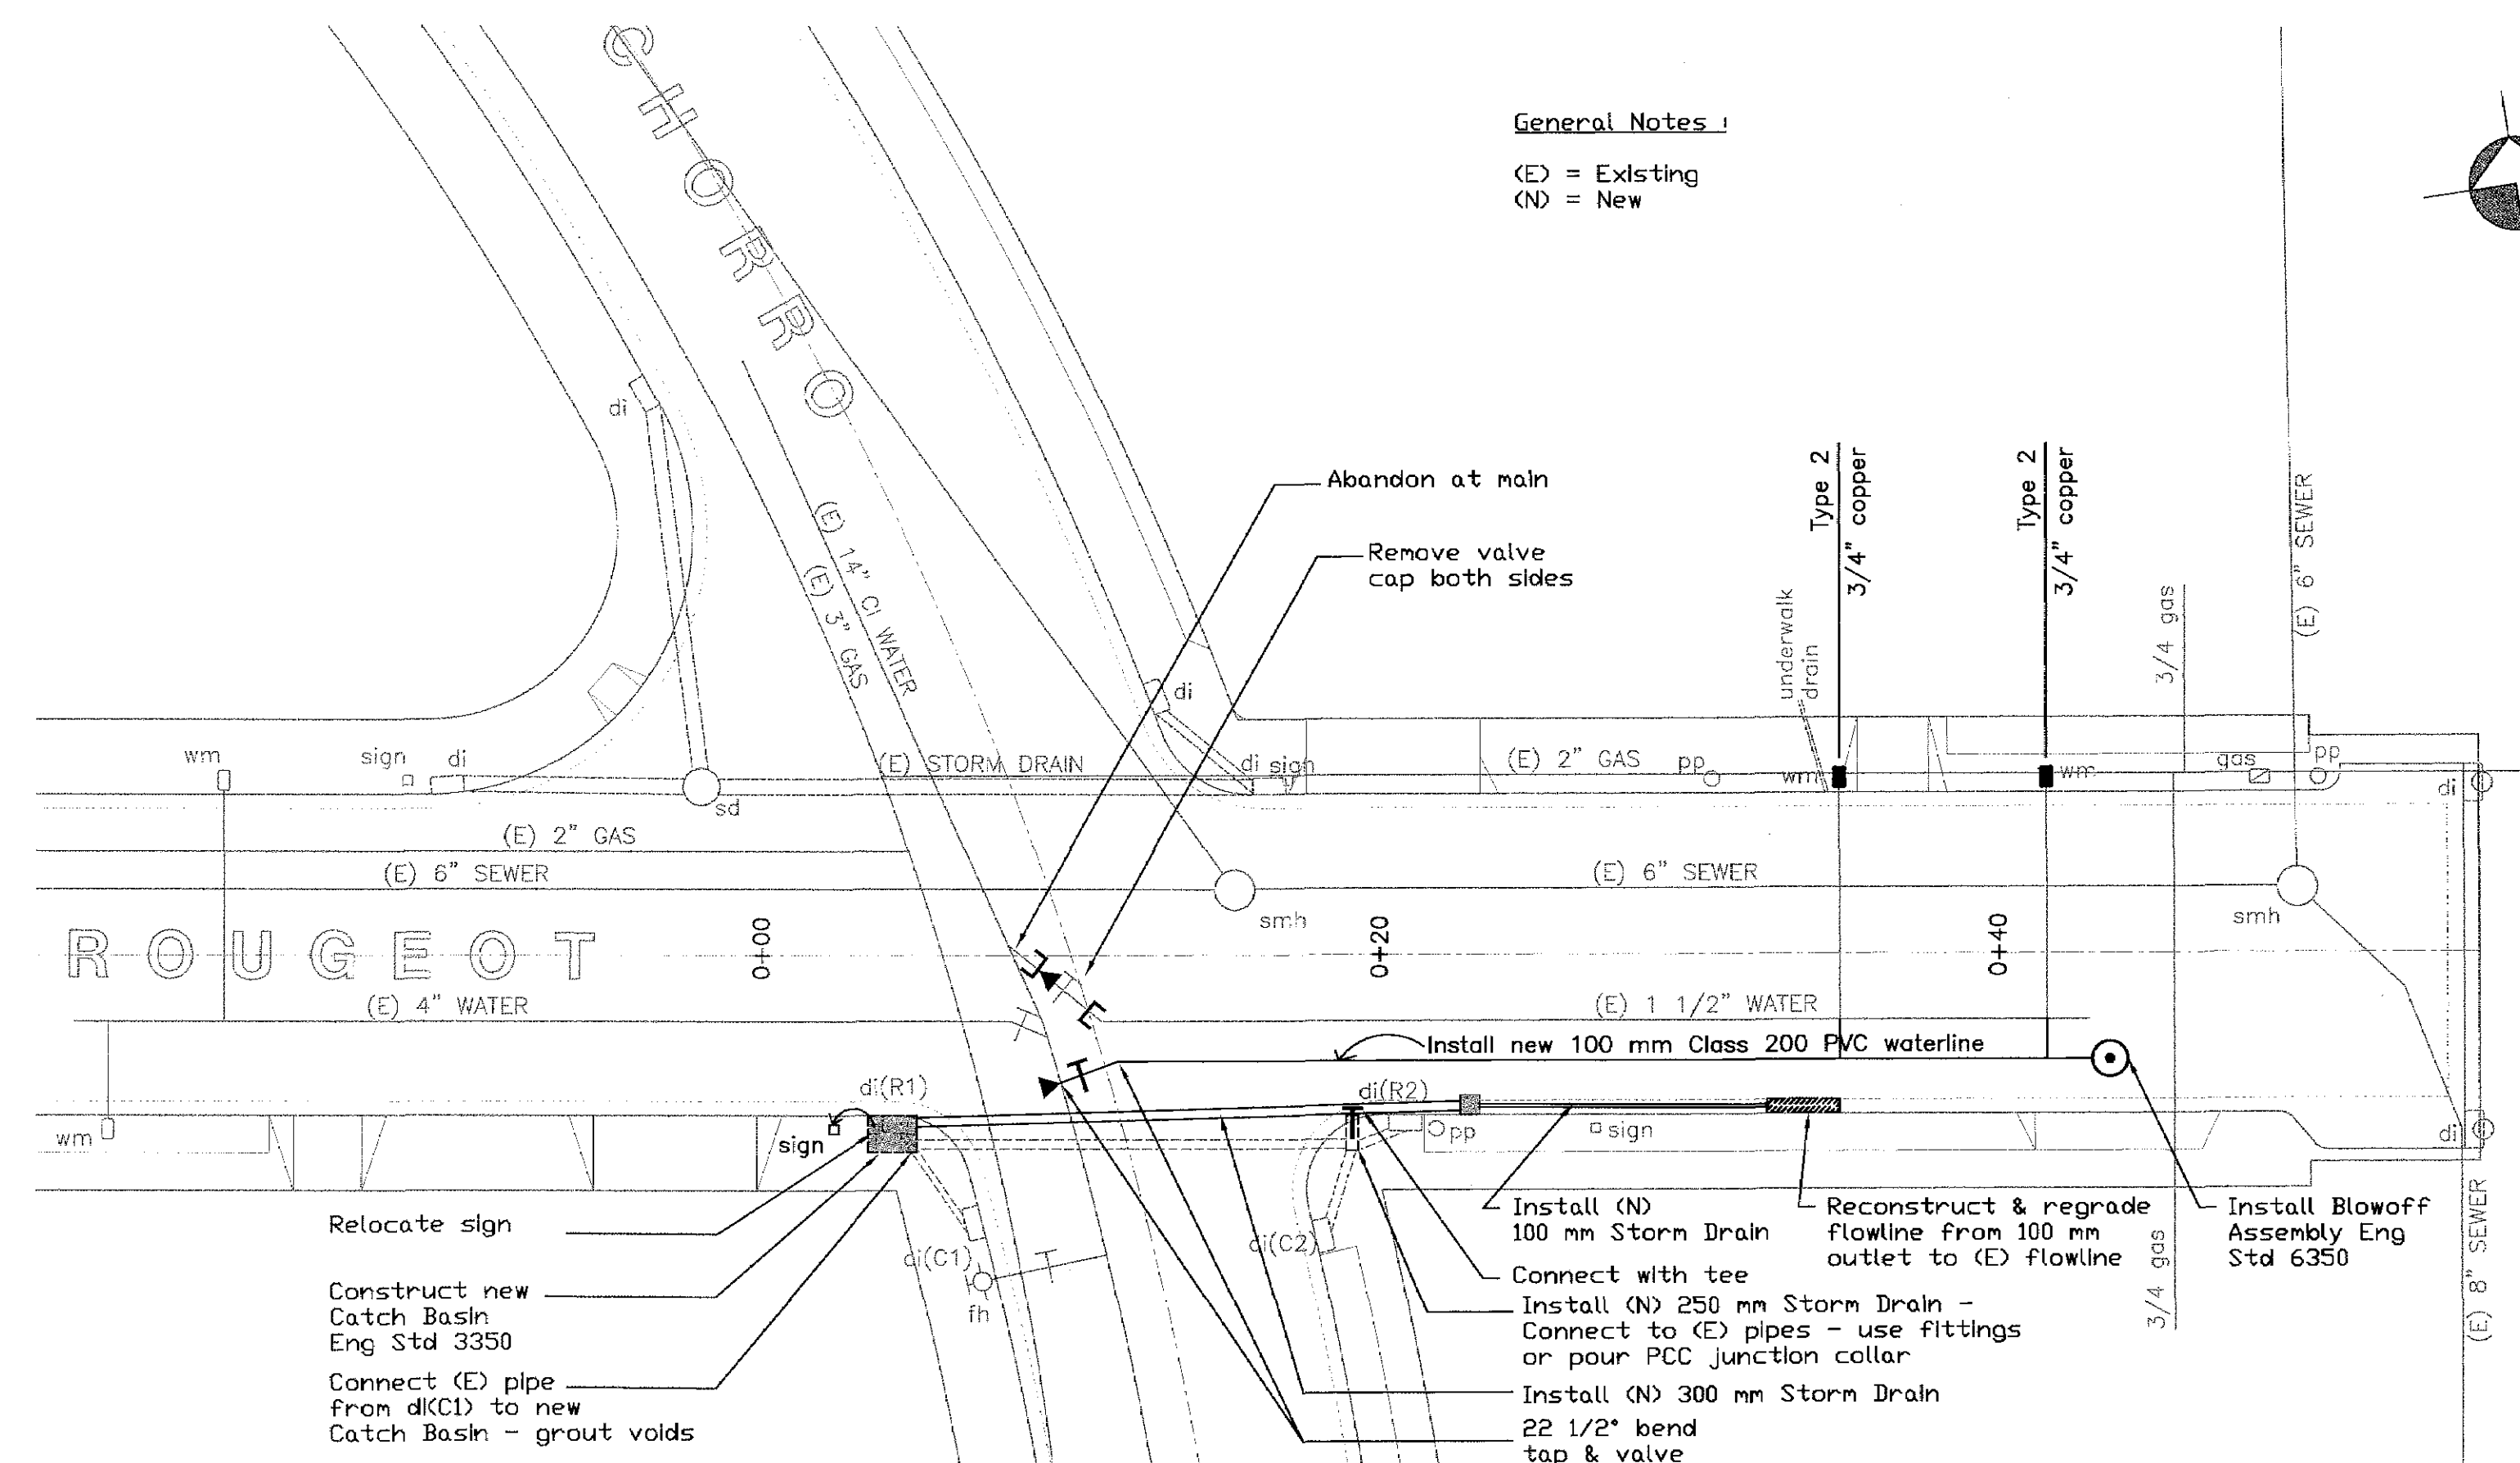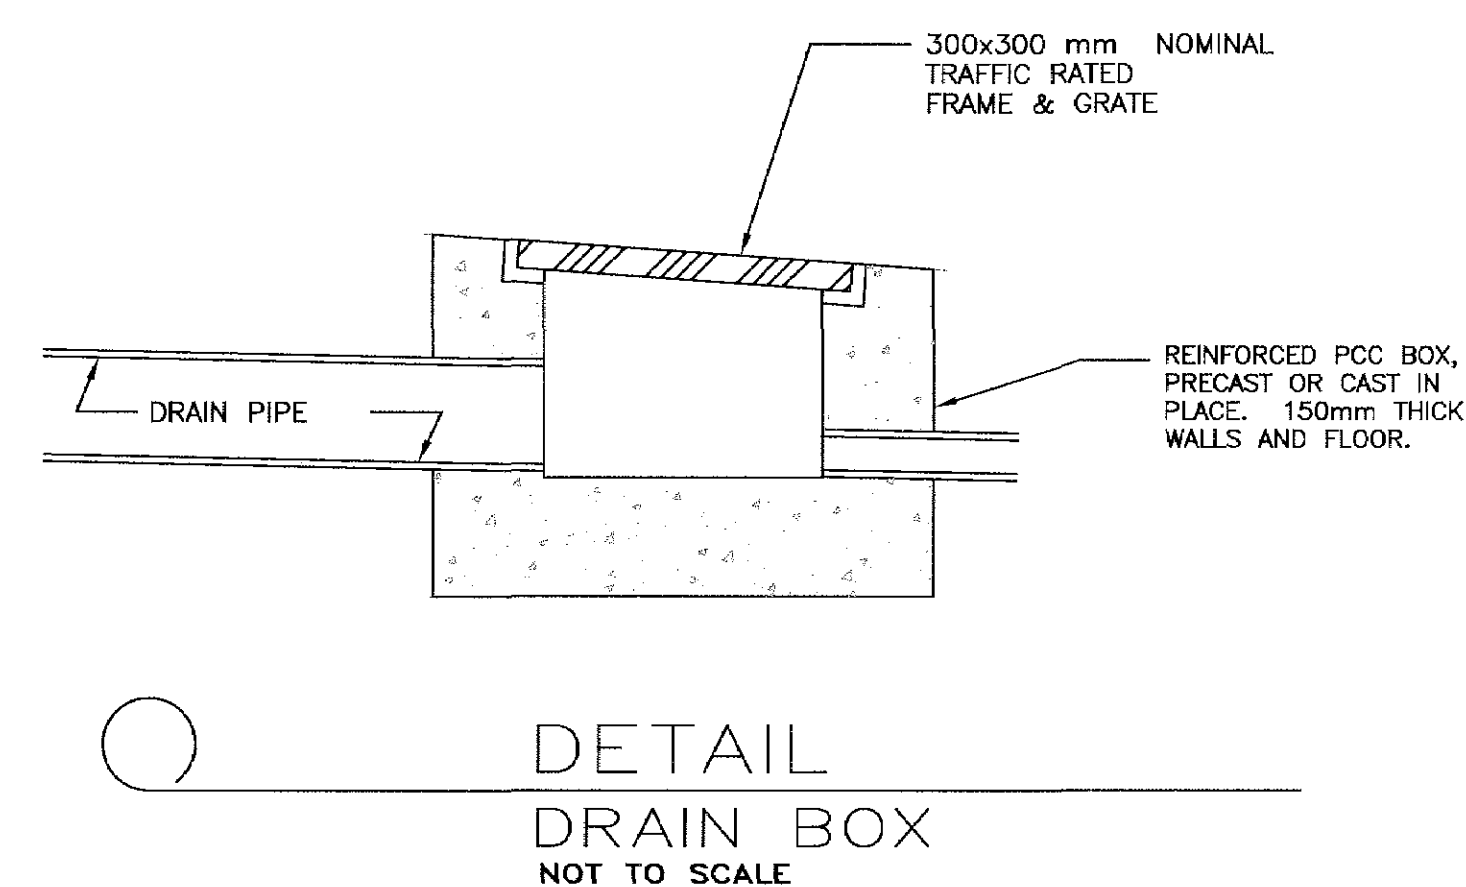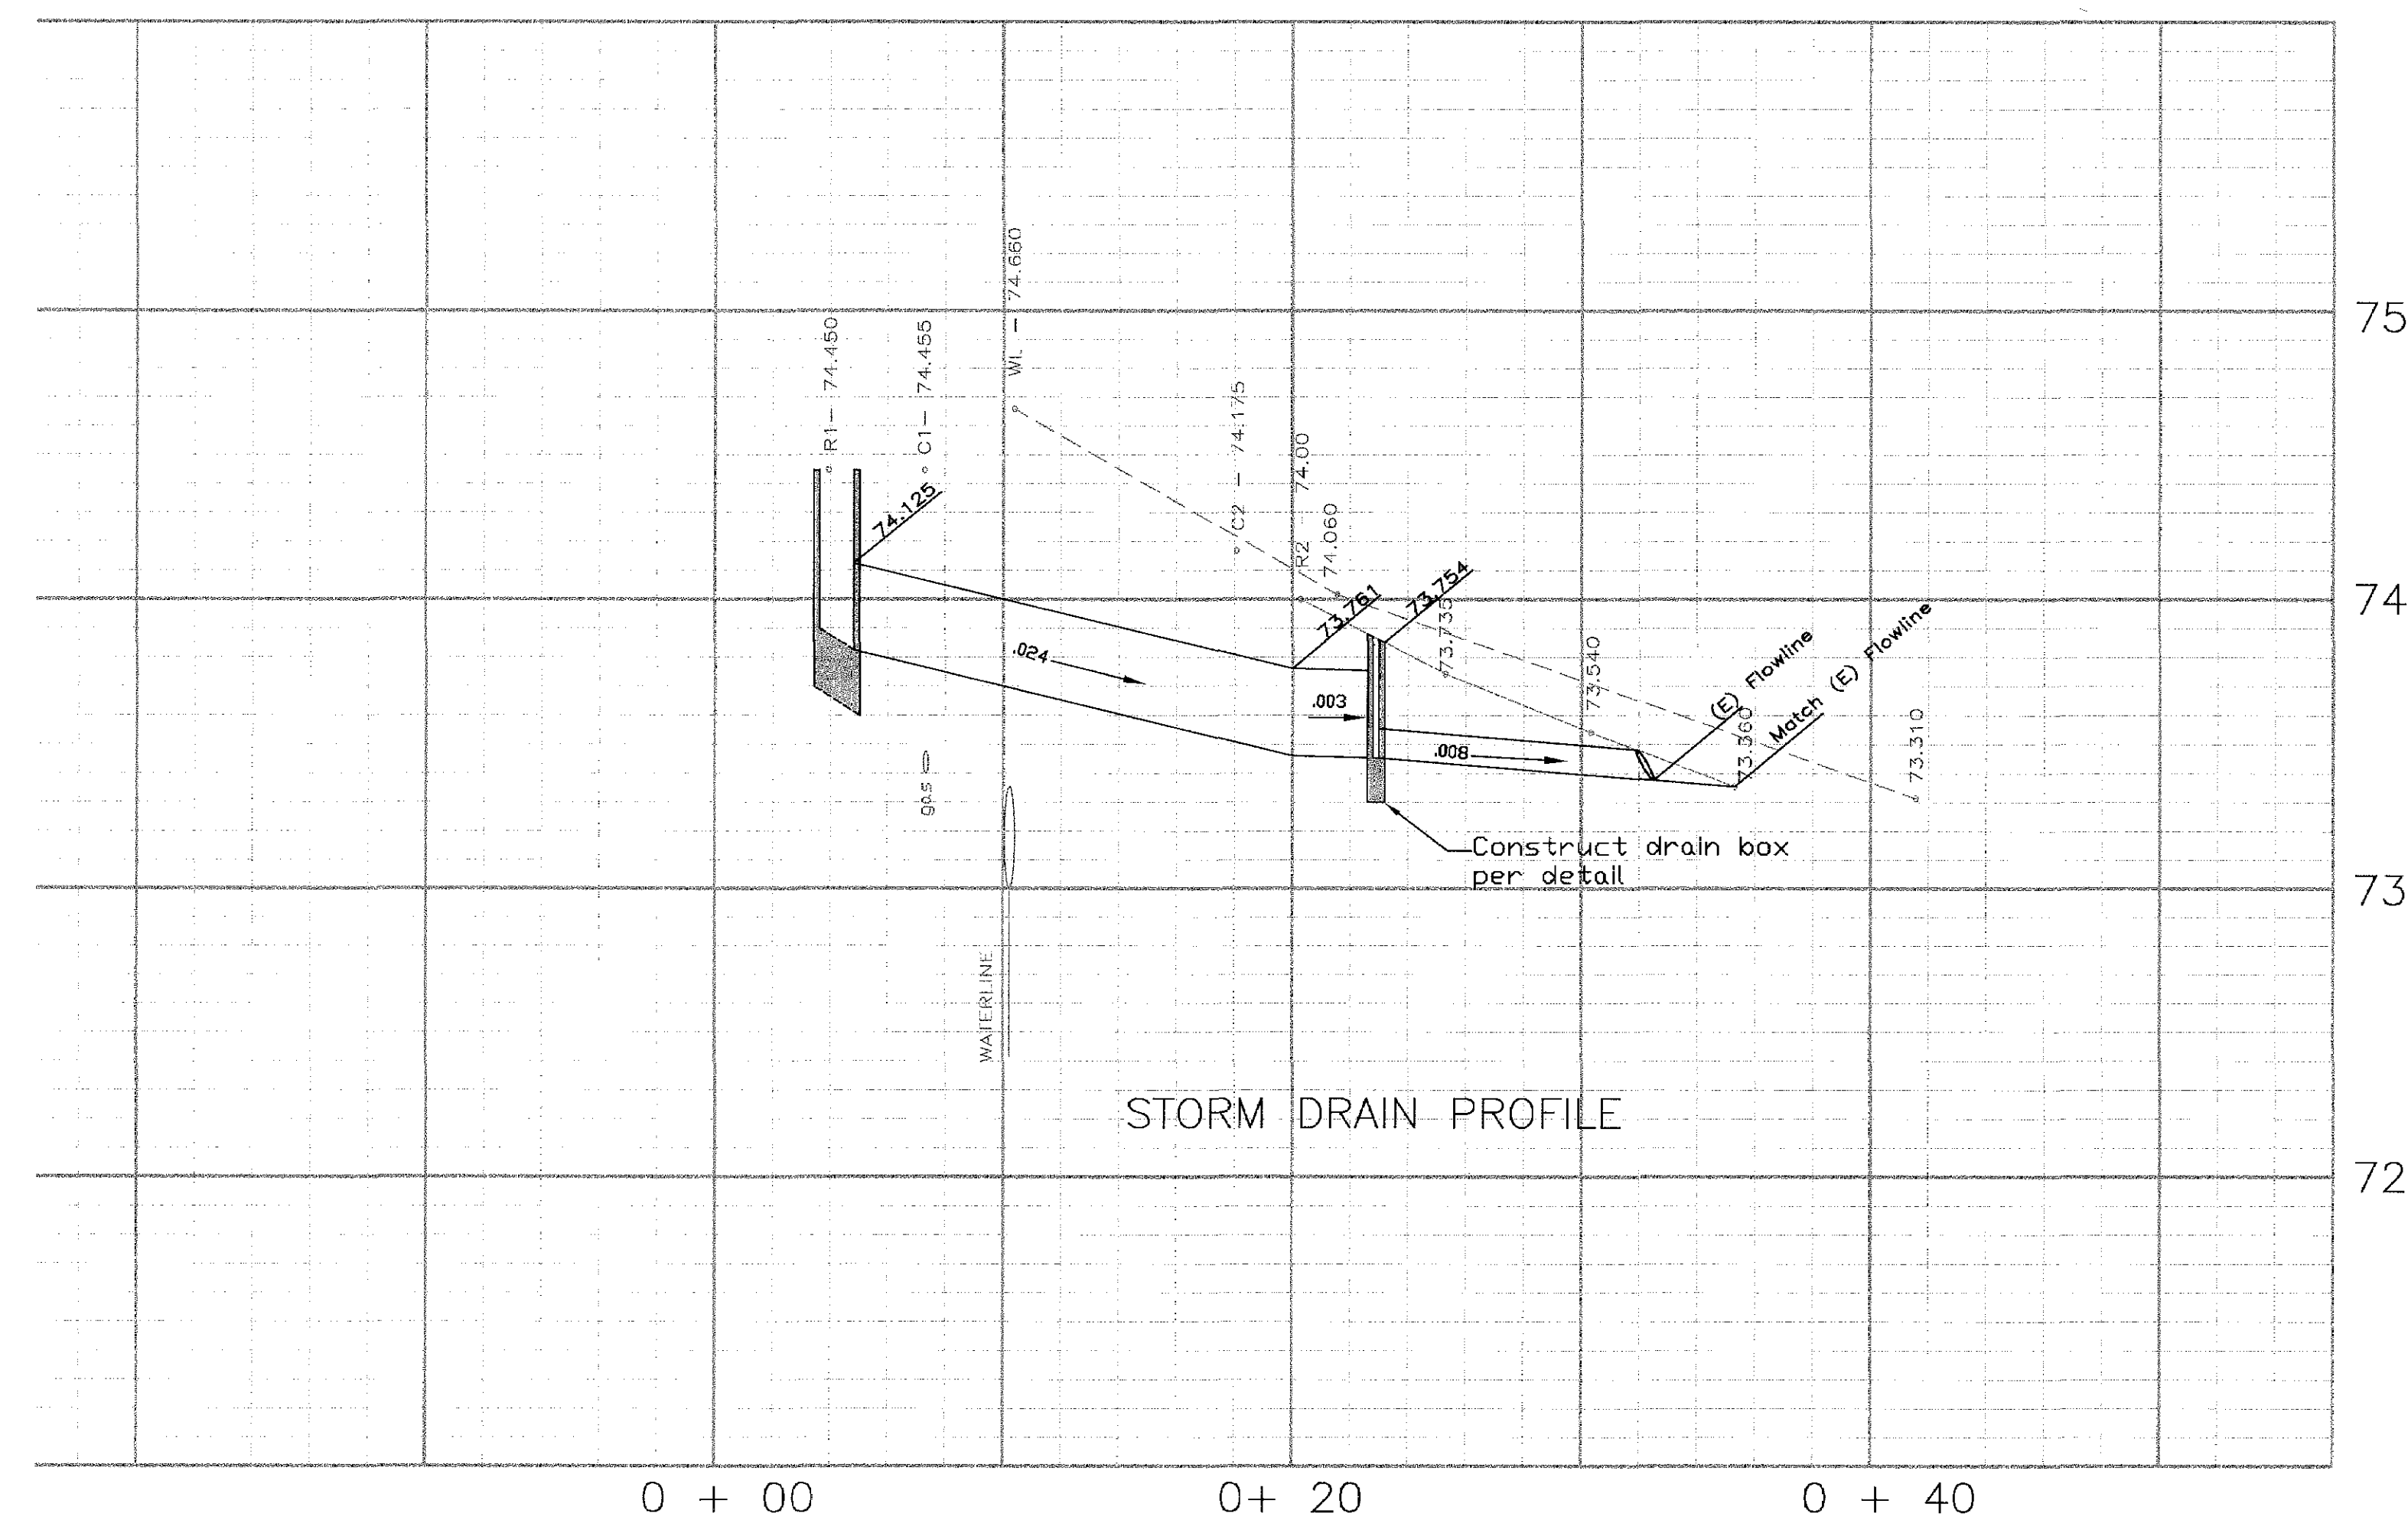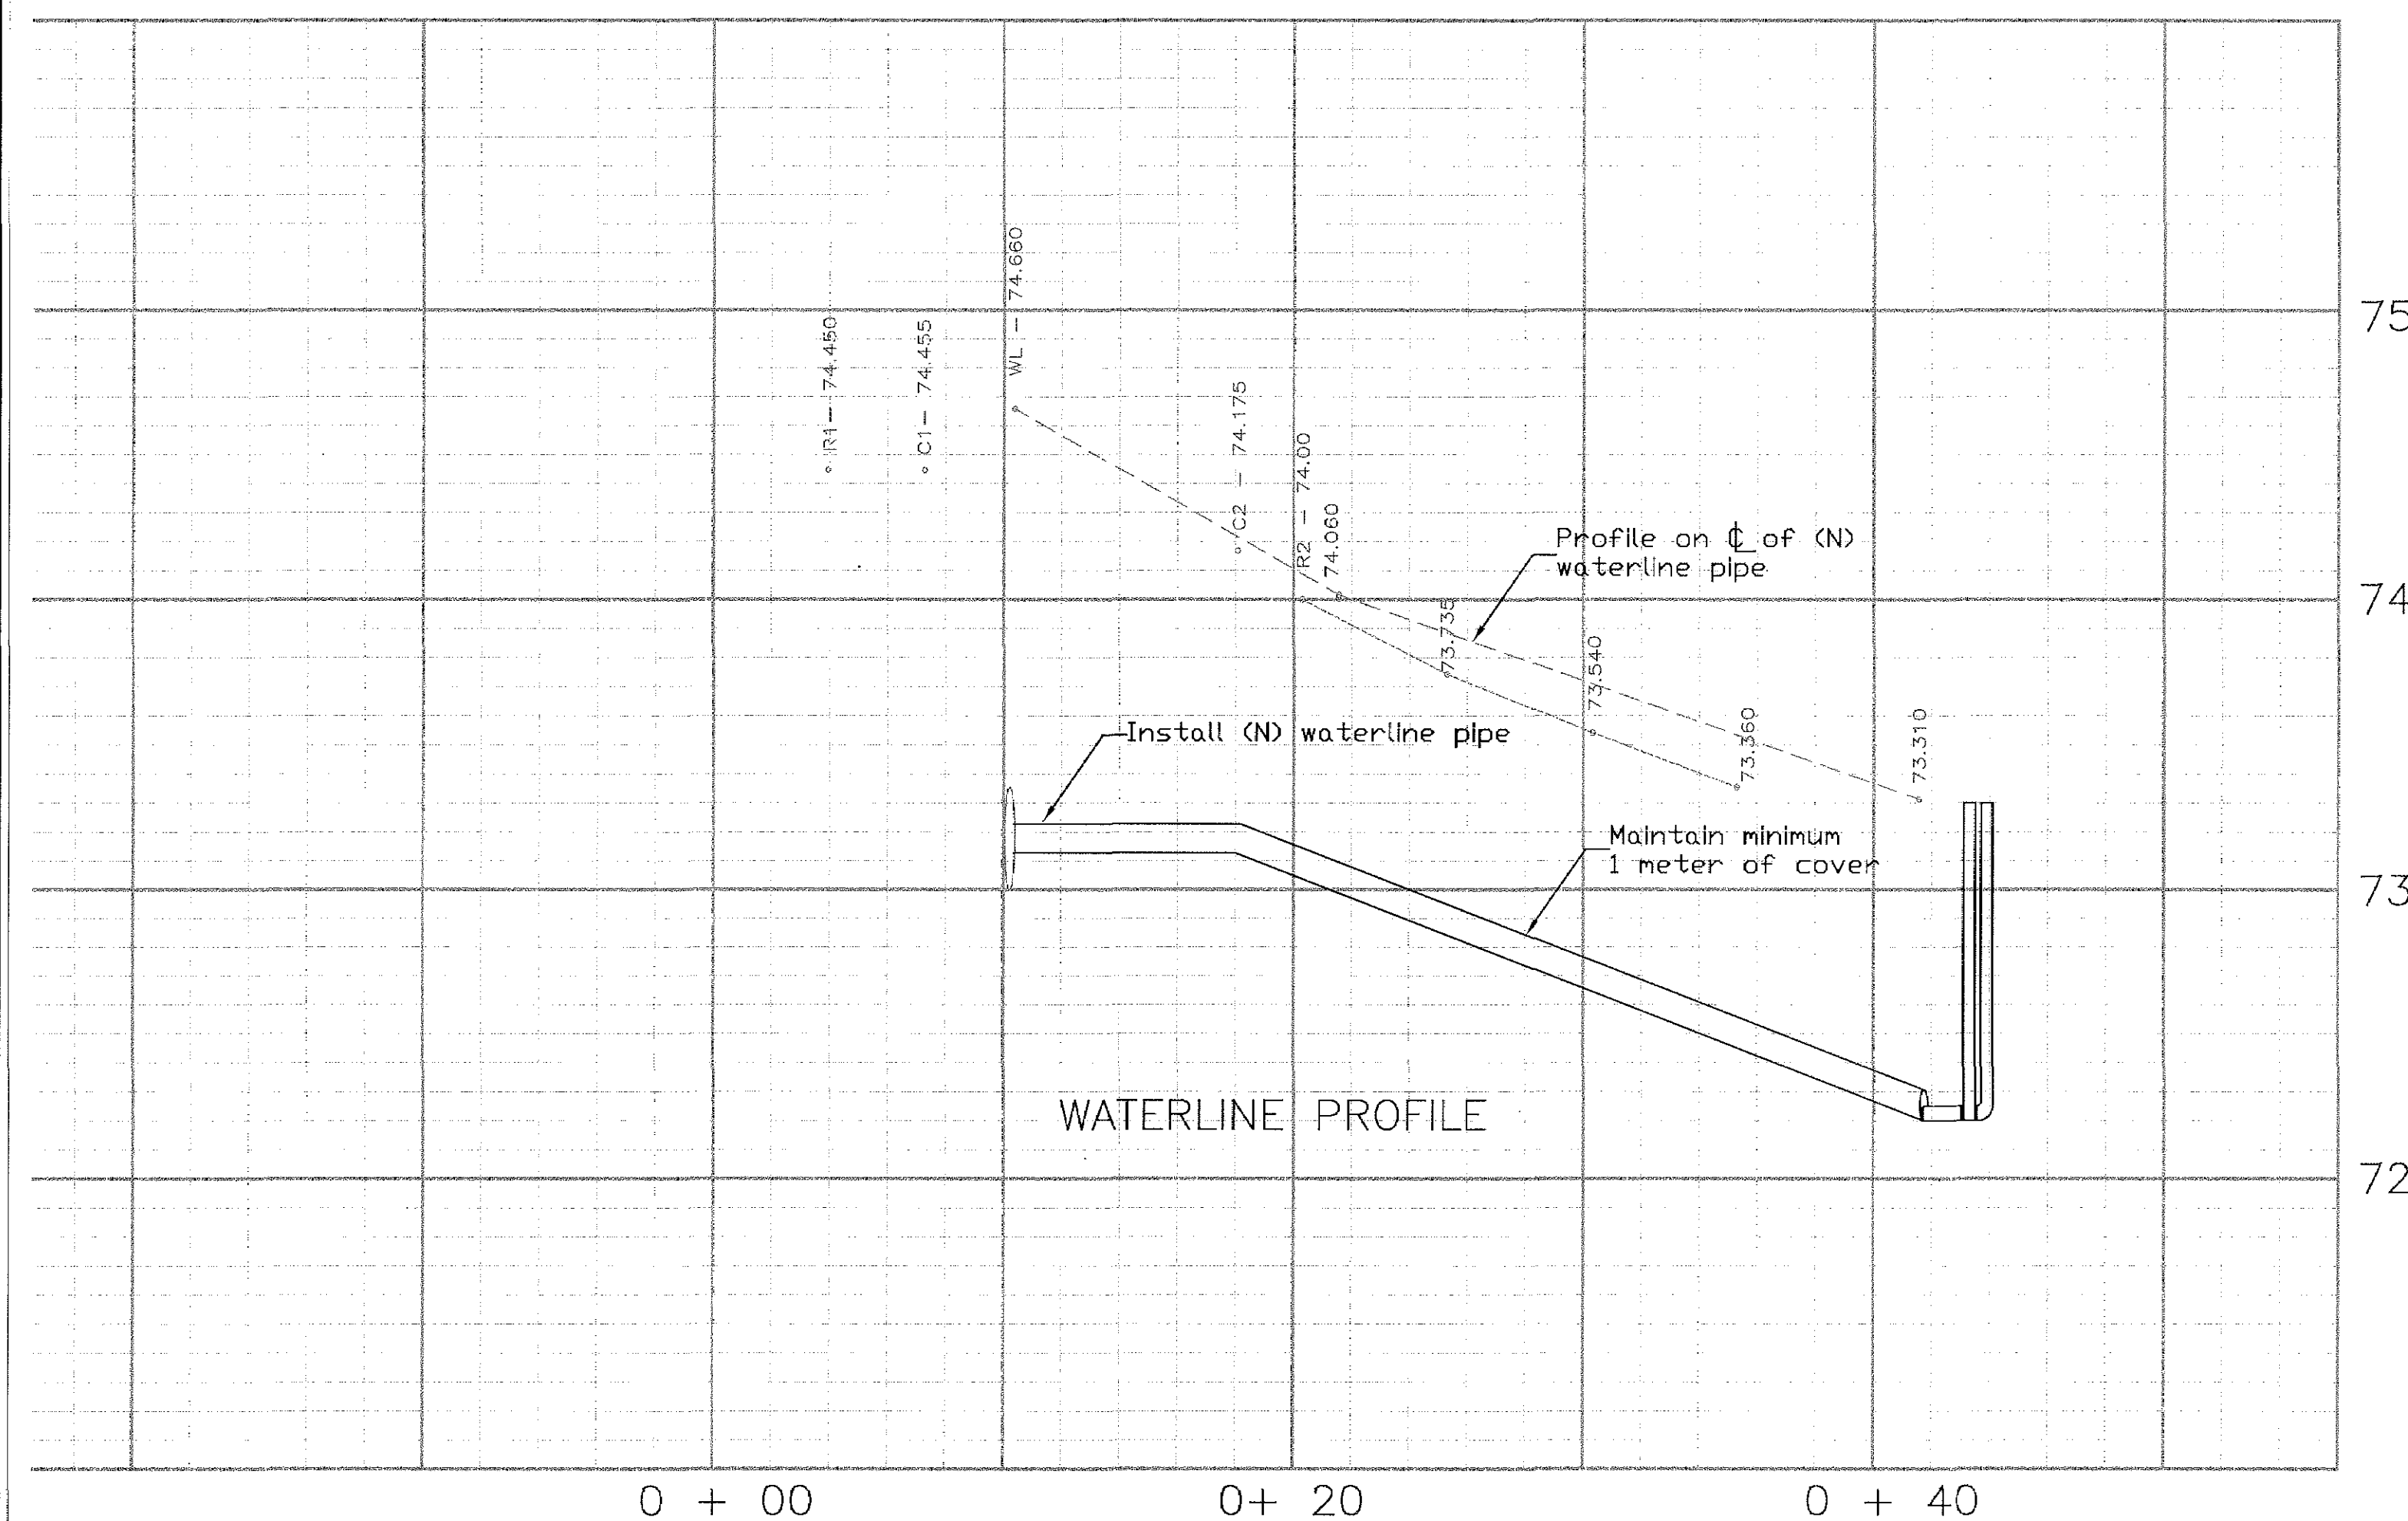[illegible]

city of san luis obispo

WATER & STORMDRAIN IMPROVEMENT PROJECT:
ROUGEOT E/O CHORRO




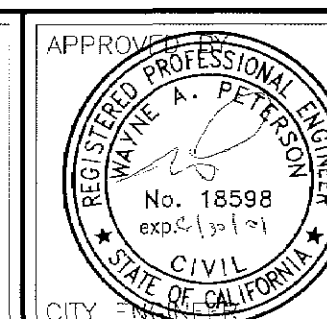


DATE	OCT 97	
SCALE	1:200H	1:20V
DESIGNED BY	BL	
DRAWN BY	JDL,SR	
CHECKED BY	WAP	
APPROVED BY		

ROUGEOT
PLAN, PROFILE


SPECIFICATION NO.	98-78
FILE NO./LOCATION	0010 / B
SHEET	2 OF 2

NATURE / STATUS OF PLANS	BY	DATE

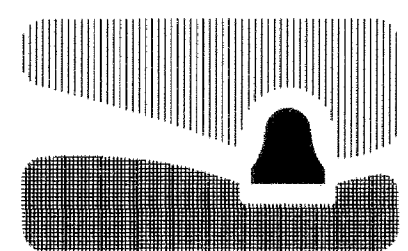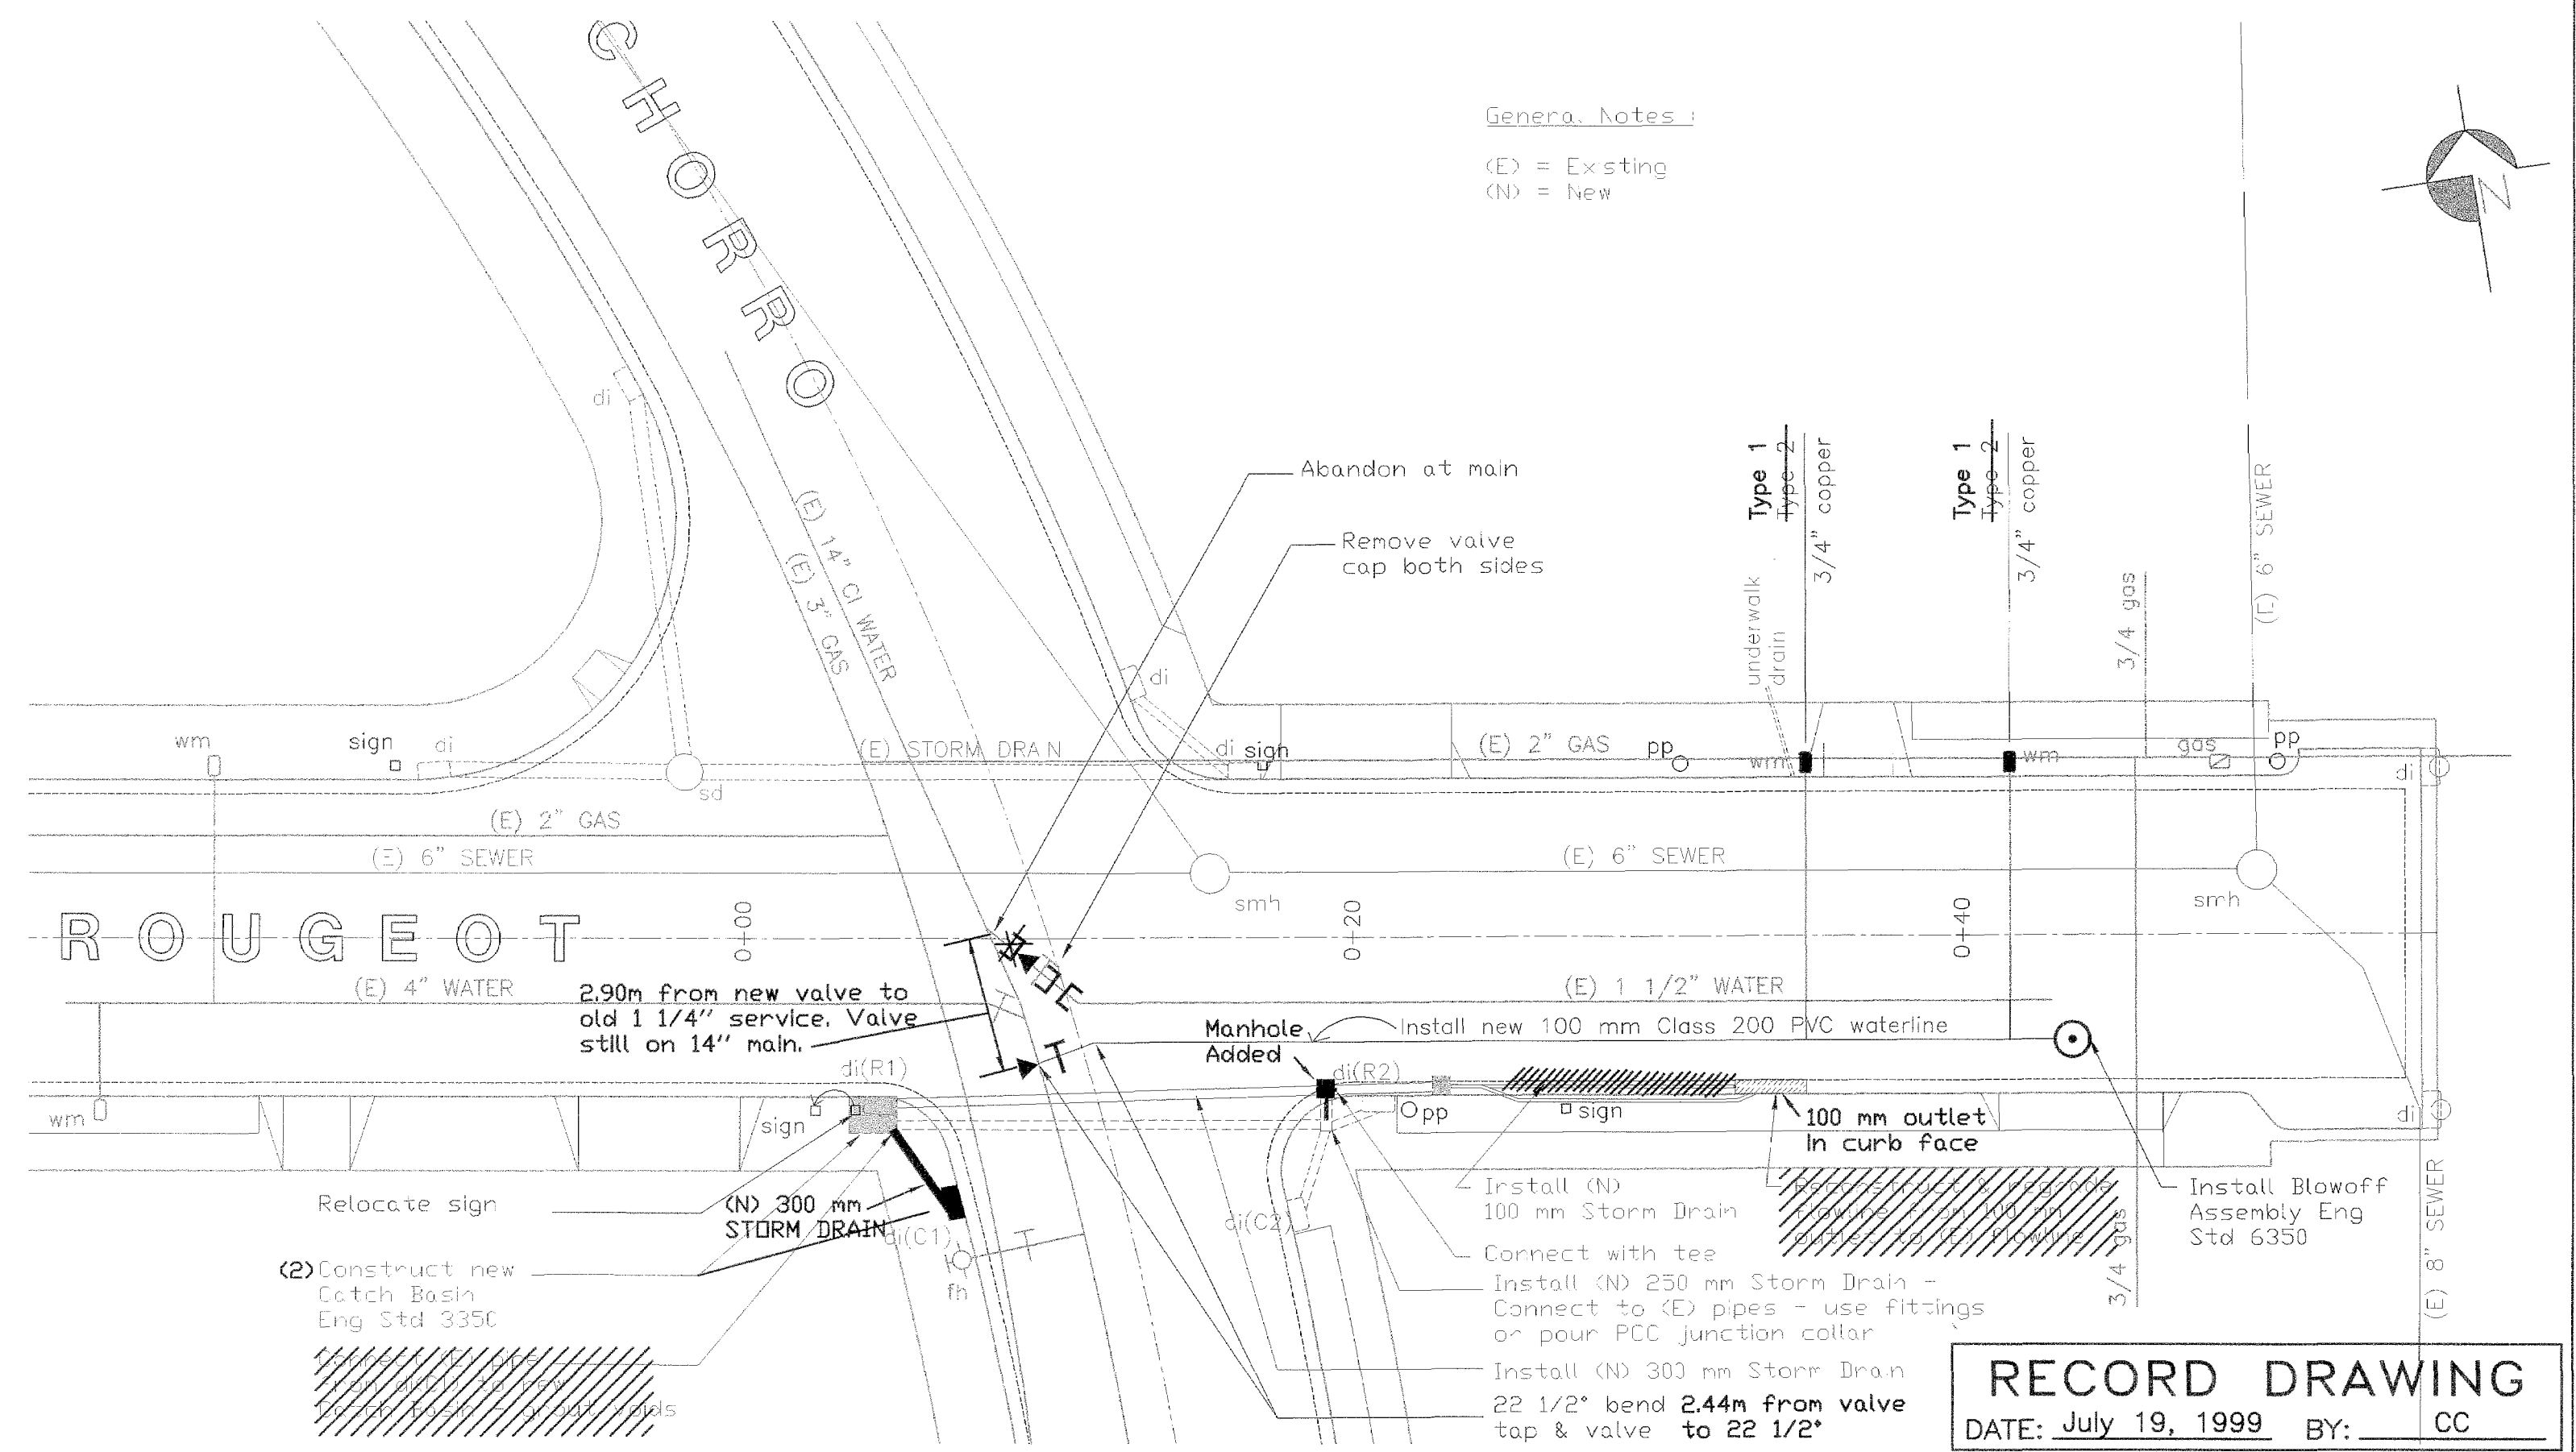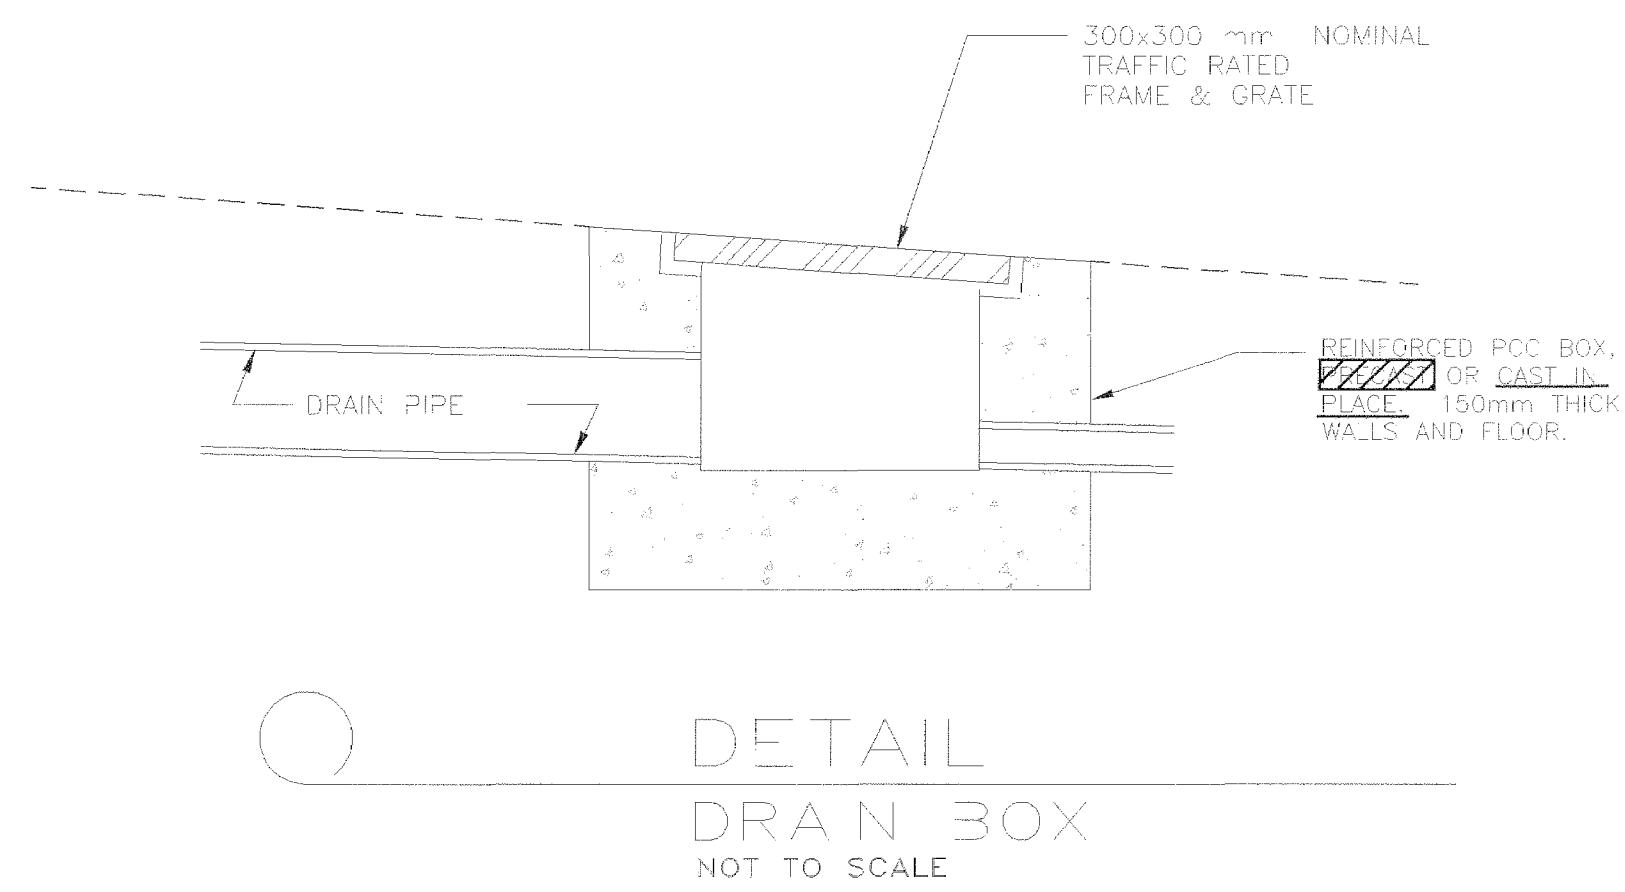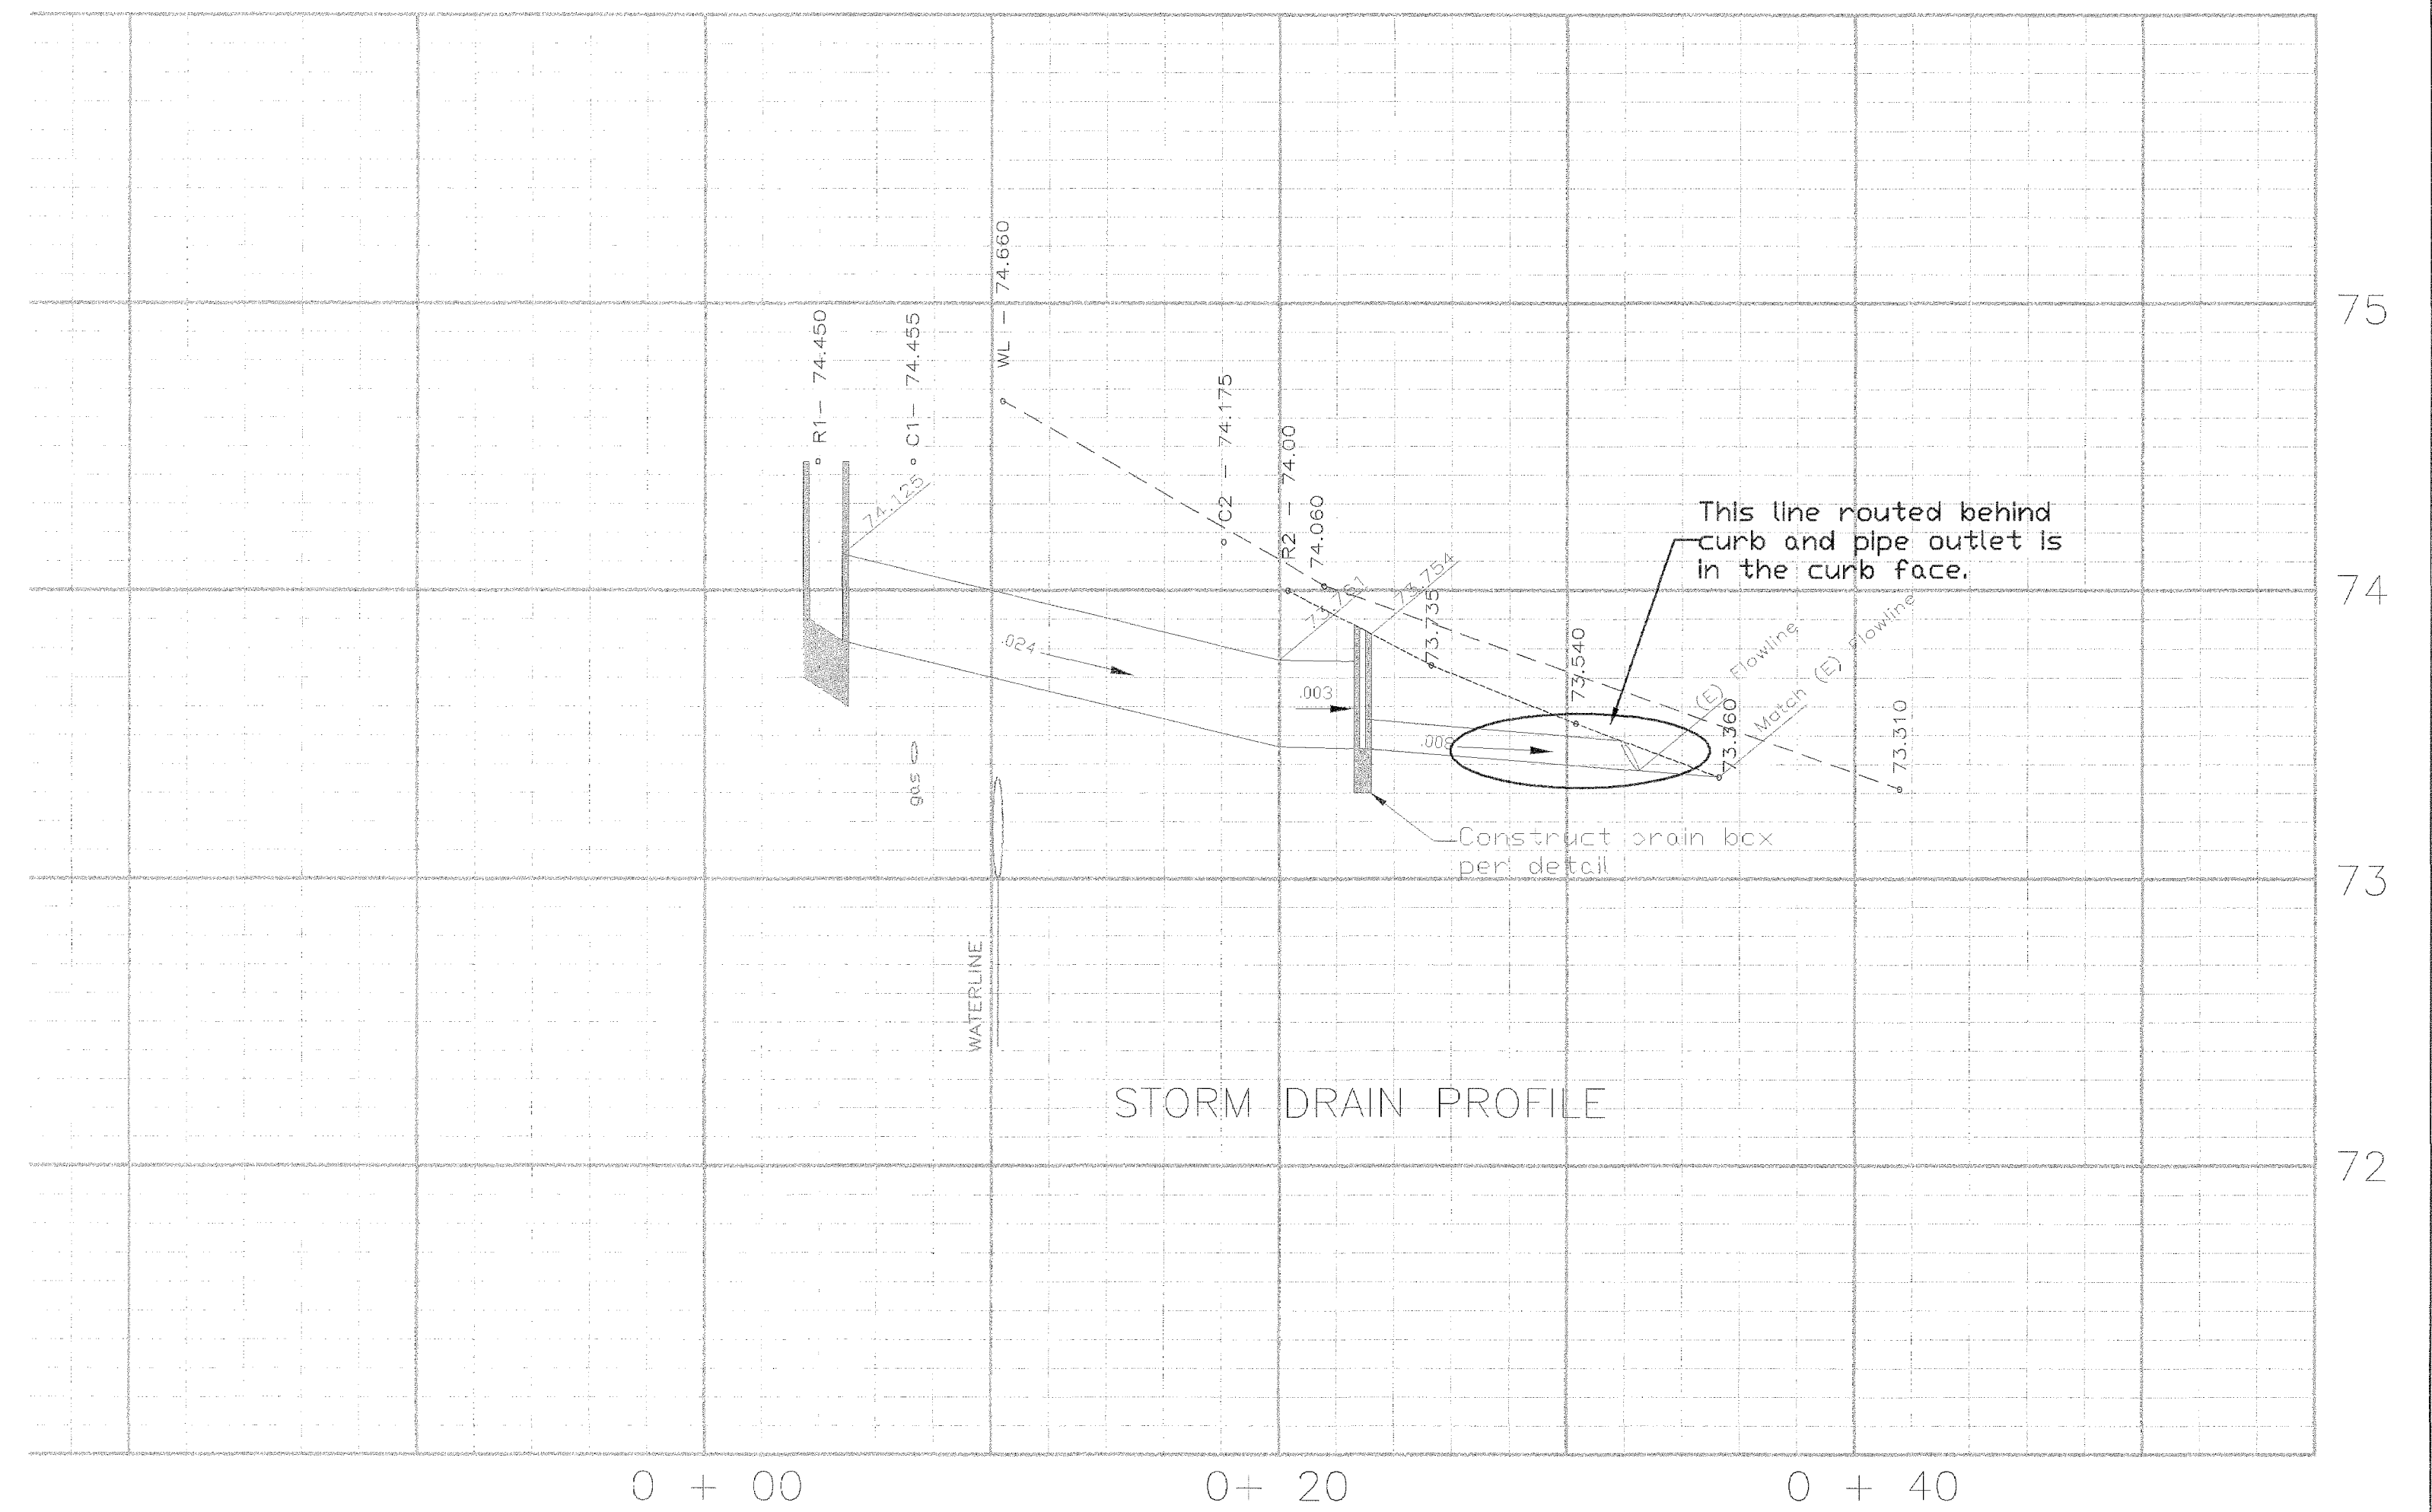

city of san luis obispo

WATER & STORMDRAIN IMPROVEMENT PROJECT:
ROUGEOT E/O CHORRO

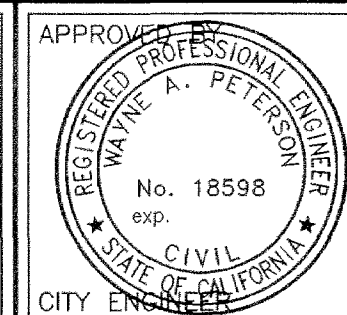

DATE	OCT 97
SCALE	1:200H 1:20V
DESIGNED BY	BL
DRAWN BY	JDL,SR
CHECKED BY	WAP
APPROVED BY	
UTILITIES DEPARTMENT	

ROUGEOT
PLAN, PROFILE

SPECIFICATION NO.
 98-78
 E NO./LOCATION
 0010 / B
 SHEET
 2 OF 2