



FIRST FLOOR PLAN

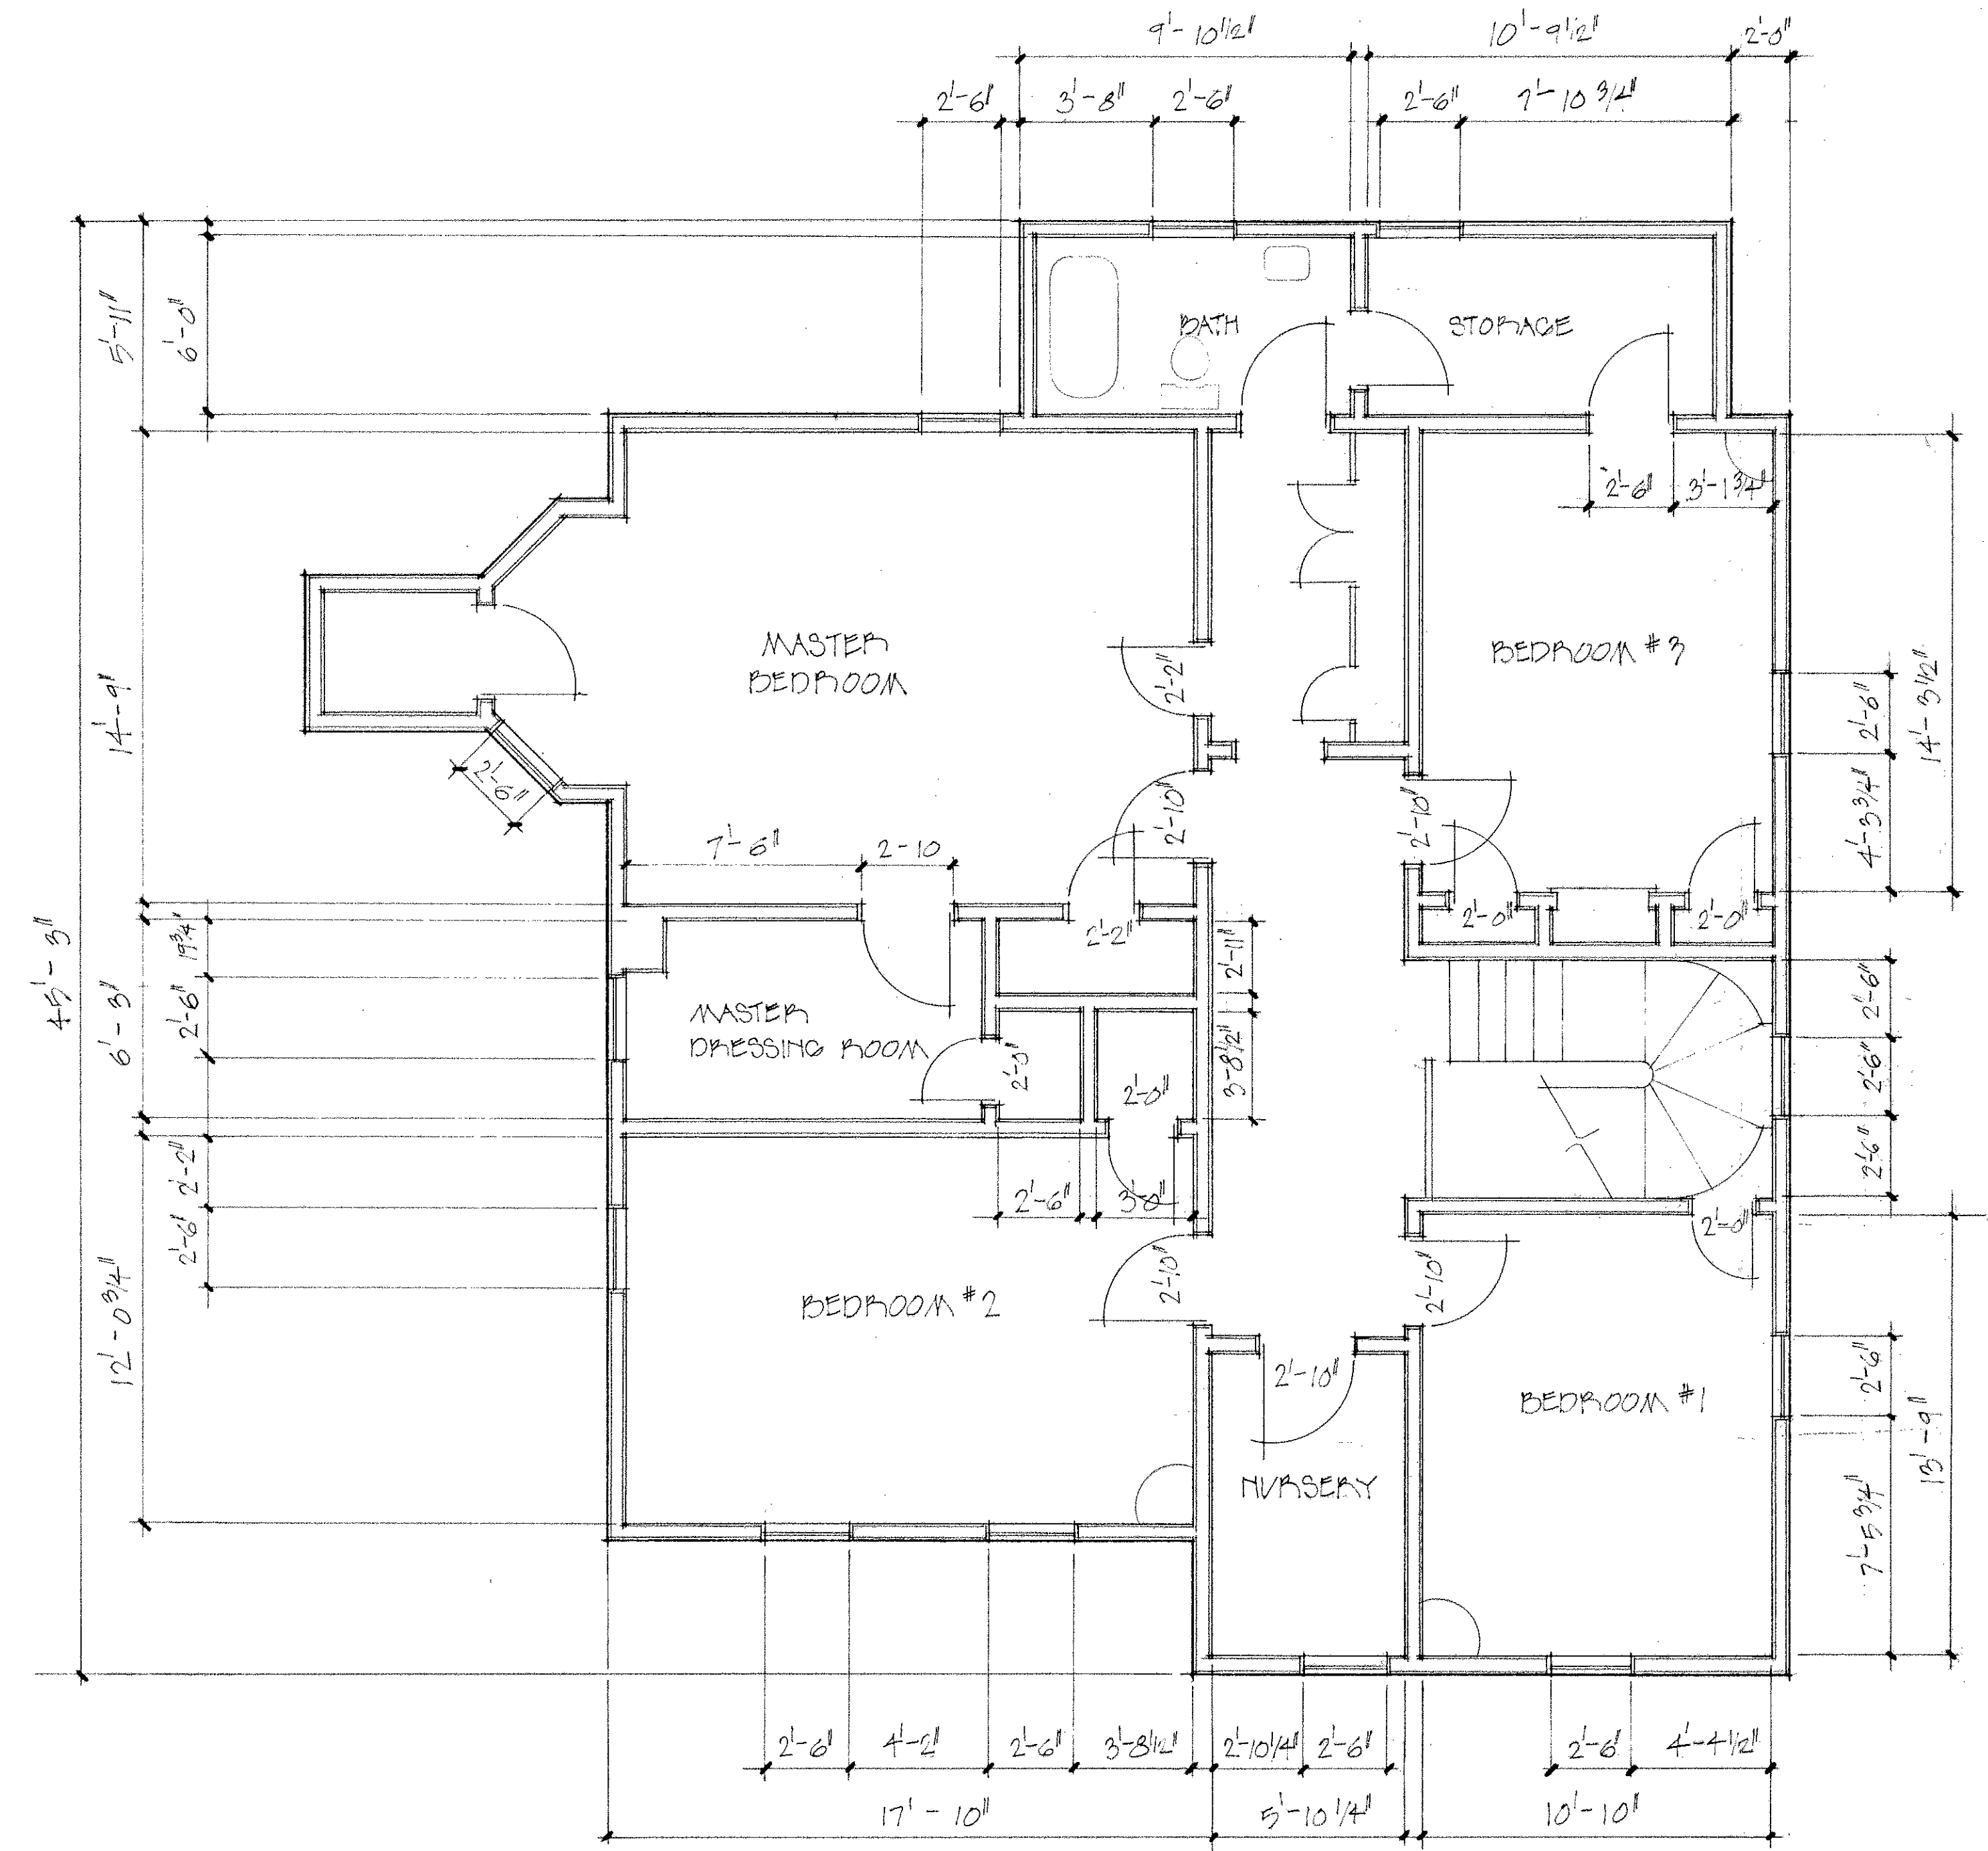

SECOND FLOOR PLAN

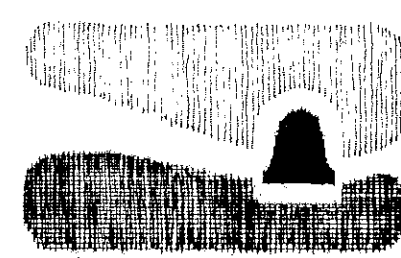

city of san luis obispo

JACK MANSION SAN LUIS OBISPO, CALIFORNIA


REVISIONS	BY	APPROVED	DATE

DRAWN BY	DATE
CHECKED BY	SCALE
REF.	
APPROVED	
ENGINEER NO.	


AS - BUILT DRAWINGS
CITY PLAN NO.



FRONT ELEVATION

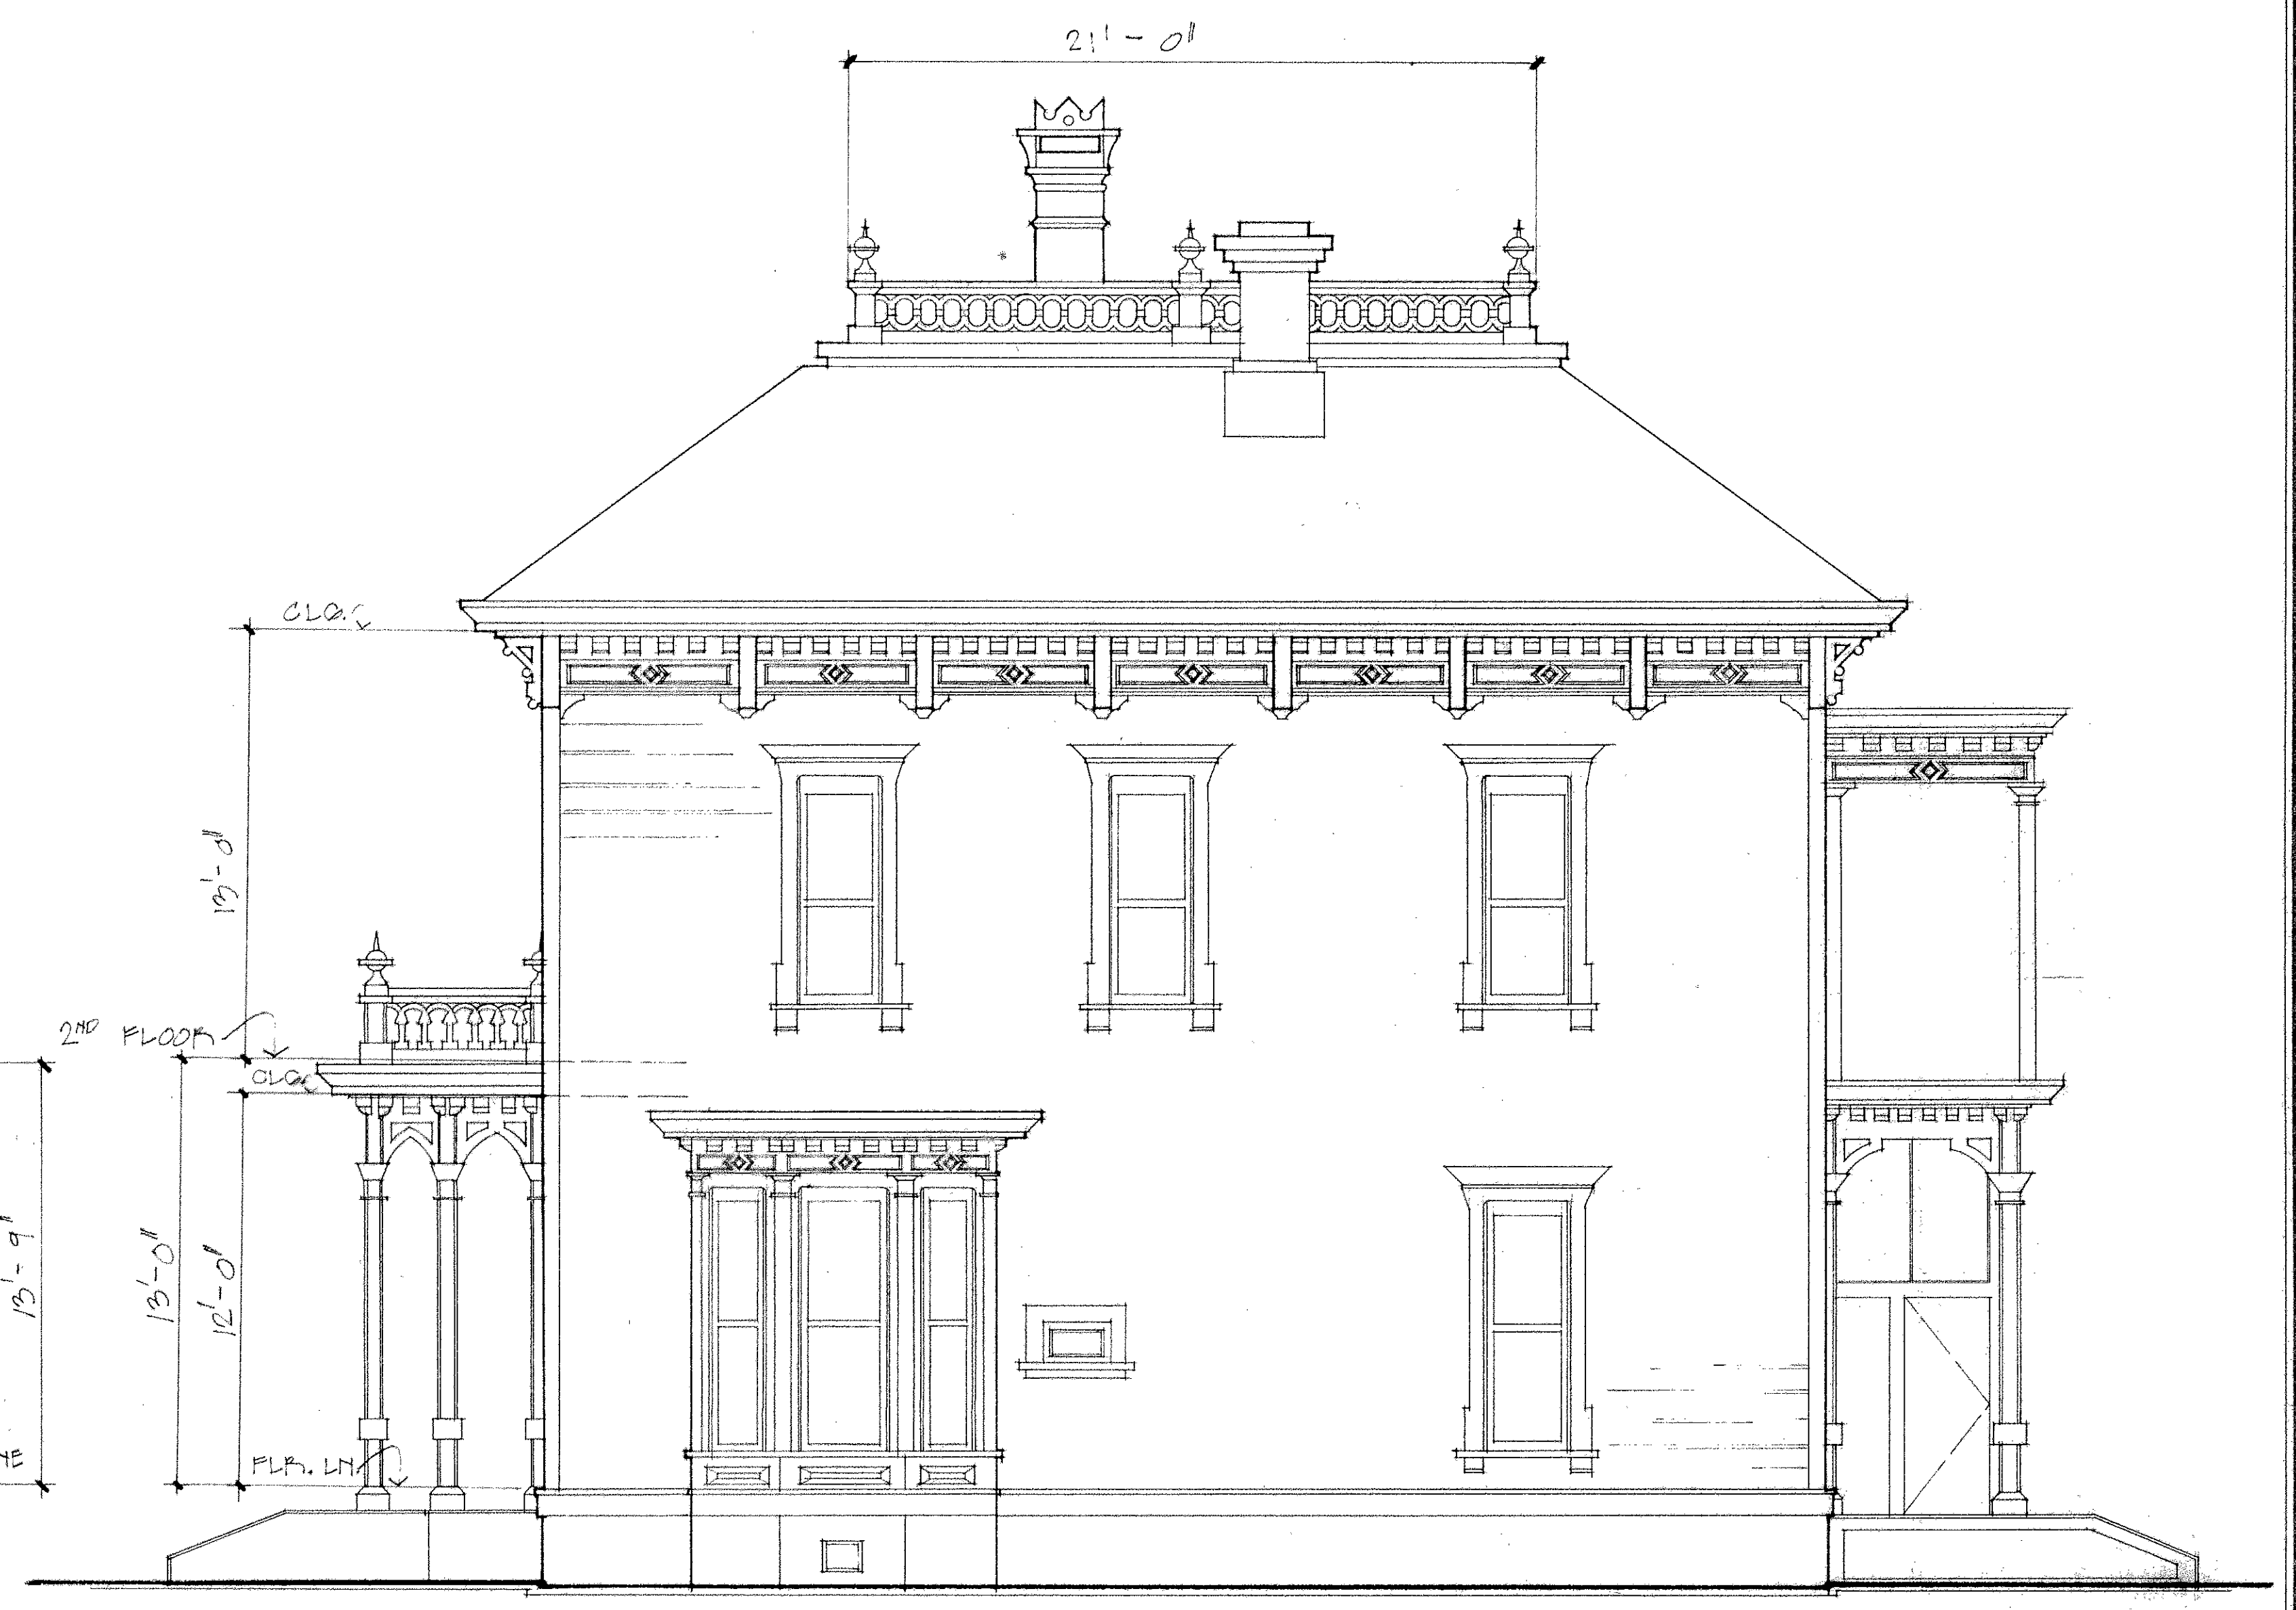

SIDE ELEVATION

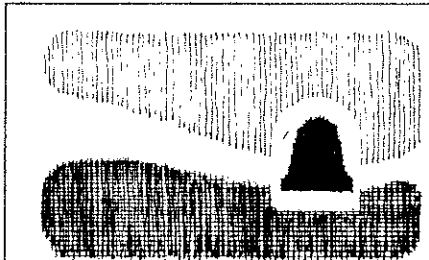

city of san luis obispo

JACK MANSION SAN LUIS OBISPO, CALIFORNIA

REVISIONS	BY	APPRVD	DATE

DRAWN BY	DATE
CHECKED BY	SCALE
APPROVED	
ENGINEER NO.	

AS-BUILT DRAWINGS