



general notes


- 1. IT SHALL BE THE RESPONSIBILITY OF THE CONTRACTOR OR PERMITTEE TO CONTACT "UNDERGROUND SERVICE ALERT U.S.A." TOLL FREE AT 1-800-227-2600 FORTY-EIGHT (48) HOURS PRIOR TO START OF CONSTRUCTION, FOR LOCATION OF POWER, TELEPHONE, OIL AND NATURAL GAS UNDERGROUND FACILITIES. CONTRACTOR OR PERMITTEE SHALL ALSO CONTACT THE APPROPRIATE AGENCY FOR THE LOCATION OF CABLE T.V., WATER, SEWER, DRAINAGE OR UNDERGROUND FACILITIES.
- 2. THE CONTRACTOR SHALL POSSESS A CLASS "A" or "C12" LICENSE AT THE TIME THE CONTRACT IS AWARDED.
- 3. ALL EXISTING UTILITIES AND IMPROVEMENTS THAT BECOME DAMAGE DURING CONSTRUCTION SHALL BE COMPLETELY RESTORED TO THE SATISFACTION OF THE CITY ENGINEER AT THE CONTRACTORS SOLE EXPENSE.
- 4. ALL CURB AND GUTTER REPAIRS SHALL BE COMPLETED PRIOR TO THE START OF PAVING WORK.
- 5. ALL SEWER MANHOLES, CLEANOUTS, WATER AND MONUMENTS WELLS SHALL BE UPGRADED AND RAISED TO THE NEW STREET SURFACE. IF MISMARKED LID IS FOUND, CONTRACTOR SHALL NOTIFY ENGINEER PRIOR TO REPLACING.
- 6. THE CONTRACTOR IS RESPONSIBLE FOR TYING OUT ALL UTILITIES. TIE-OUT INFORMATION FOR NON-CITY UTILITIES SHALL BE FURNISHED TO THE UTILITY OWNER TO RAISE THEIR FACILITIES.
- 7. CONTRACTOR SHALL COORDINATE WITH UTILITY COMPANIES TO RAISE AND LOWER ANY MANHOLES AND UTILITY METERS.
- 8. ALL UTILITY AND CONDUIT WORK SHALL BE COMPLETED PRIOR TO START OF PAVING WORK.

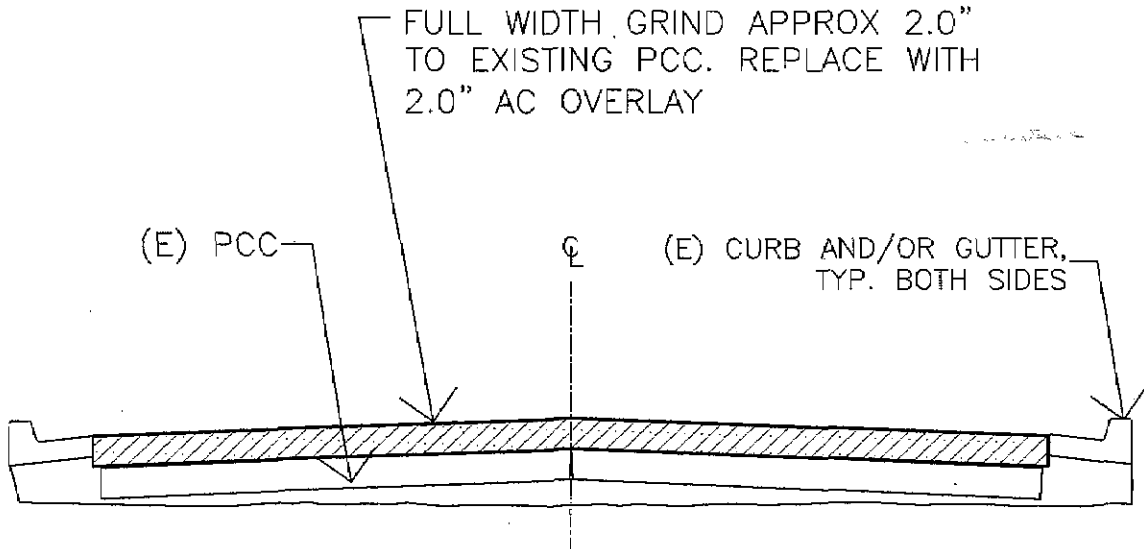


OVERLAY SECTION DETAIL
(NOT TO SCALE)

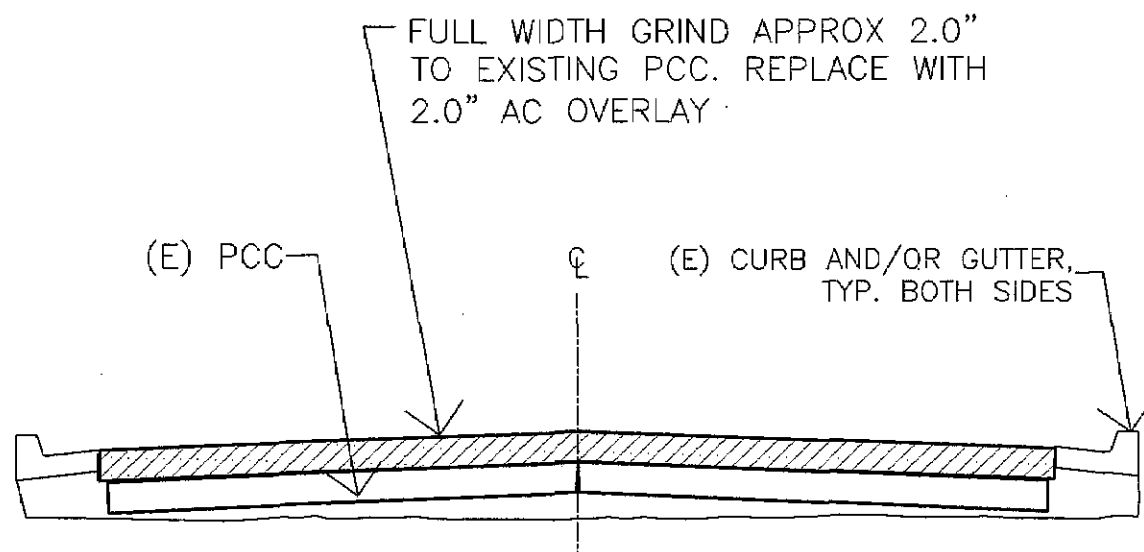

PACIFIC AND BROAD INTERSECTION
OVERLAY SECTION DETAIL
(NOT TO SCALE)

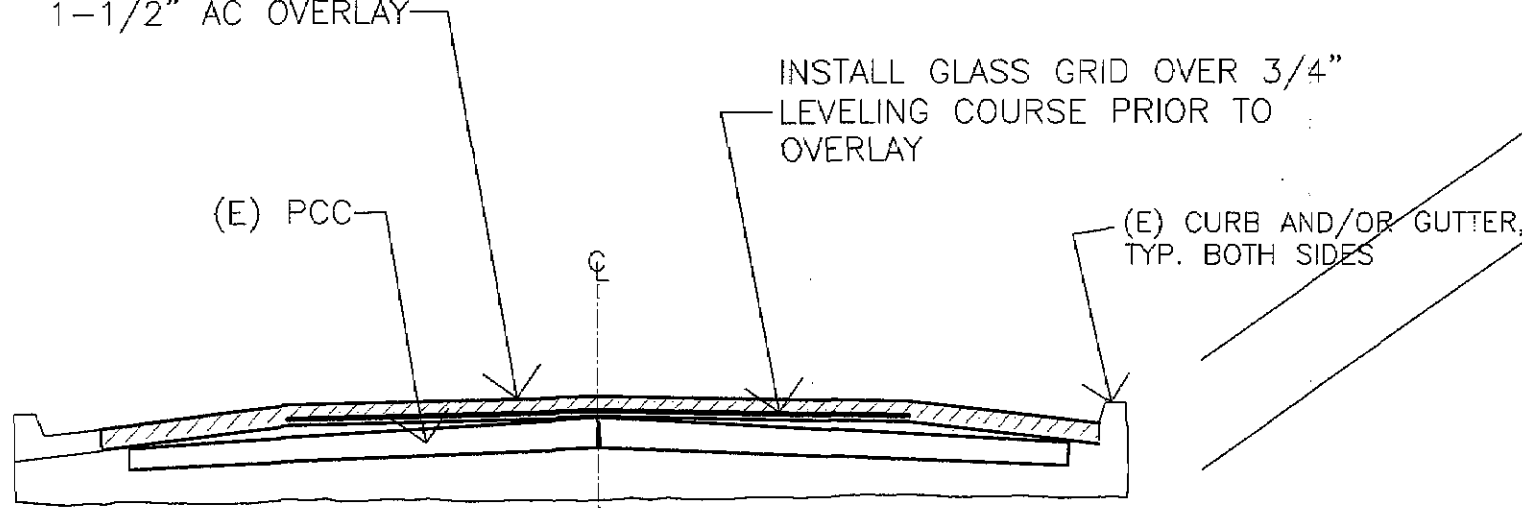

BID ALTERNATE "C"
OVERLAY SECTION DETAIL
(NOT TO SCALE)

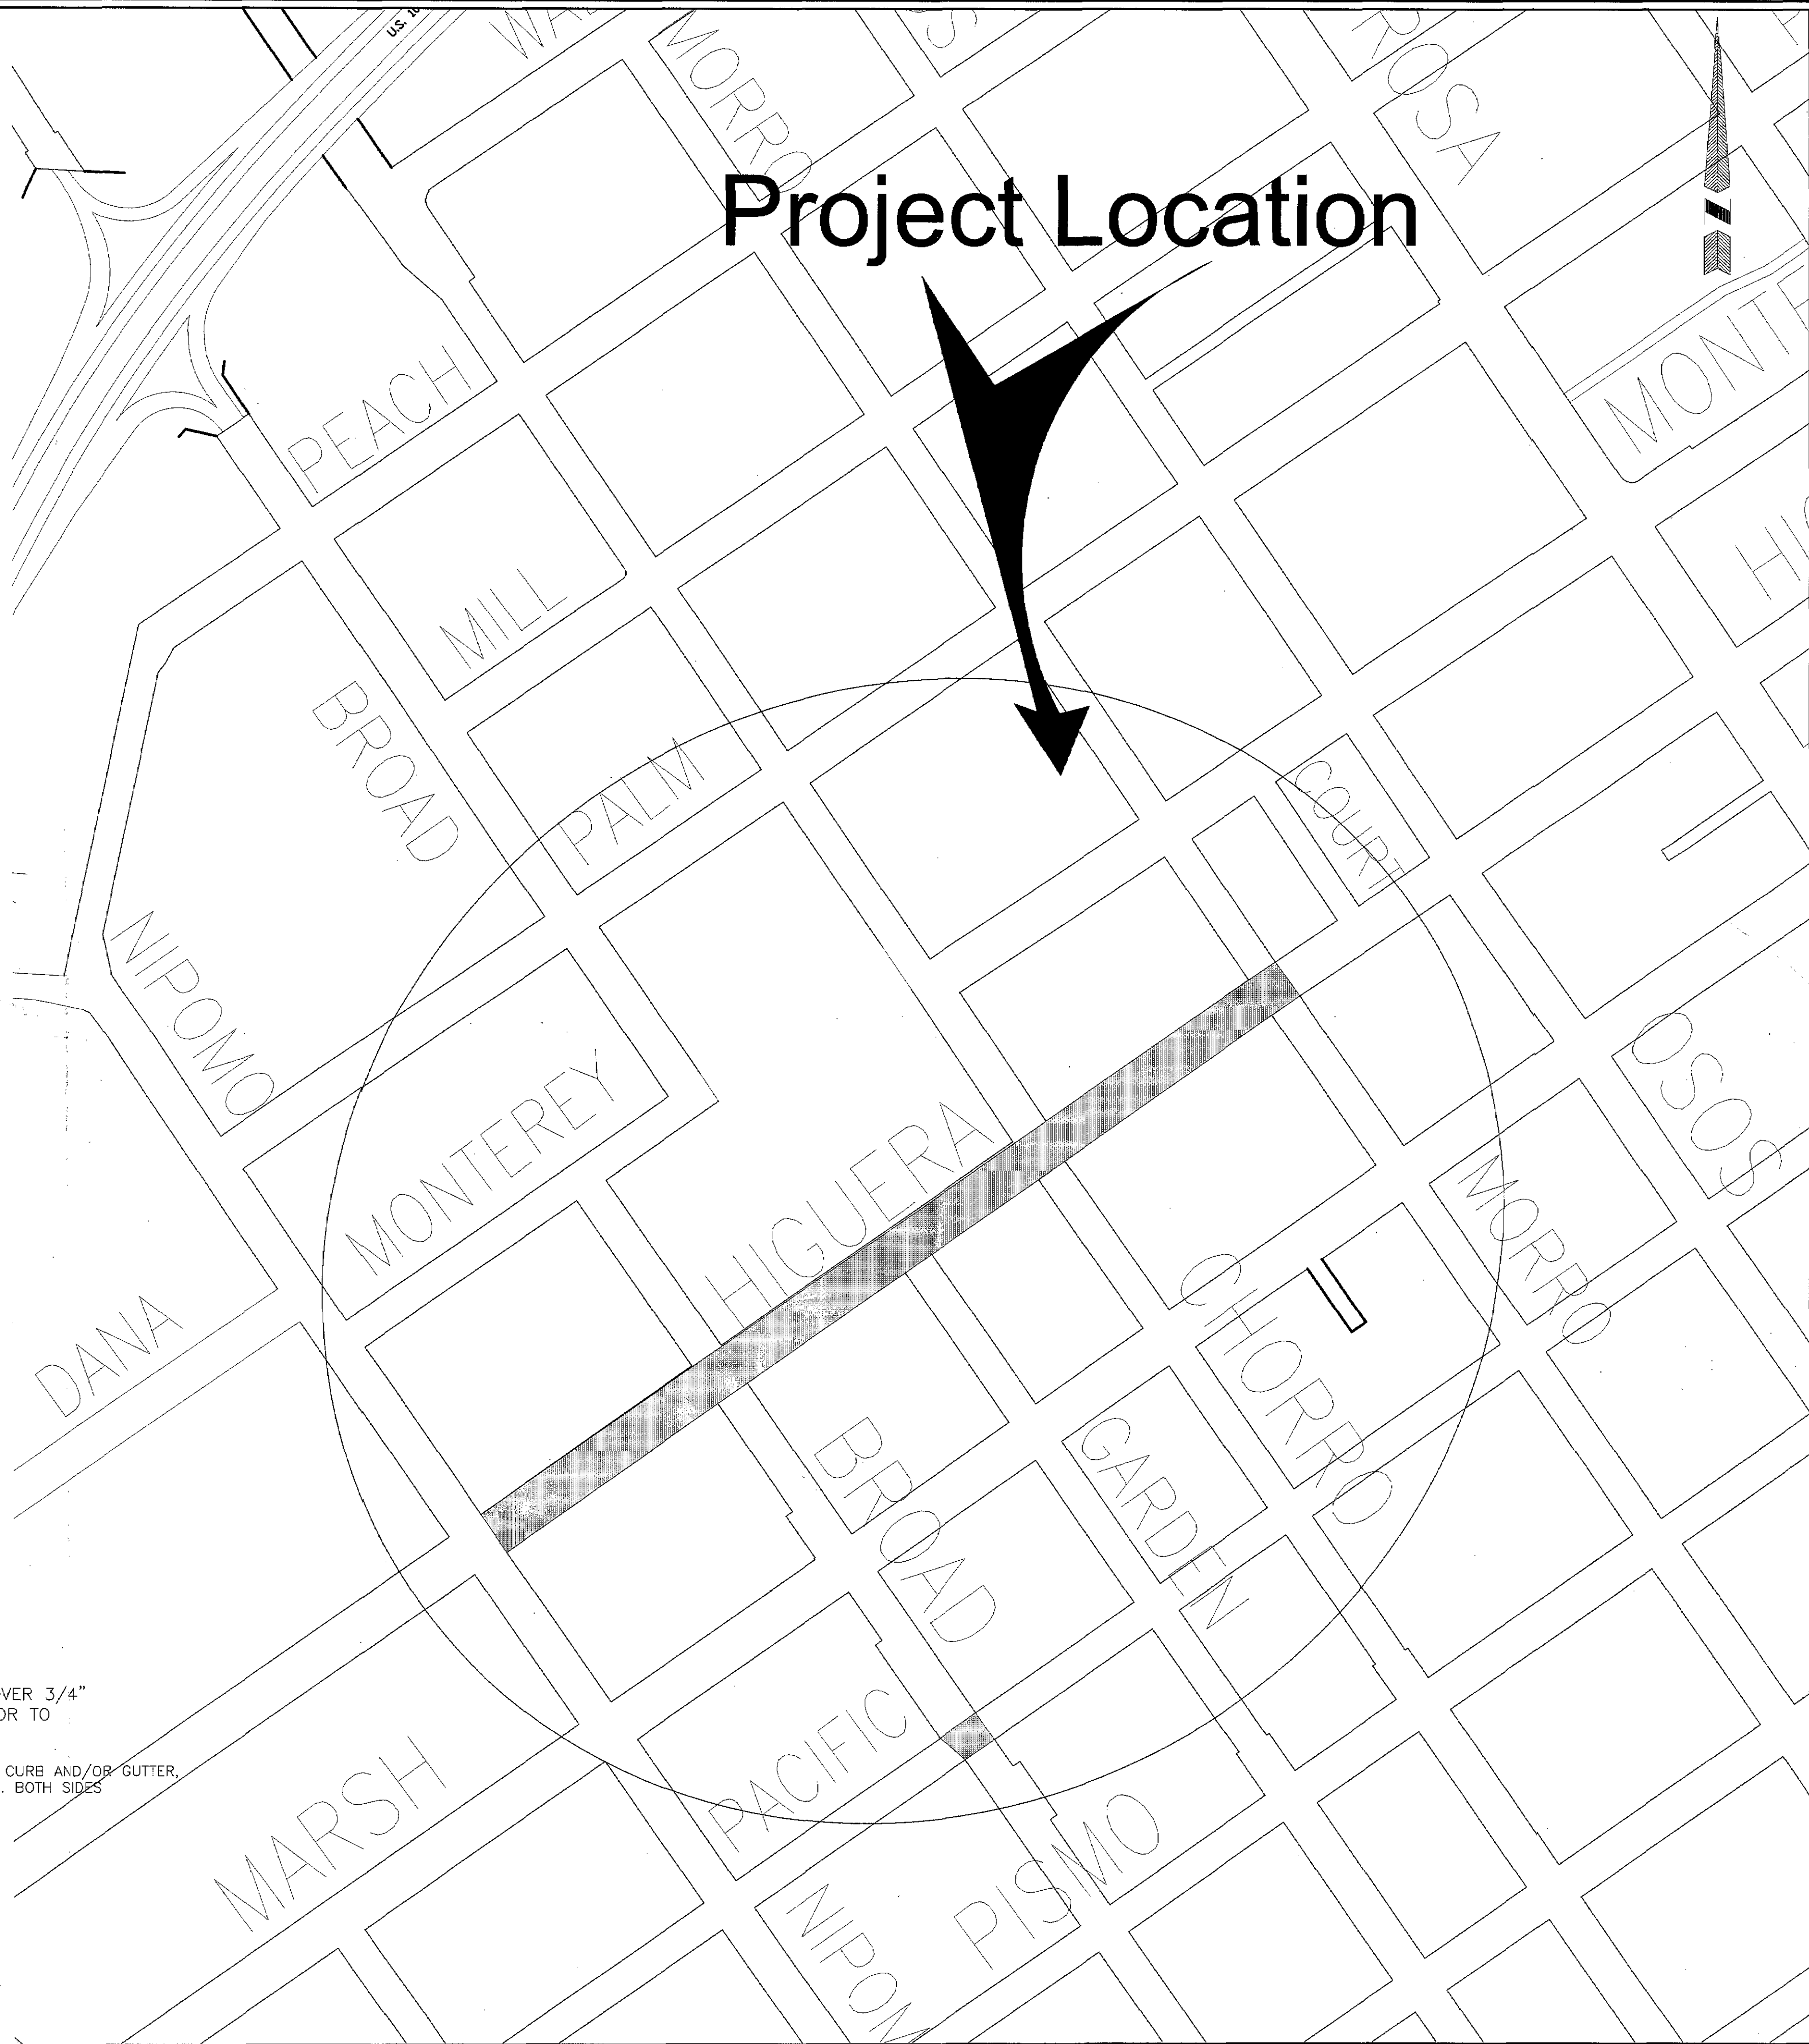


Project Location

index to plans

sheet no.	description
1	VICINITY MAP
2	HIGUERA ST. - NIPOMO TO CHORRO
3	HIGUERA ST. - CHORRO TO MORRO & LIGHTING CONDUIT PROJECT
4	BID ALTERNATE "A" & STREET CLOSURE MAP

LEGEND	SYMBOL	NOTE	ENG	STAND	REF.
SEWER MANHOLE	●	MH	6610,	6040	
MONUMENT	⊙	(BLANK)	9020,	6040	
WATER VALVE	⋈	WV	6340,	6040	
CITY COMMUNICATIONS	○	city comm	9030		
STORM DRAIN	●	SD	3510,	3520,	6040
FIRE HYDRANT	●	FH	6310		
AT&T MANHOLE	○	tele			

Reference Documents:
City Standard Specifications - January 2007 Edition
City Engineering Standards - January 2007 Edition

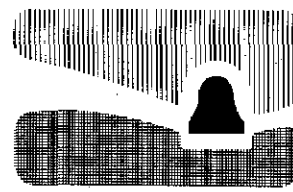

city of

san luis obispo

san luis obispo county, california

HIGUERA STREET PAVING
NIPOMO ST. TO MORRO ST.

SPECIFICATION NO. 90684

APPROVED BY

Barbara Lynch

Barbara Lynch R.C.E. C053418
City Engineer



Approved: 6-06-2007

DATE	JANUARY 2007
FILE NO./LOCATION	0036 B
SHEET	1 OF 4



Approved: 6-06-2007

city of
san luis obispo

**HIGUERA STREET PAVING
NIPOMO ST. TO MORRO ST.**

PLAN SHEET

PROJECT TITLE:

DESIGNED BY: MGR

DRAWN BY: MGR

CHECKED BY: MH, RF, BL


APPROVED BY: BL


DATE: JANUARY 2007

CITY SPECIFICATION NO. 90684

H SCALE: 1:20

SHEET NO. 2 of 4

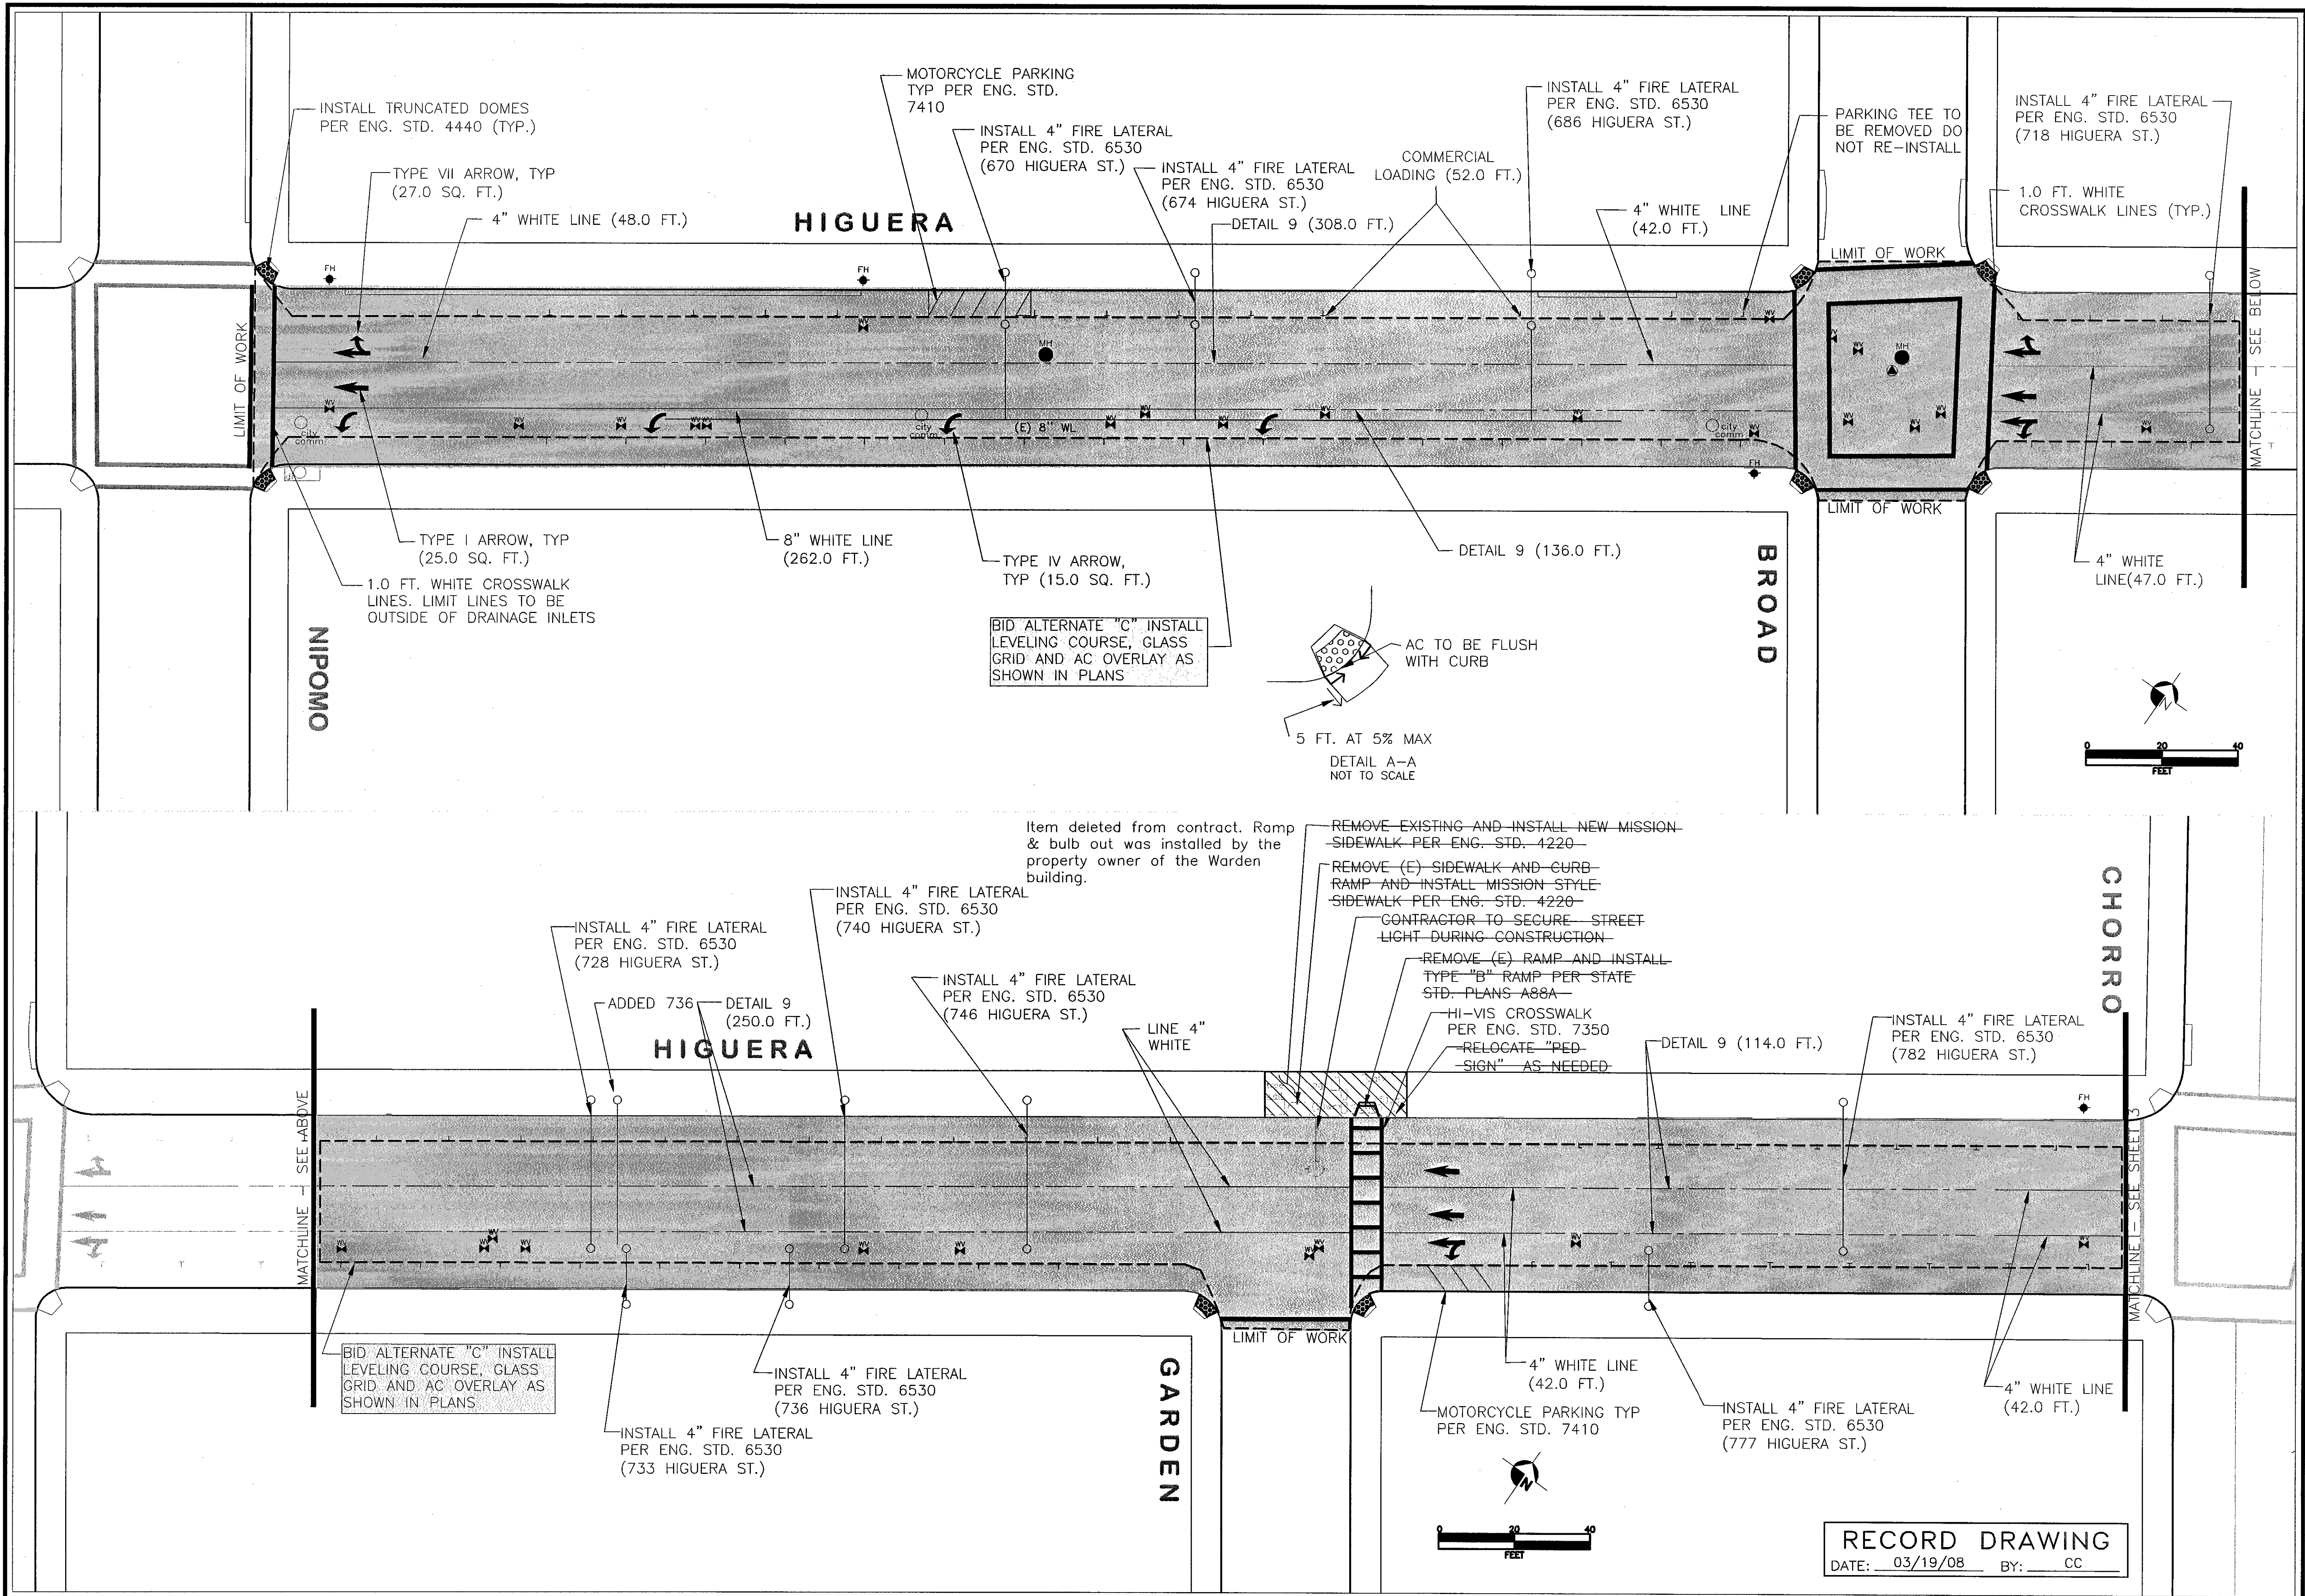

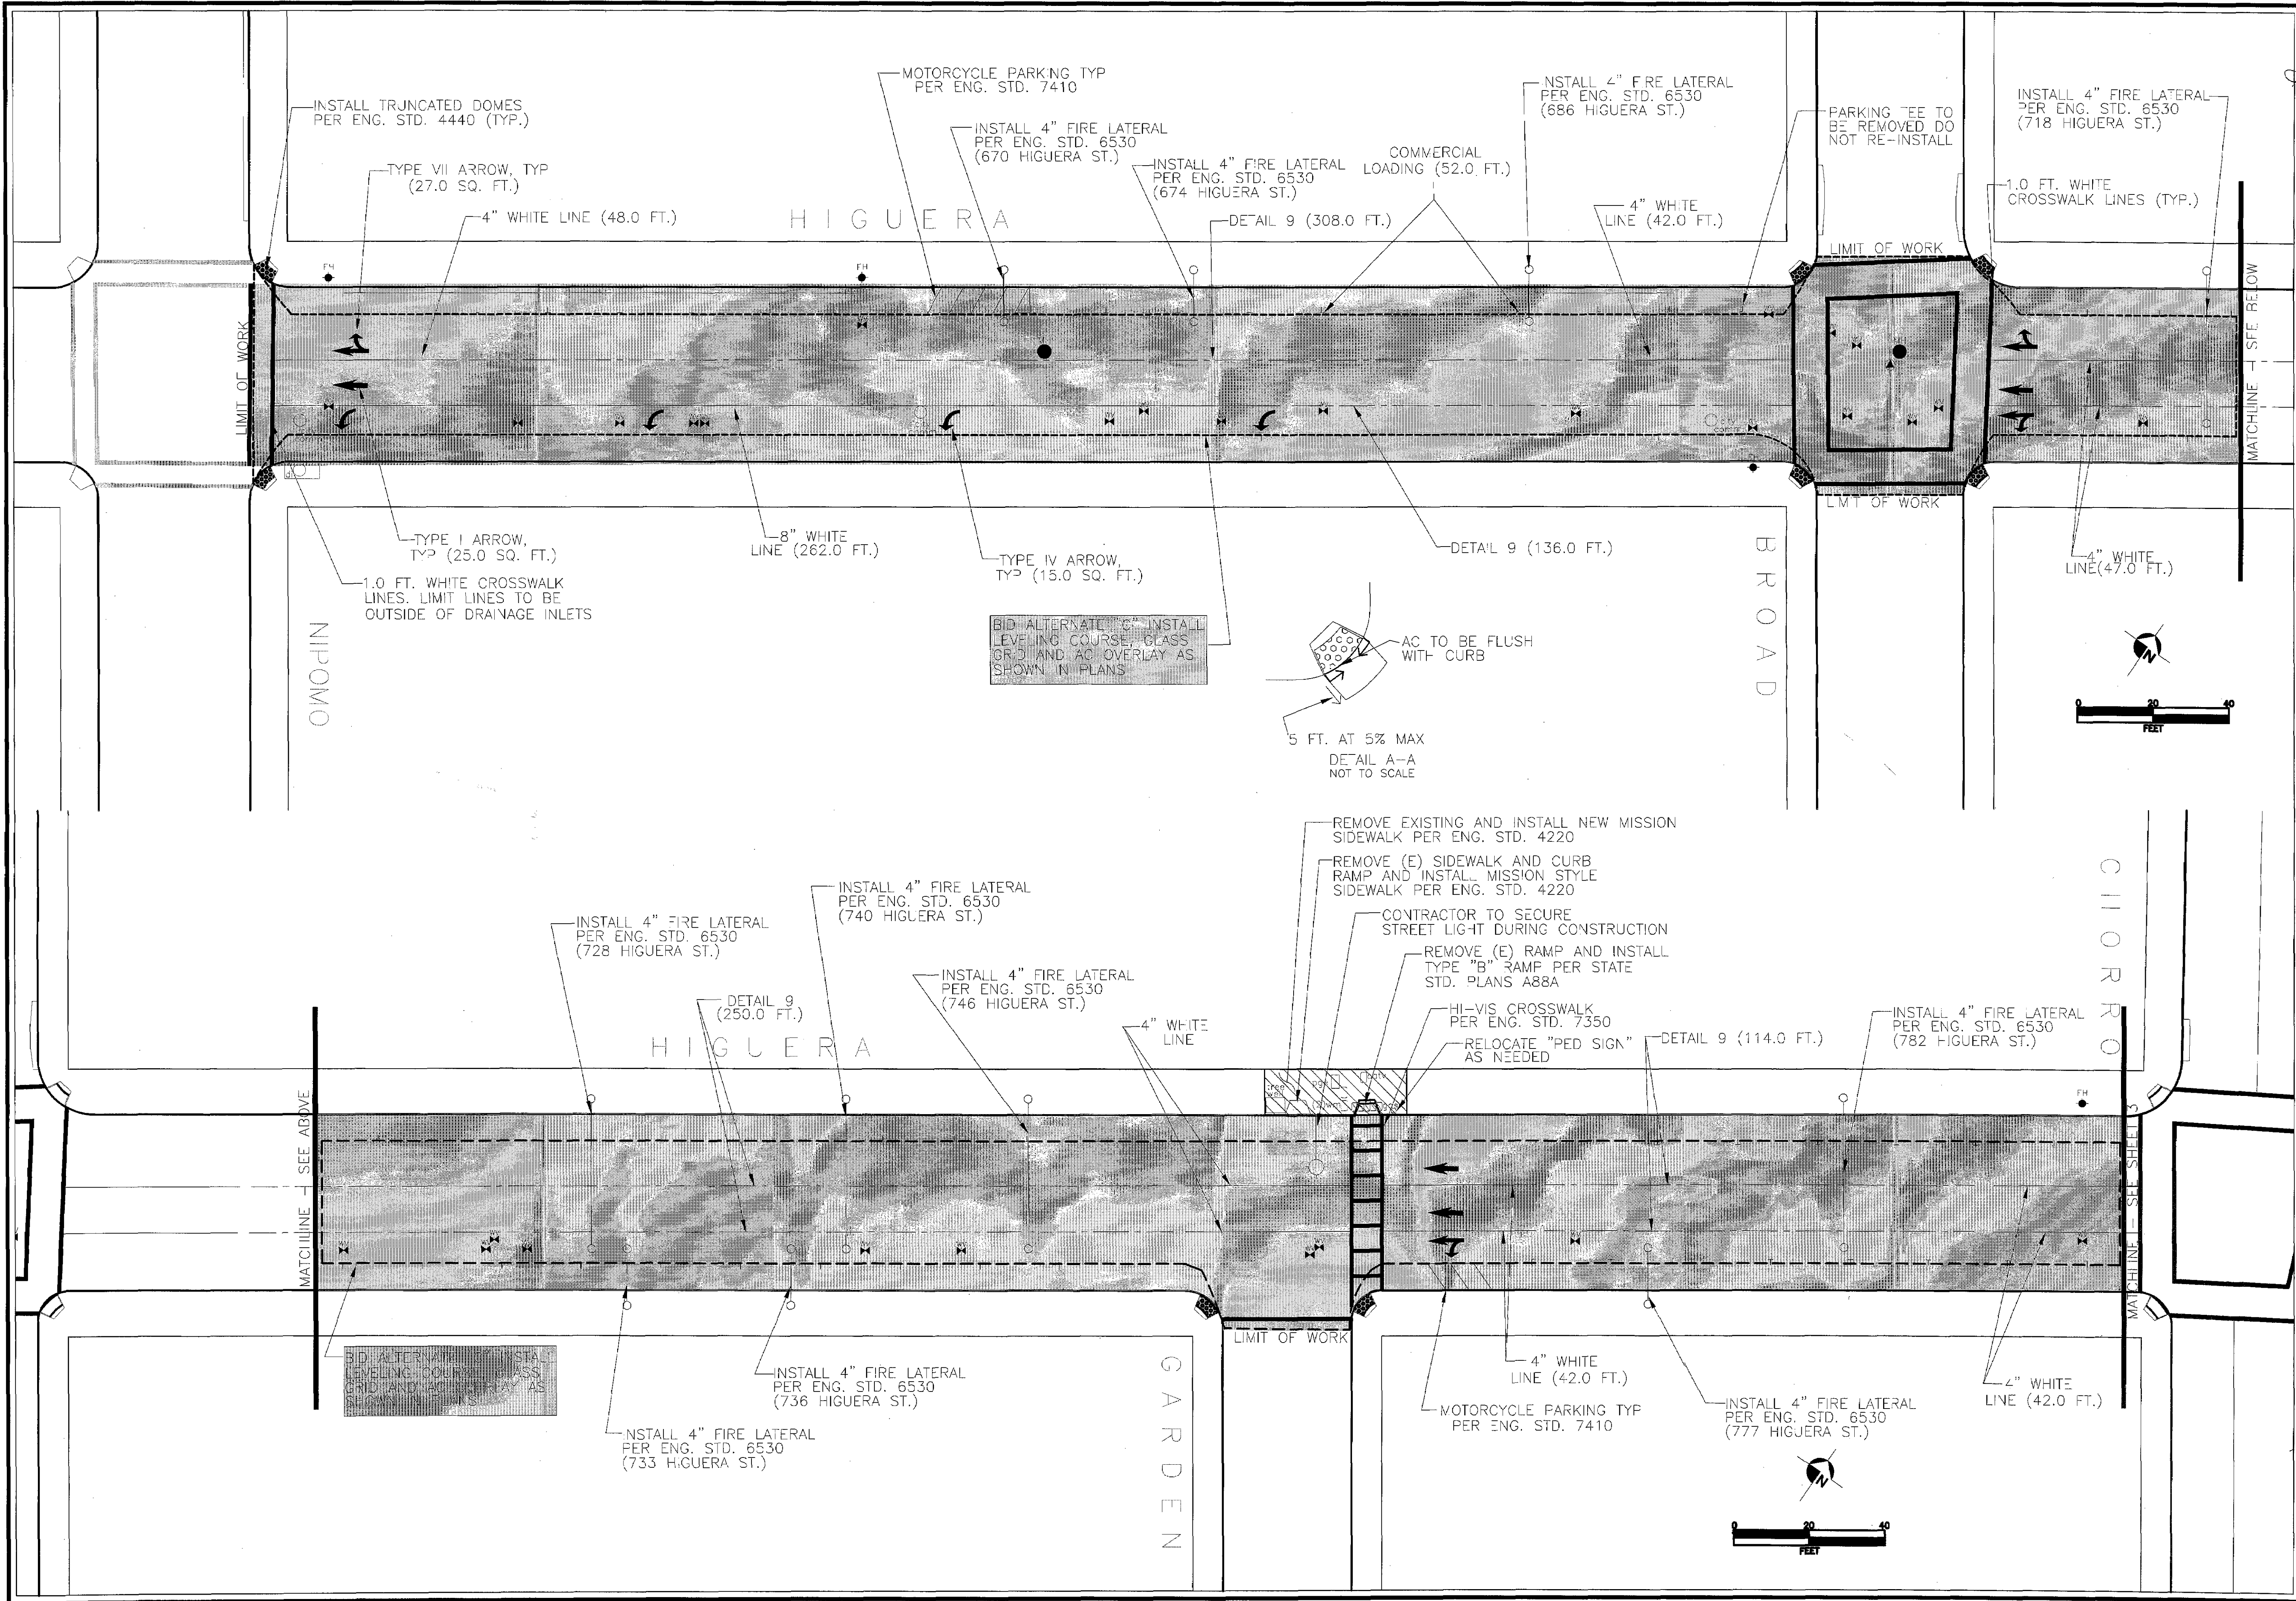

Approved: 6-06-2007


city of

san luis obispo


HIGUERA STREET PAVING
NIPOMO ST. TO MORRO ST.

PLAN SHEET

PROJECT TITLE:	HIGUERA STREET PAVING NIPOMO ST. TO MORRO ST.
DESIGNED BY:	MGR
DRAWN BY:	MGR
CHECKED BY:	MH, RF, BL
APPROVED BY:	BL
DATE:	JANUARY 2007
CITY SPECIFICATION NO.	90684
H SCALE:	1:20
SHEET NO.	2 of 4

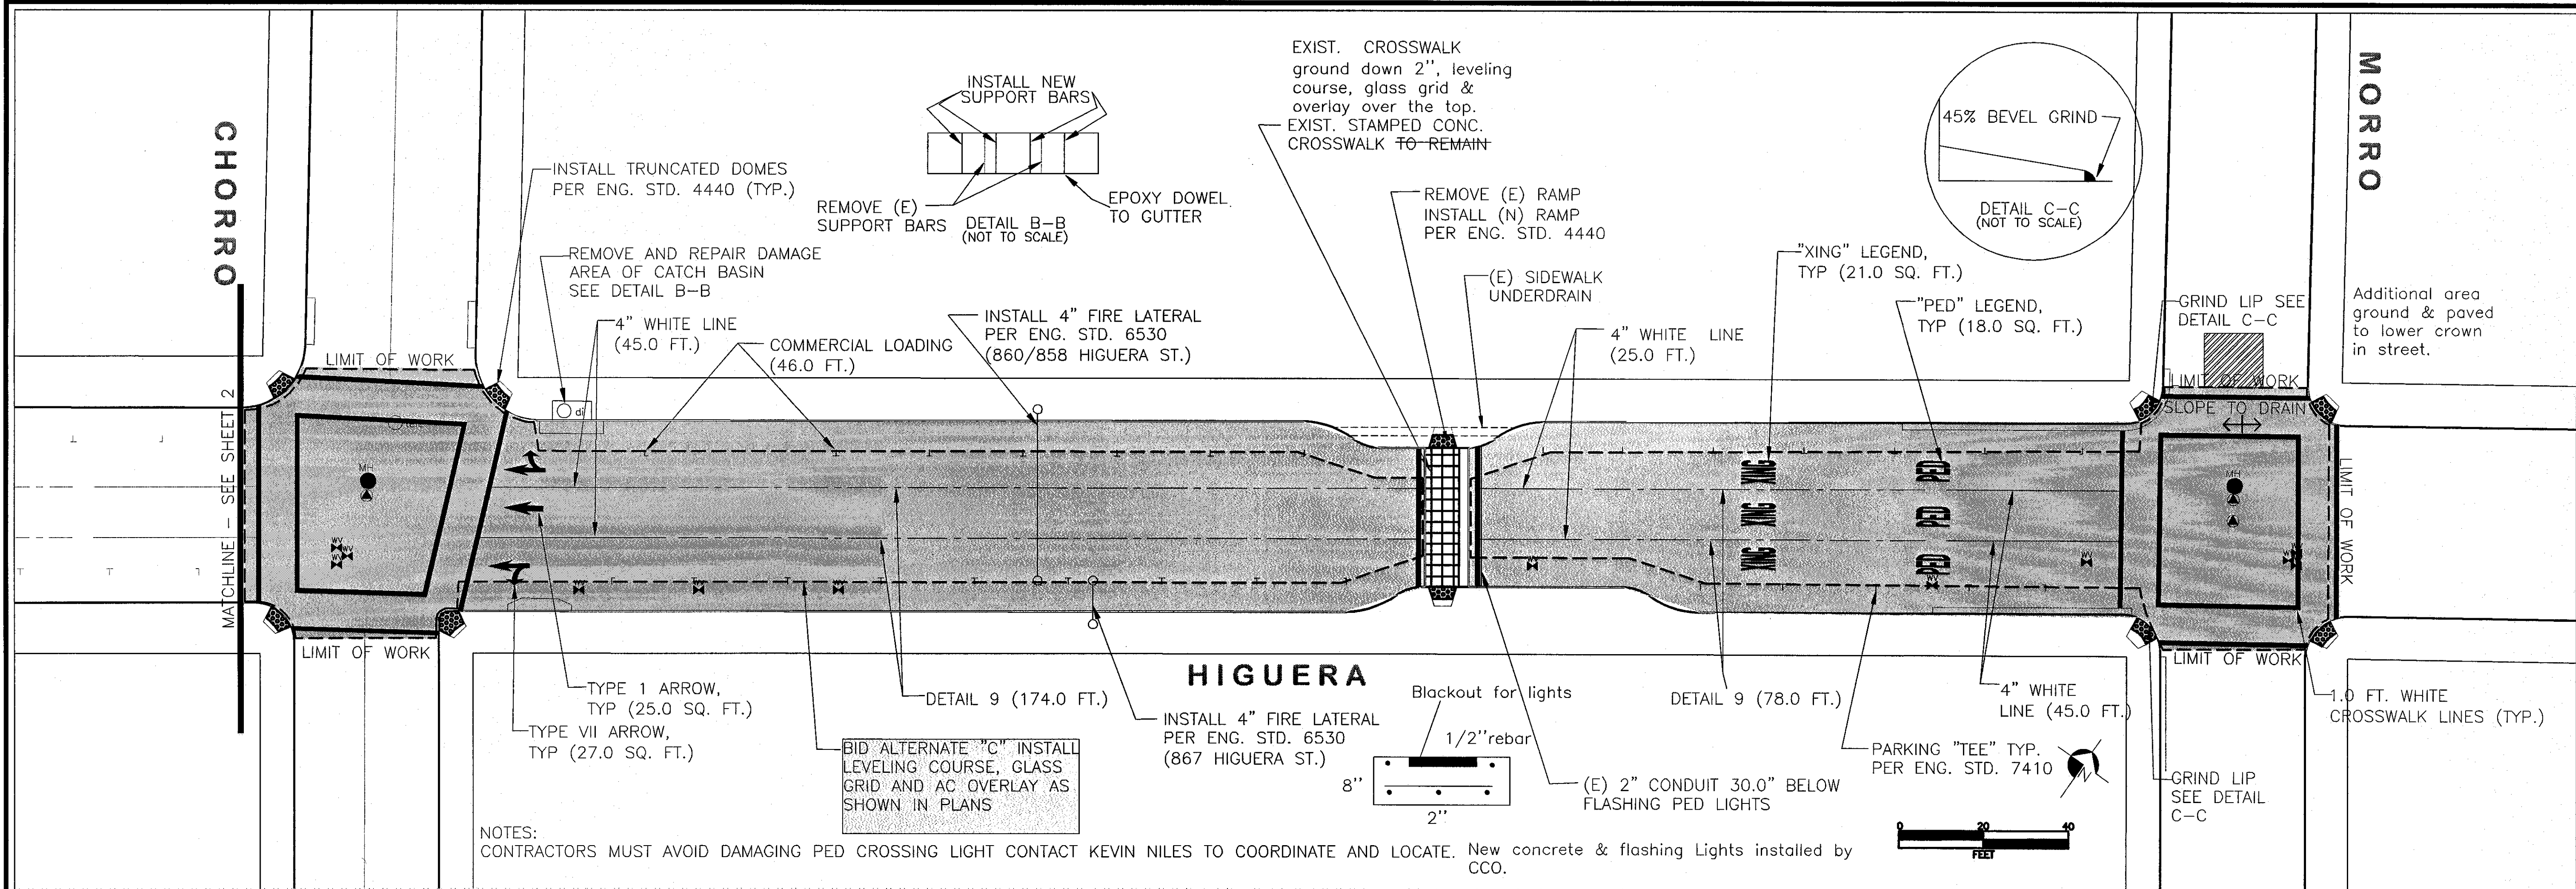

HIGUERA ST. LIGHTING CONDUIT

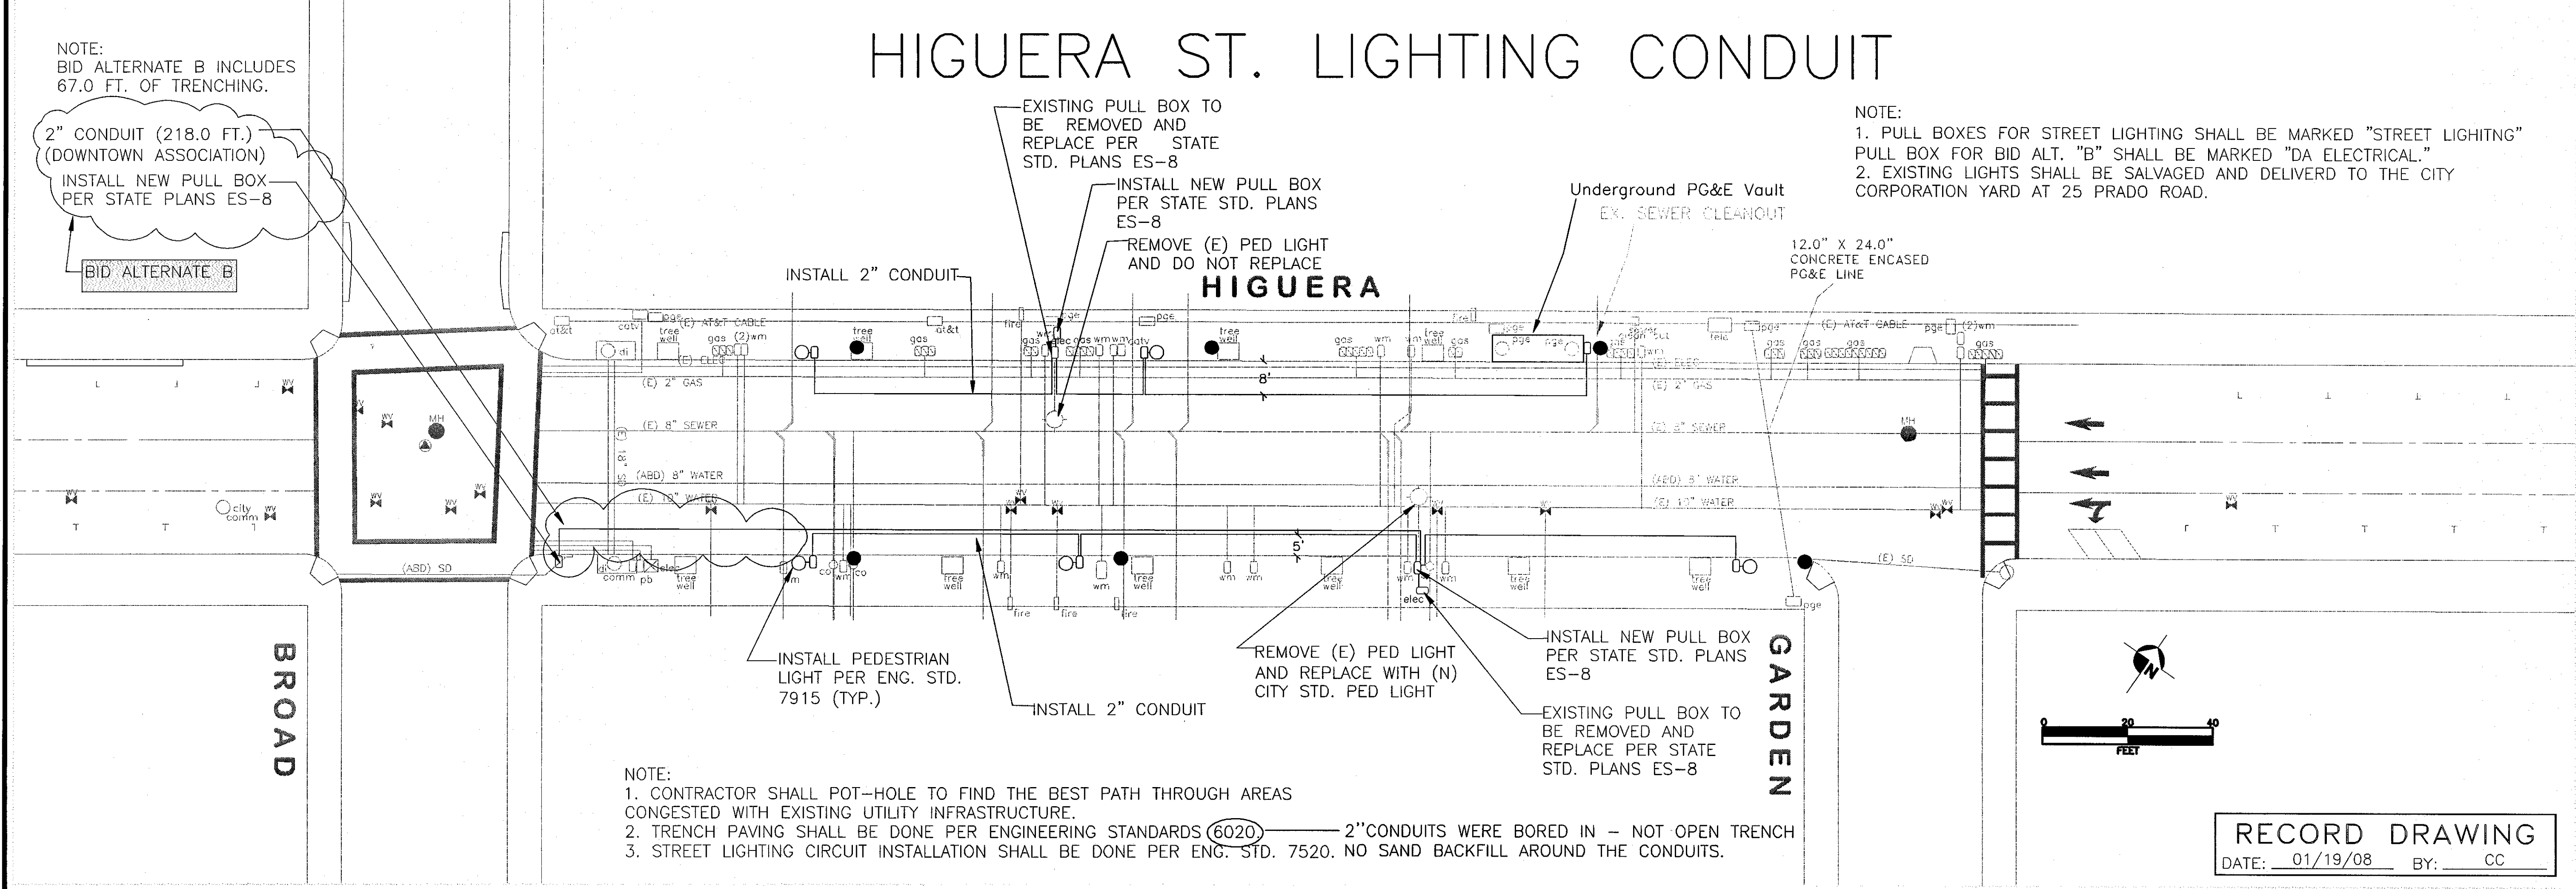



Approved: 6-06-2007

city of
san luis obispo

HIGUERA STREETER PAVING
NIPOMO ST. TO MORRO ST.

PROJECT TITLE	HIGUERA STREETER PAVING NIPOMO ST. TO MORRO ST.
SHEET TITLE	PLAN SHEET
DESIGNED BY:	MGR
DRAWN BY:	MGR
CHECKED BY:	MH, RF, BL
APPROVED BY:	BL
DATE:	JANUARY 2007
CITY SPECIFICATION NO.	90684
H SCALE	1:20
SHEET NO.	3 of 4

RECORD DRAWING
DATE: 01/19/08 BY: CC

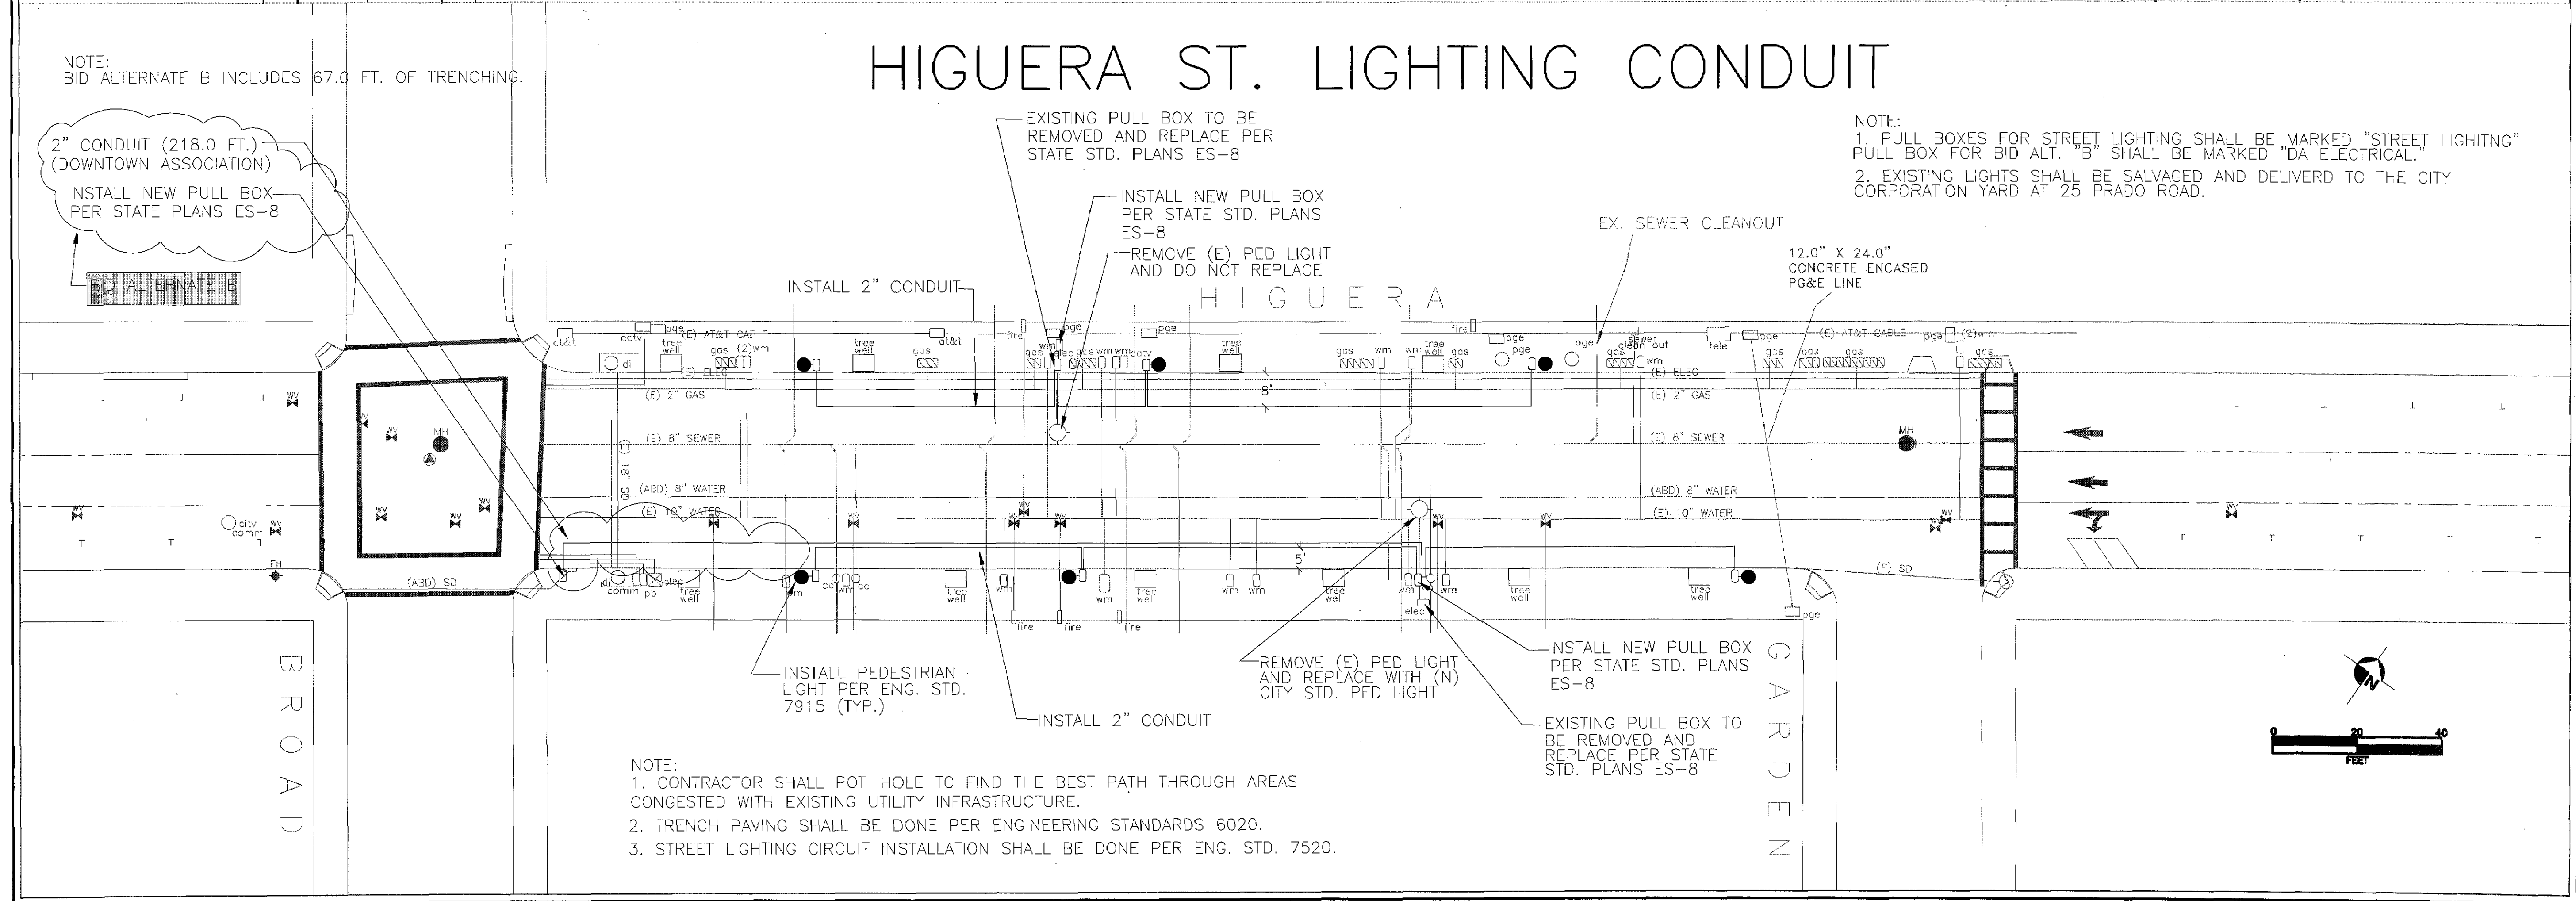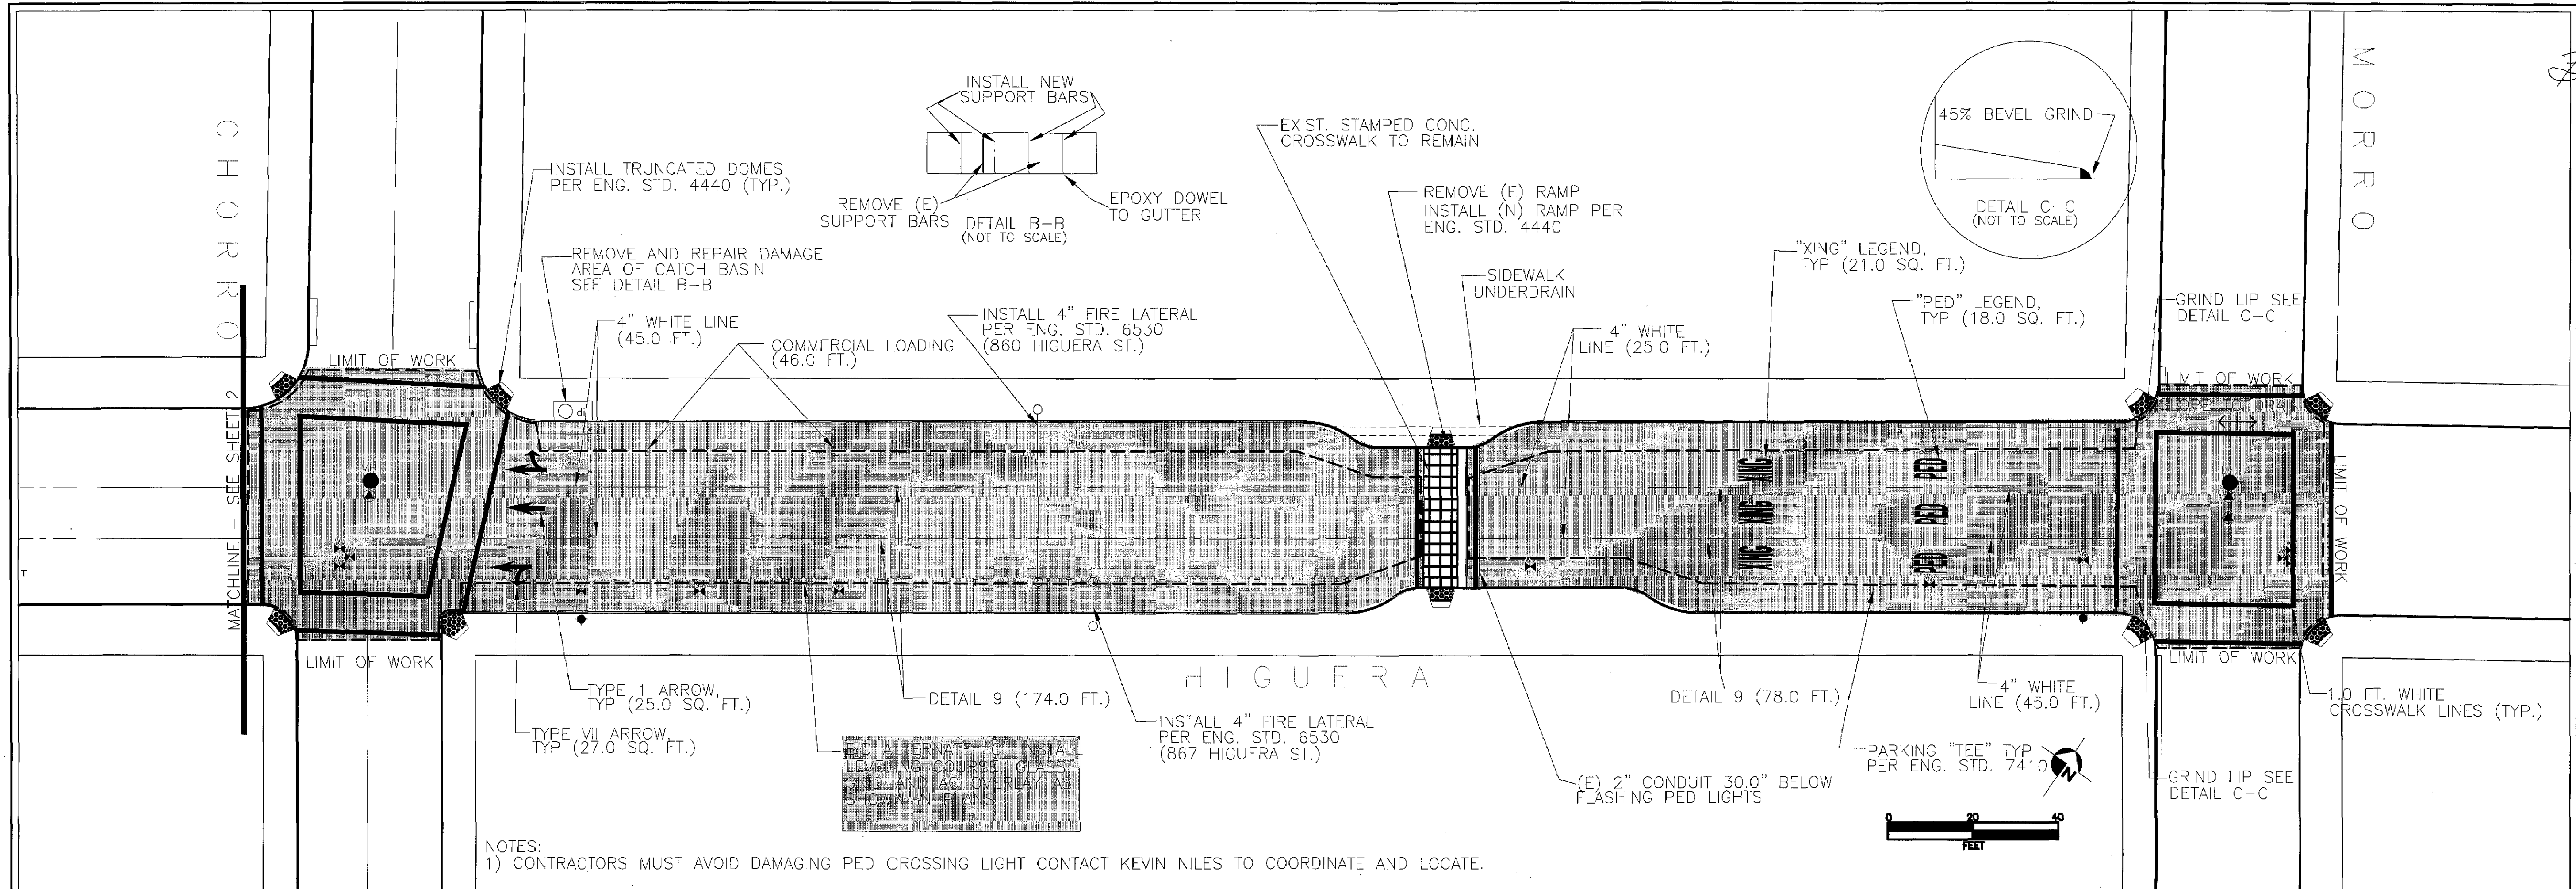

Approved: 6-06-2007

city of
san luis obispo

**HIGUERA STREER PAVING
NIPOMO ST. TO MORRO ST.**

PLAN SHEET

PROJECT TITLE:

DESIGNED BY: MGR

DRAWN BY: MGR

CHECKED BY: MH, RF, BL

APPROVED BY: BL


DATE: JANUARY 2007

CITY SPECIFICATION NO. 90684

H SCALE 1:20

SHEET NO. 3 of 4

NOTES:
 1) CONTRACTOR IS CAUTIONED THAT EXISTING CUT IN LOOPS ARE RIGHT UNDERNEATH THE AC AND CAN BE EASILY BE DAMAGED BY GRINDING EQUIPMENT. ANY DAMAGE TO ALL EXISTING UTILITIES AND IMPROVEMENTS THAT BECOME DAMAGED DURING CONSTRUCTION SHALL BE COMPLETELY RESTORED TO THE SATISFACTION OF THE CITY ENGINEER AT THE CONTRACTOR'S SOLE EXPENSE.

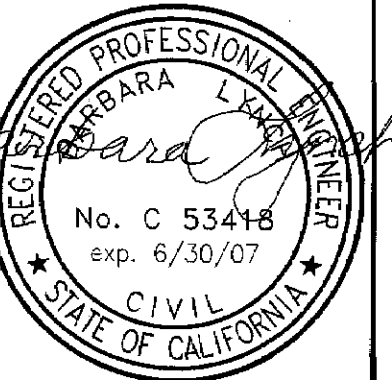

Approved: 6-06-2007


city of
san luis obispo

1.0 FT. WHITE CROSSWALK LINES (TYP.)


(E) CUT IN LOOPS

PACIFIC

B R O A D

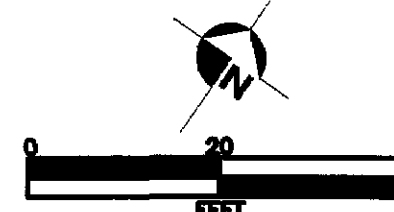

BID ALTERNATE A

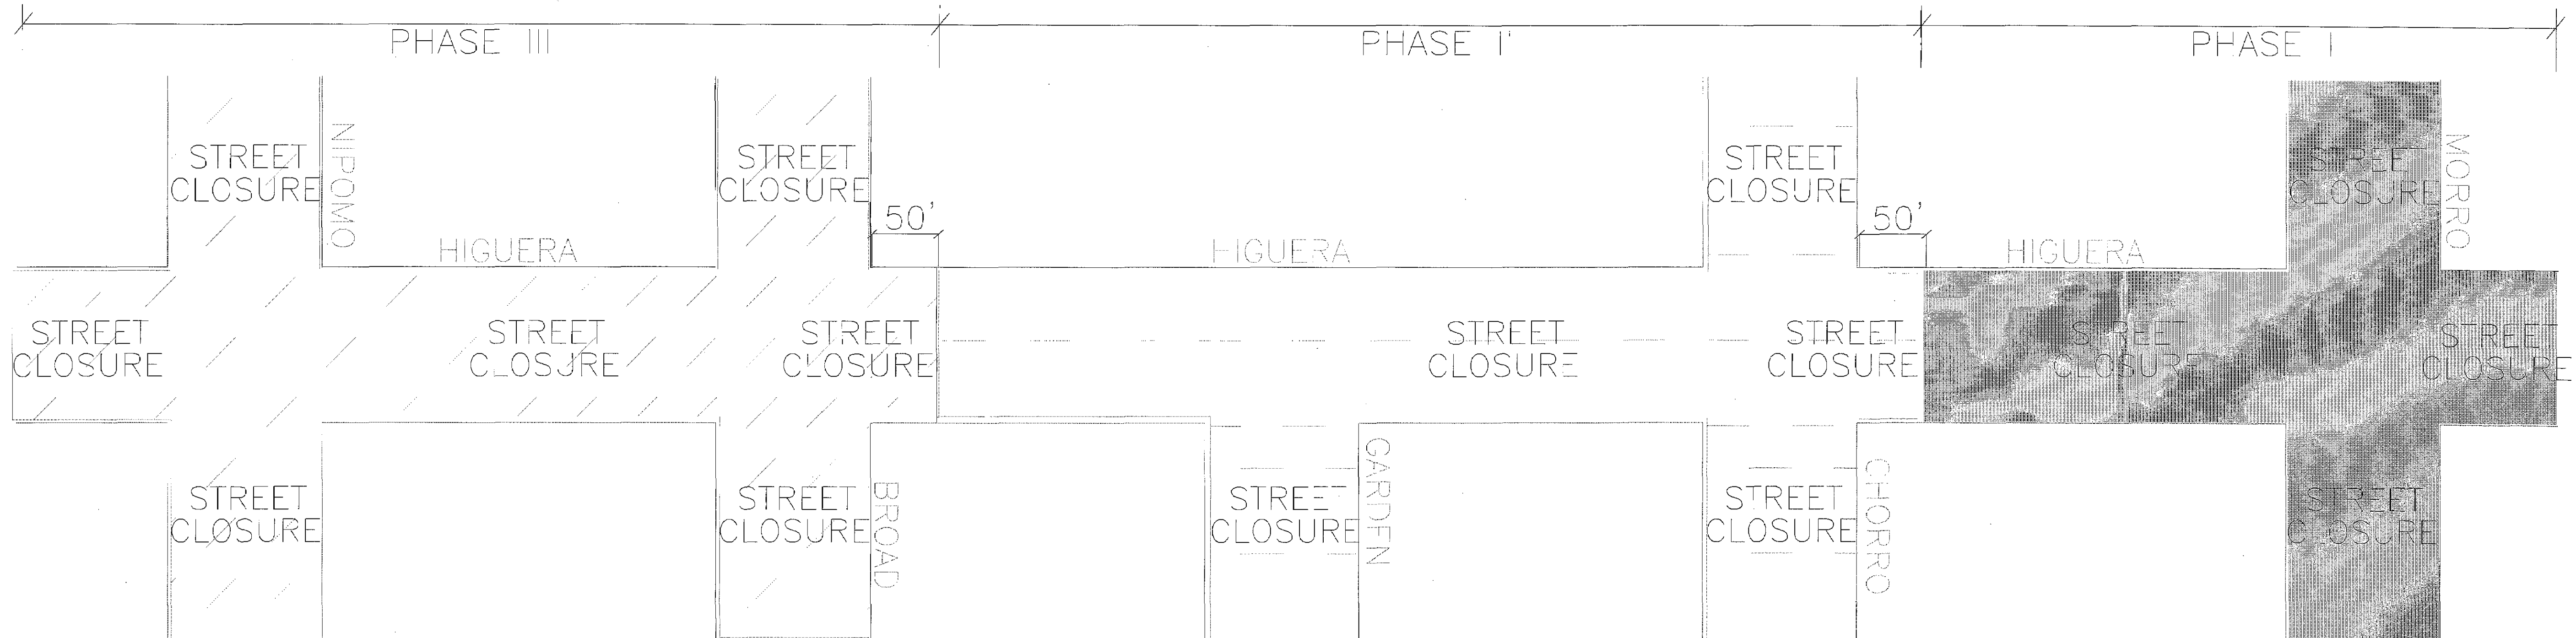

NOTE:
 1. WHEN WORKING ON HIGUERA FROM CHORRO TO BROAD CONTRACTOR SHALL CLOSE HIGJERA FROM MORRO TO CHORRO.
 2. WHEN WORKING ON HIGUERA FROM BROAD TO NIPOMO CONTRACTOR SHALL CLOSE HIGUERA FROM CHORRO TO BROAD.

STREET CLOSURE MAP
 NOT TO SCALE

HIGUERA STREER PAVING
 NIPOMO ST. TO MORRO ST.

PLAN SHEET

PROJECT TITLE:

DESIGNED BY:

MGR

DRAWN BY:

MGR

CHECKED BY:

MH, RF, BL

APPROVED BY:

BL

DATE:

JANUARY 2007

CITY SPECIFICATION NO.

90684

H/V SCALE

SHEET NO.

4 of 4