
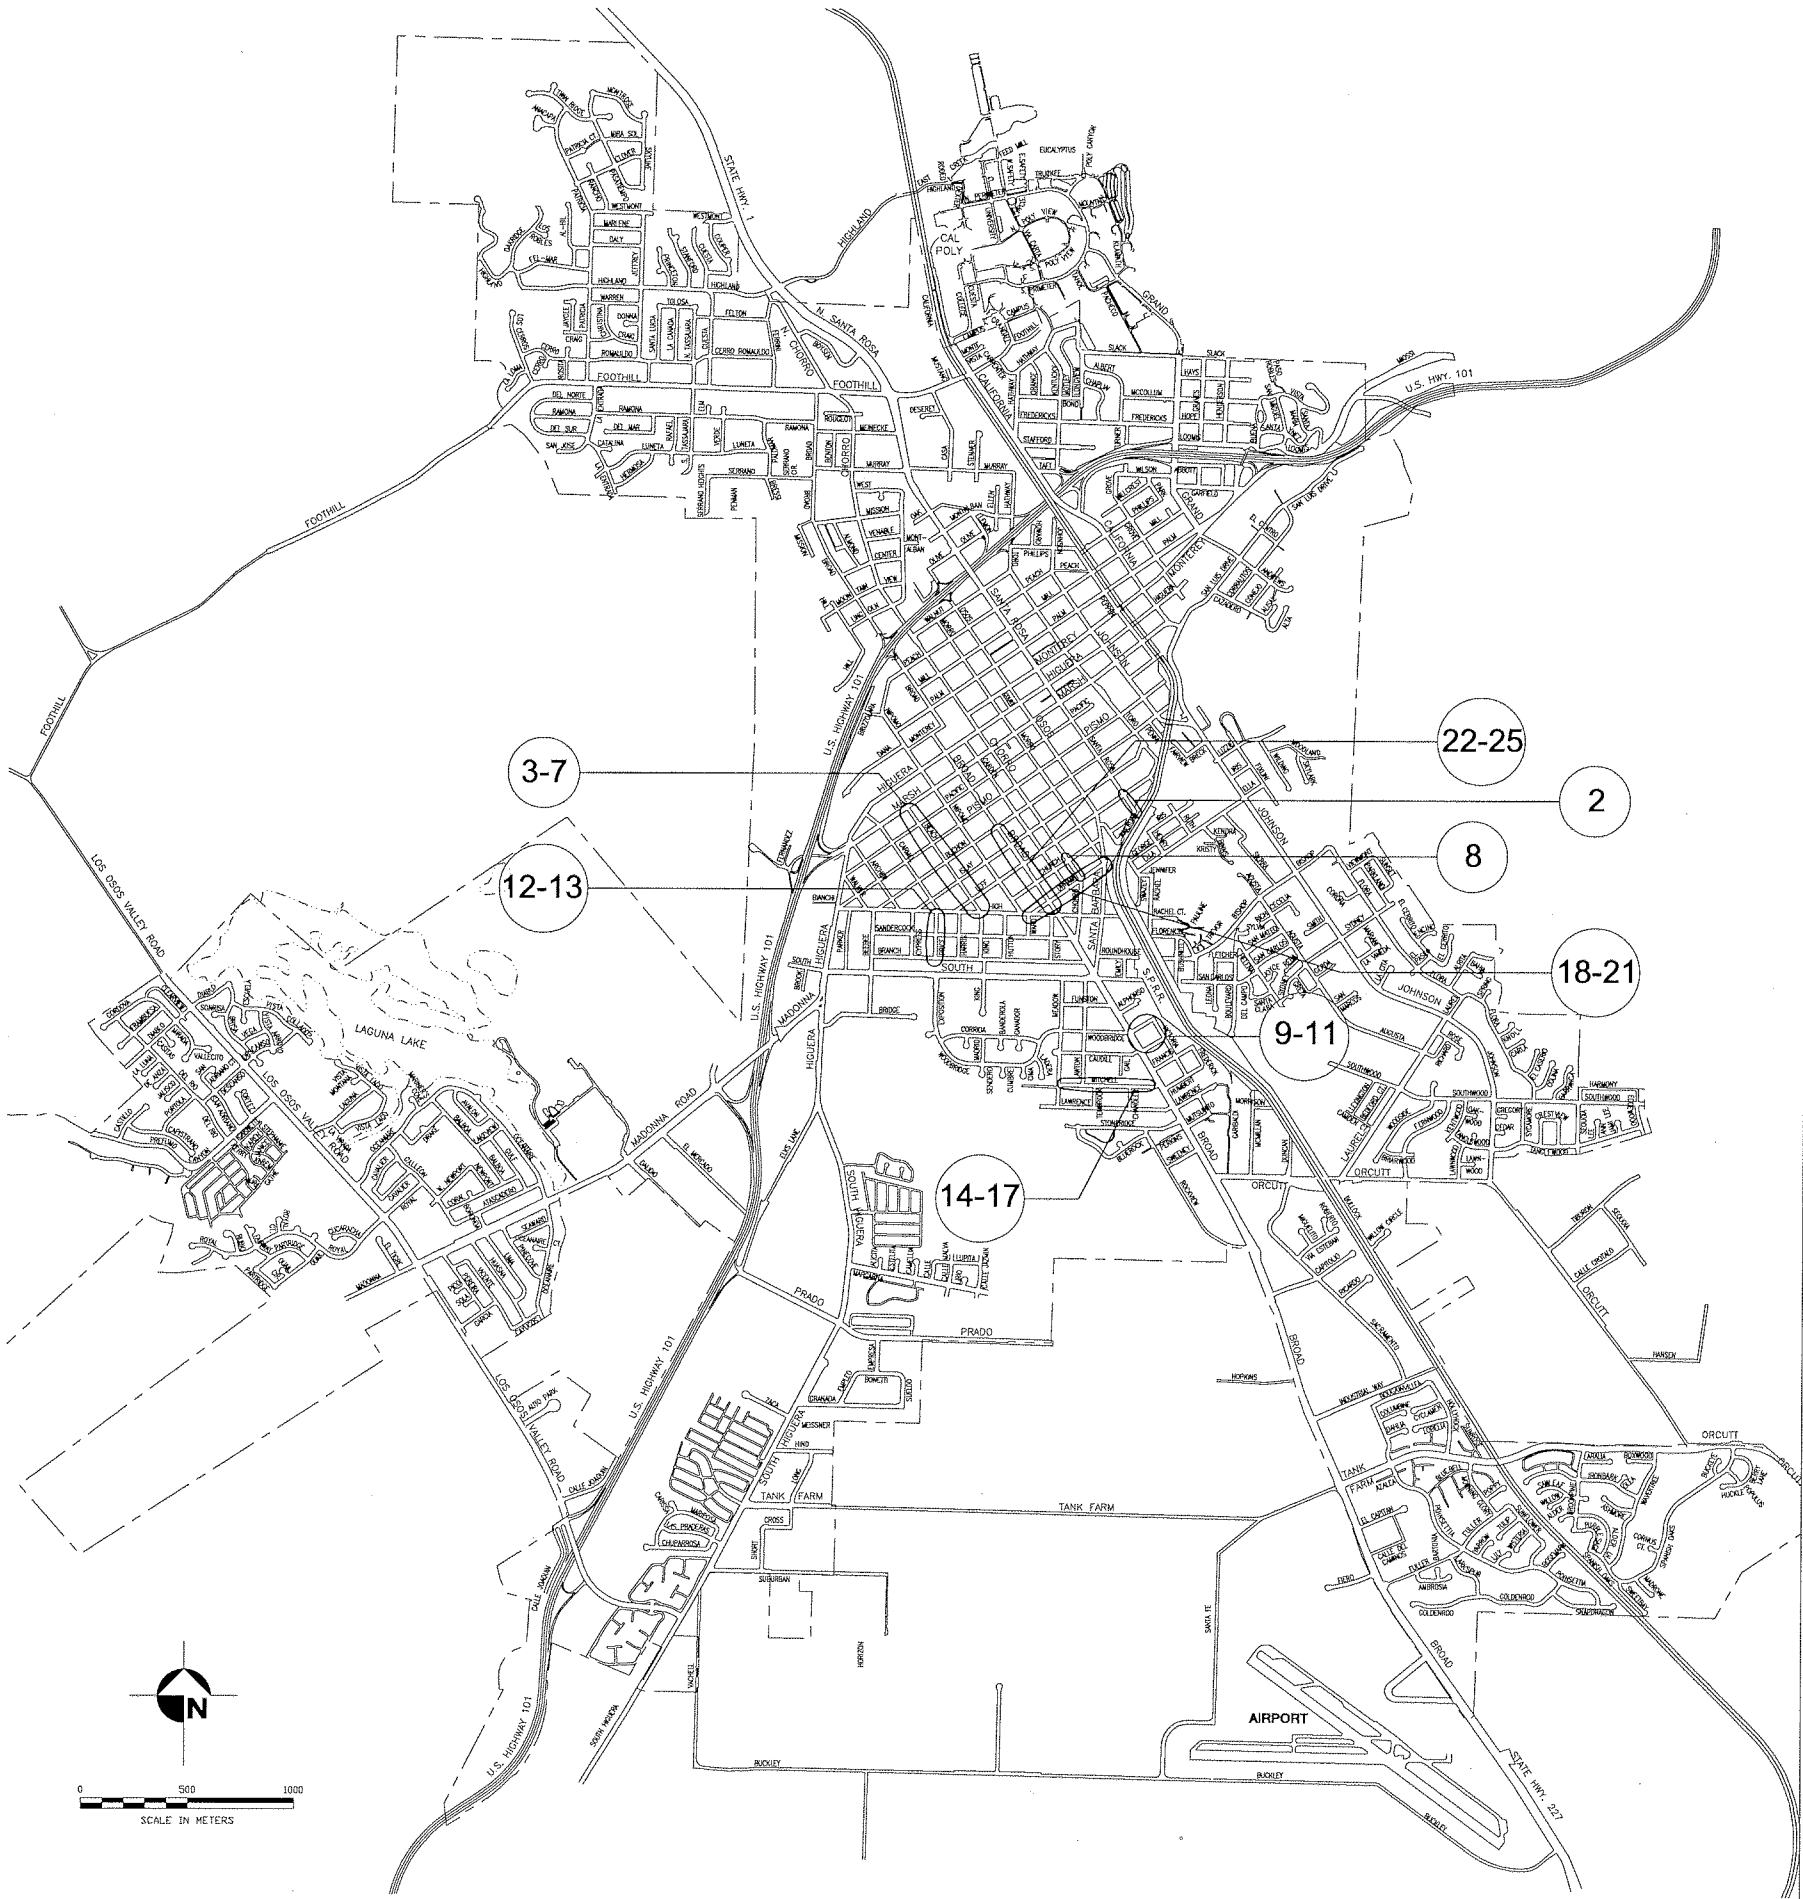


general notes

- 1. IT SHALL BE THE RESPONSIBILITY OF THE CONTRACTOR OR PERMITTEE TO CONTACT "UNDERGROUND SERVICE ALERT U.S.A." TOLL FREE AT 1-800-227-2600 FORTY-EIGHT (48) HOURS PRIOR TO START OF CONSTRUCTION, FOR LOCATION OF POWER, TELEPHONE, OIL AND NATURAL GAS UNDERGROUND FACILITIES. CONTRACTOR OR PERMITTEE SHALL ALSO CONTACT THE APPROPRIATE AGENCY FOR THE LOCATION OF CABLE T.V., WATER, SEWER, DRAINAGE OR UNDERGROUND FACILITIES.
- 2. THE CONTRACTOR SHALL POSSESS A CLASS "A" LICENSE AT THE TIME THE CONTRACT IS AWARDED.
- 3. CONTRACTOR SHALL VERIFY DEPTH & LOCATION, OF ALL CROSSINGS PRIOR TO LAYING PIPE SO THAT PIPE ALIGNMENT AND GRADE CAN BE ADJUSTED AS NEEDED.
- 4. CONTRACTOR SHALL VERIFY DEPTH, LOCATION, SIZE OF AND MATERIAL OF PIPE AT ALL TIE-INS. WATERLINE ALIGNMENT AND GRADE SHALL BE ADJUSTED AS NEEDED BASED ON THE FINDINGS. CONTRACTOR SHALL PROVIDE ALL THE NECESSARY PIPE, FITTINGS ADAPTERS, THRUST BLOCKS AS NEEDED TO ACCOMPLISH THE TIE-IN.
- 5. CONTRACTOR MAY PROVIDE TEMPORARY BLOW-OFFS, CONNECTIONS, VALVES, ETC. AS NEEDED TO FACILITATE TESTING, DISINFECTING AND FLUSHING OF NEW PIPELINE.
- 6. SEWER LATERALS AND GAS LINES EXIST WHICH ARE NOT SHOWN ON THESE PLANS. CONTRACTOR TO PROCEED WITH CAUTION WHEN TRENCHING AND SHALL HAVE THE NECESSARY MATERIALS ON HAND TO FIX SEWER LATERALS IF DAMAGED.

Metric datum:

VERTICAL CONTROL: BENCHMARK NO.(S) 2-190 & 2-152 AS PUBLISHED IN THE CITY OF SAN LUIS OBISPO 1996 BENCHMARK SYSTEM. CITY'S BENCHMARK SYSTEM IS GENERALLY 52MM HIGHER THAN THE NORTH AMERICA VERTICAL DATUM OF 1929 (NAVD29).

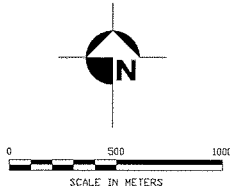

index to plans

sheet no.	description
1	Cover Sheet
2	Santa Rosa
3-7	Beach St.
8	Chorro St.
9	Caudill St.
10	Woodbridge St.
11	Victoria St.
12-13	Price St.
14-17	Mitchell St.
18-21	Upham St.
22-25	Broad St



san luis obispo county, california
WATER IMPROVEMENT PROJECT


- Broad Street: Buchon - High
- Beach Street: Marsh - High
- Price Street: Branch - High
- Upham Street: High - Morro
- Chorro Street: Church - Upham
- Santa Rosa Street: Leff - Upham
- Mitchell Street: Meadow - Broad
- Woodbridge Street: Broad - Victoria
- Victoria Street: Woodbridge - Caudill
- Caudill Street: Broad - Victoria


SPECIFICATION NO. 90033

APPROVED BY


Wayne A. Peterson R.C.E. 18598
City Engineer

DATE	MAY 2000
FILE NO./LOCATION	90033
SHEET	1 OF 25

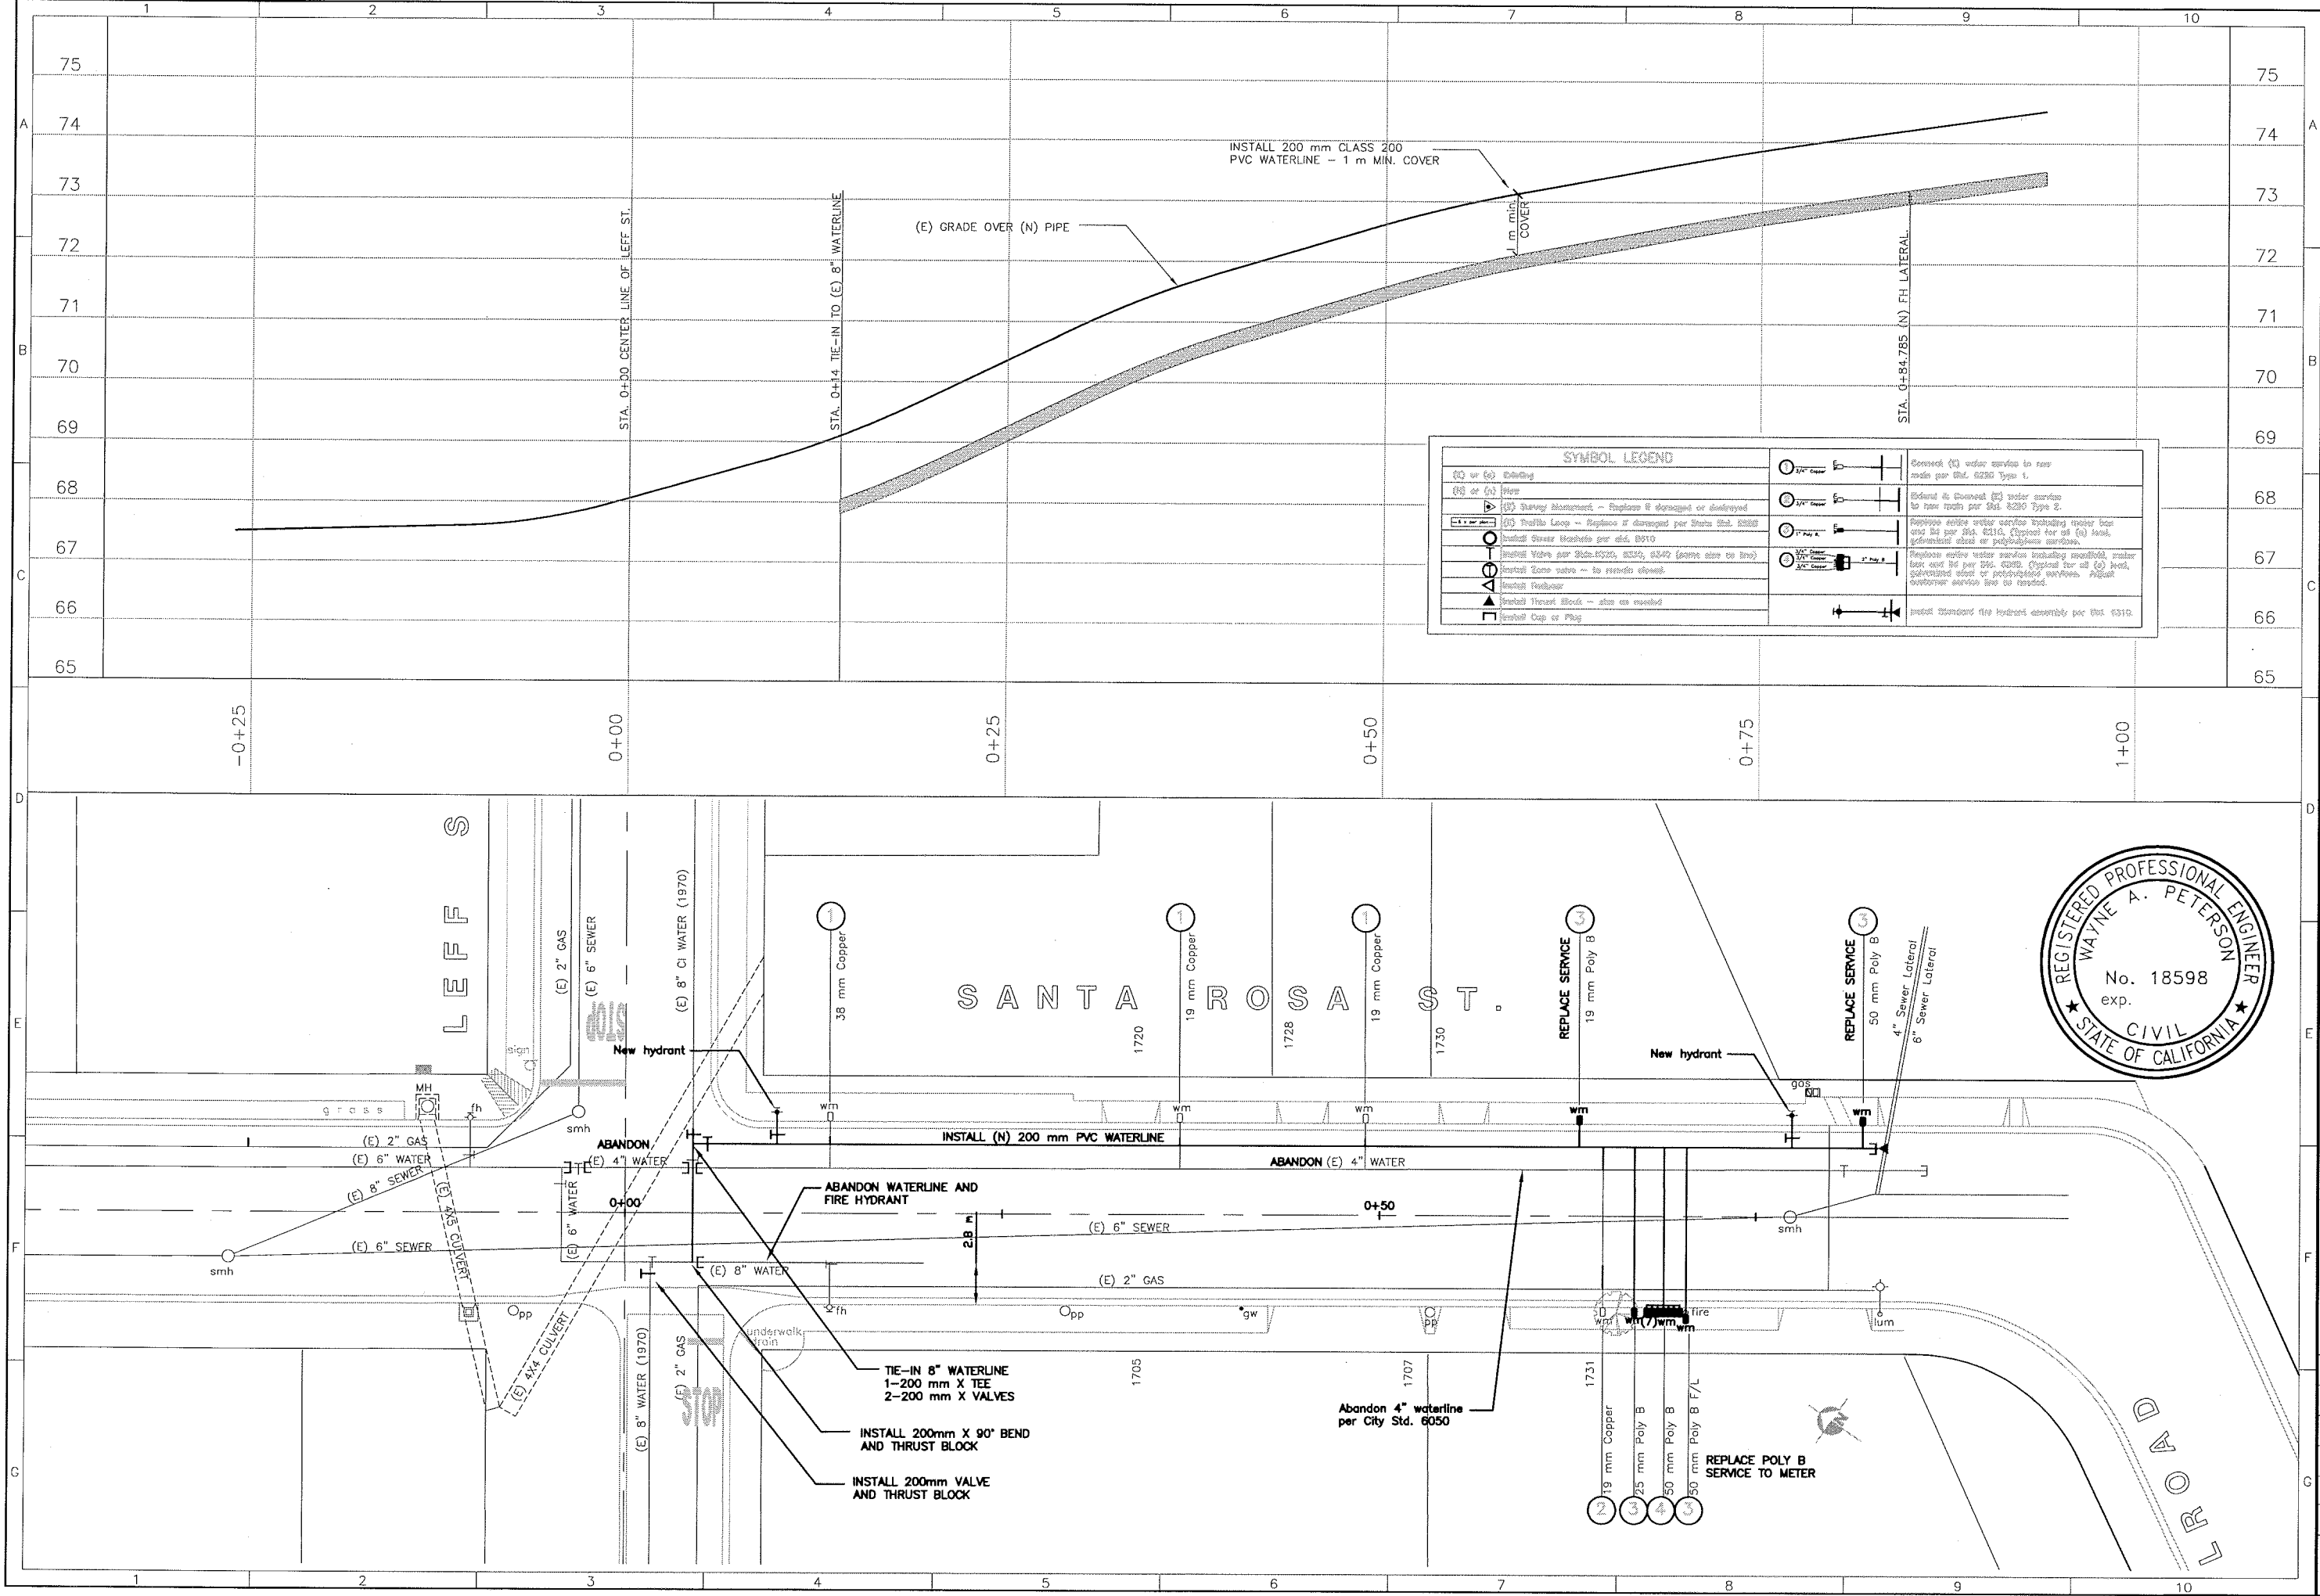

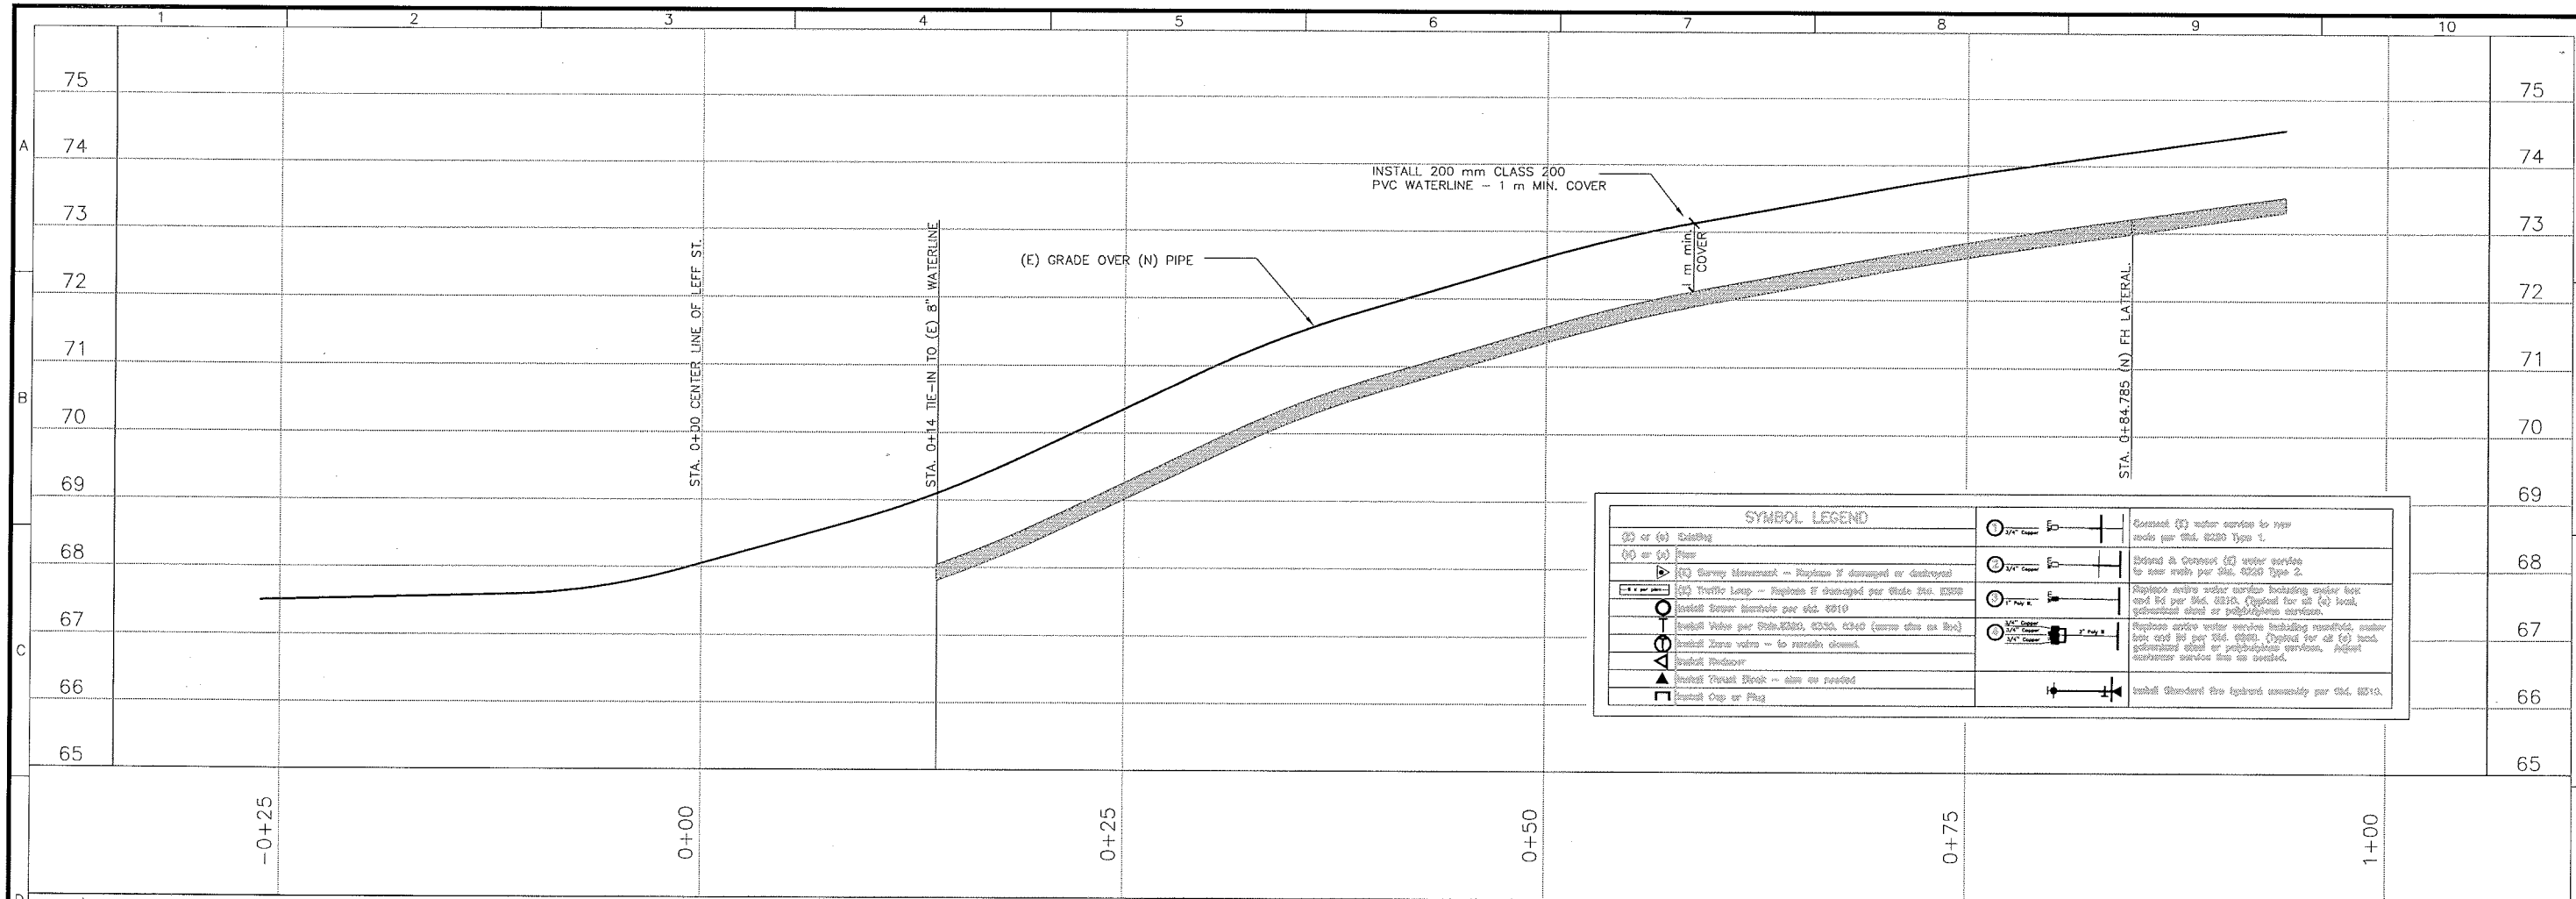



SYMBOL LEGEND	
(E) or (N) Existing	Symbol for existing water service to new meter per City Std. 8220 Type 1.
(E) or (N) New	Symbol for new water service to new meter per City Std. 8220 Type 2.
(E) Survey Manhole - Replace if damaged or destroyed	Symbol for replace water service including water box and 1/2\"/>
(E) Traffic Loop - Replace if damaged per City Std. 8220	Symbol for replace water service including water box and 1/2\"/>
Install Sewer Manhole per City Std. 8210	Symbol for replace water service including water box and 1/2\"/>
Install Valve per City Std. 8230, 8235, 8240 (same size as box)	Symbol for replace water service including water box and 1/2\"/>
Install Elbow Valve - to match closed	Symbol for replace water service including water box and 1/2\"/>
Install Reducer	Symbol for replace water service including water box and 1/2\"/>
Install Thrust Block - same as noted	Symbol for replace water service including water box and 1/2\"/>
Install Cap or Plug	Symbol for replace water service including water box and 1/2\"/>

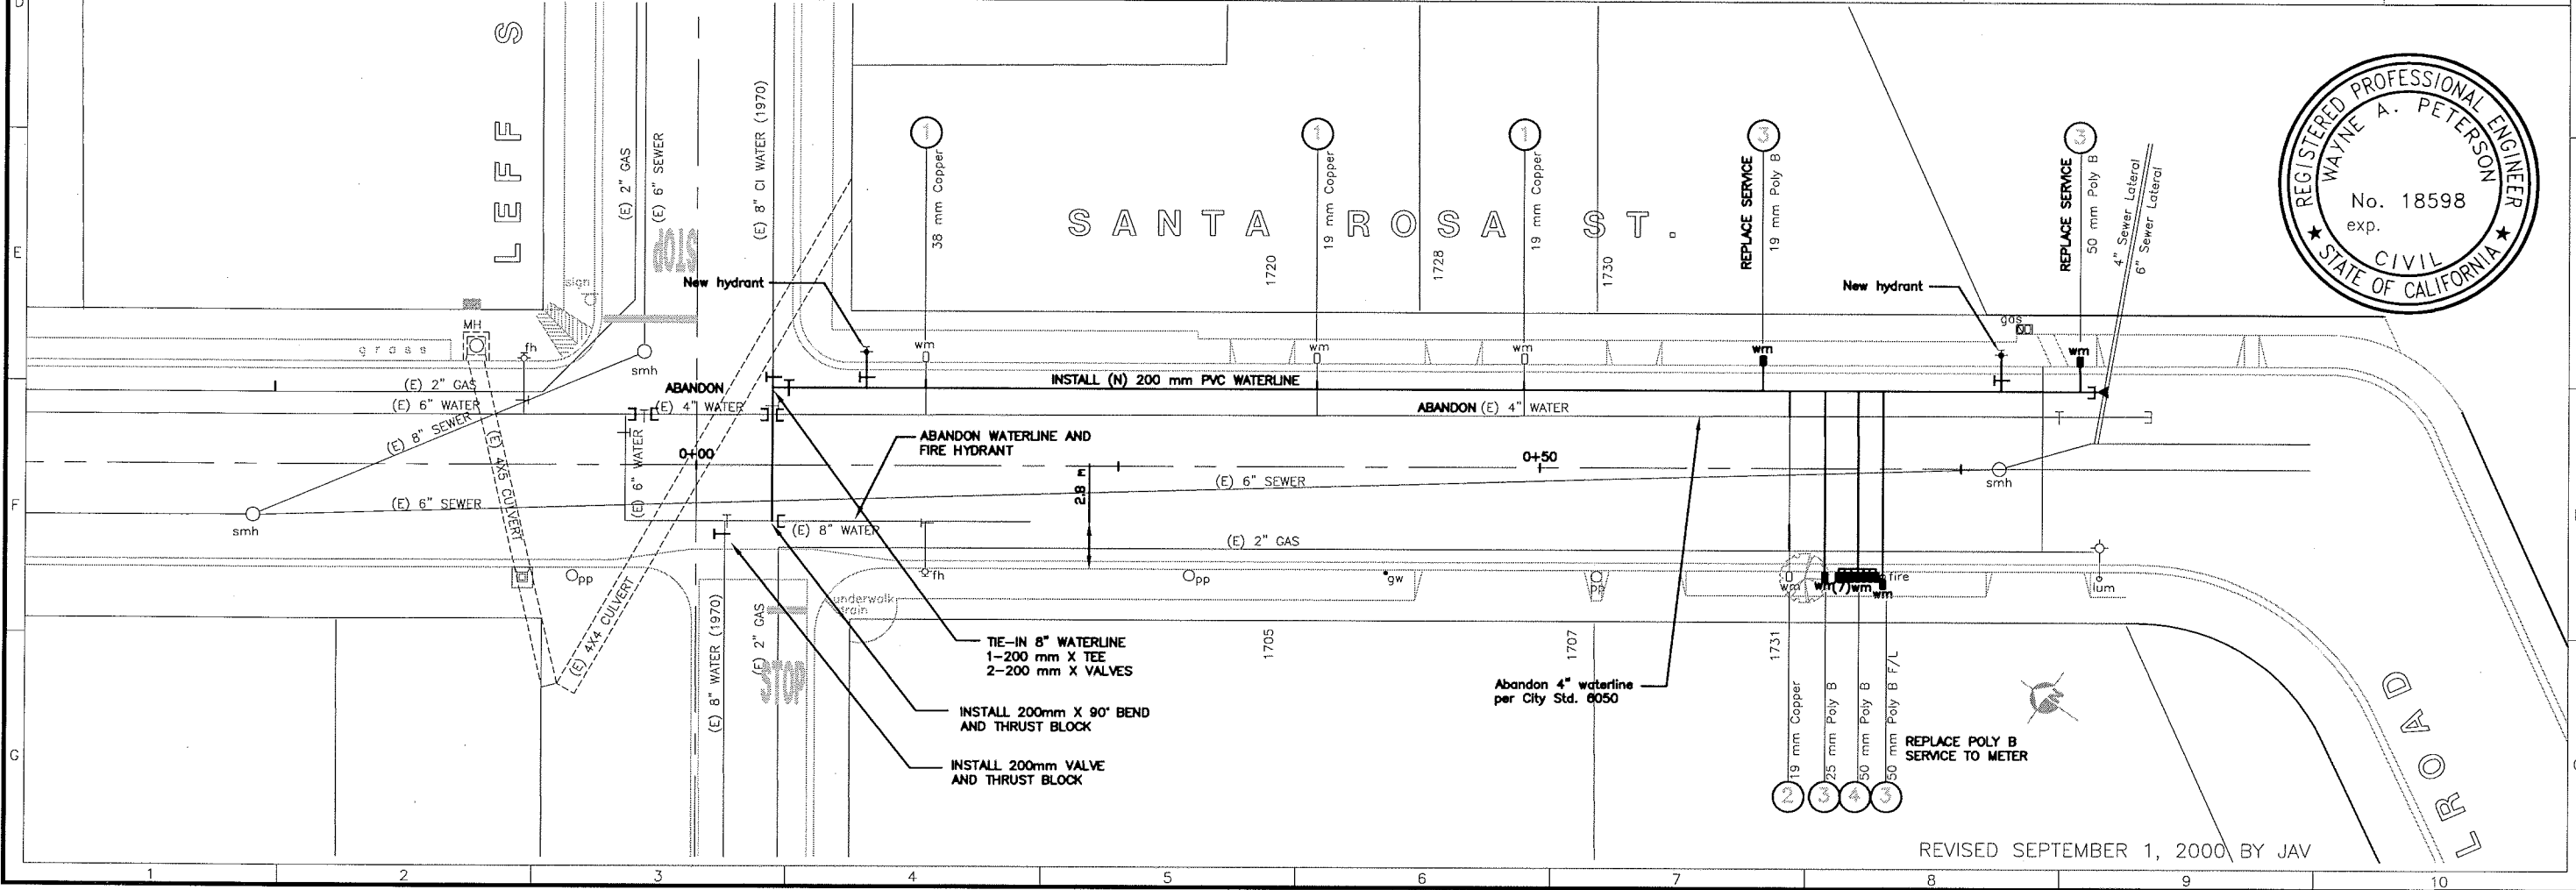

city of
san luis obispo

REVISIONS:	Drawn By & Date
	Record Drawing
	Drawn By & Date

PROJECT TITLE:	SANTA ROSA STREET
SHEET TITLE:	LEFF ST. - RAILROAD ST.
DESIGNED BY:	JV
DRAWN BY:	SR
CHECKED BY:	
APPROVED BY:	
DATE:	DEC 1999
CITY SPECIFICATION NO.	90033
SHEET NO.	2

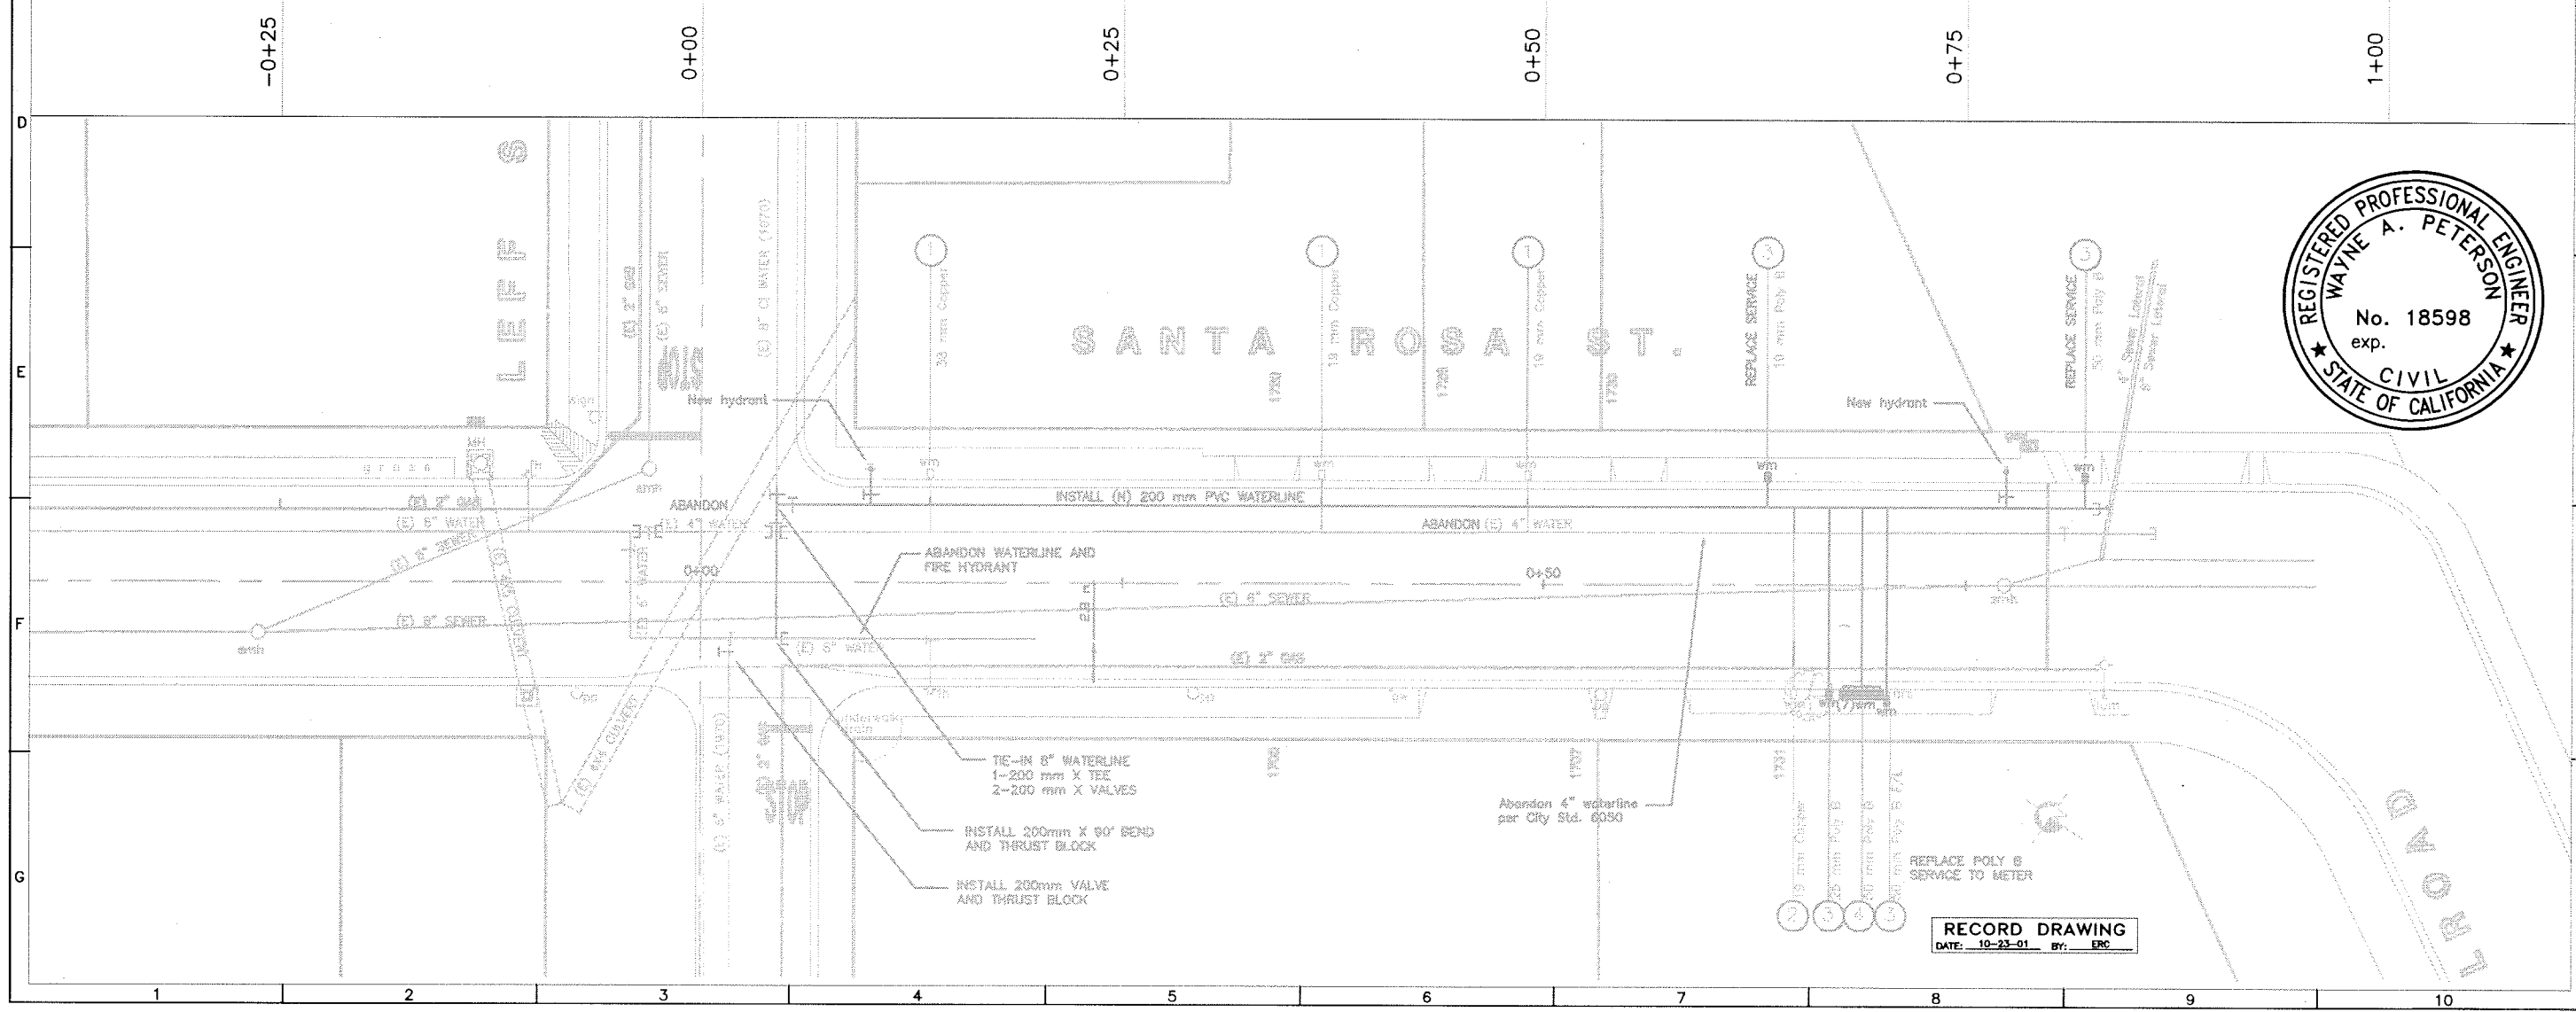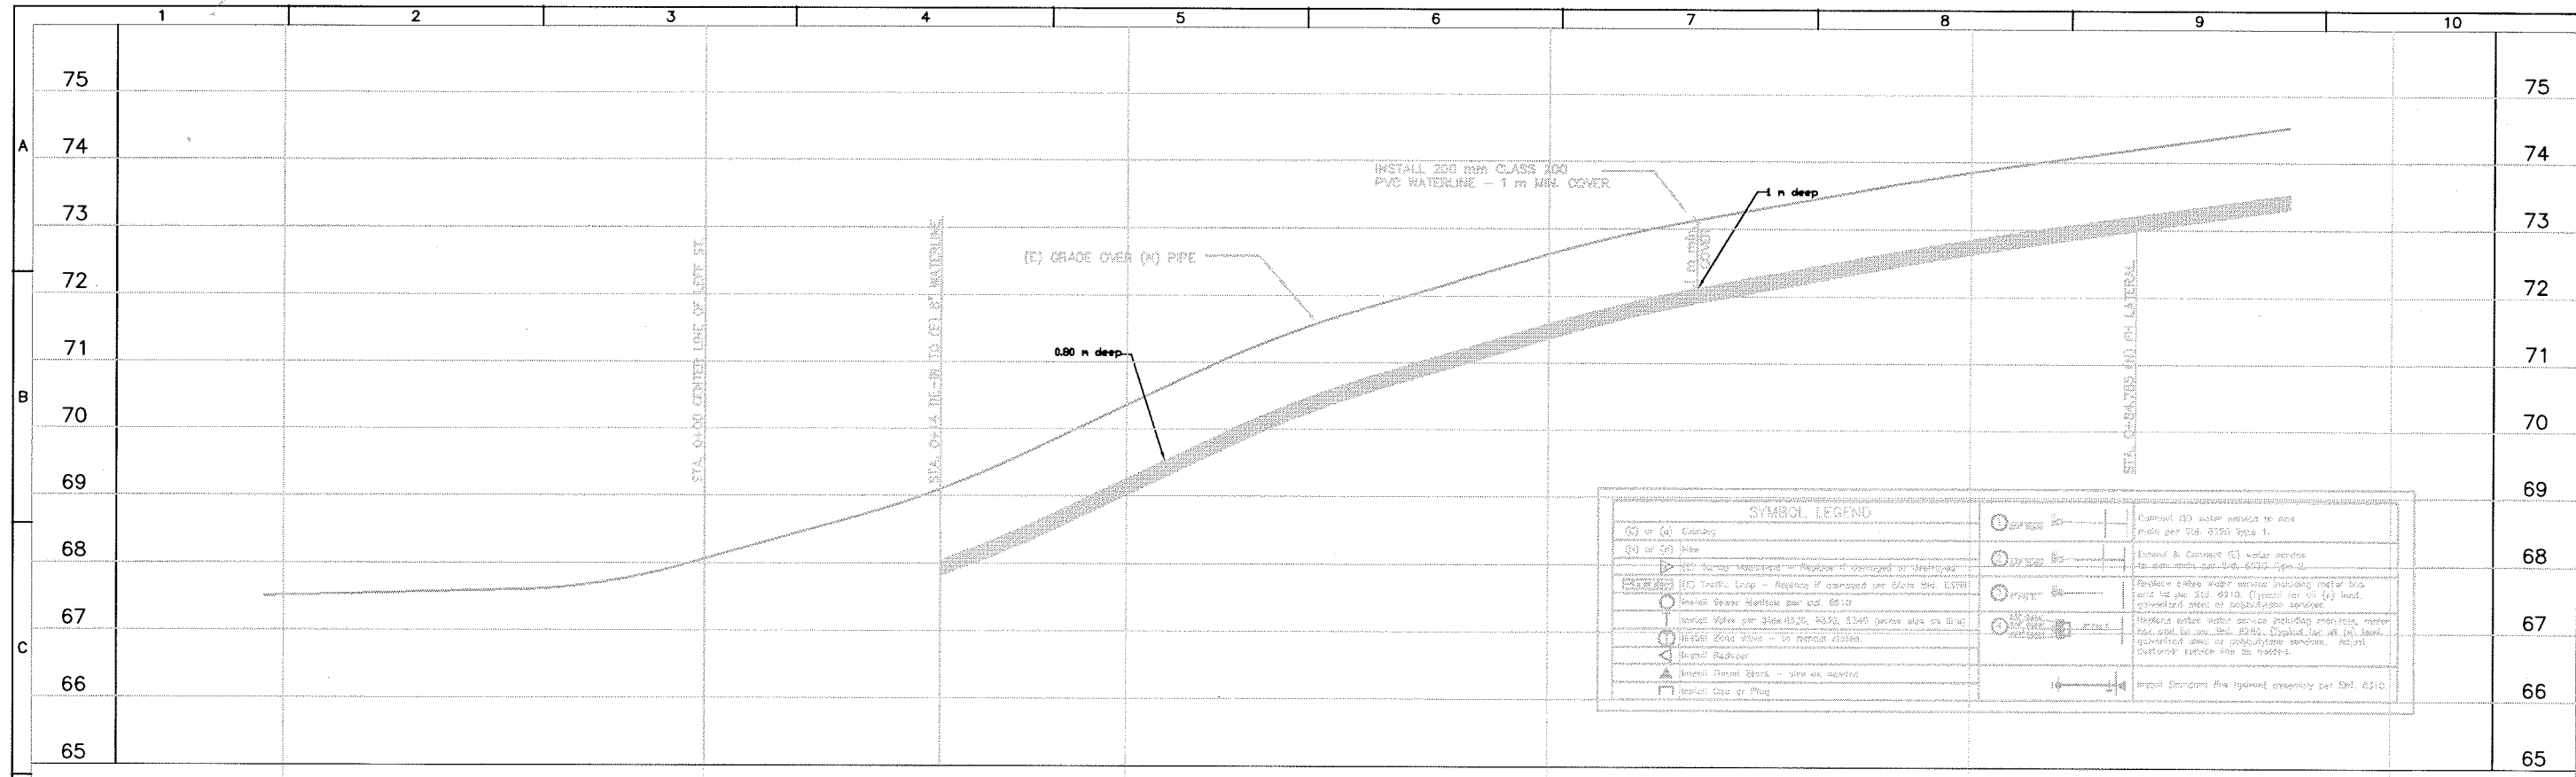

city of

san luis obispo

Drawn By & Date

Record Drawing

Drawn By & Date

Scale: 1:400

PROJECT TITLE

SANTA ROSA STREET

LEFT ST. - RAILROAD ST.

DESIGNED BY:

DATE:

CITY SPECIFICATION NO.

SHEET NO.

DRAWN BY:


CHECKED BY:

APPROVED BY:


DEC 1999

90033

2a of 25

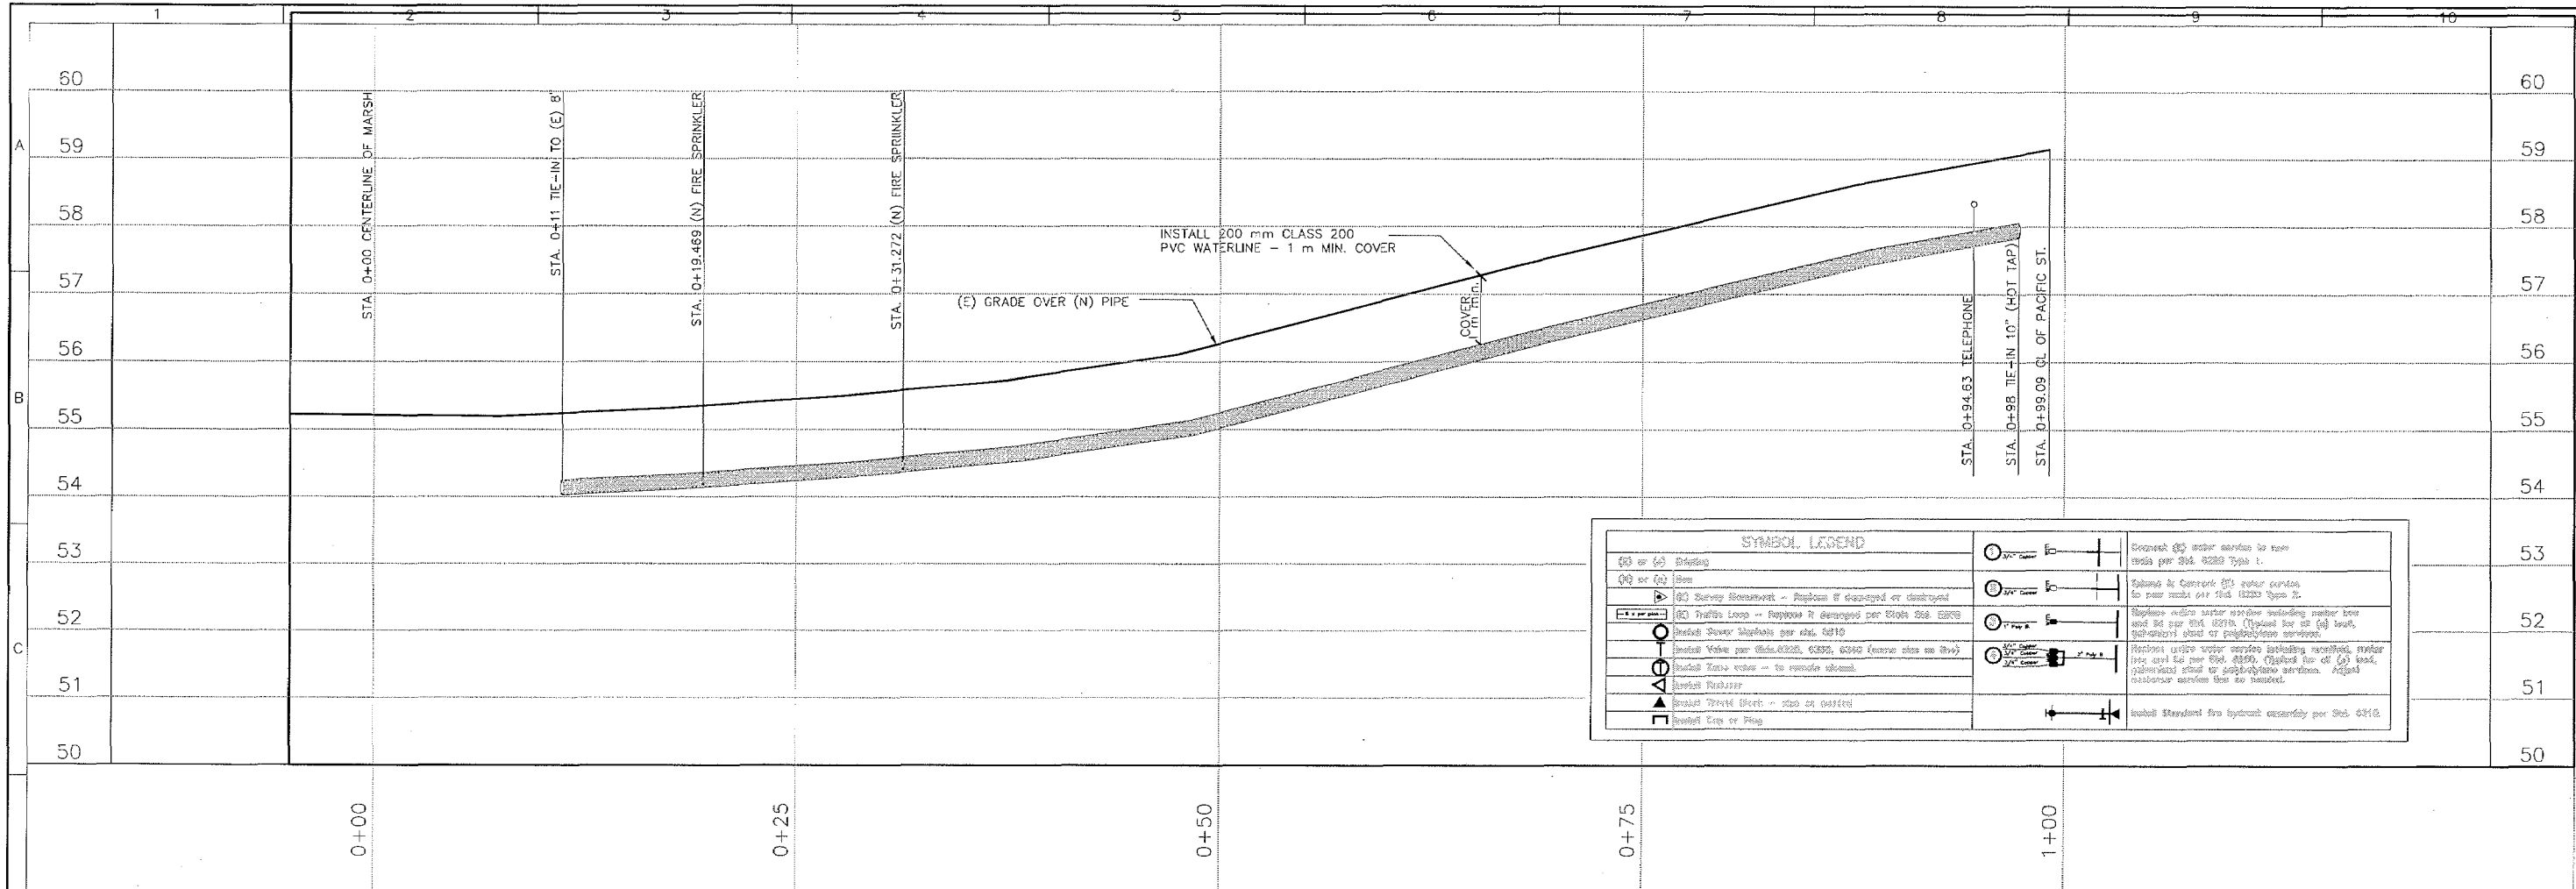

SYMBOL LEGEND	
(E) or (N) Existing	Symbol for existing waterline
(E) or (N) New	Symbol for new waterline
Survey Monument - Replaced if damaged or destroyed	Symbol for survey monument
Traffic Loop - Replaced if damaged per State Std. 6505	Symbol for traffic loop
Water Valve per State Std. 6505, 6506, 6507 (house size as shown)	Symbol for water valve
Water Gate valve - to remote control	Symbol for water gate valve
Water Reducer	Symbol for water reducer
Water Break Valve - open or closed	Symbol for water break valve
Water End or Plug	Symbol for water end or plug
Water to Control (E) water service to new main per State Std. 6505 Type 1.	Symbol for water to control
Water to Control (E) water service to new main per State Std. 6505 Type 2.	Symbol for water to control
Water to Control (E) water service to new main per State Std. 6505 Type 3.	Symbol for water to control
Water to Control (E) water service to new main per State Std. 6505 Type 4.	Symbol for water to control
Water to Control (E) water service to new main per State Std. 6505 Type 5.	Symbol for water to control
Water to Control (E) water service to new main per State Std. 6505 Type 6.	Symbol for water to control
Water to Control (E) water service to new main per State Std. 6505 Type 7.	Symbol for water to control
Water to Control (E) water service to new main per State Std. 6505 Type 8.	Symbol for water to control
Water to Control (E) water service to new main per State Std. 6505 Type 9.	Symbol for water to control
Water to Control (E) water service to new main per State Std. 6505 Type 10.	Symbol for water to control

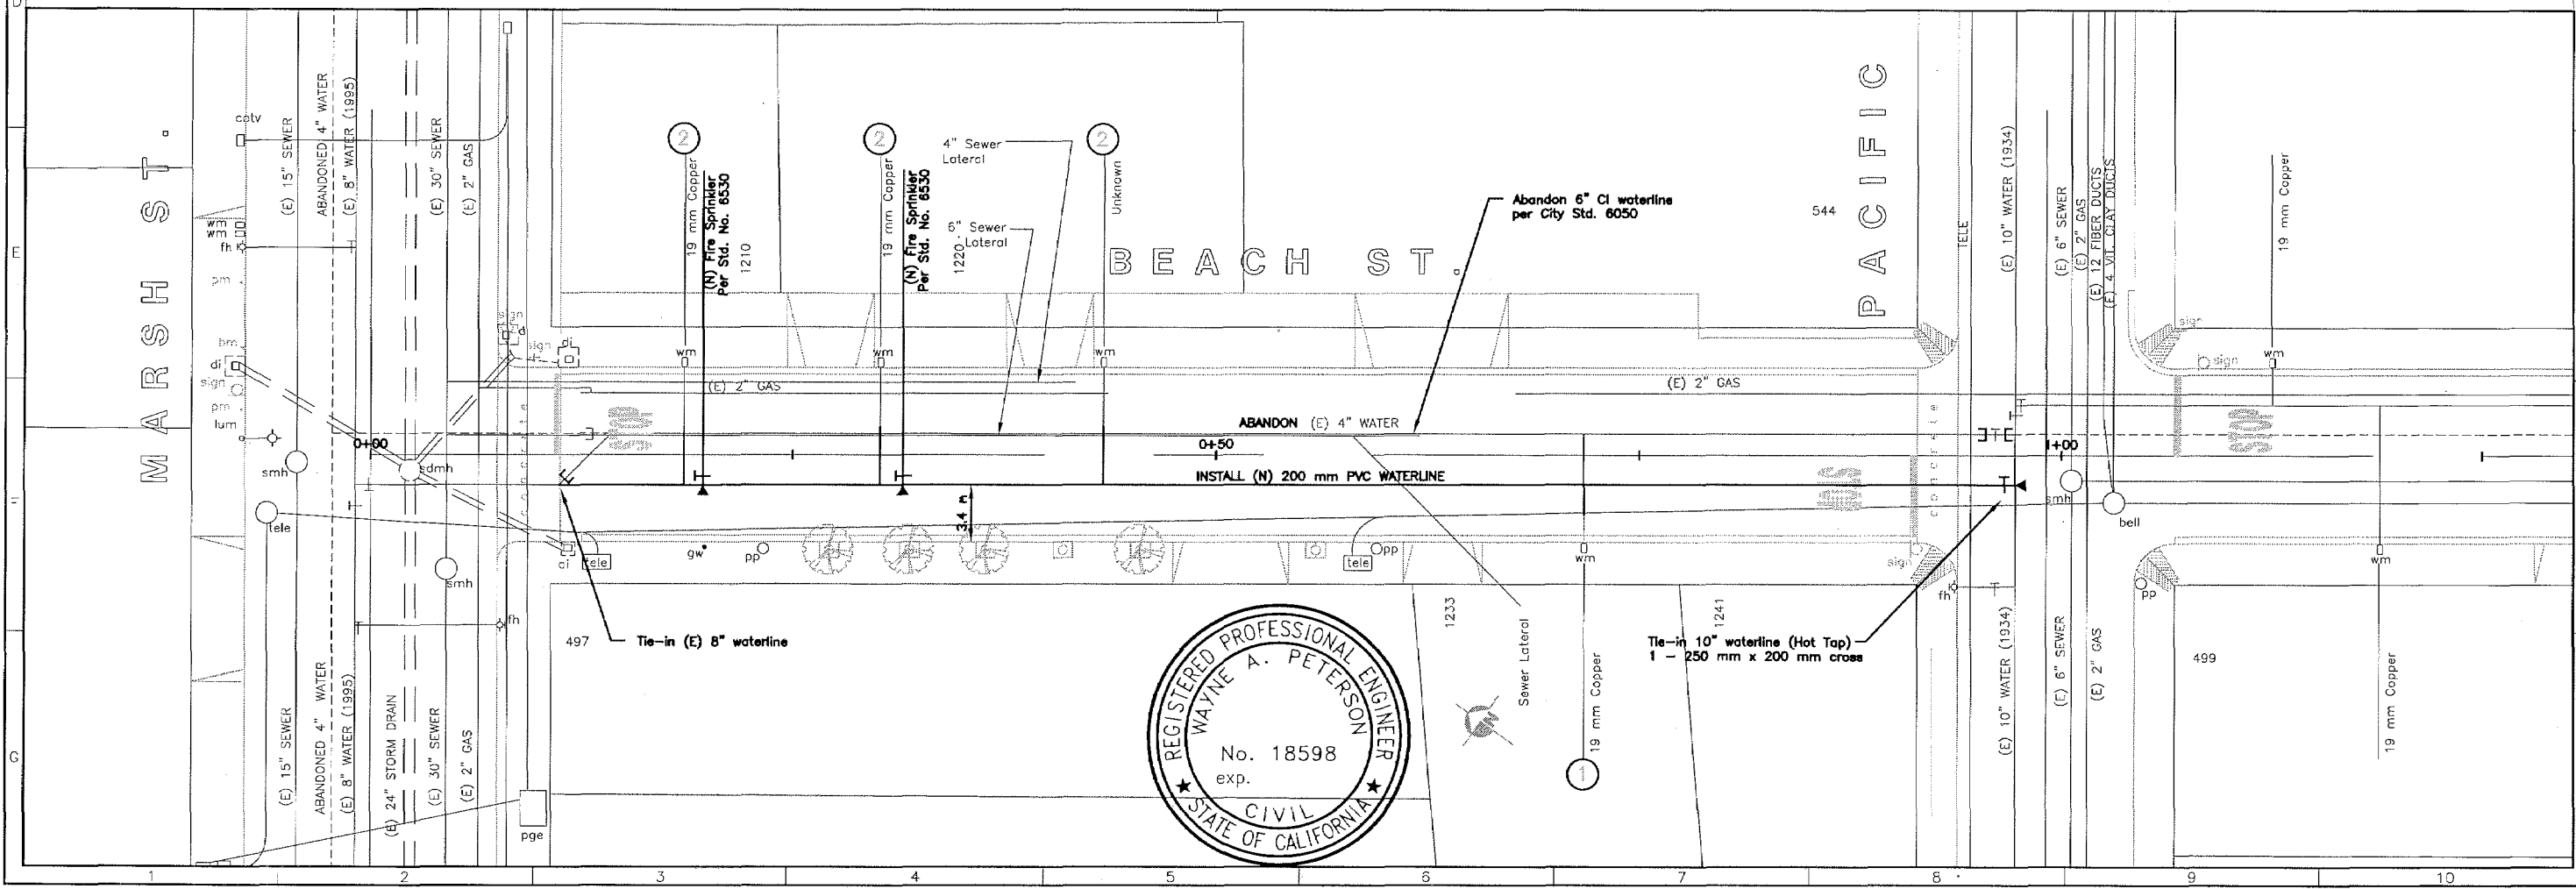

city of
san luis obispo

REVISIONS:

Drawn By & Date	Record Drawing	Drawn By & Date
-----------------	----------------	-----------------

Graphic Scale: 1" = 100'

PROJECT TITLE

BEACH STREET
MARSH ST. - PACIFIC ST.

DESIGNED BY: J.V.

DRAWN BY: SR


CHECKED BY: [Signature]

APPROVED BY: [Signature]

DATE: DEC 1999

CITY SPECIFICATION NO. 90033



SHEET NO. 3 of 25

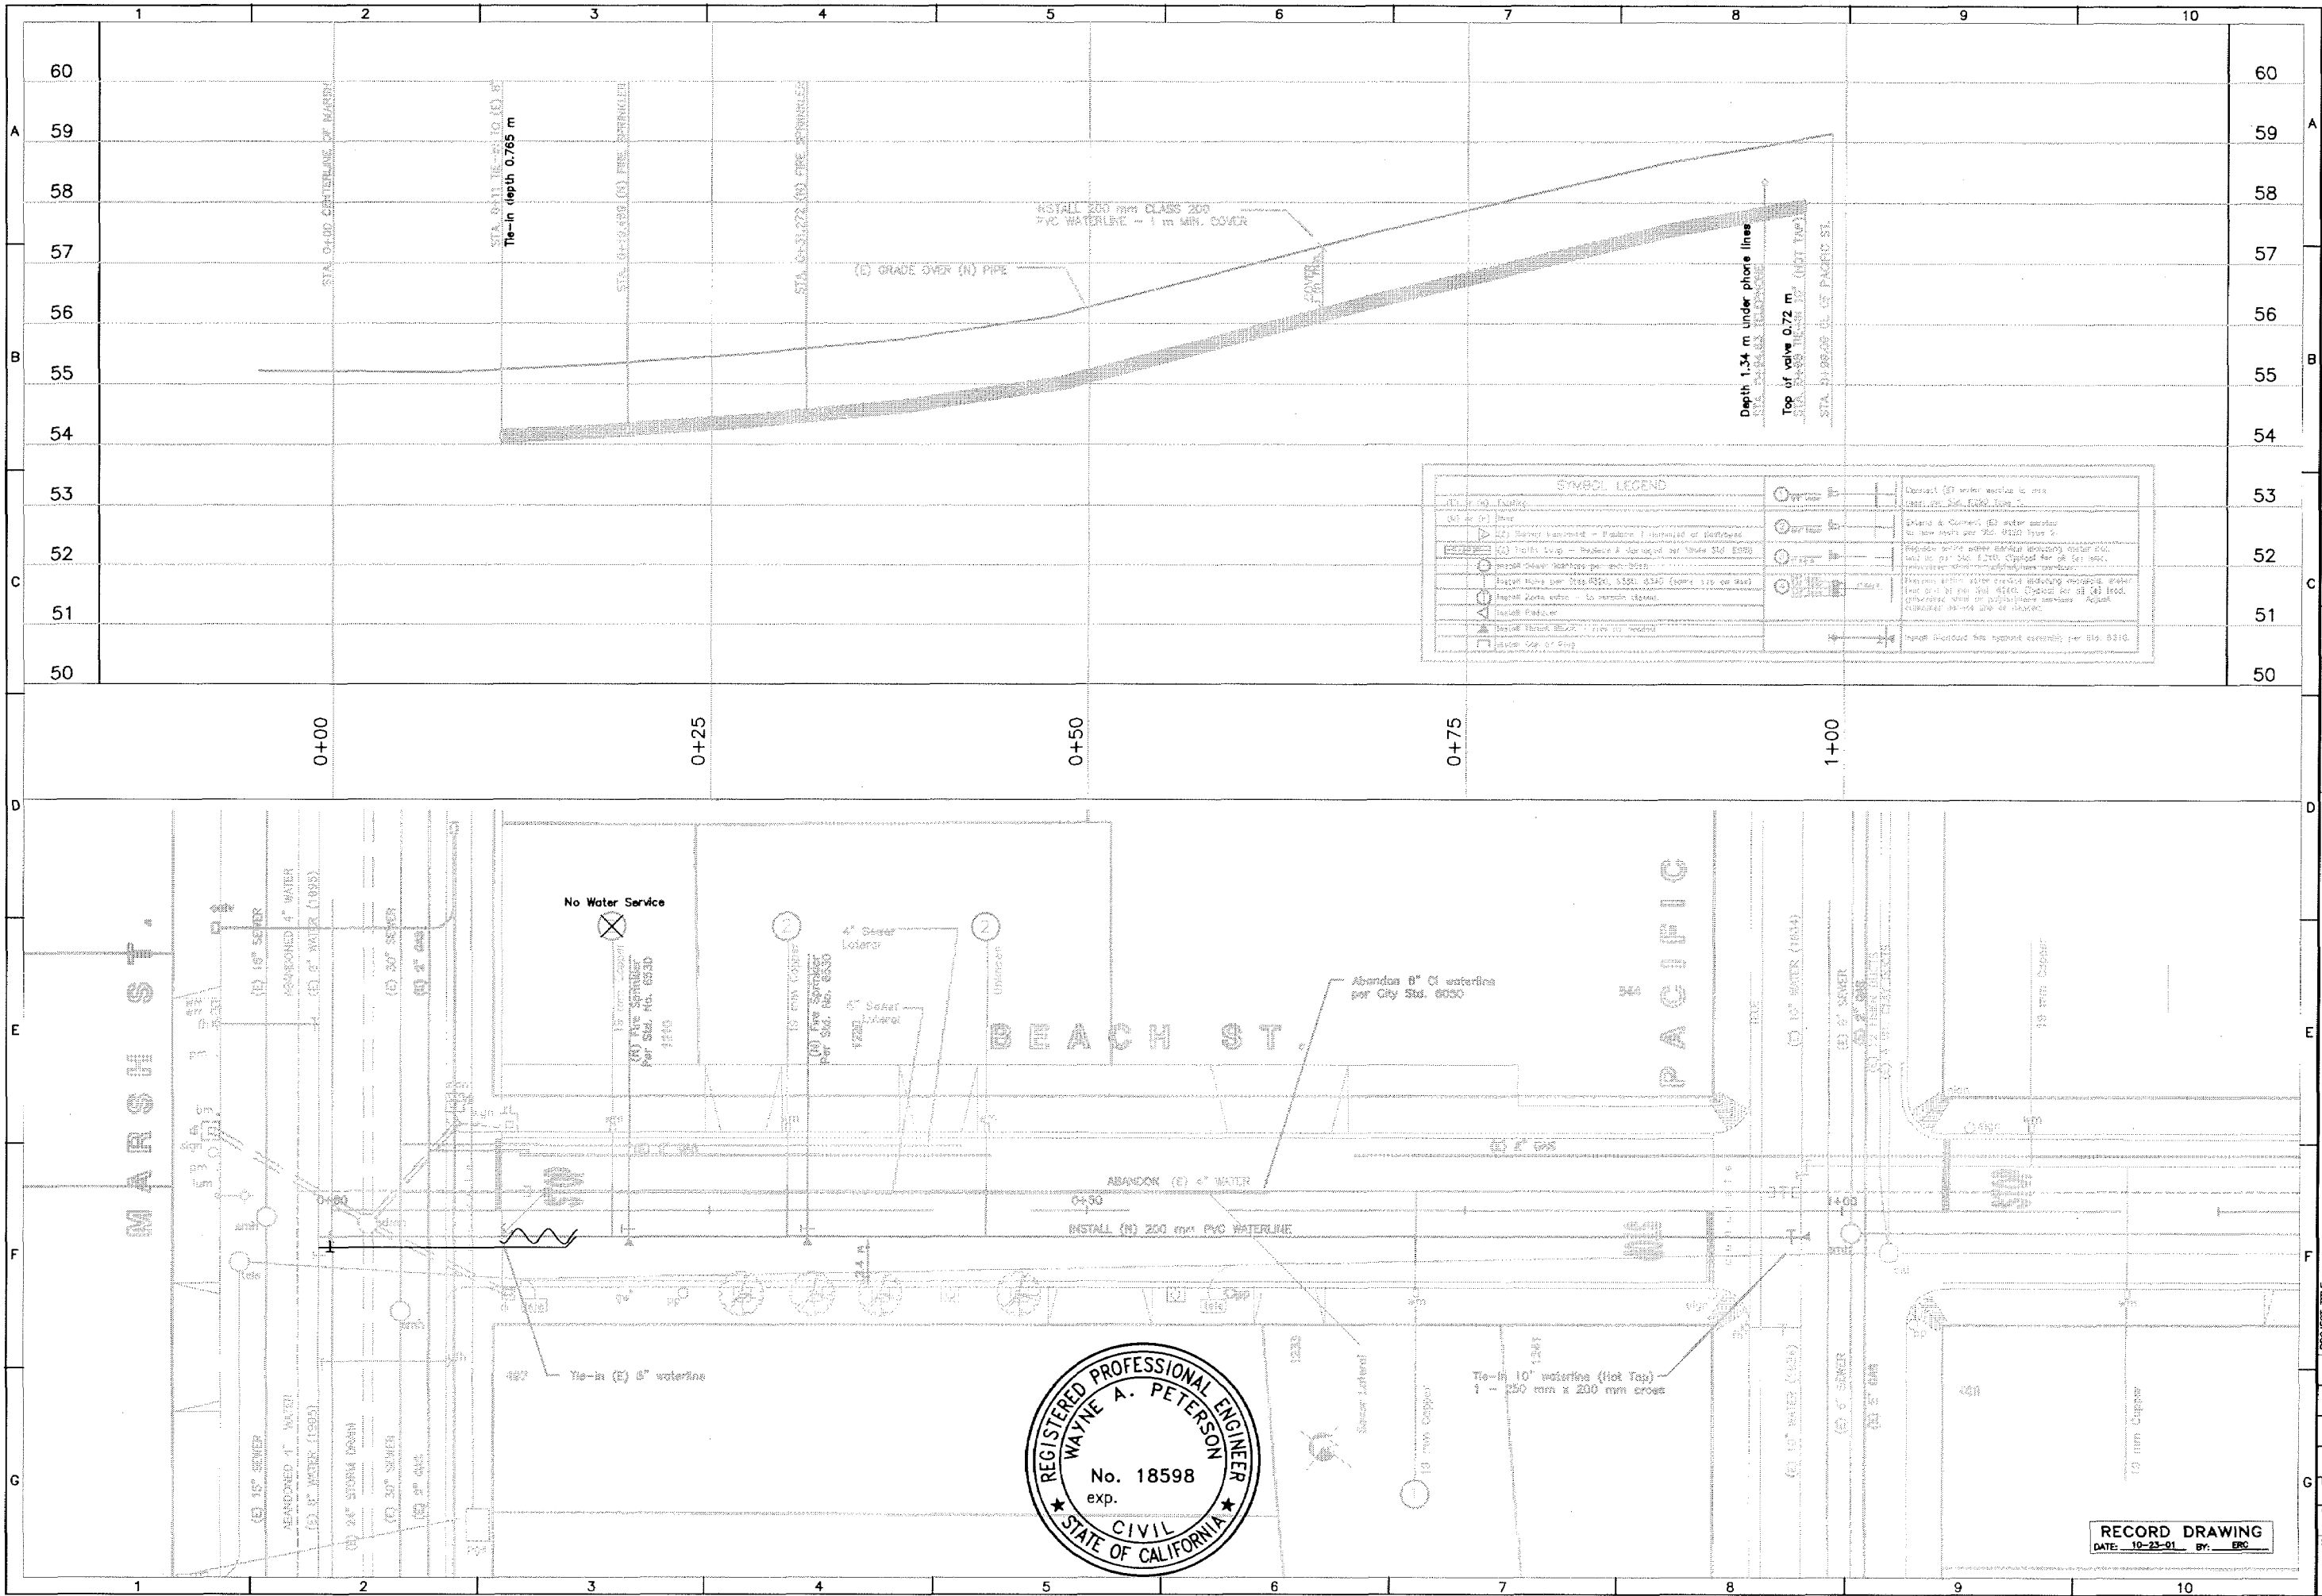

city of
san luis obispo

Drawn By & Date
Record Drawing
Drawn By & Date
Scale
1:400

PROJECT TITLE
BEACH STREET
MARSH ST. - PACIFIC ST.
DESIGNED BY:
JV
DRAWN BY:
SR
CHECKED BY:
CHECKED BY:
APPROVED BY:
DATE:
DEC 1999
CITY SPECIFICATION NO.
90033
SHEET NO.
3a of 25

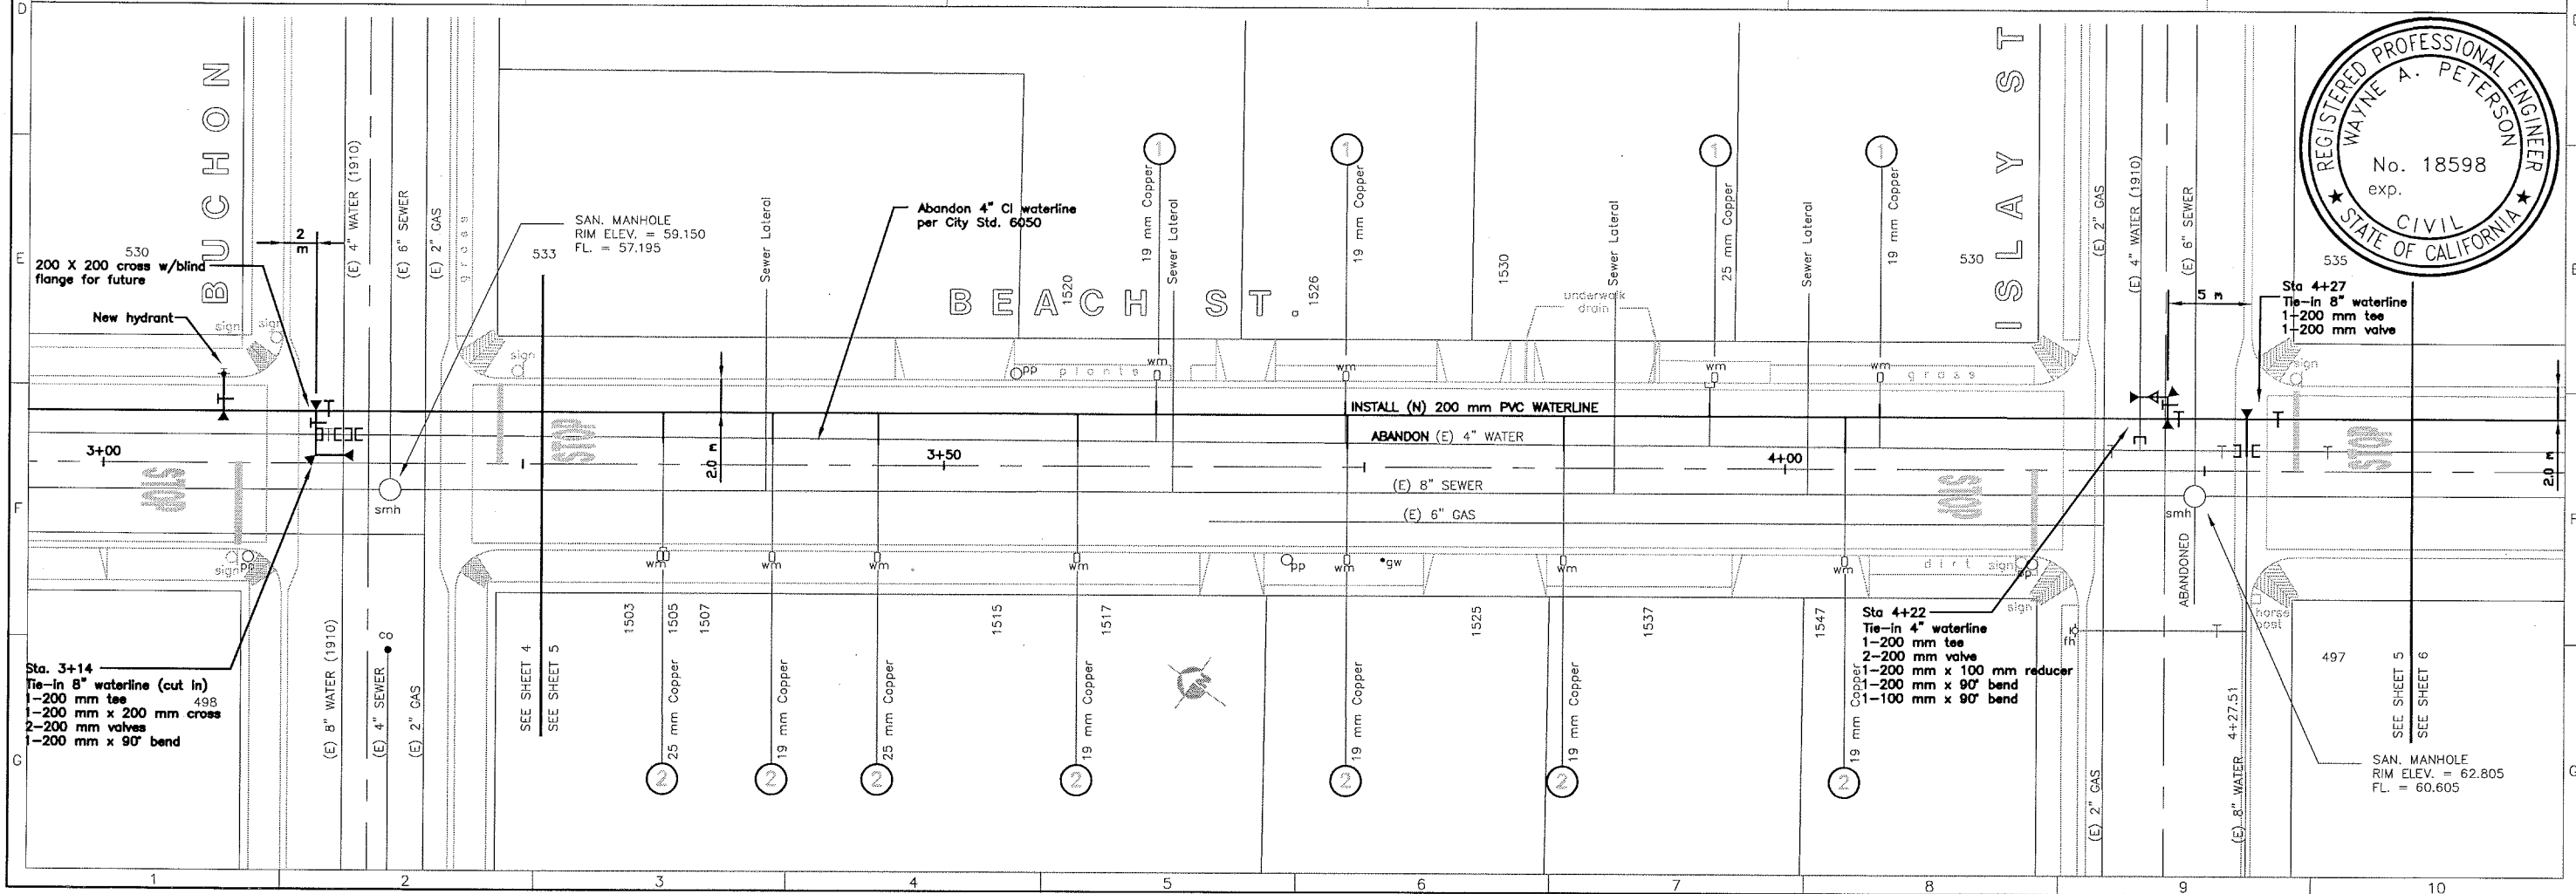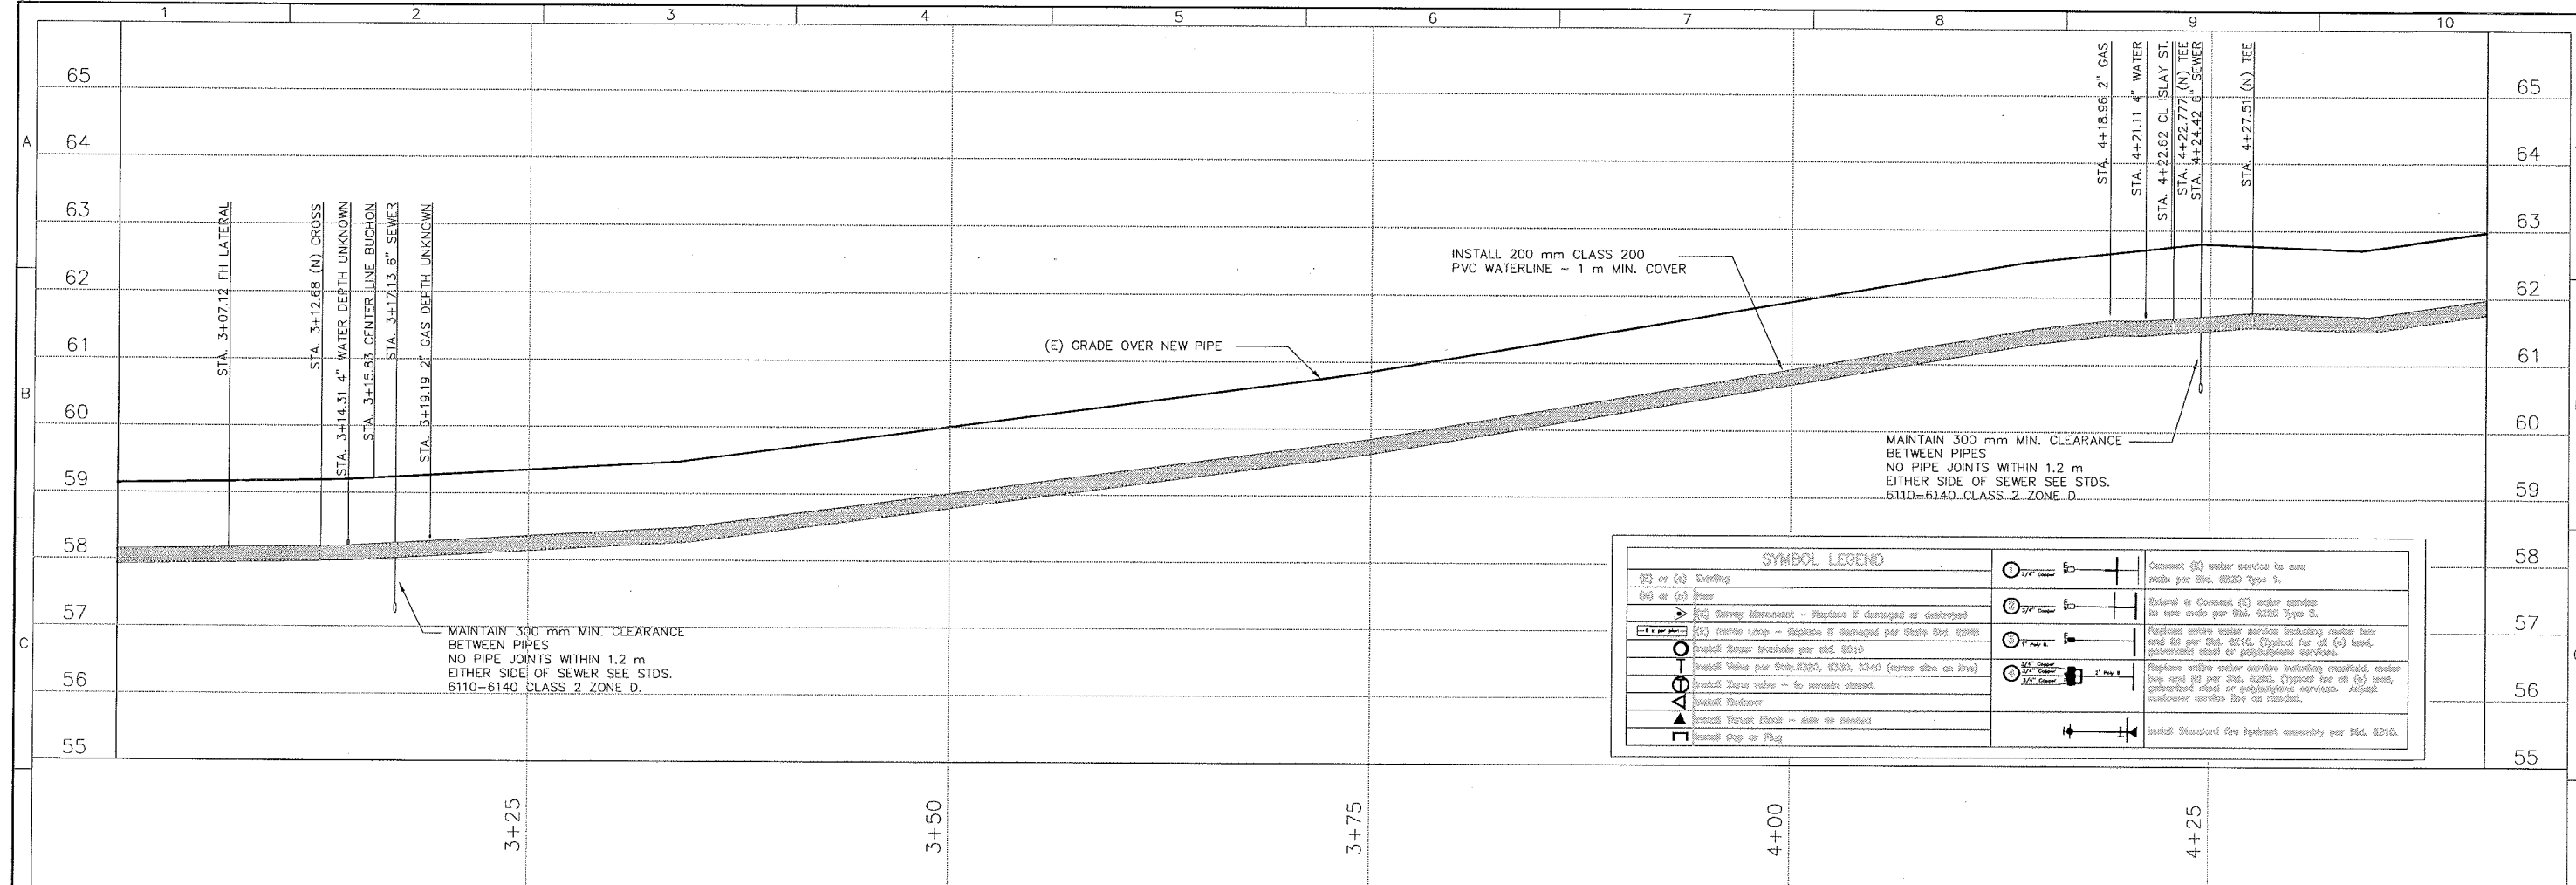

city of

san luis obispo

REVISIONS

Drawn By & Date

Record Drawing

Drawn By & Date

PROJECT TITLE

BEACH STREET

BUCHON ST. - ISLAY ST.

DESIGNED BY:

JV

DRAWN BY:

SR

CHECKED BY:

CHECKED BY

APPROVED BY:

APPROVED BY

DATE:



DEC 1999

CITY SPECIFICATION NO.

90033

SHEET NO.

5 of 25

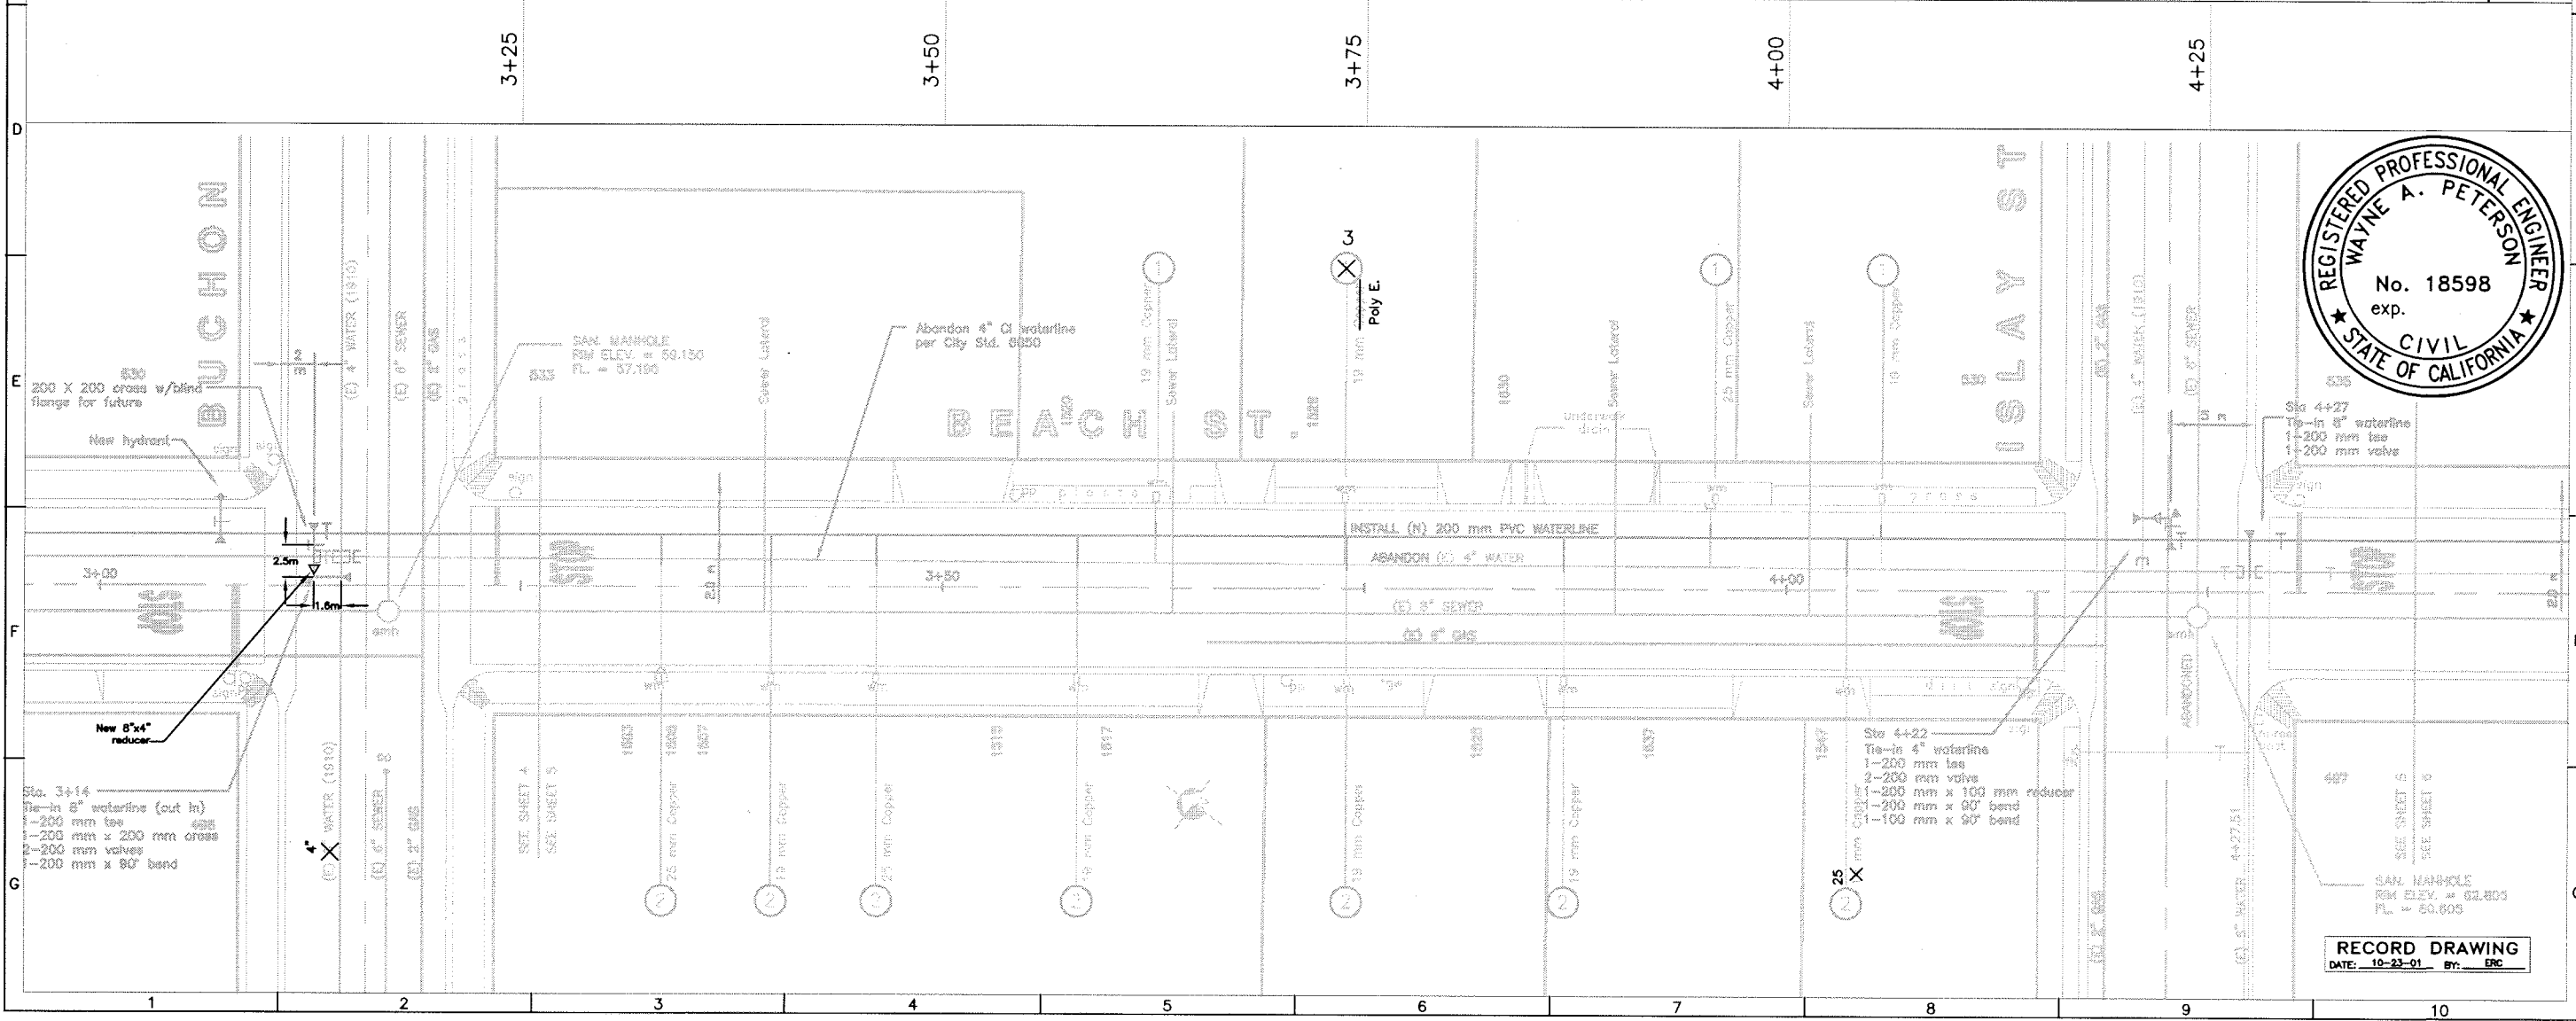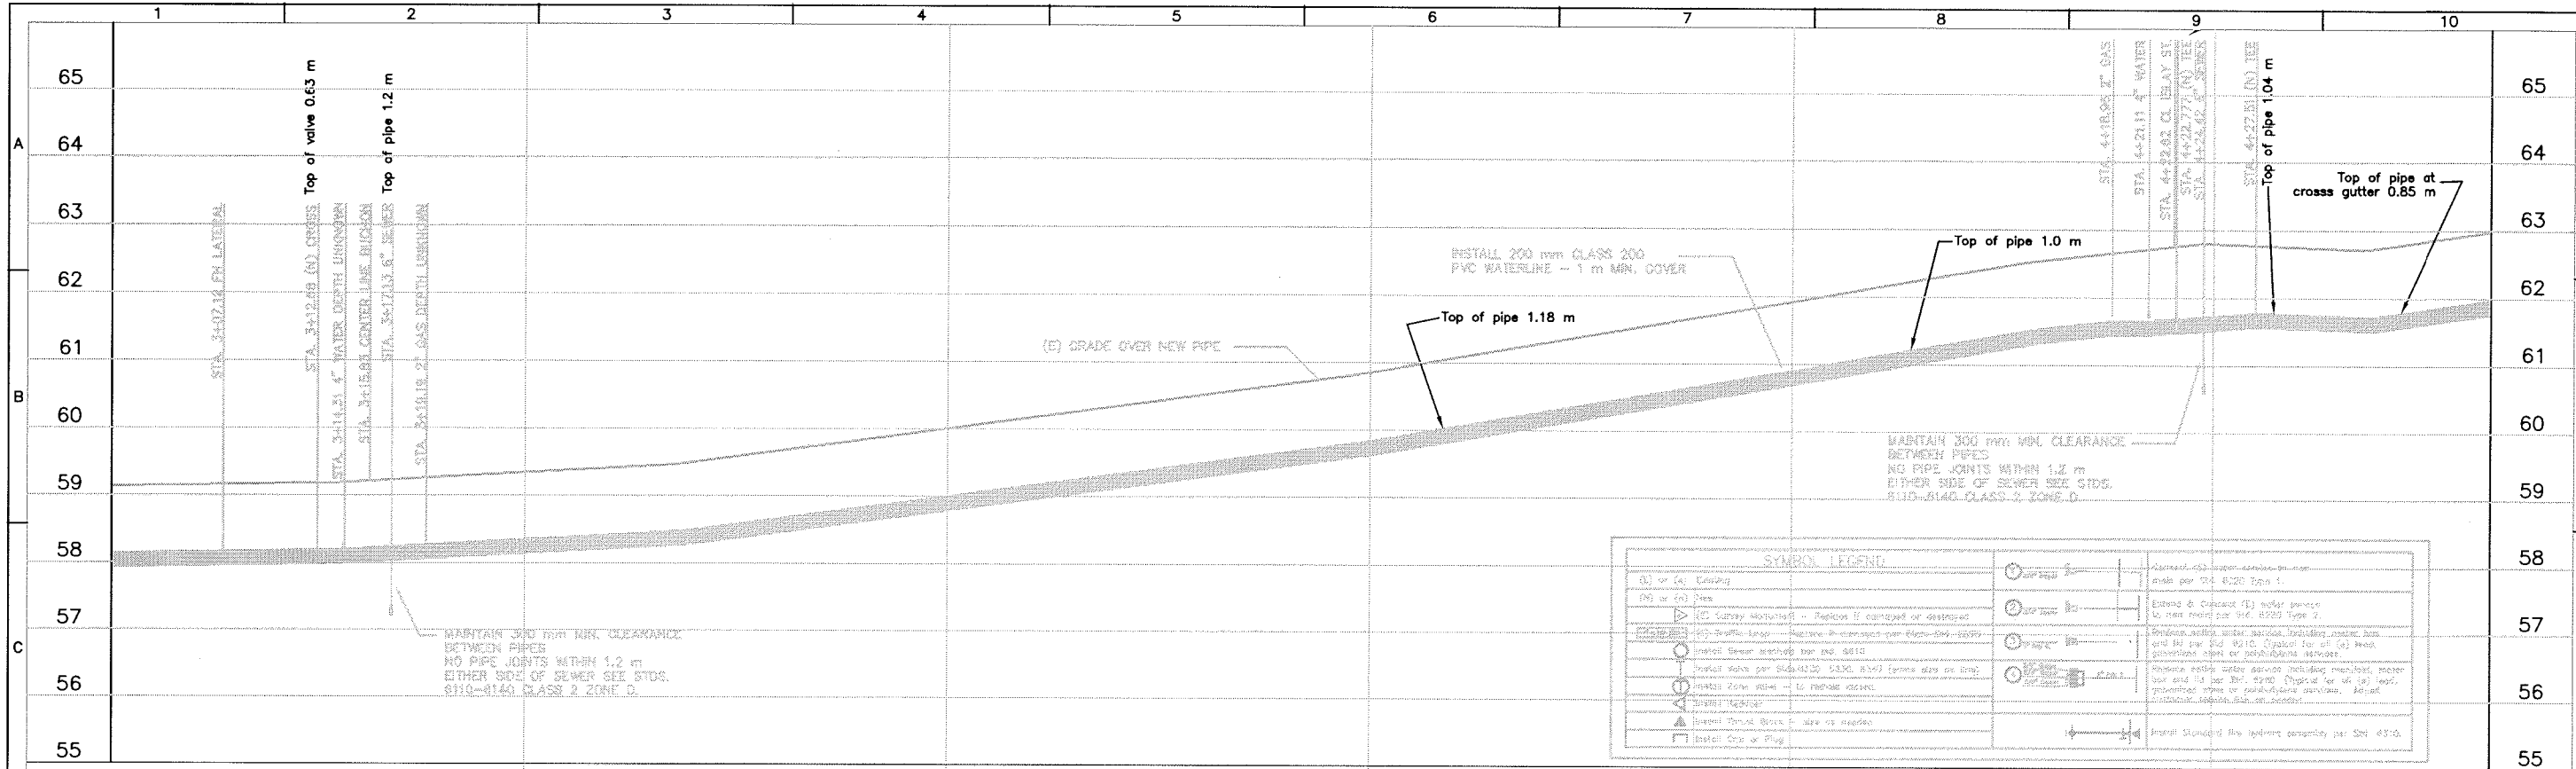

city of
san luis obispo

REVISIONS:

Drawn By & Date

Record Drawing

Drawn By & Date

PROJECT TITLE

BEACH STREET

BUCHON ST. - ISLAY ST.

DESIGNED BY:

JV

DRAWN BY:

SR

CHECKED BY:

CHECKED BY

APPROVED BY:

DATE:

DEC 1999

CITY SPECIFICATION NO.

90033

SHEET NO.

5a of 25

REGISTERED PROFESSIONAL ENGINEER

WAYNE A. PETERSON

No. 18598

exp.



CIVIL

STATE OF CALIFORNIA

RECORD DRAWING

DATE: 10-23-01

BY: EPC

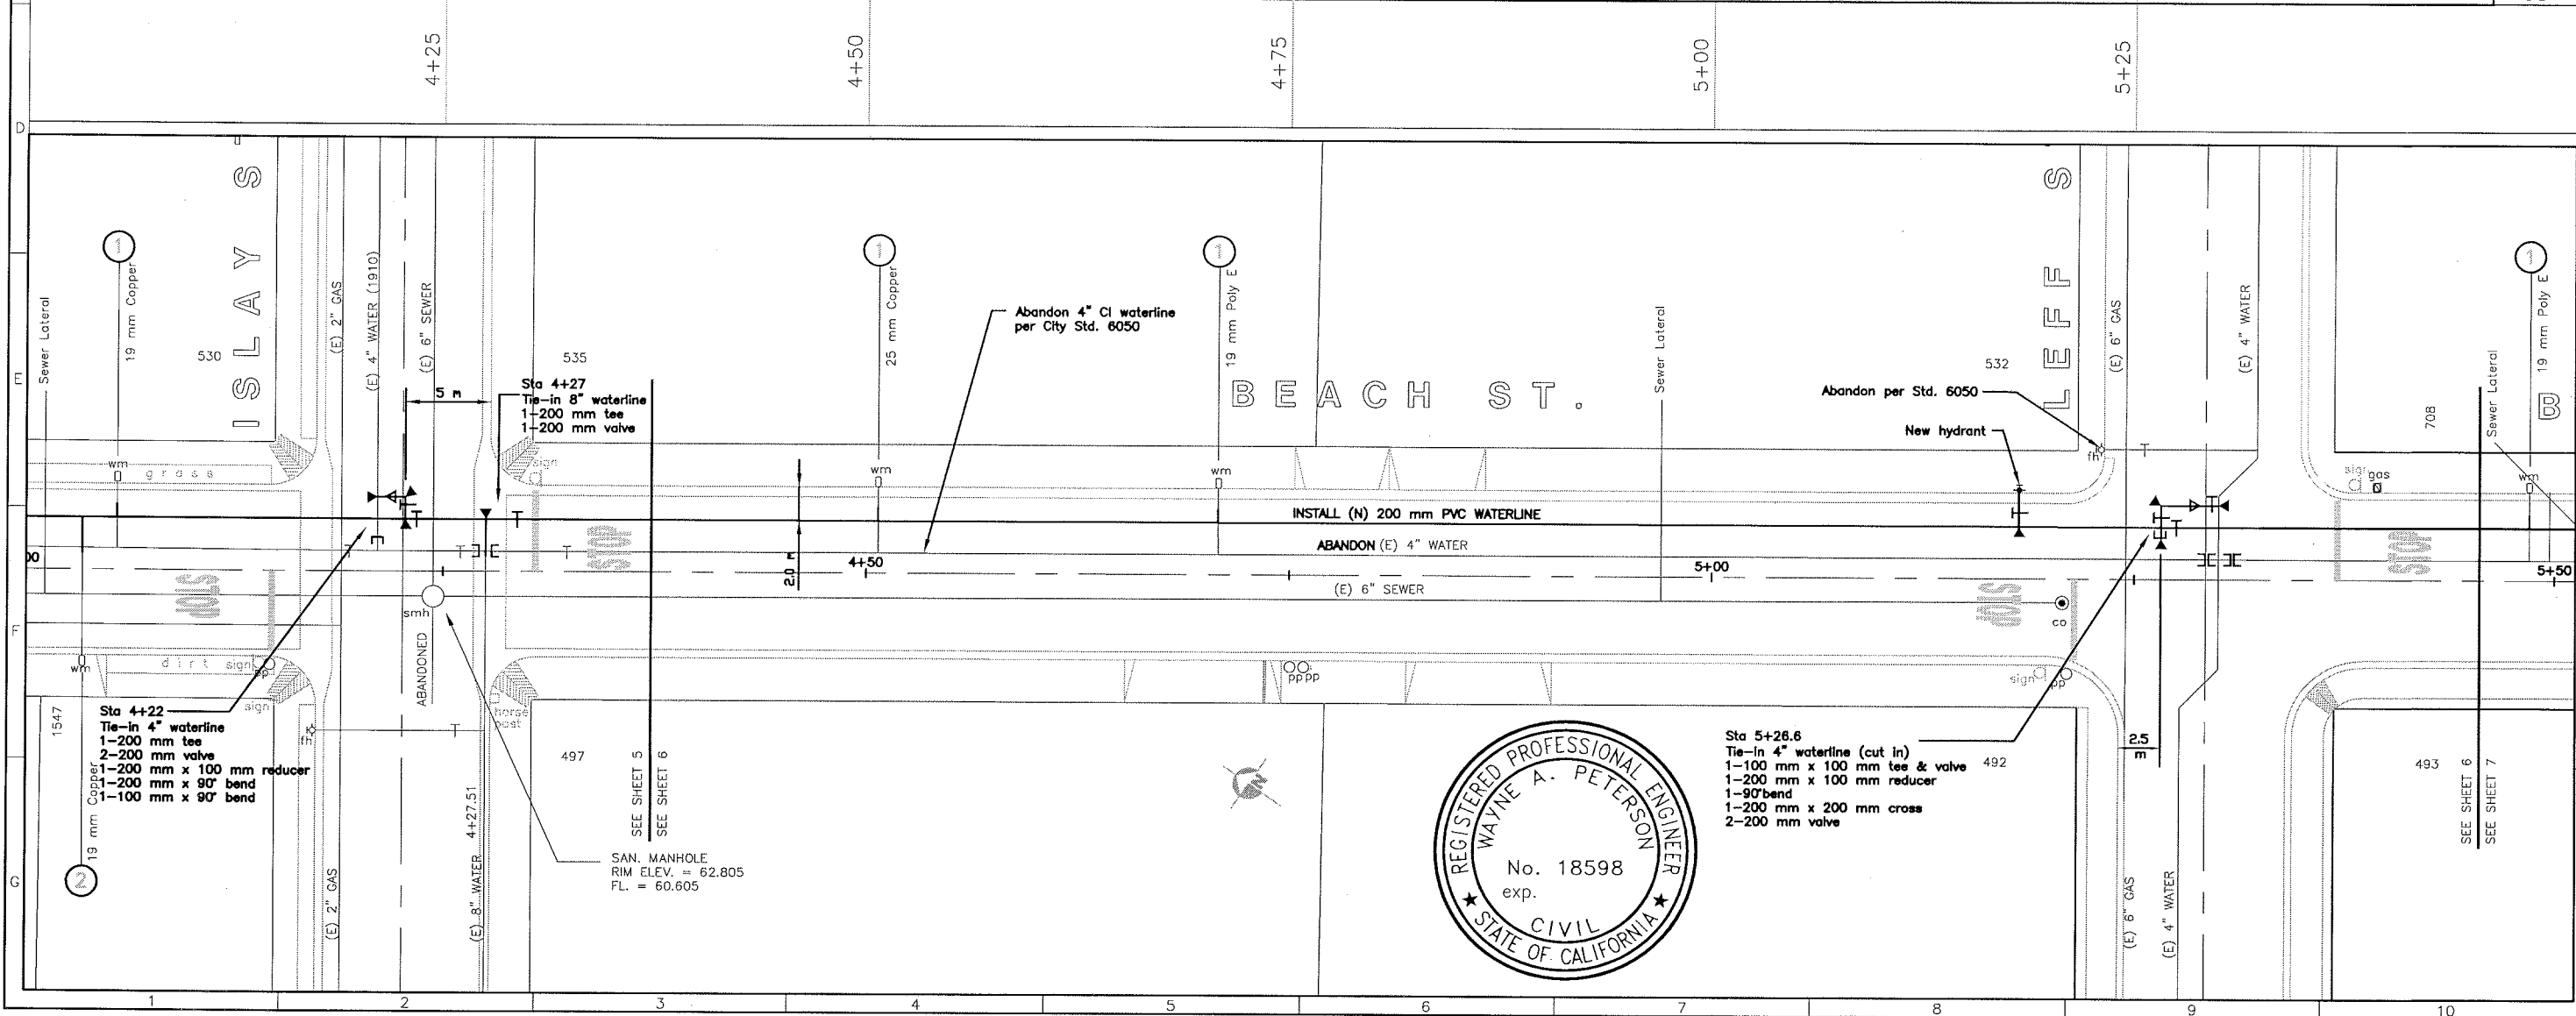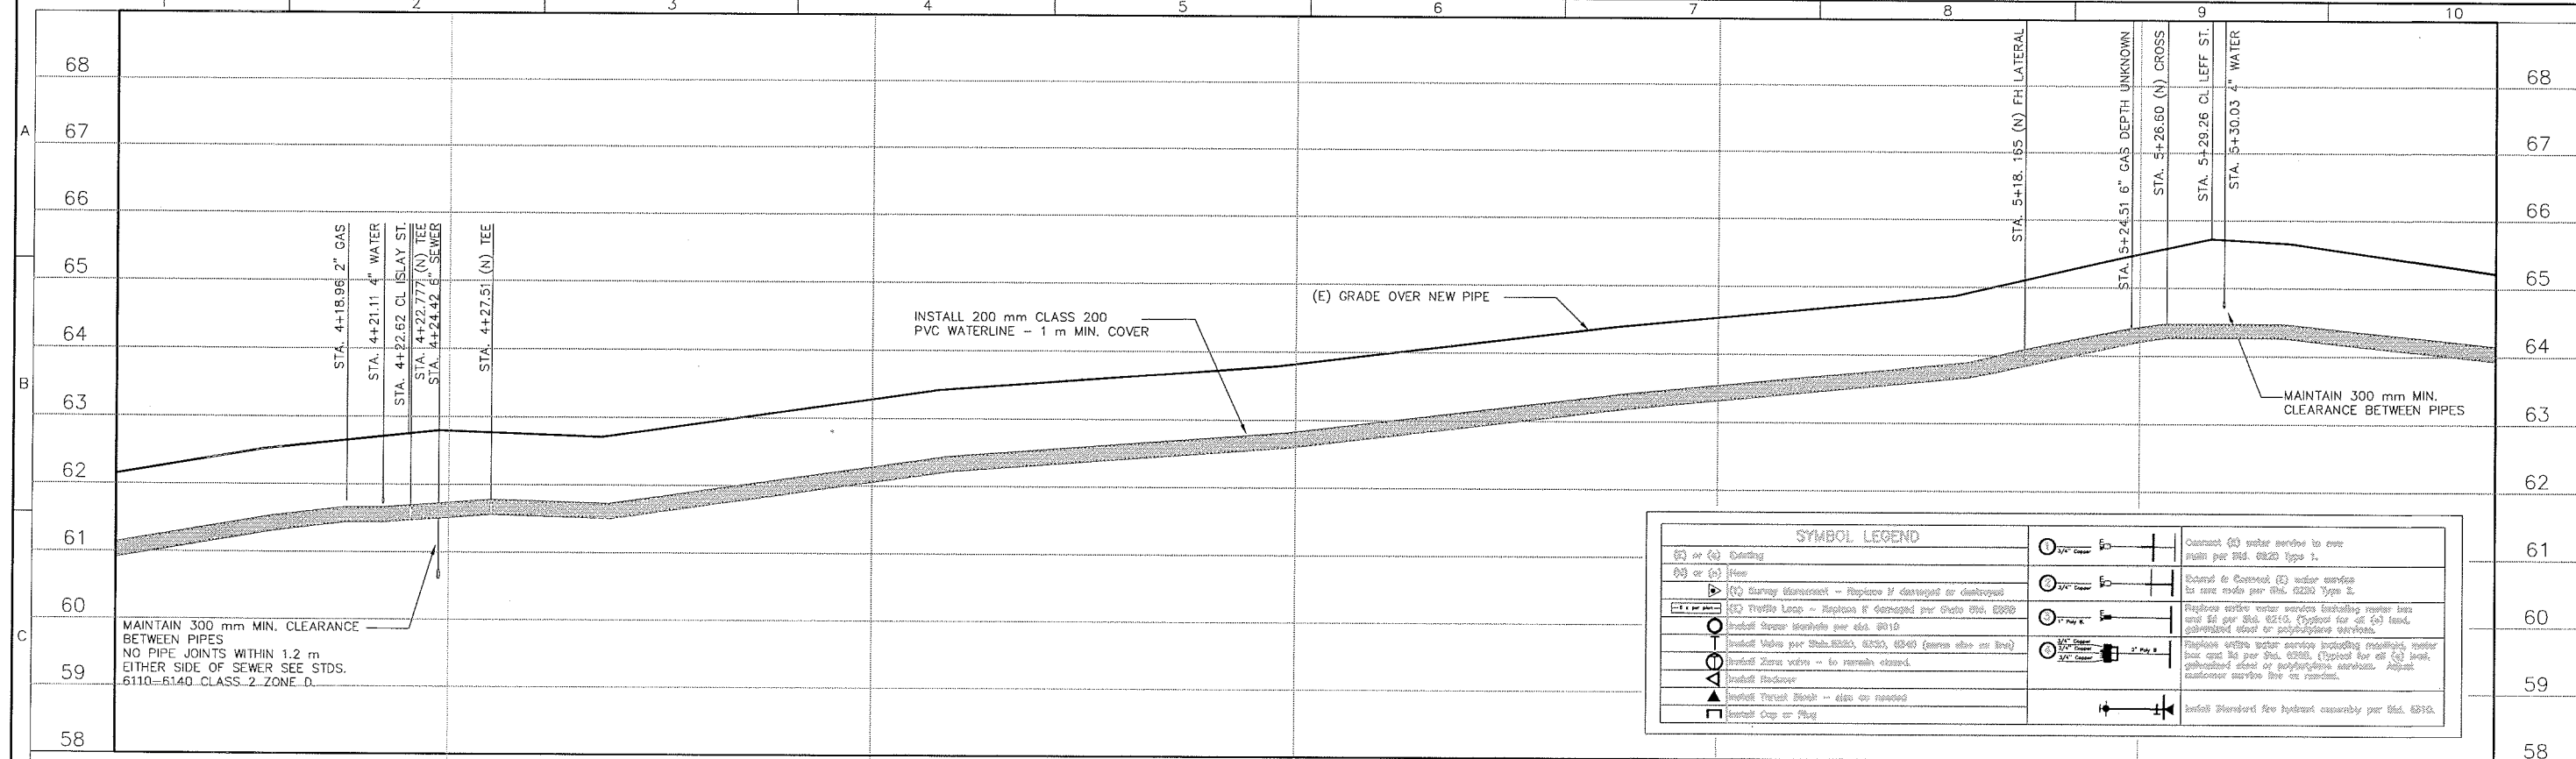

city of

san luis obispo

REVISIONS:

Drawn By & Date

Record Drawing

Drawn By & Date

PROJECT TITLE

BEACH STREET

ISLAY ST. - LEFF ST.

DESIGNED BY:

JV

DRAWN BY:

SR

CHECKED BY:

CHECKED BY

APPROVED BY:

DATE:


DATE

CITY SPECIFICATION NO.:

90033

SHEET NO.:

6 of 25

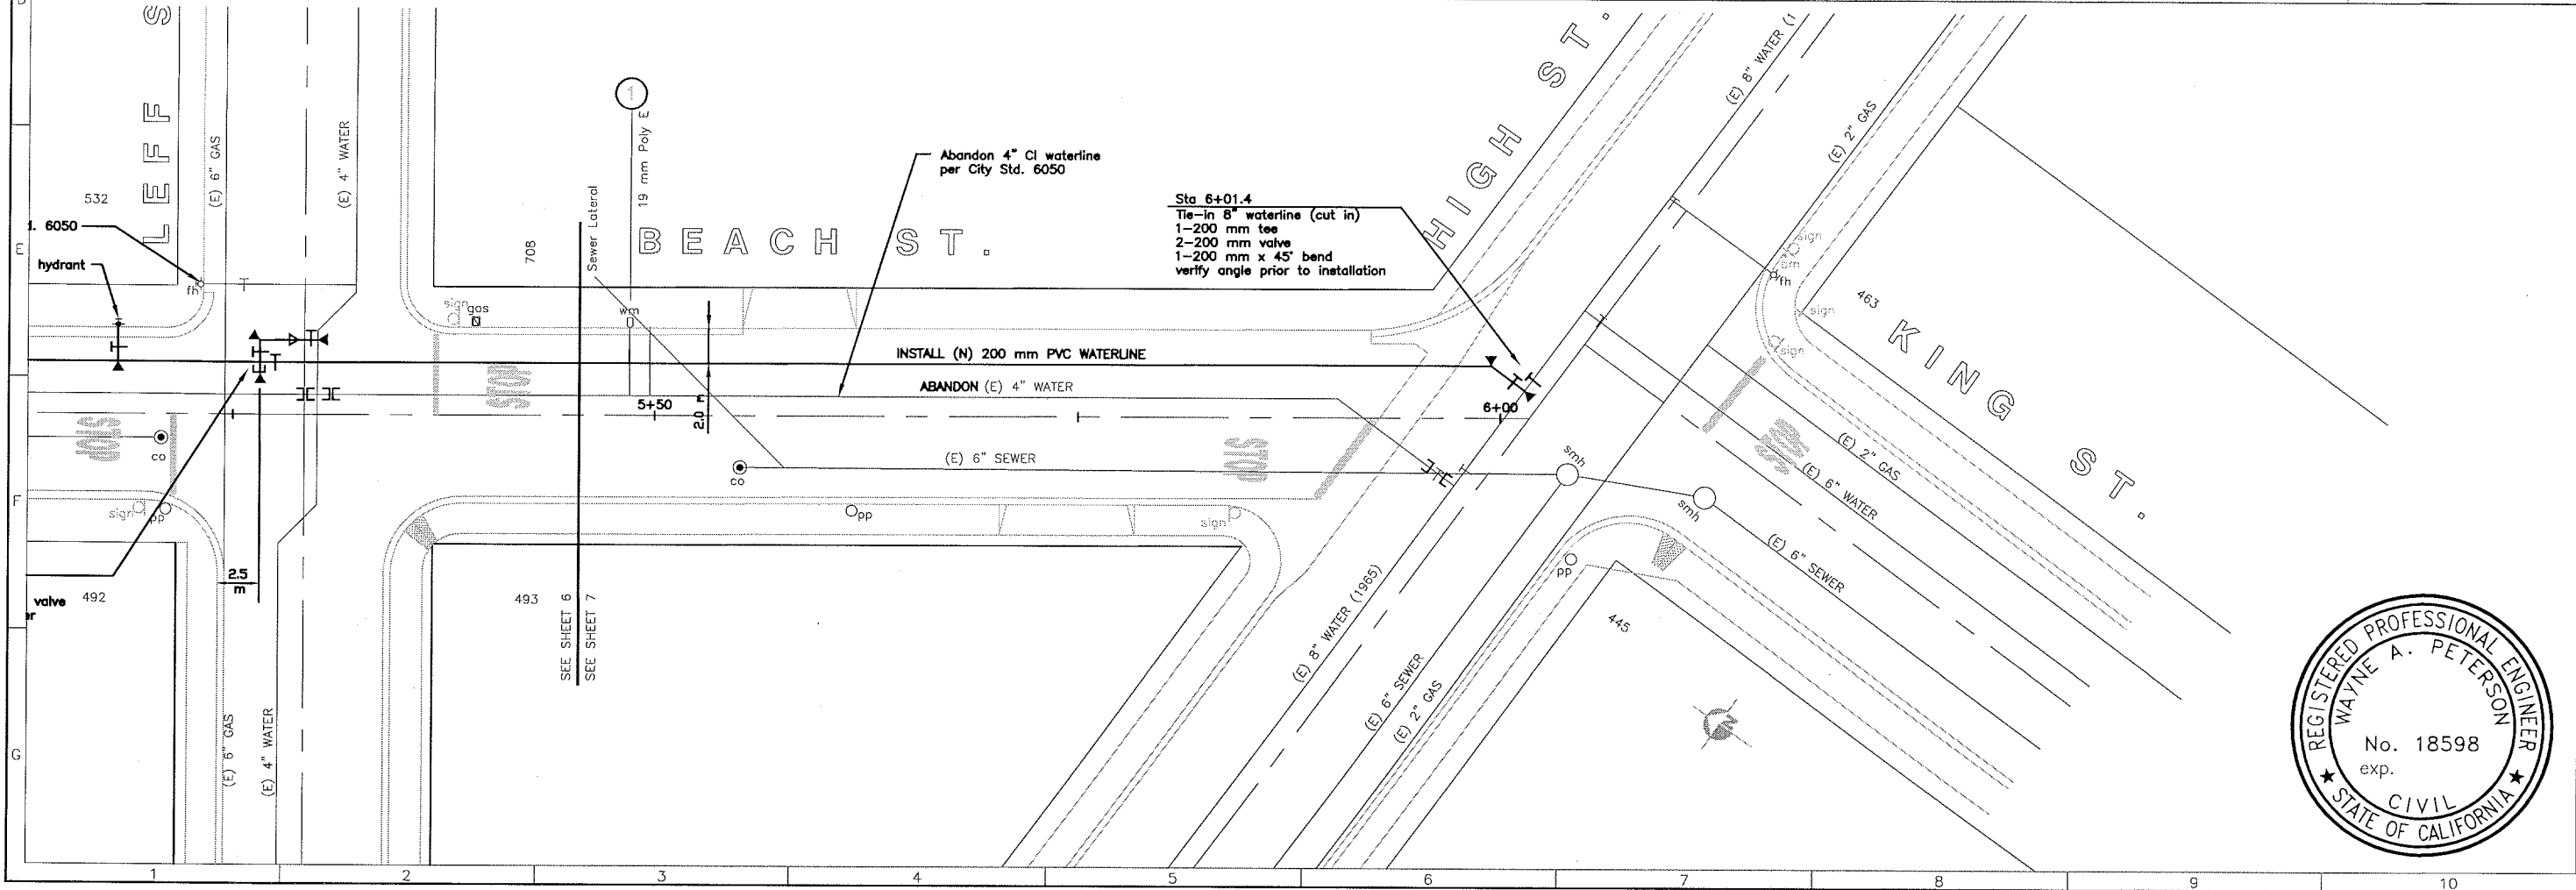

SYMBOL LEGEND	
(E) or (S) Existing	Connect (E) water service to new water per Std. 6020 Type 1.
(W) or (S) New	Extend & Connect (E) water service to new water per Std. 6020 Type 2.
(E) Survey Monument - Replace if damaged or destroyed	Replace water service including meter box and fit per Std. 6020. (Typical for all (E) lines, galvanized steel or polyethylene overtop).
(E) Drafty Loop - Replace if damaged per State Std. 6020	Replace water service including meter box and fit per Std. 6020. (Typical for all (E) lines, galvanized steel or polyethylene overtop).
Install Sewer Manhole per Std. 6010	Replace water service including meter box and fit per Std. 6020. (Typical for all (E) lines, galvanized steel or polyethylene overtop. Adjust customer service line as needed).
Install Valve per Std. 6030, 6030, 6040 (same also on line)	Install 200 mm valve - to remain closed.
Install 200 mm valve - to remain closed.	Install Reducer
Install Reducer	Install Street Flush - also as needed
Install Street Flush - also as needed	Install Cap or Plug



city of
san luis obispo

REVISIONS:

Drawn By & Date
Record Drawing

Drawn By & Date

Metric Scale
1:400
SCALE

PROJECT TITLE:
BEACH STREET
LEFF ST. - HIGH ST.

SHEET TITLE:
HIGH ST.

DESIGNED BY:
JV

DRAWN BY:
SR


CHECKED BY:
CHECKED BY

APPROVED BY:


DATE:
DEC 1999

CITY SPECIFICATION NO.
90033

SHEET NO.
7 of 25

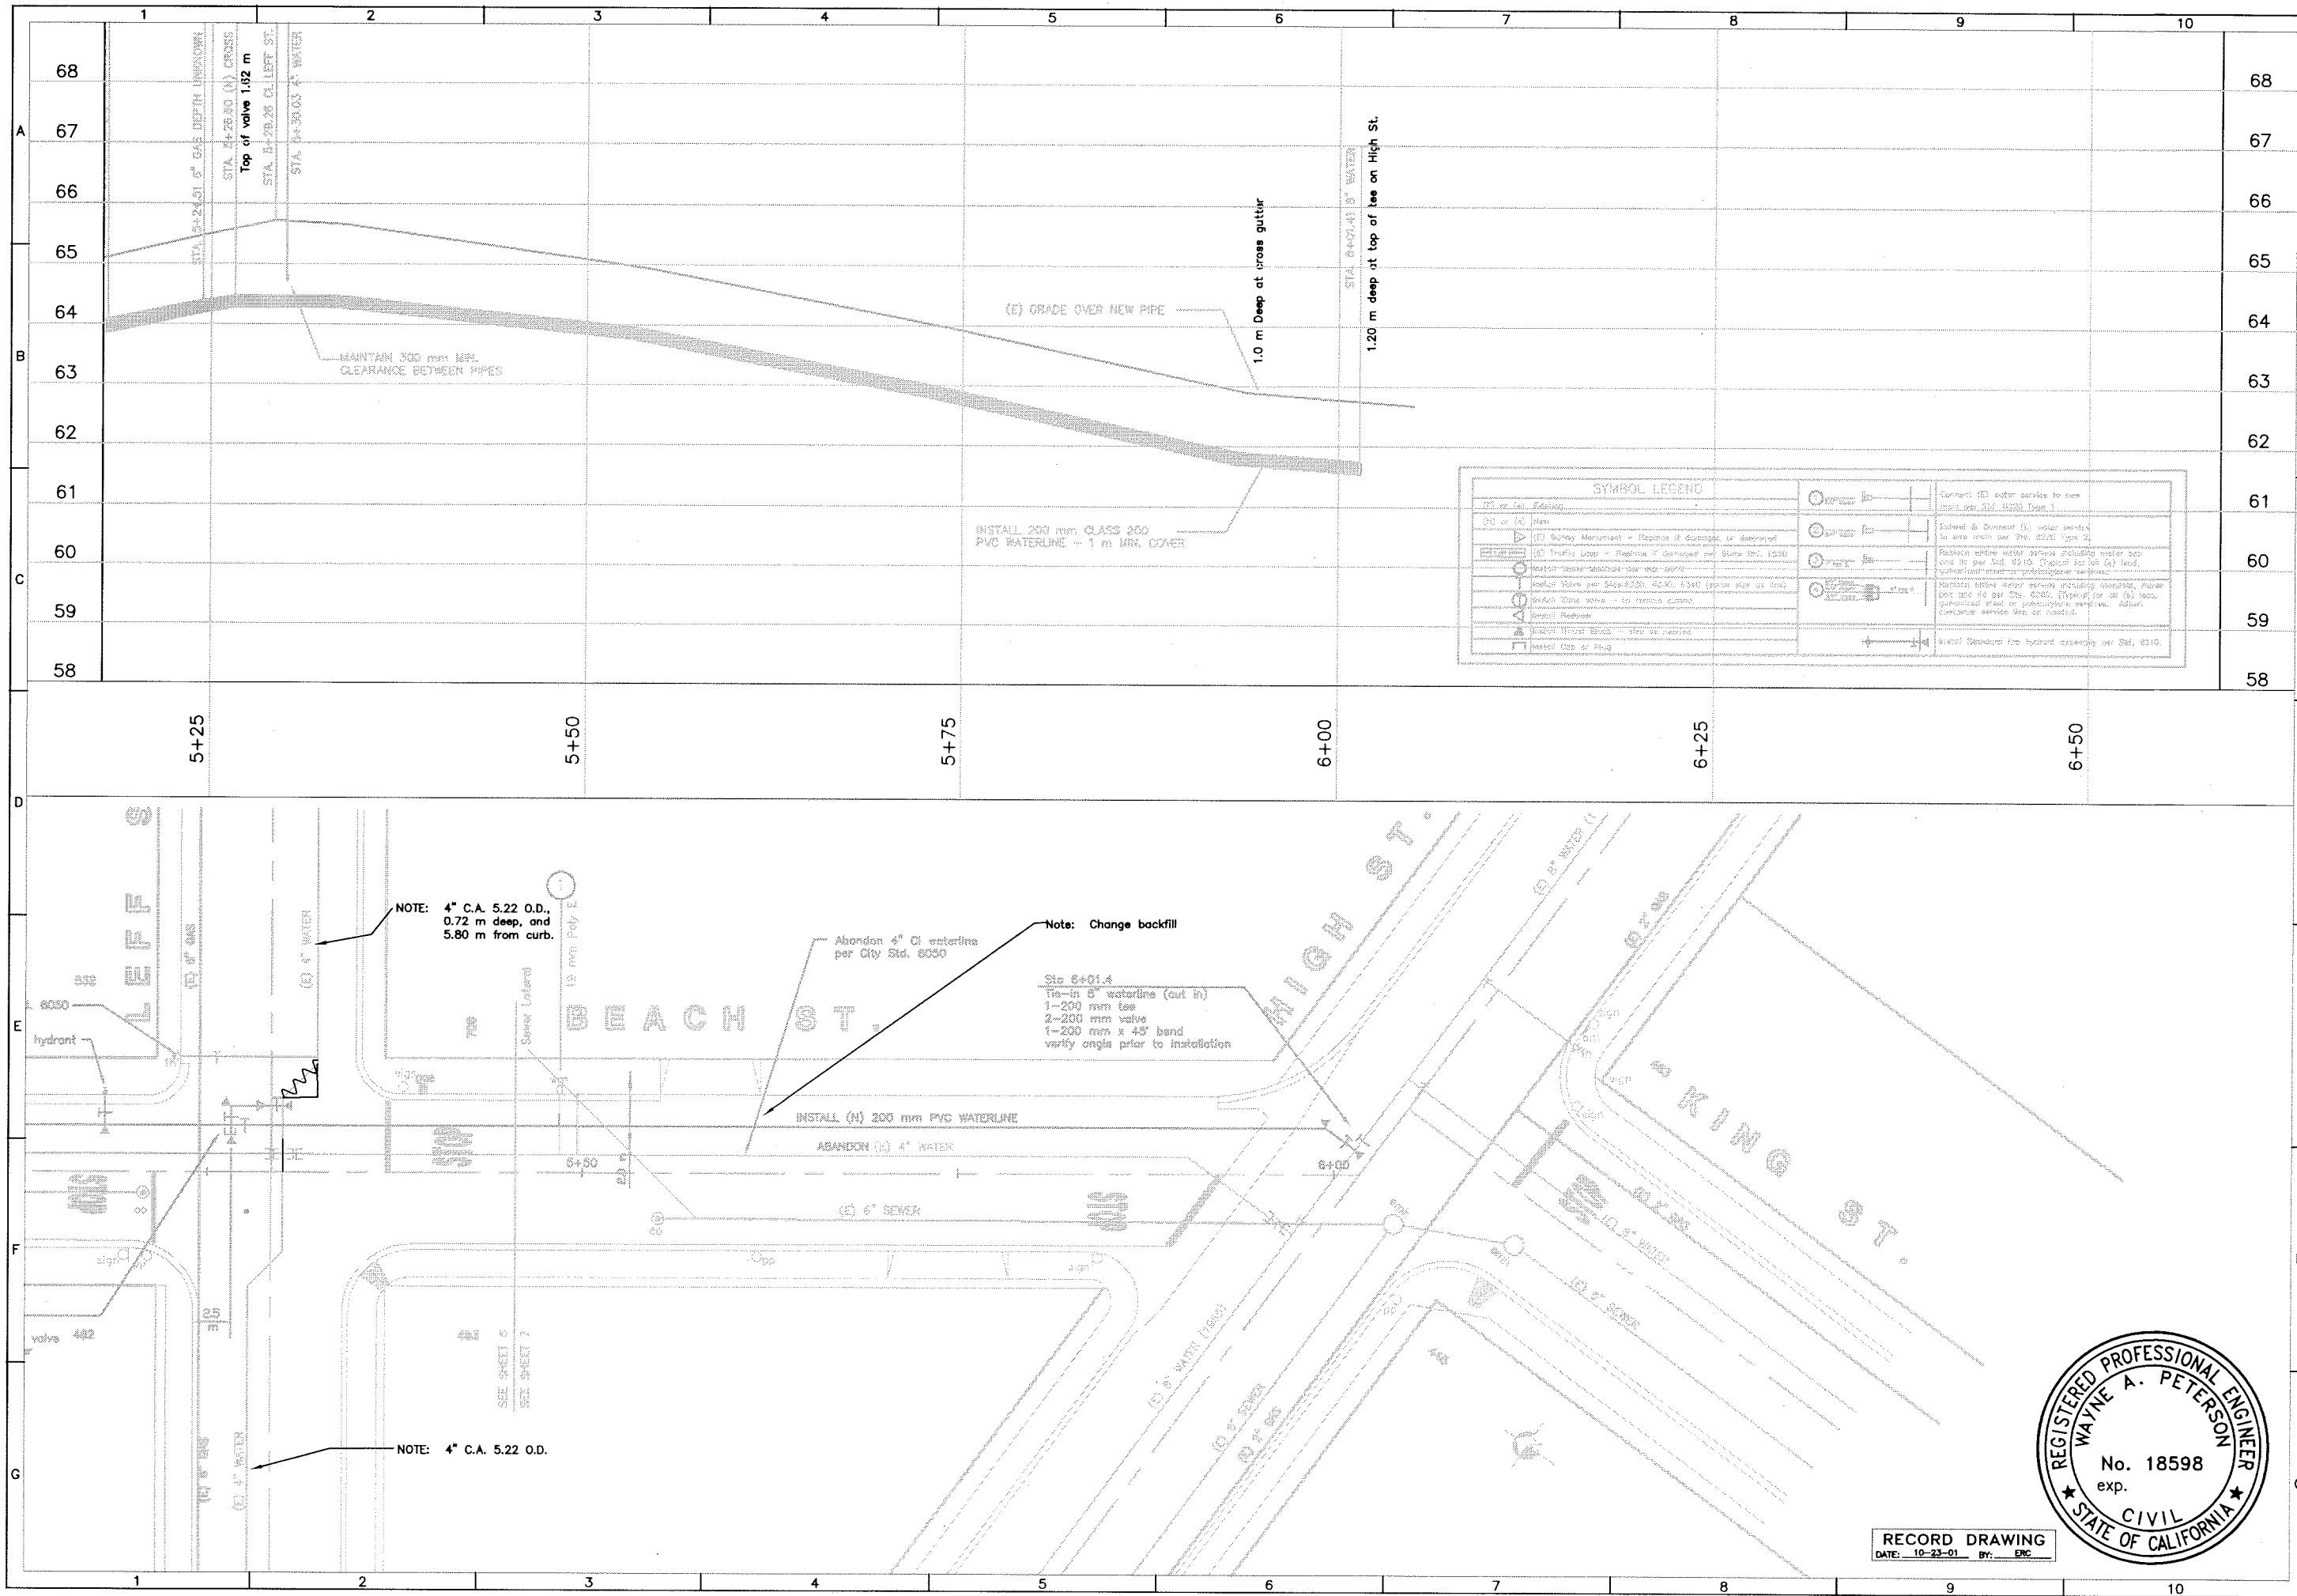

RECORD DRAWING
DATE: 10-23-01 BY: EDC

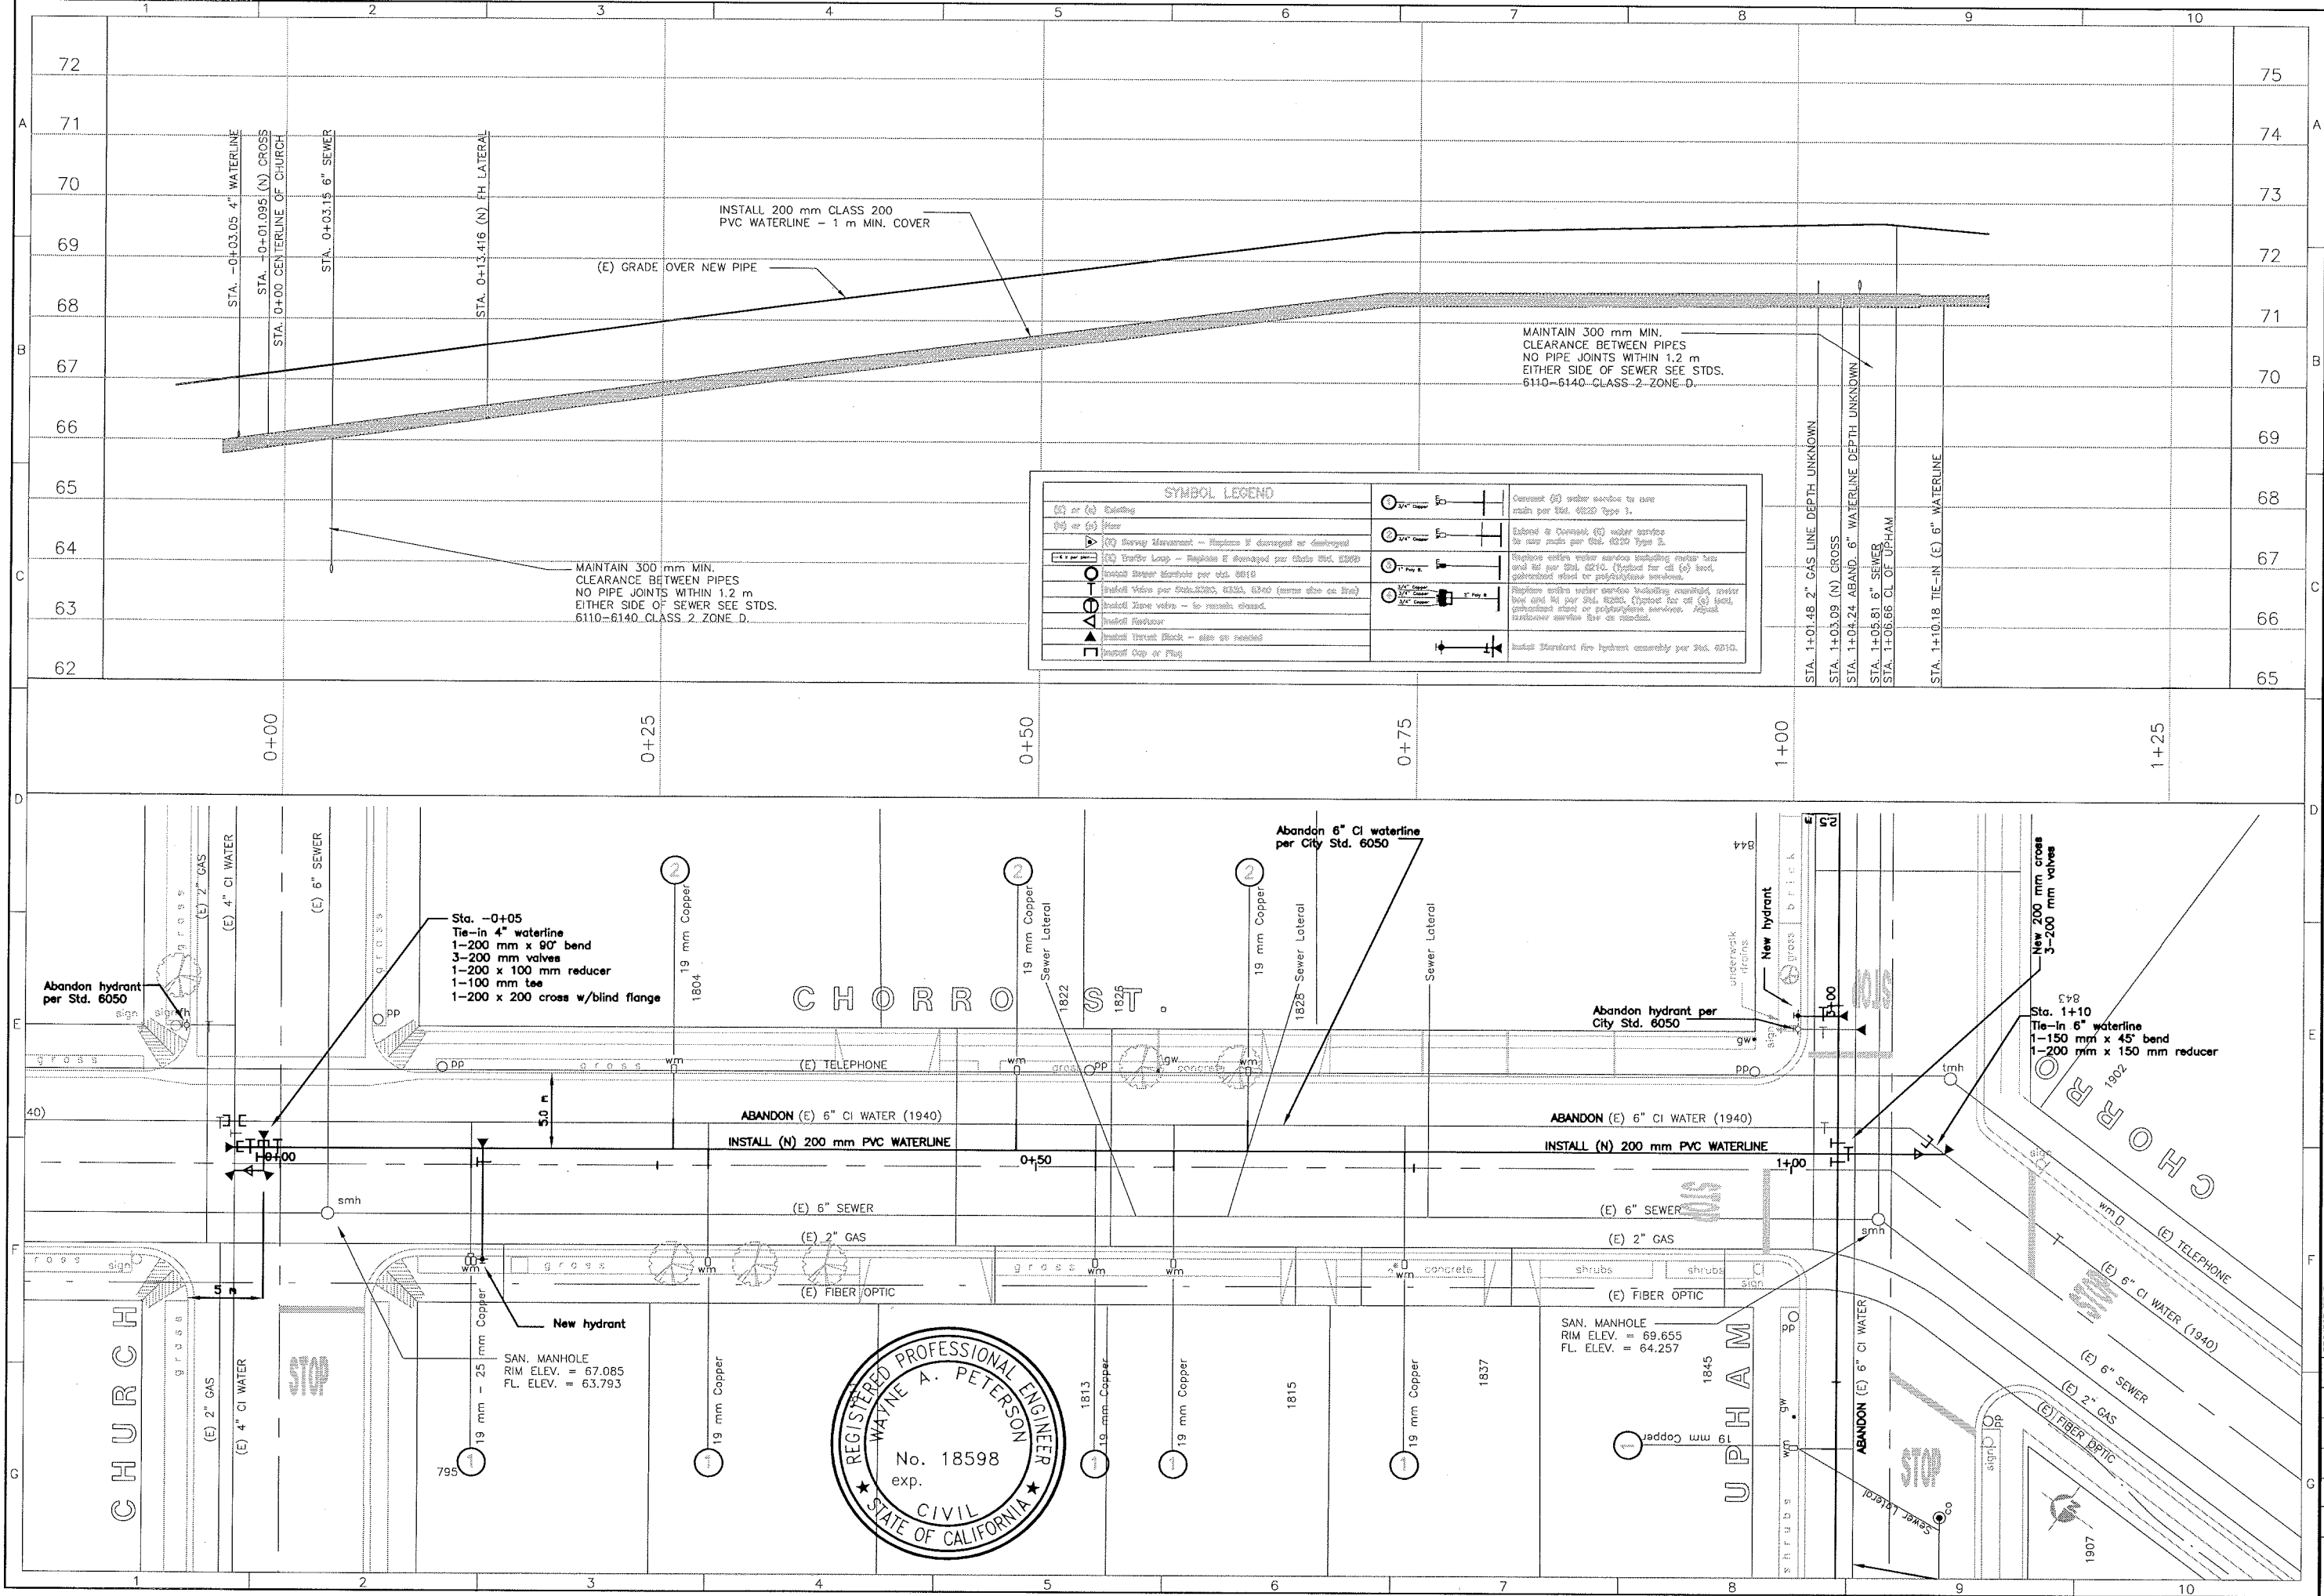

city of

san luis obispo

Drawn By & Date

Record Drawing

Drawn By & Date

Scale

PROJECT TITLE

CHORRO STREET

CHURCH ST. - UPHAM ST.

DESIGNED BY:

JOHN V.

DRAWN BY:

SR

CHECKED BY:

CHECKED BY

APPROVED BY:

DATE:


DEC 1999

CITY SPECIFICATION NO.


90033

SHEET NO.

8 of 25

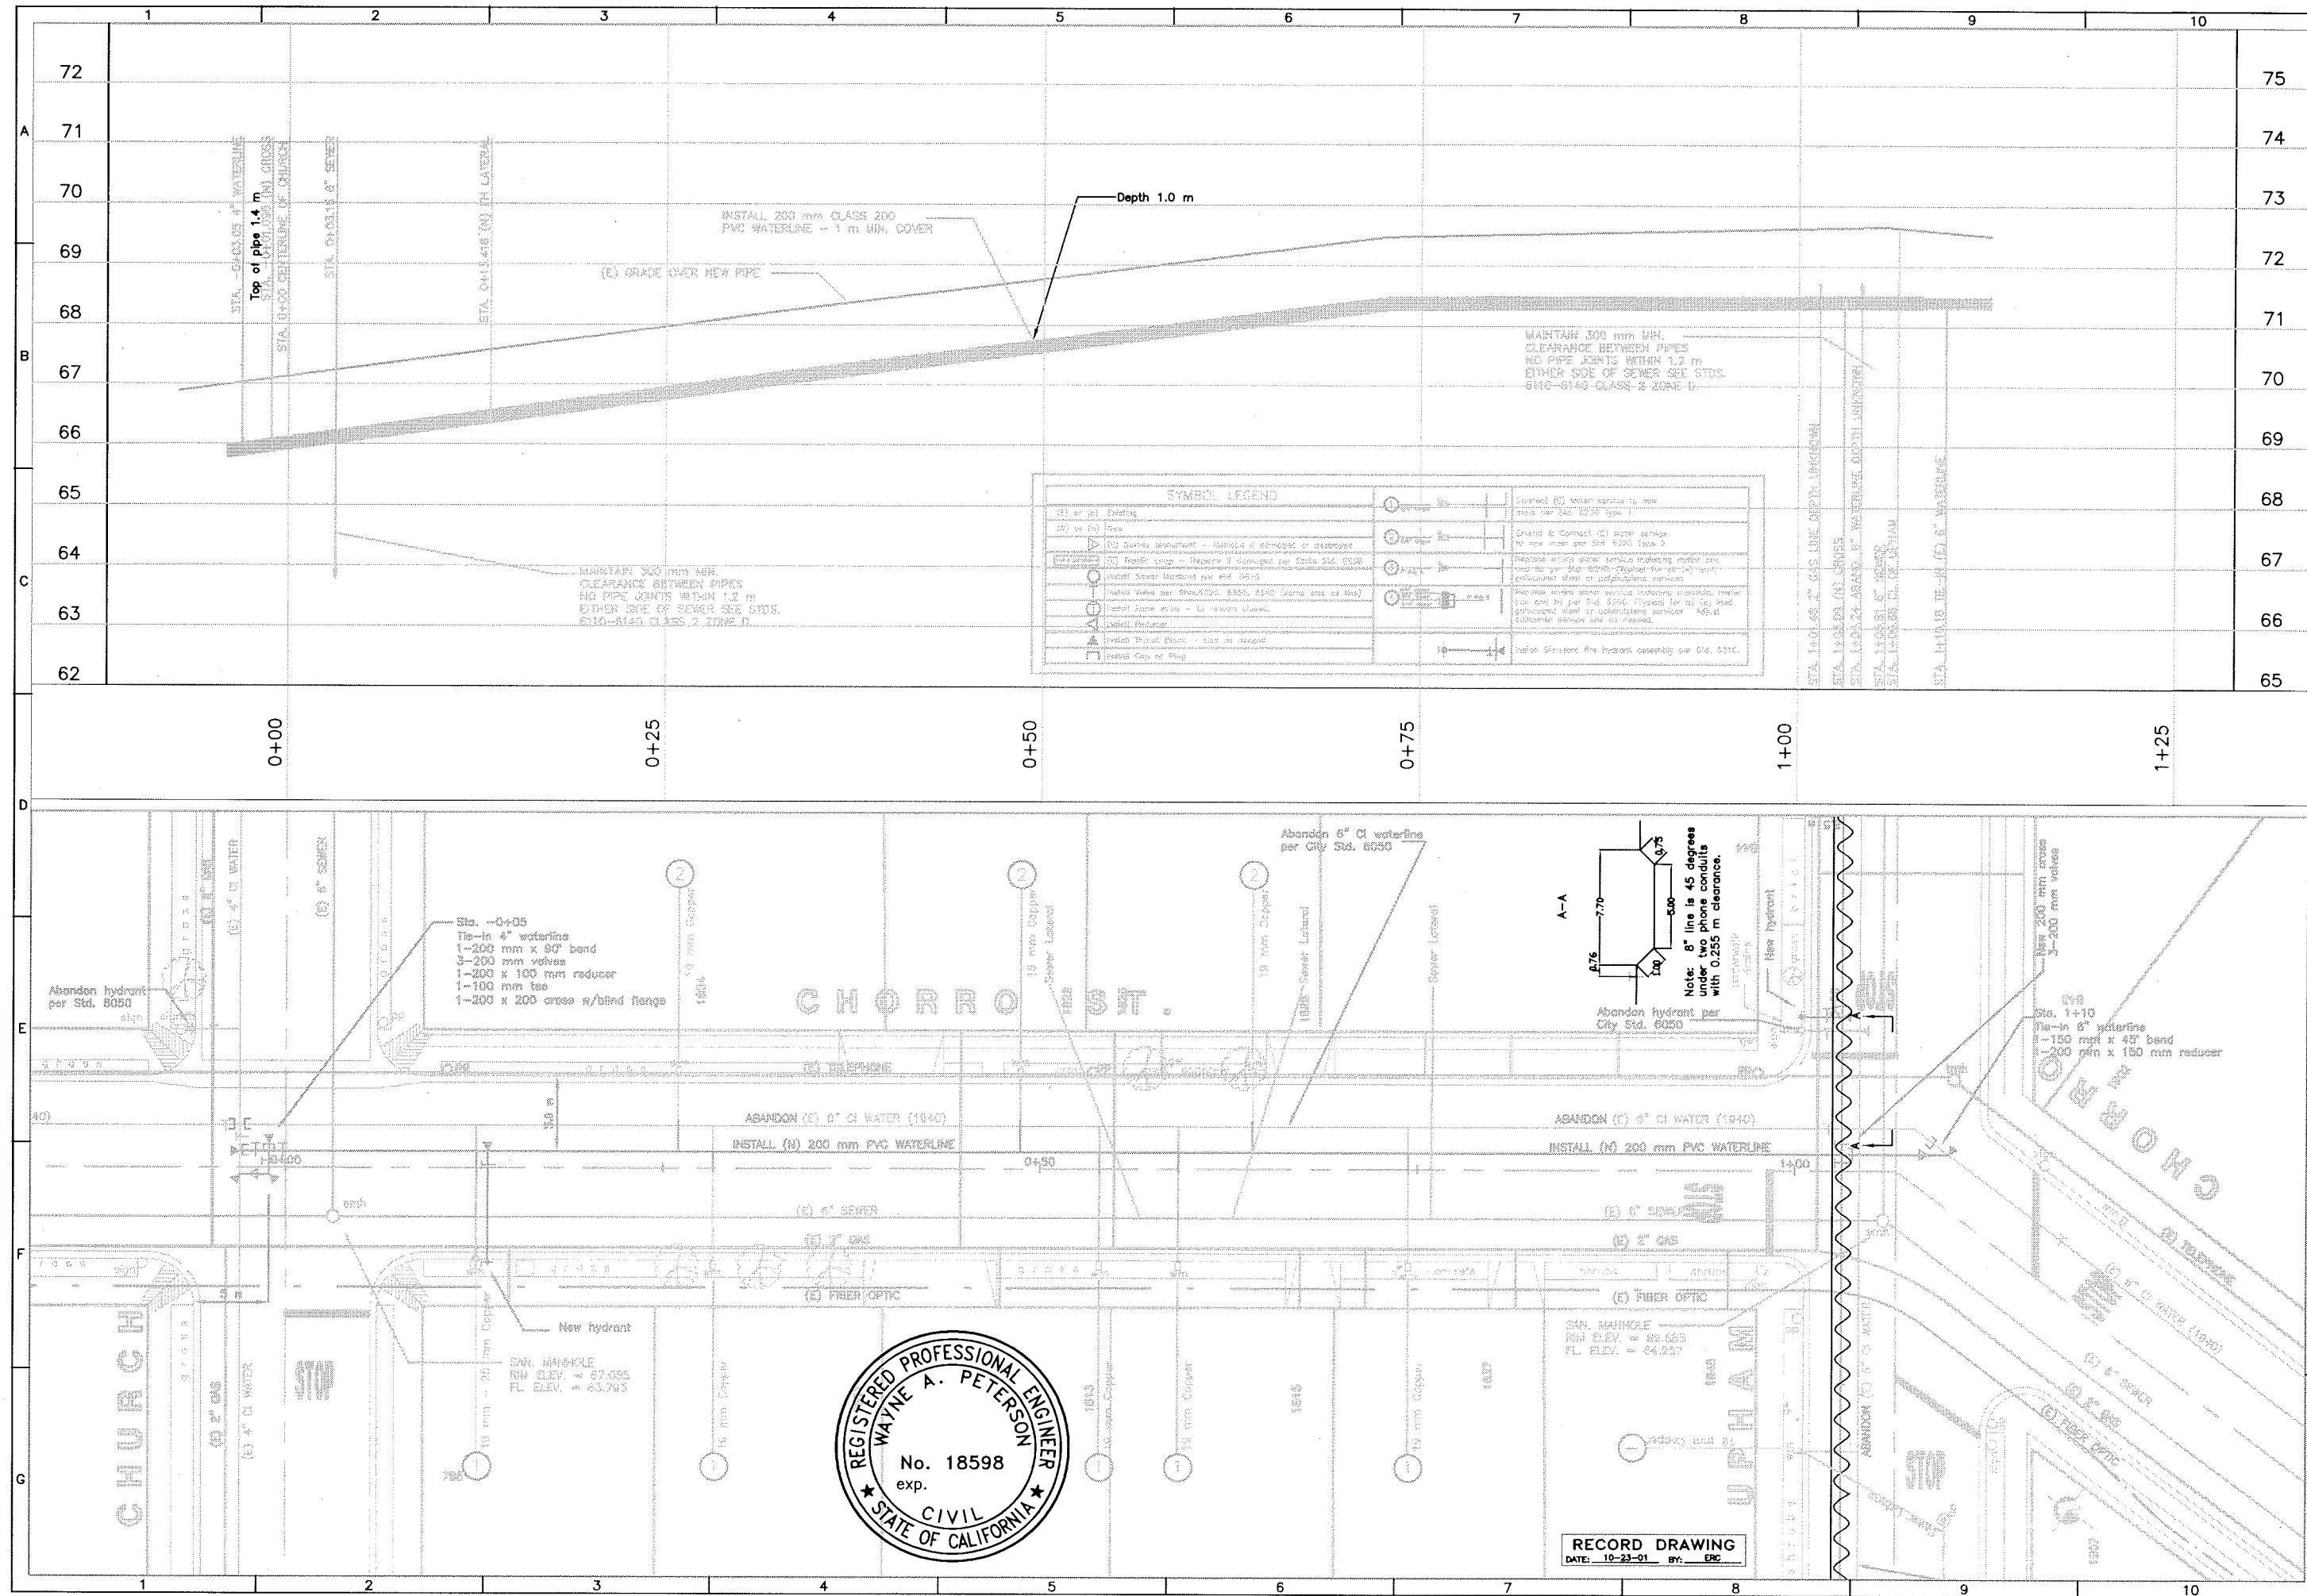

SYMBOL LEGEND	
(1) or (2) Ditching	1" or 2" pipe
(3) or (4) Box	3" or 4" pipe
(5) Survey monument - replaced if damaged or destroyed	5" or 6" pipe
(6) 6" Sewer	6" or 8" pipe
(7) 8" Sewer	8" or 10" pipe
(8) 10" Sewer	10" or 12" pipe
(347) 688" Sewer	688" or 690" pipe
(348) 690" Sewer	

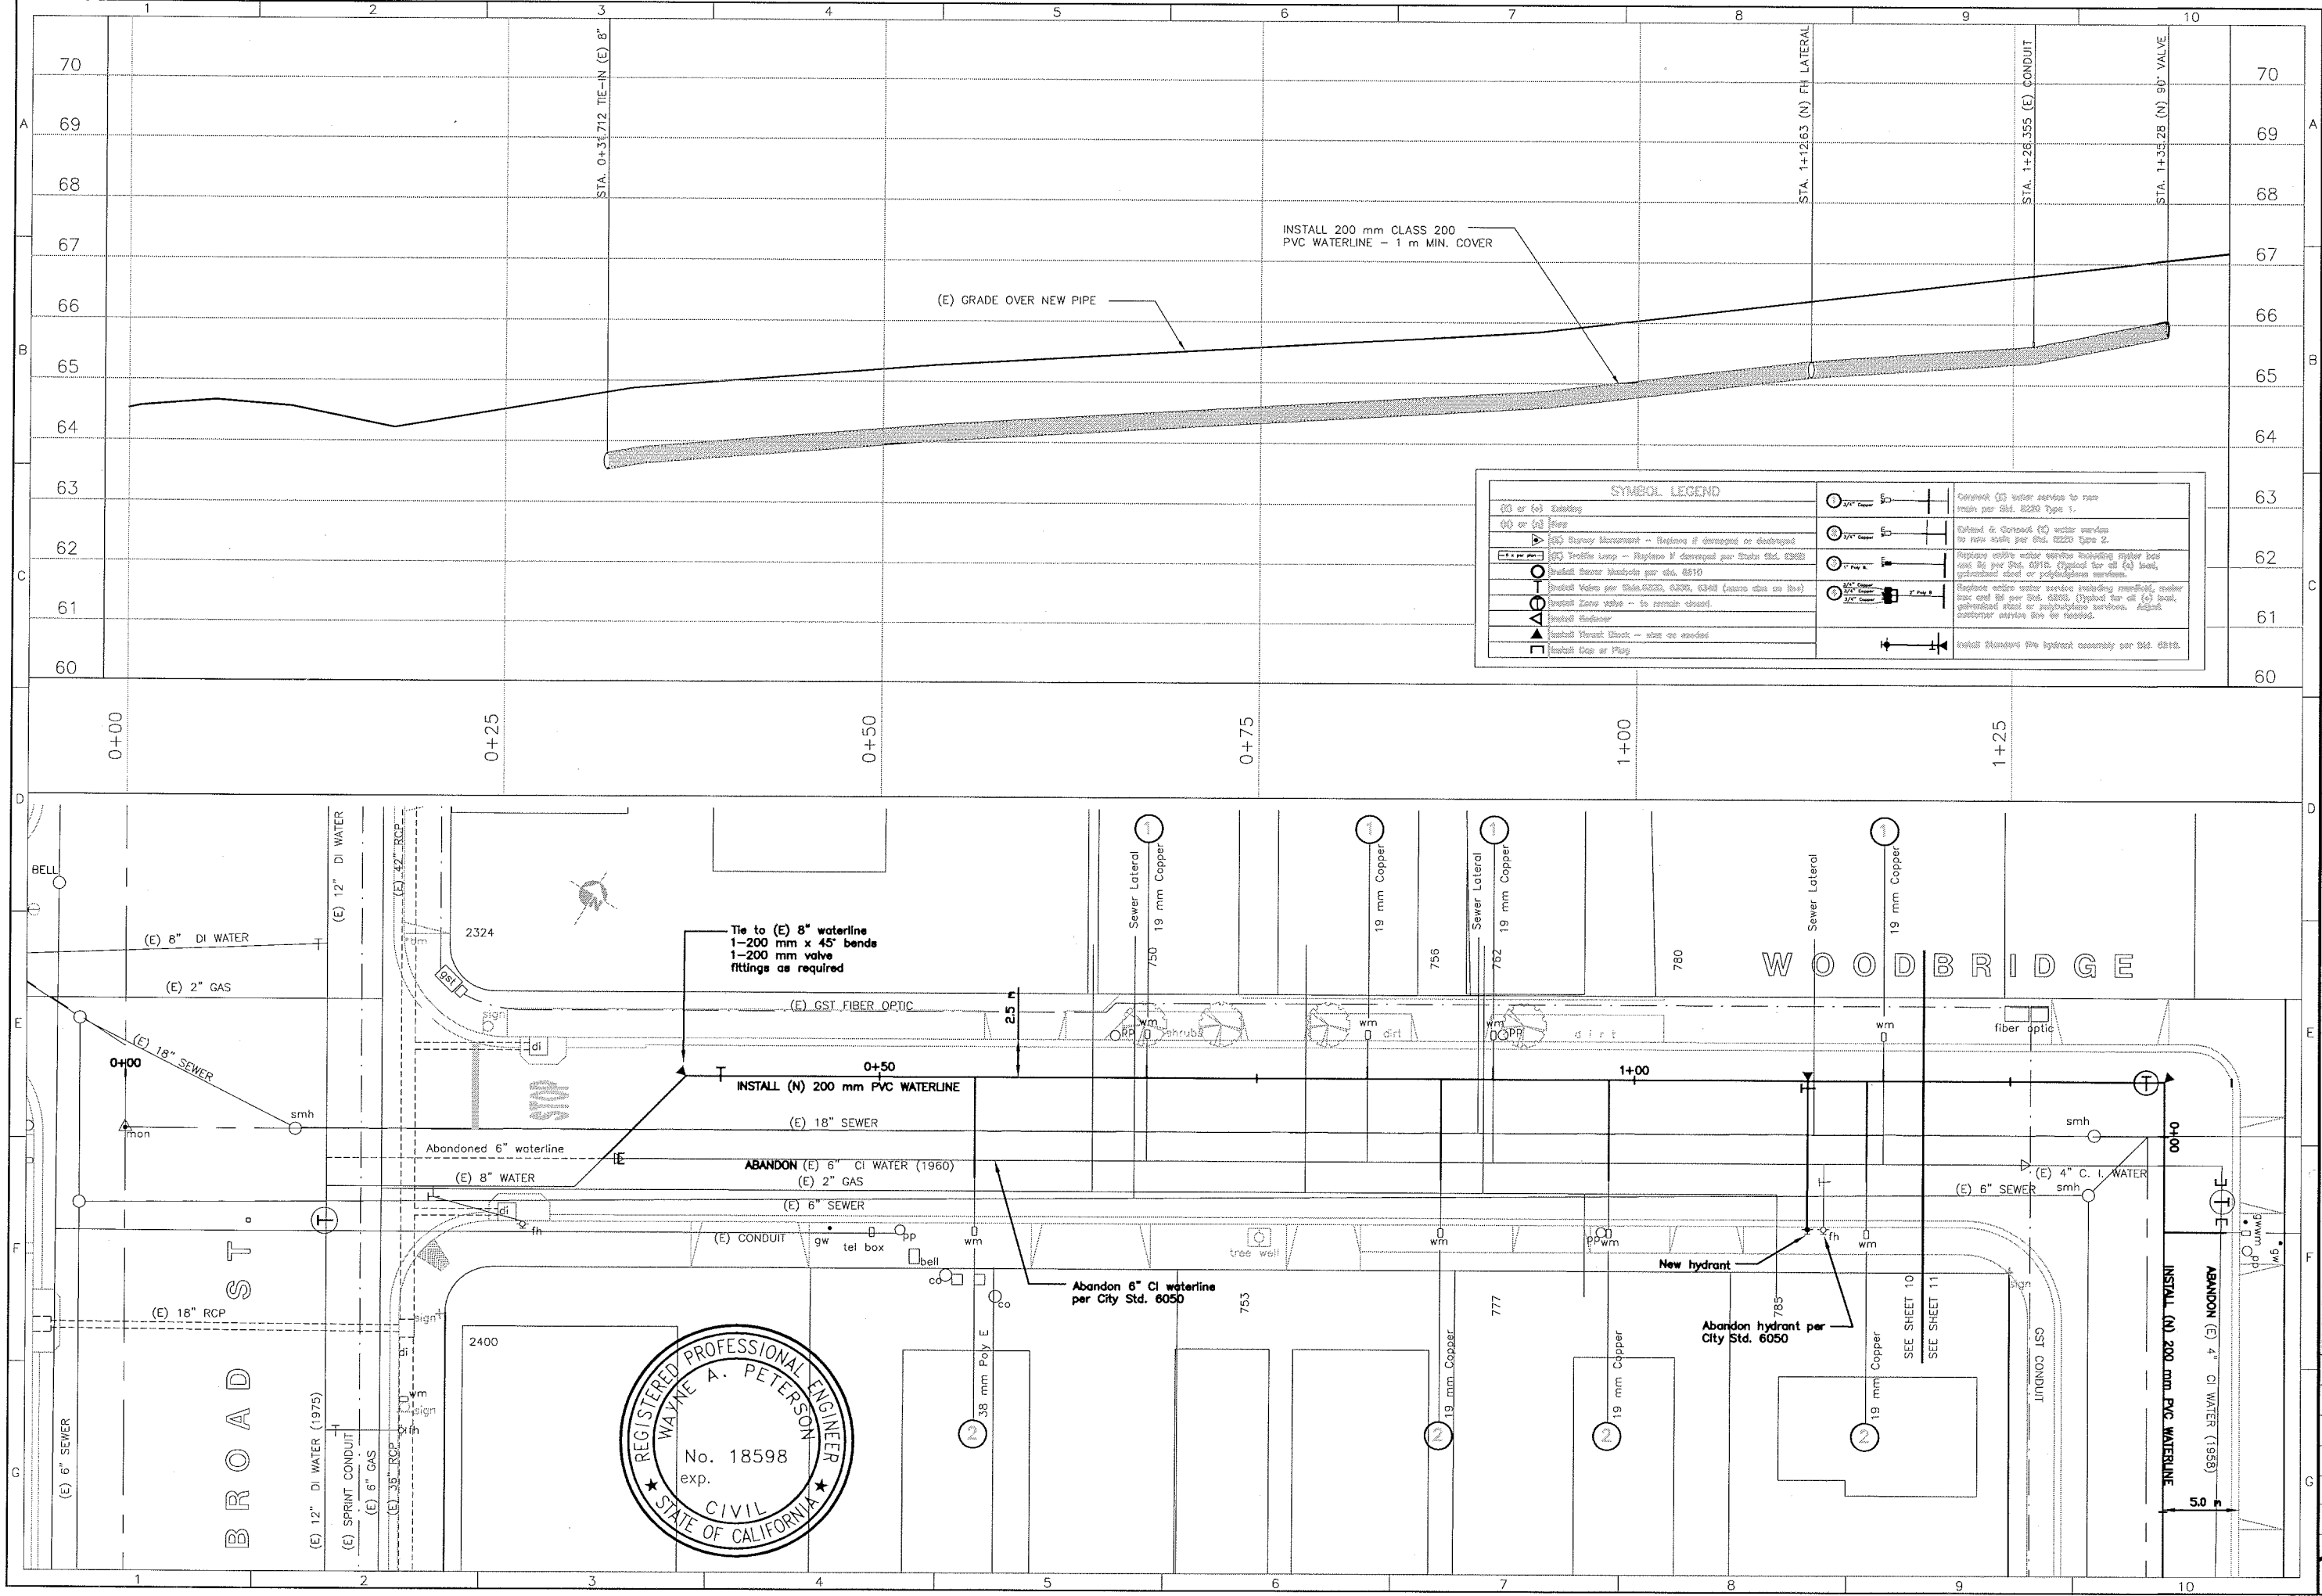

REVISIONS

Drawn By & Date

Record Drawing

Drawn By & Date

PROJECT TITLE

WOODBRIDGE STREET

BROAD ST - VICTORIA ST.

DESIGNED BY:

JV

DRAWN BY:

SR

CHECKED BY:

CHECKED BY

APPROVED BY:

DATE:

DEC 1999

CITY SPECIFICATION NO.

90033

SHEET NO.

10

city of


san luis obispo


Scale:

1" = 40'

SCALE

10 of 25

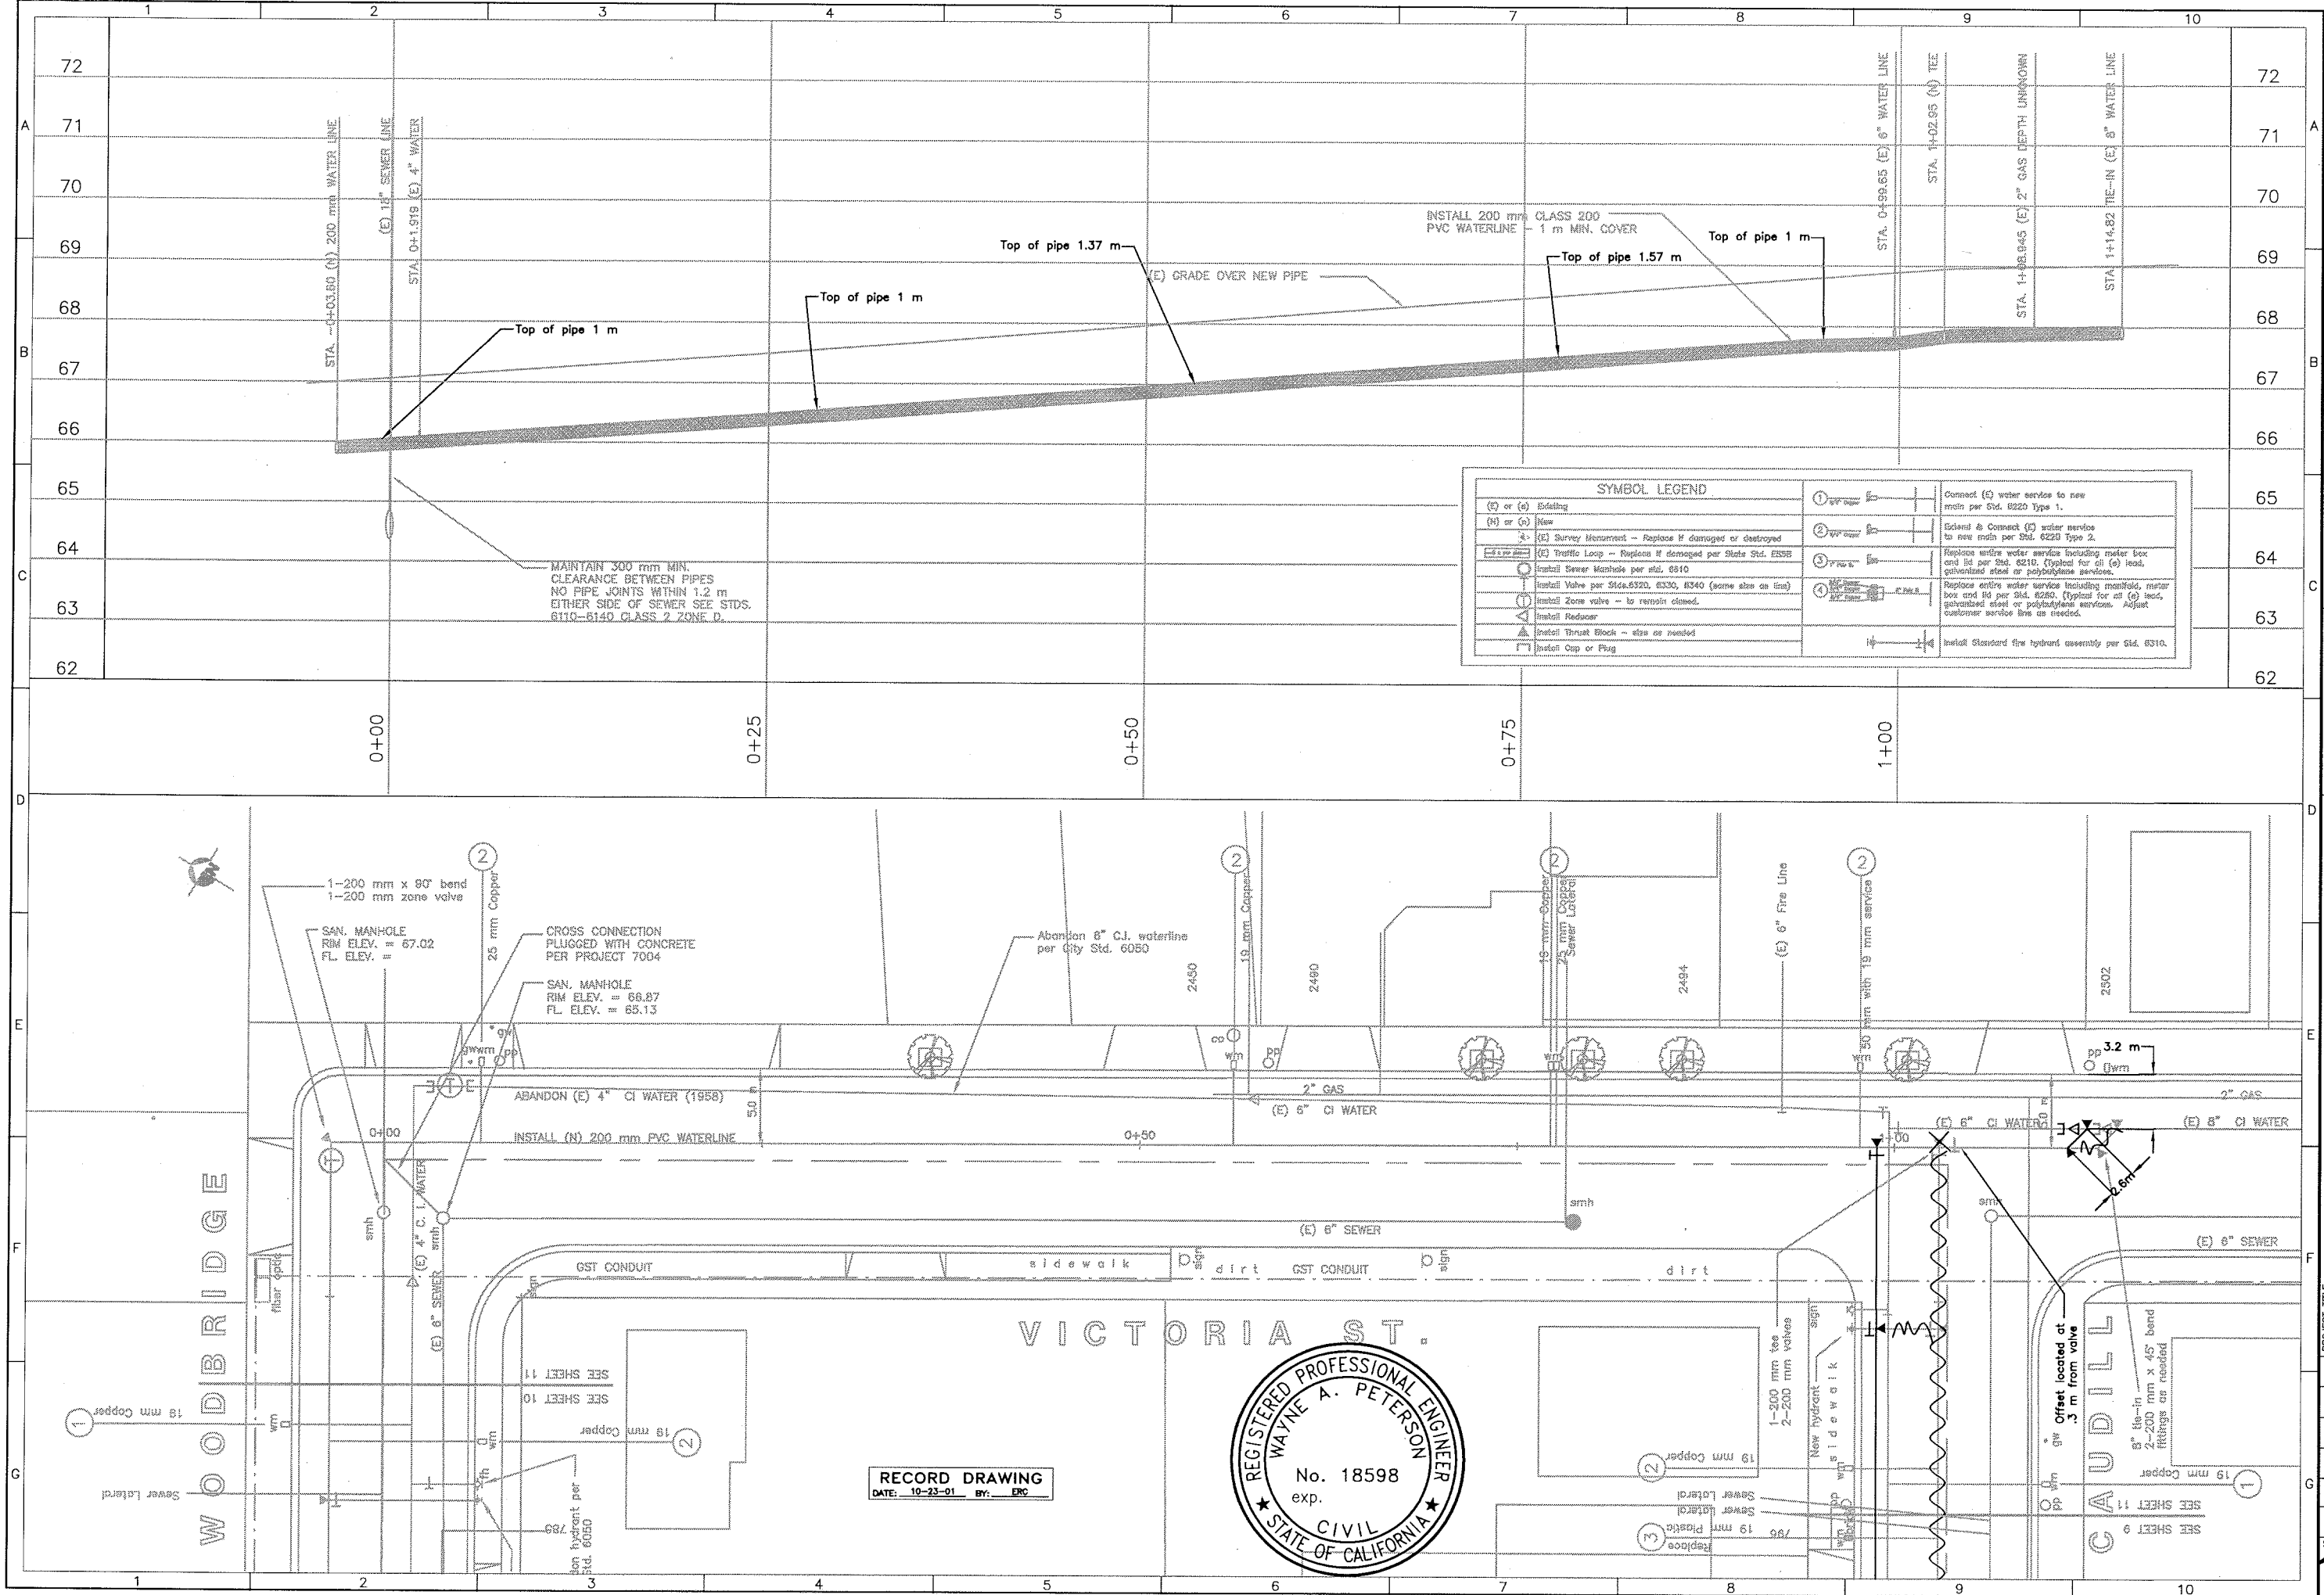

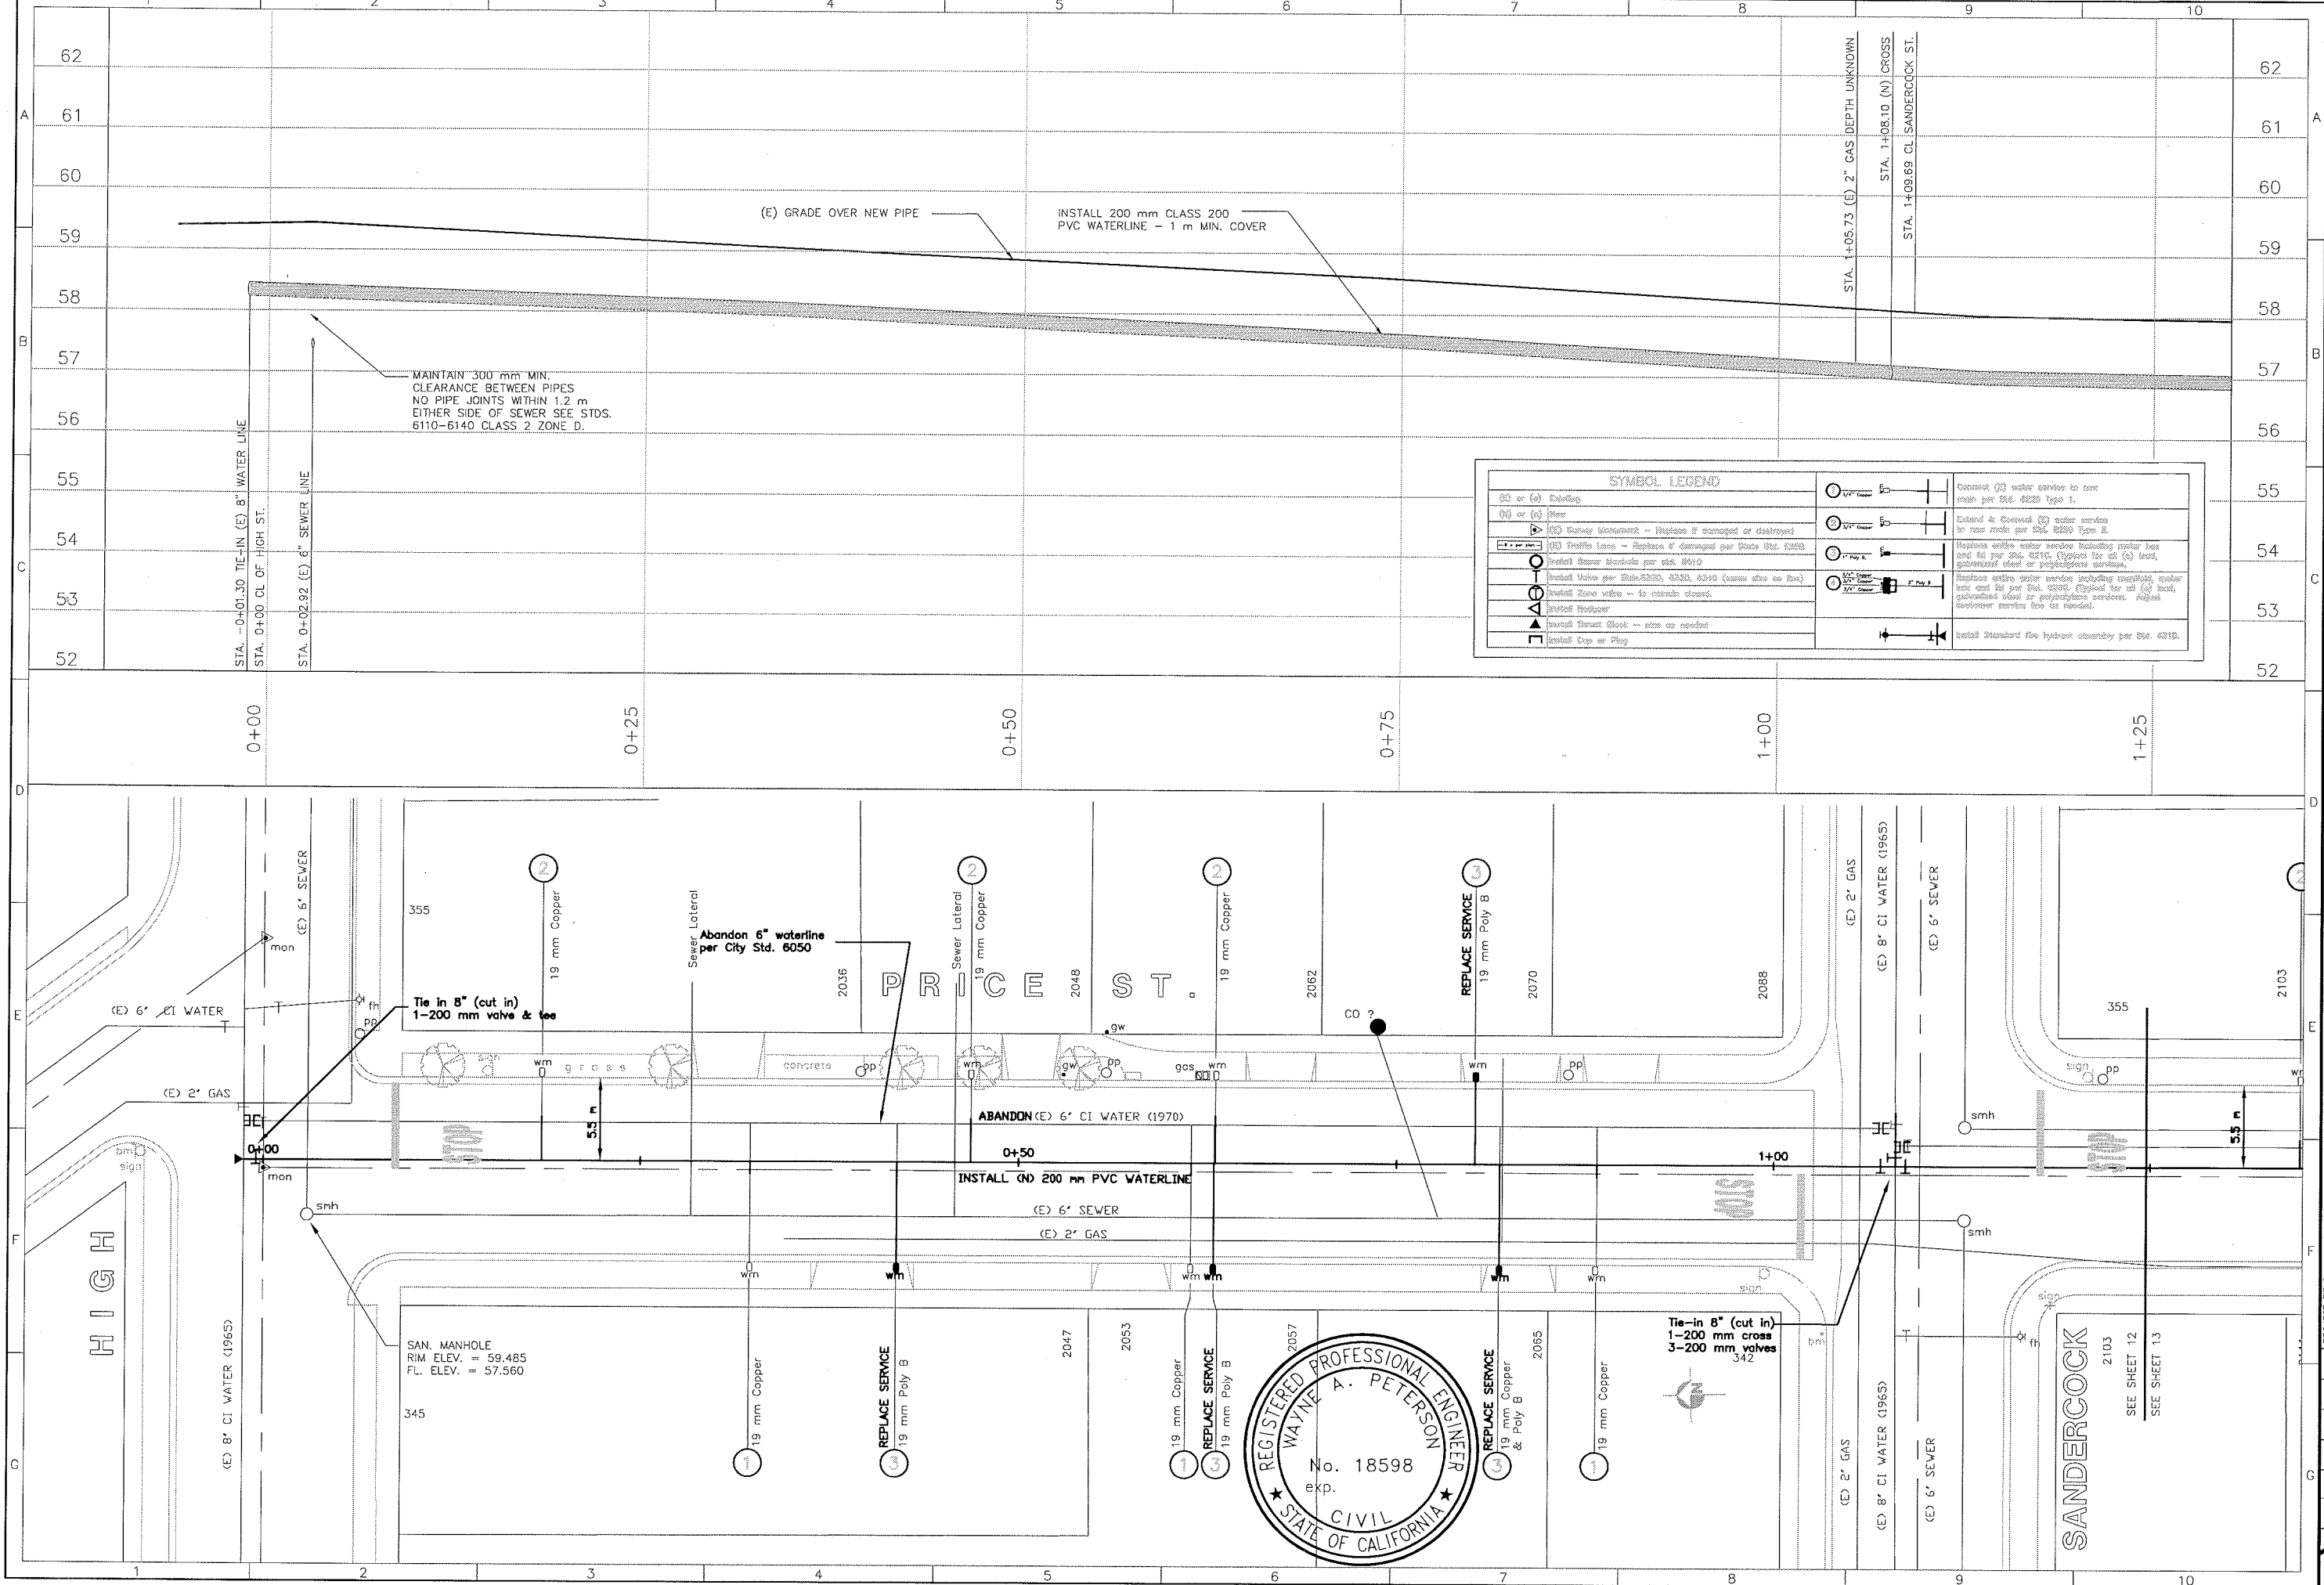

city of

san luis obispo

REVISIONS:

Drawn By & Date

Record Drawing

Drawn By & Date

PROJECT TITLE

PRICE STREET

HGH ST. - SANDERCOCK ST.

DESIGNED BY:

JV

DRAWN BY:

SR

CHECKED BY:

CHECKED BY

APPROVED BY:

DATE:

DEC 1999

CITY SPECIFICATION NO.

90033

SHEET NO.

12

of

25

city of

san luis obispo

REVISIONS:

Drawn By & Date

Record Drawing

Drawn By & Date

PROJECT TITLE

PRICE STREET

HGH ST. - SANDERCOCK ST.

DESIGNED BY:

JV

DRAWN BY:

SR

CHECKED BY:

CHECKED BY

APPROVED BY:

DATE:

DEC 1999

CITY SPECIFICATION NO.

90033

SHEET NO.

12

of

25

city of

san luis obispo

REVISIONS:

Drawn By & Date

Record Drawing

Drawn By & Date

PROJECT TITLE

PRICE STREET

HGH ST. - SANDERCOCK ST.

DESIGNED BY:

JV

DRAWN BY:

SR

CHECKED BY:

CHECKED BY

APPROVED BY:

DATE:

DEC 1999

CITY SPECIFICATION NO.


90033

SHEET NO.


12

of

25

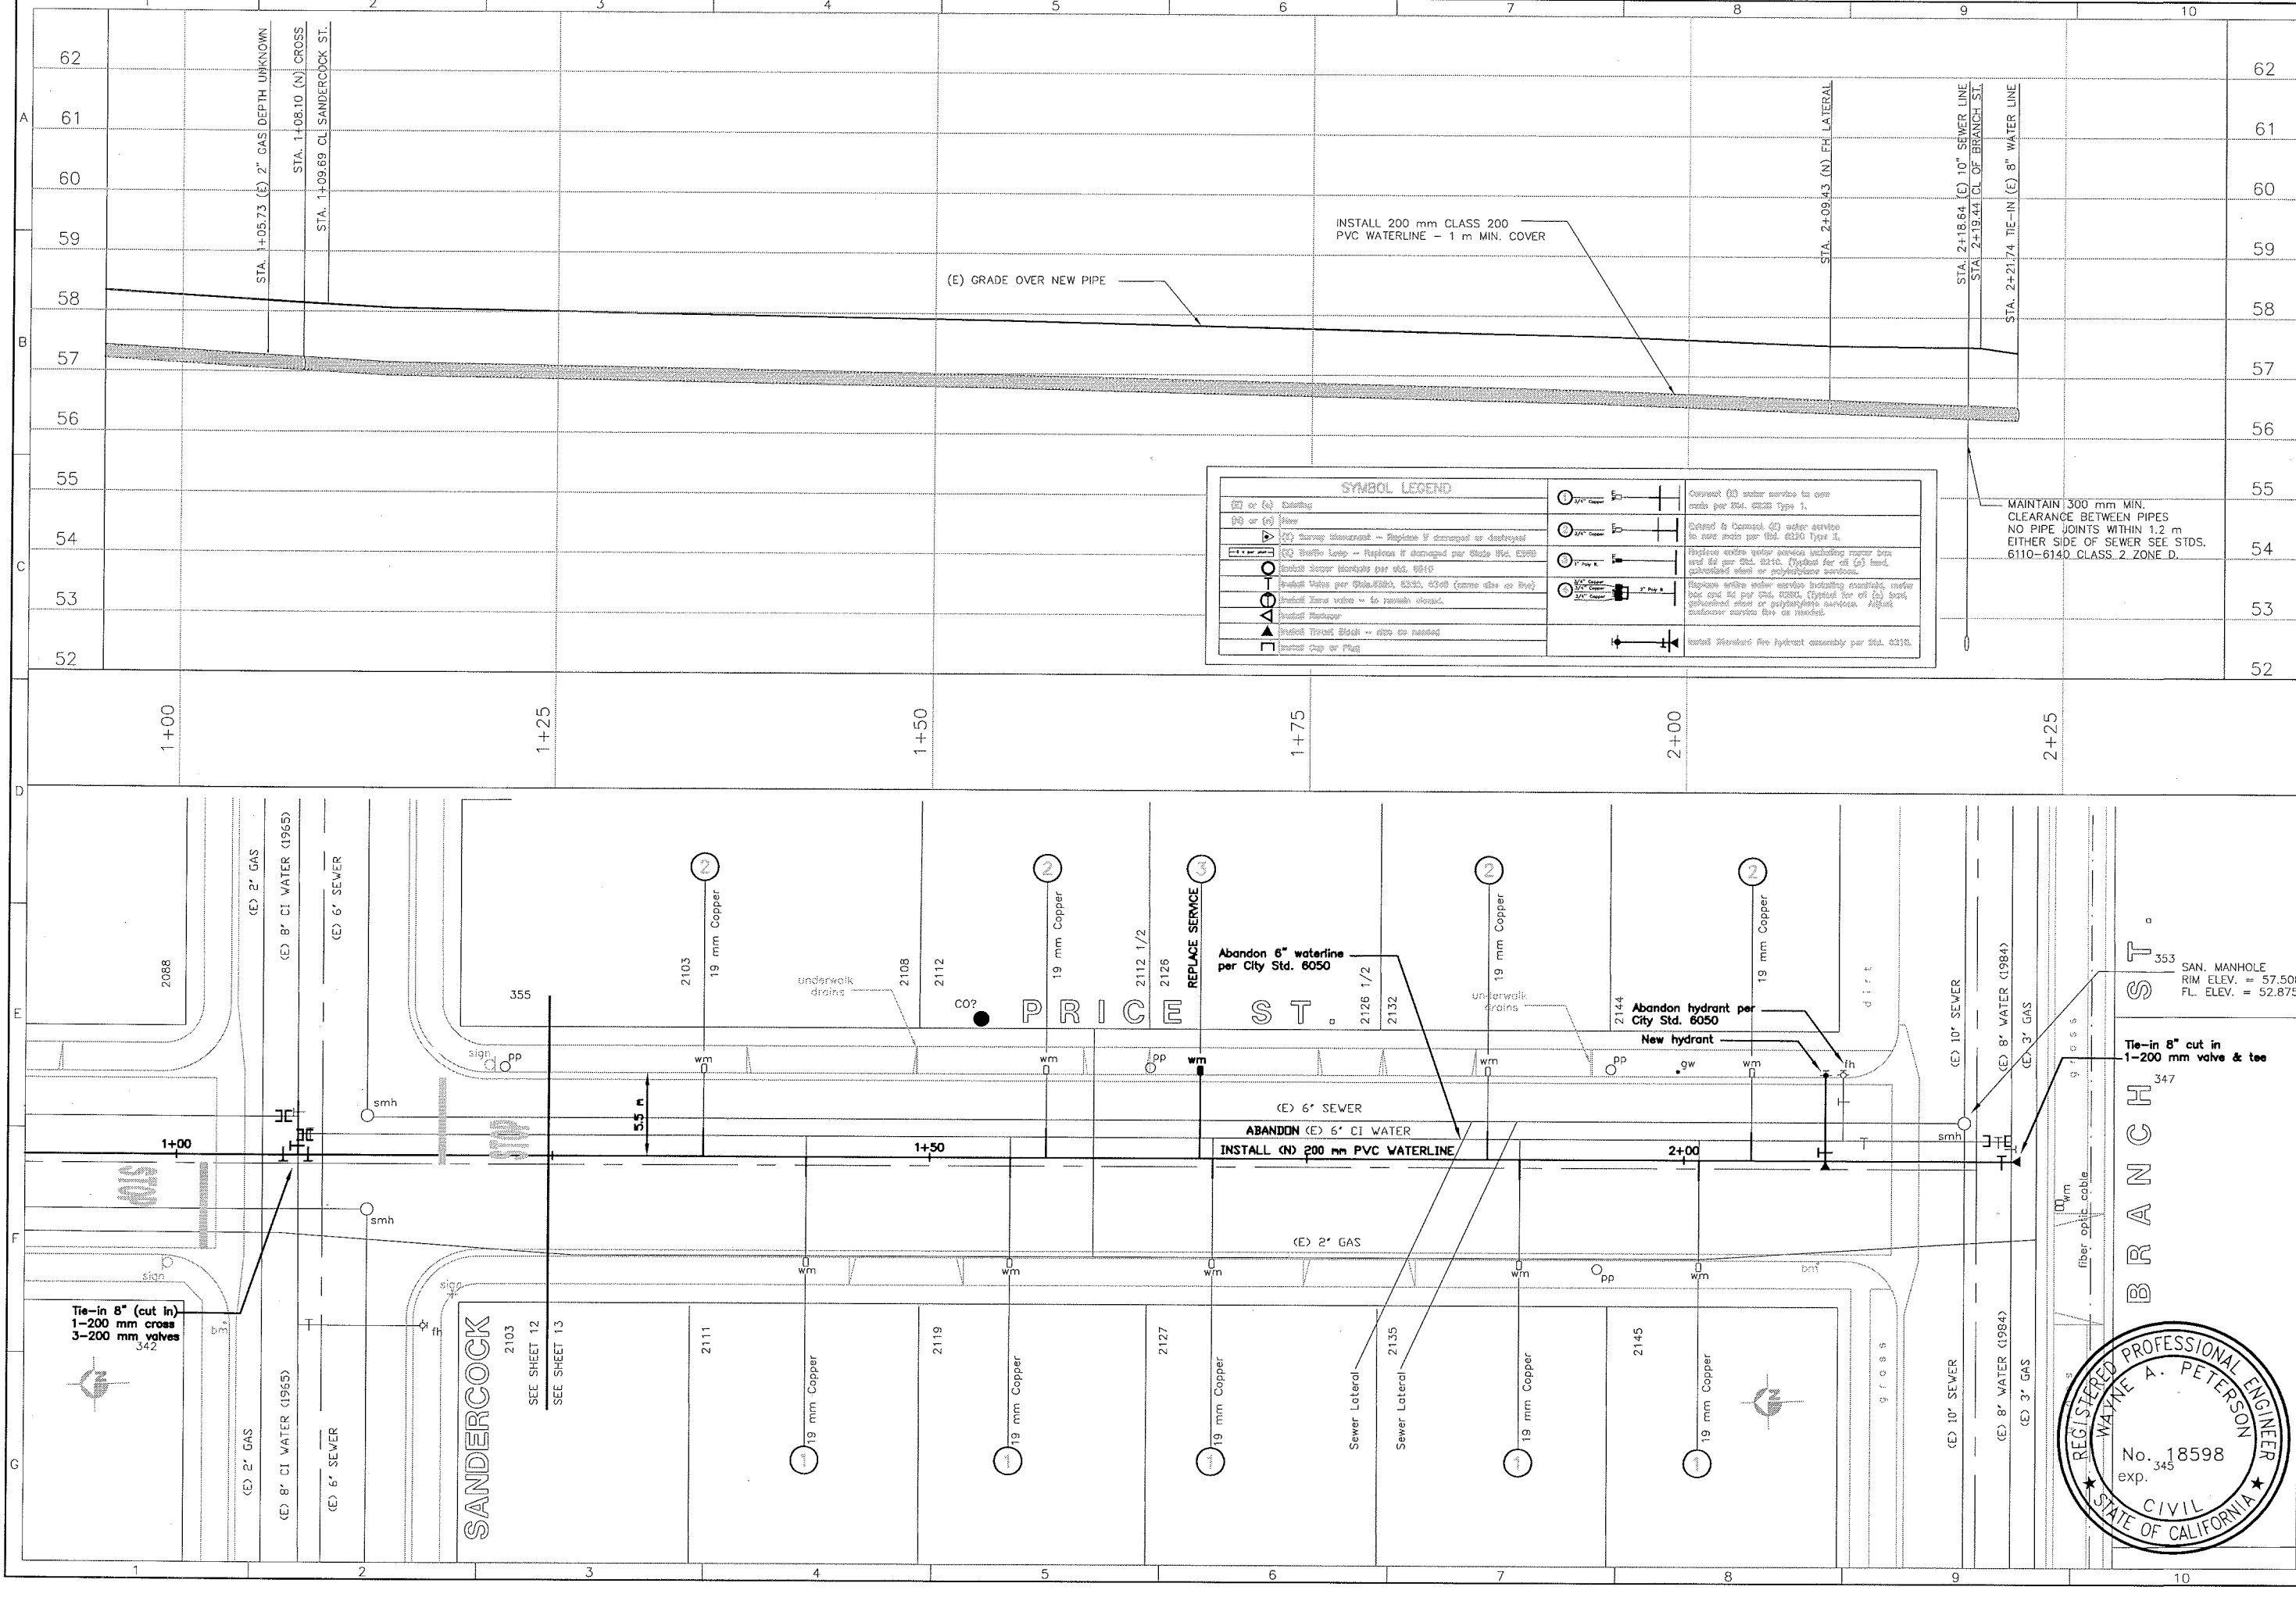

SYMBOL LEGEND	
(E) or (C) Existing	2" or 3" Sewer
(P) or (W) New	2" or 3" Water
(C) Survey Monument - Replace if damaged or destroyed	2" or 3" Sewer
(C) Traffic Light - Replace if damaged per State Std. 6300	2" or 3" Water
Install Sewer Manhole per Std. 6310	2" or 3" Sewer
Install Valve per State Std. 6330, 6335, 6340 (same size as line)	2" or 3" Water
Install Valve - to remain closed	2" or 3" Sewer
Install Hydrant	2" or 3" Water
Install Street Sign - size as needed	2" or 3" Sewer
Install Cap or Plug	2" or 3" Water

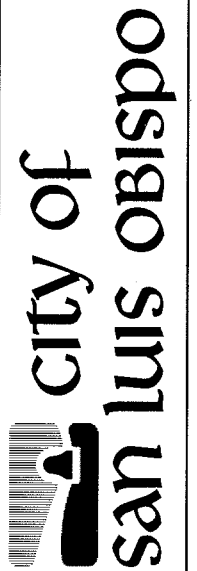

REVISIONS	
Drawn By & Date	Record Drawing
Drawn By & Date	Record Drawing

North Arrow Scale: 1" = 400' SCALE

PROJECT TITLE

PRICE STREET

SANDERCOCK ST. - BRANCH ST.

DESIGNED BY: JV

DRAWN BY: SR

CHECKED BY: SR


APPROVED BY: SR

DATE: DEC 1999


CITY SPECIFICATION NO. 90033

SHEET NO. 13 of 25



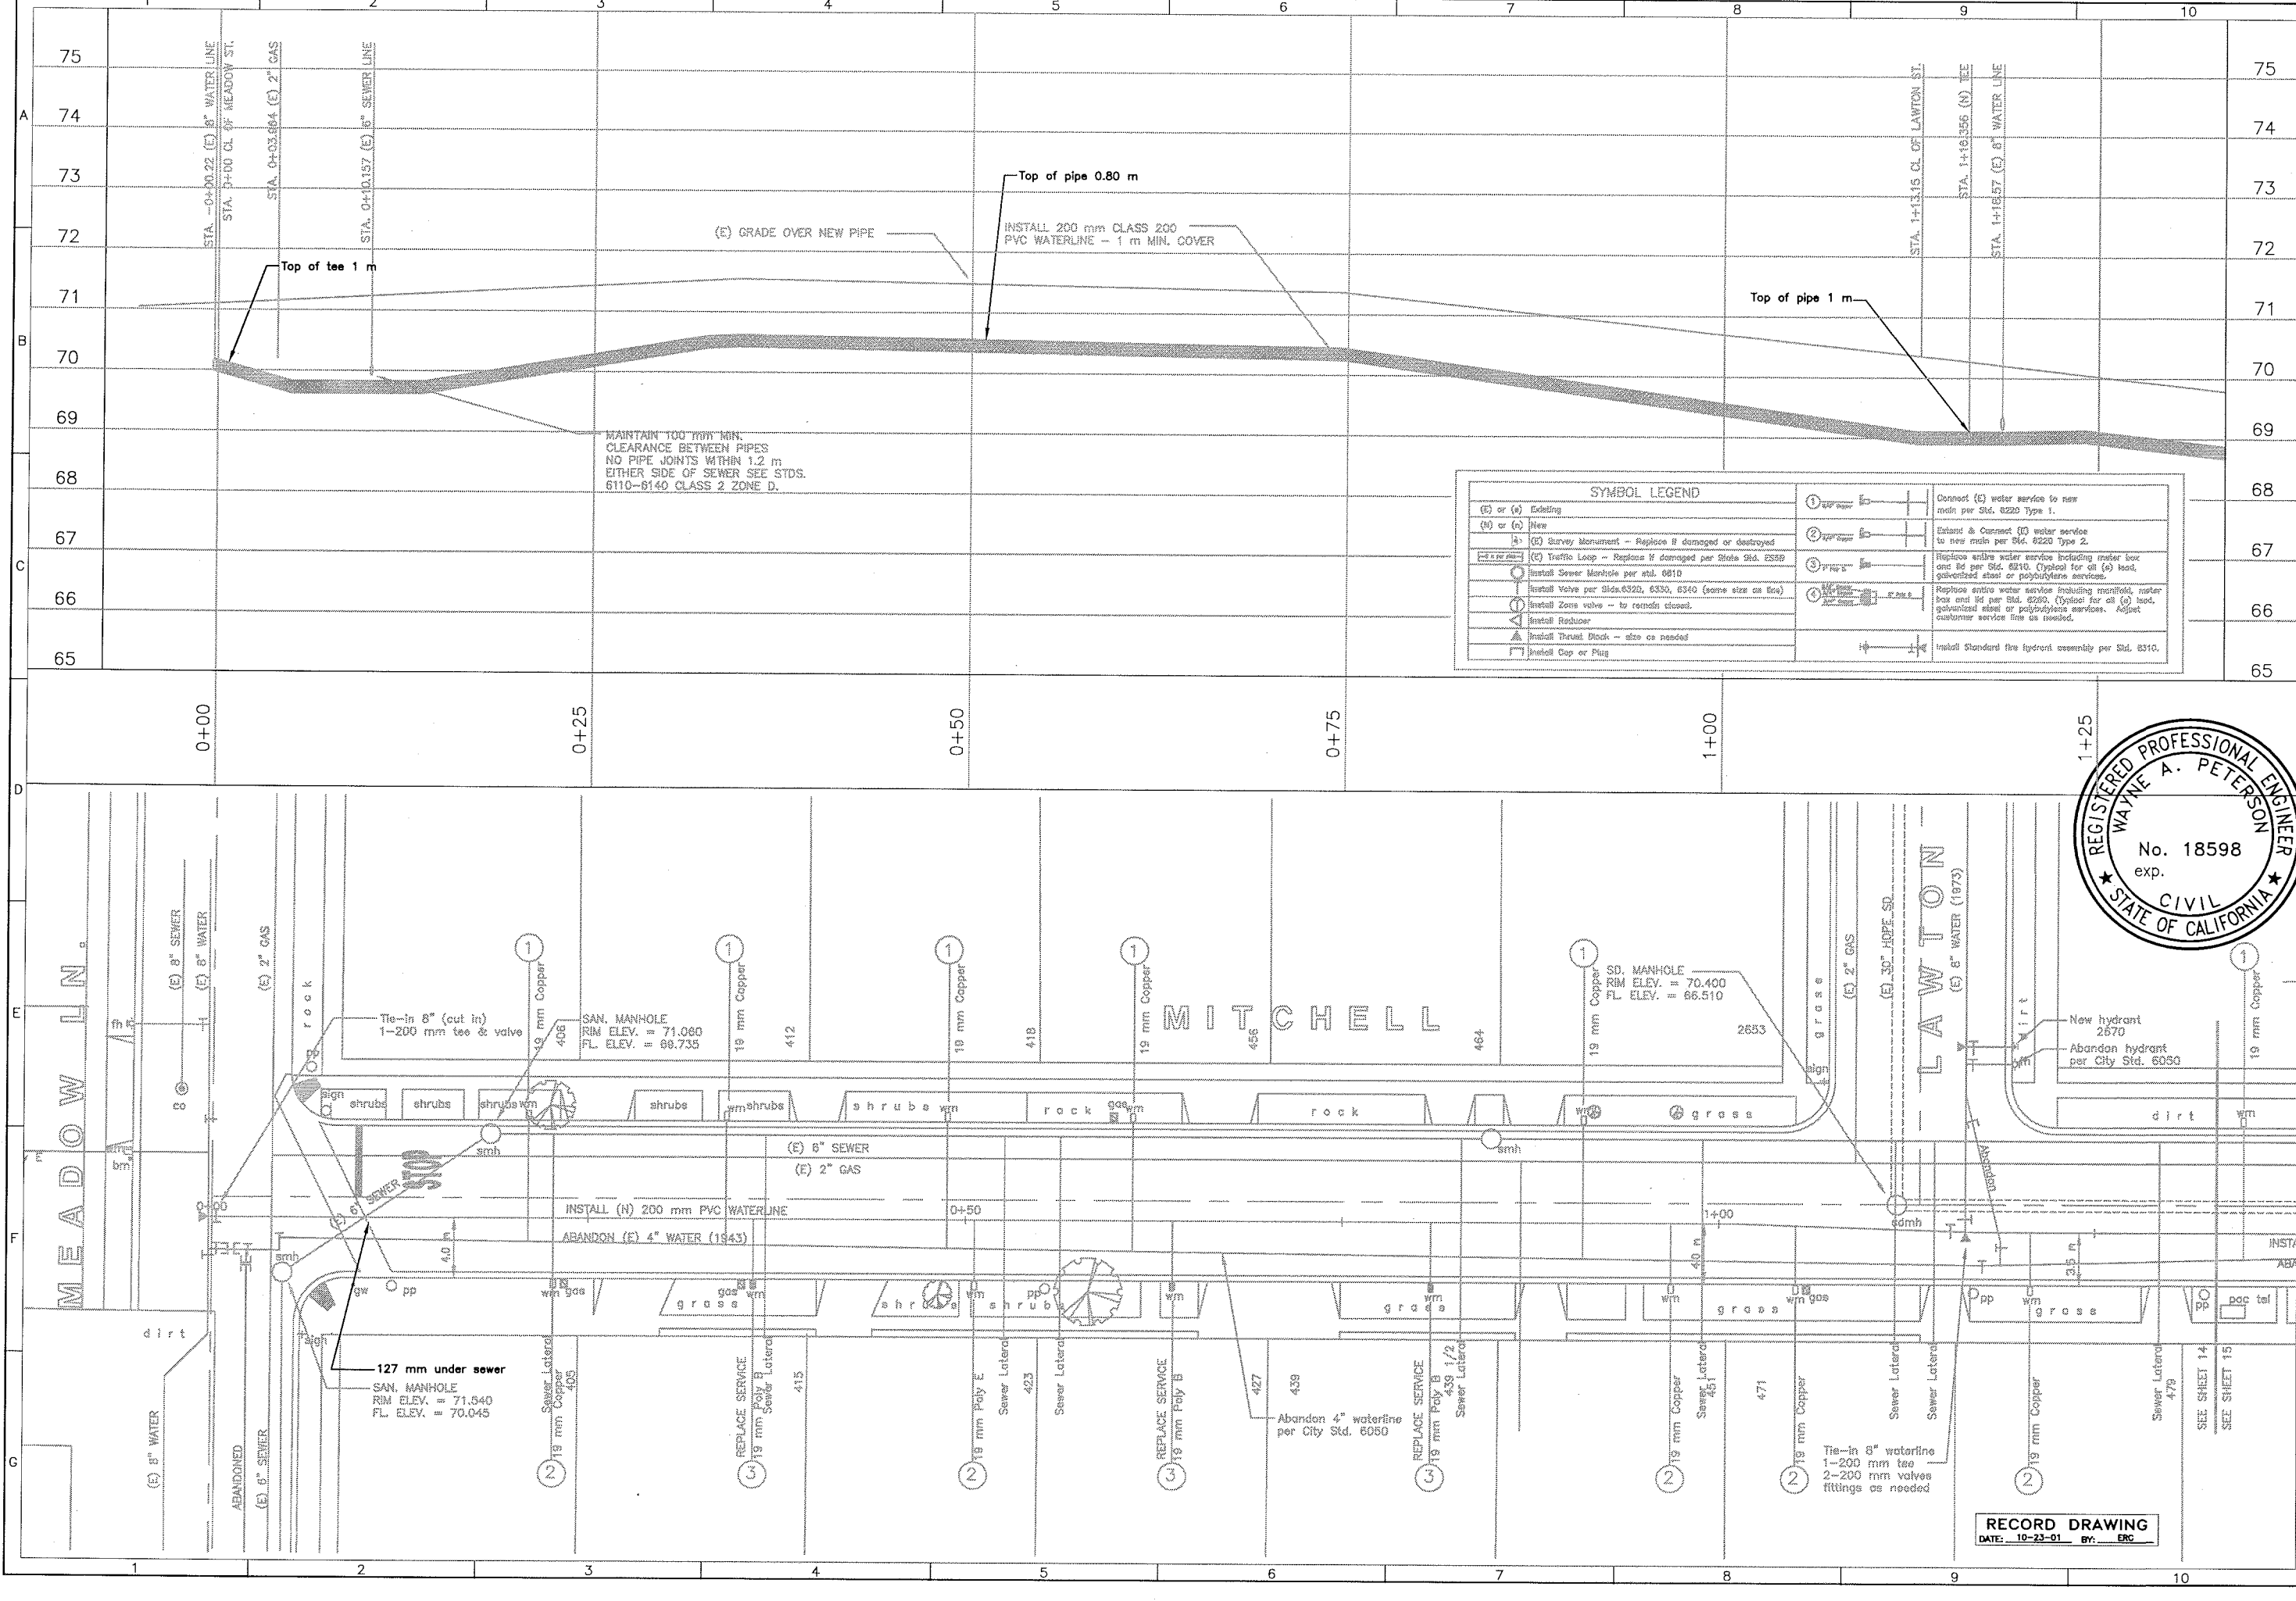

SYMBOL LEGEND	
(E) or (S) Existing	1. 1/2" Water
(H) or (N) New	2. 2" Water
Survey Monument - Replace if damaged or destroyed	3. 4" Water
(C) Traffic Loop - Replace if damaged per State Std. 255B	4. 6" Water
Install Sewer Manhole per std. 6810	5. 8" Water
Install Valve per State Std. 6320, 6330, 6340 (same size as line)	6. 10" Water
Install Zone Valve - to remain closed	7. 12" Water
Install Reducer	8. 14" Water
Install Thrust Block - size as needed	9. 16" Water
Install Cap or Plug	10. 18" Water
	11. 20" Water
	12. 24" Water
	13. 30" Water
	14. 36" Water
	517. 3054" Water
	518. 3060

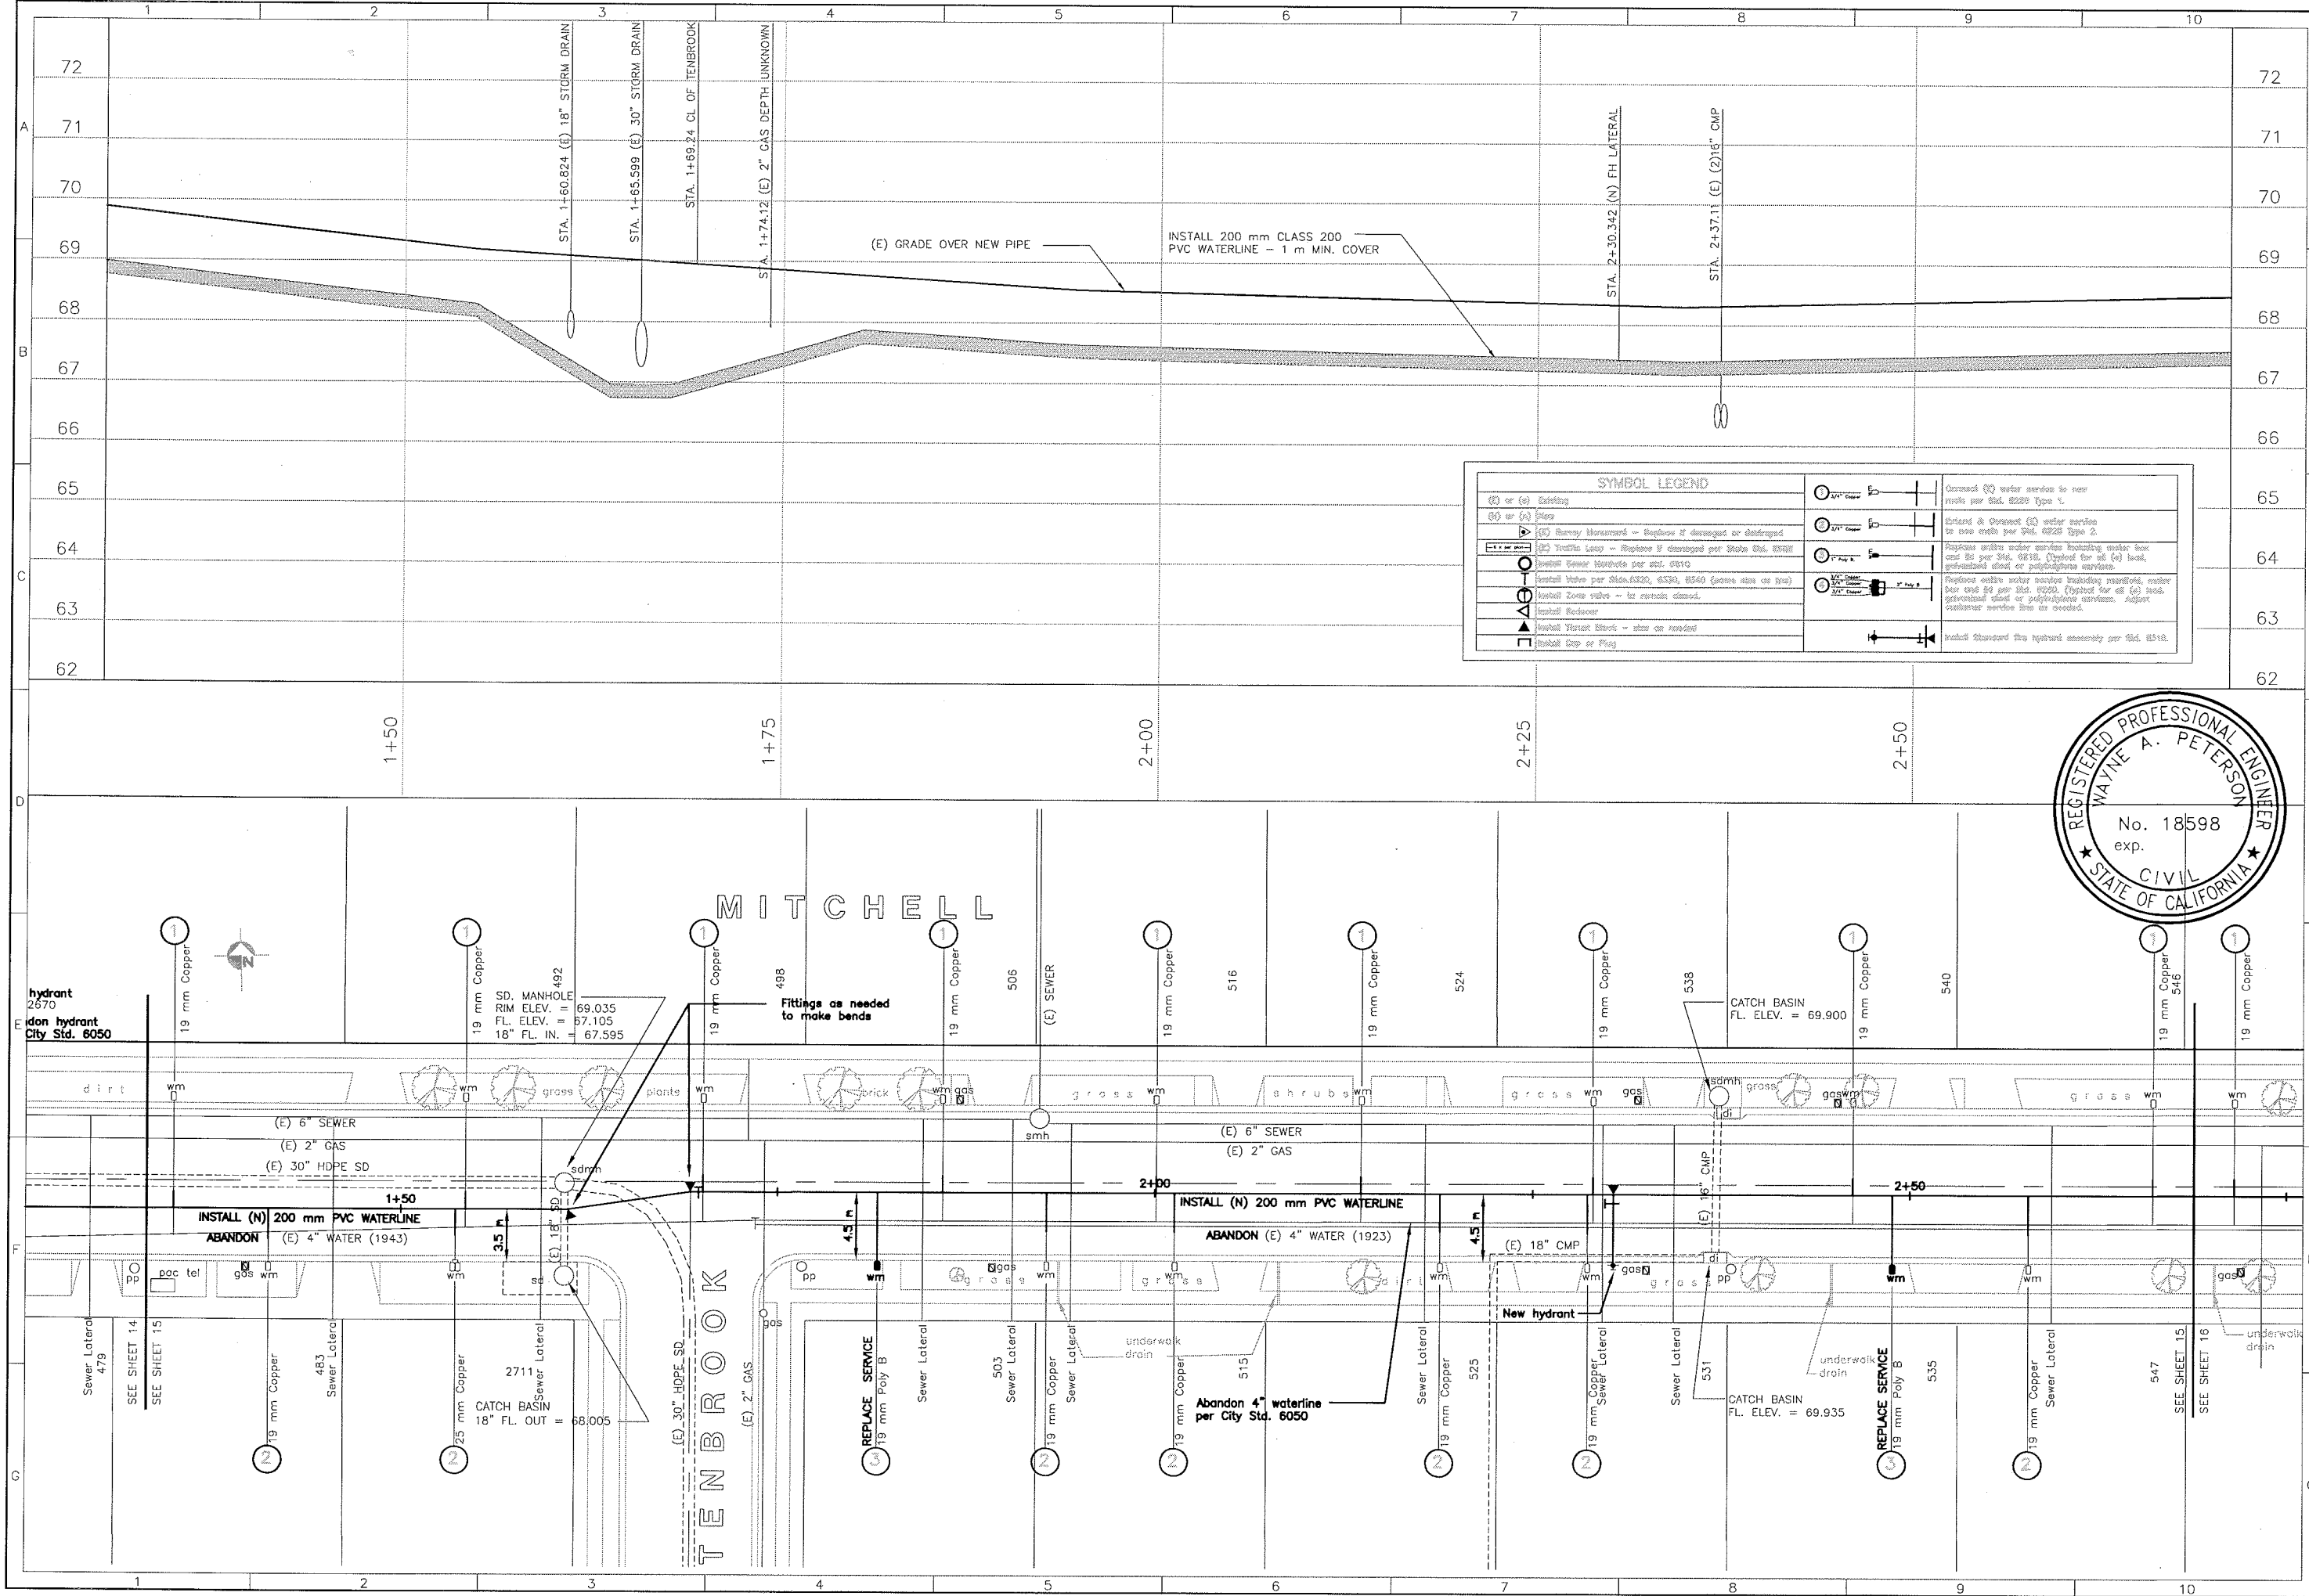

SYMBOL LEGEND	
(E) or (N) Existing	24\"/>
(S) or (N) New	24\"/>
(E) Survey Monument - Replace if damaged or destroyed	24\"/>
(E) Traffic Light - Replace if damaged per State Std. 6225	24\"/>
Install Valve per Std. 6320, 6330, 6340 (same size as line)	24\"/>
Install Zone Valve - to remain closed	24\"/>
Install Reducer	24\"/>
Install Vent Stack - also as needed	24\"/>
Install Dip or Plug	24\"/>



city of
san luis obispo

REVISIONS:
Drawn By & Date
Record Drawing
Drawn By & Date


PROJECT TITLE
MITCHELL STREET
LAWTON ST. - TENBROOK ST.

DESIGNED BY:
JV
DRAWN BY:
SR
CHECKED BY:
CHECKED BY:
APPROVED BY:

DATE:
DEC 1999
CITY SPECIFICATION NO.
90033
SHEET NO.
15 of 25

etric Scale:
H: 1:400
V: SCALE

REGISTERED PROFESSIONAL ENGINEER
WAYNE A. PETERSON
No. 18598
exp.
CIVIL
STATE OF CALIFORNIA

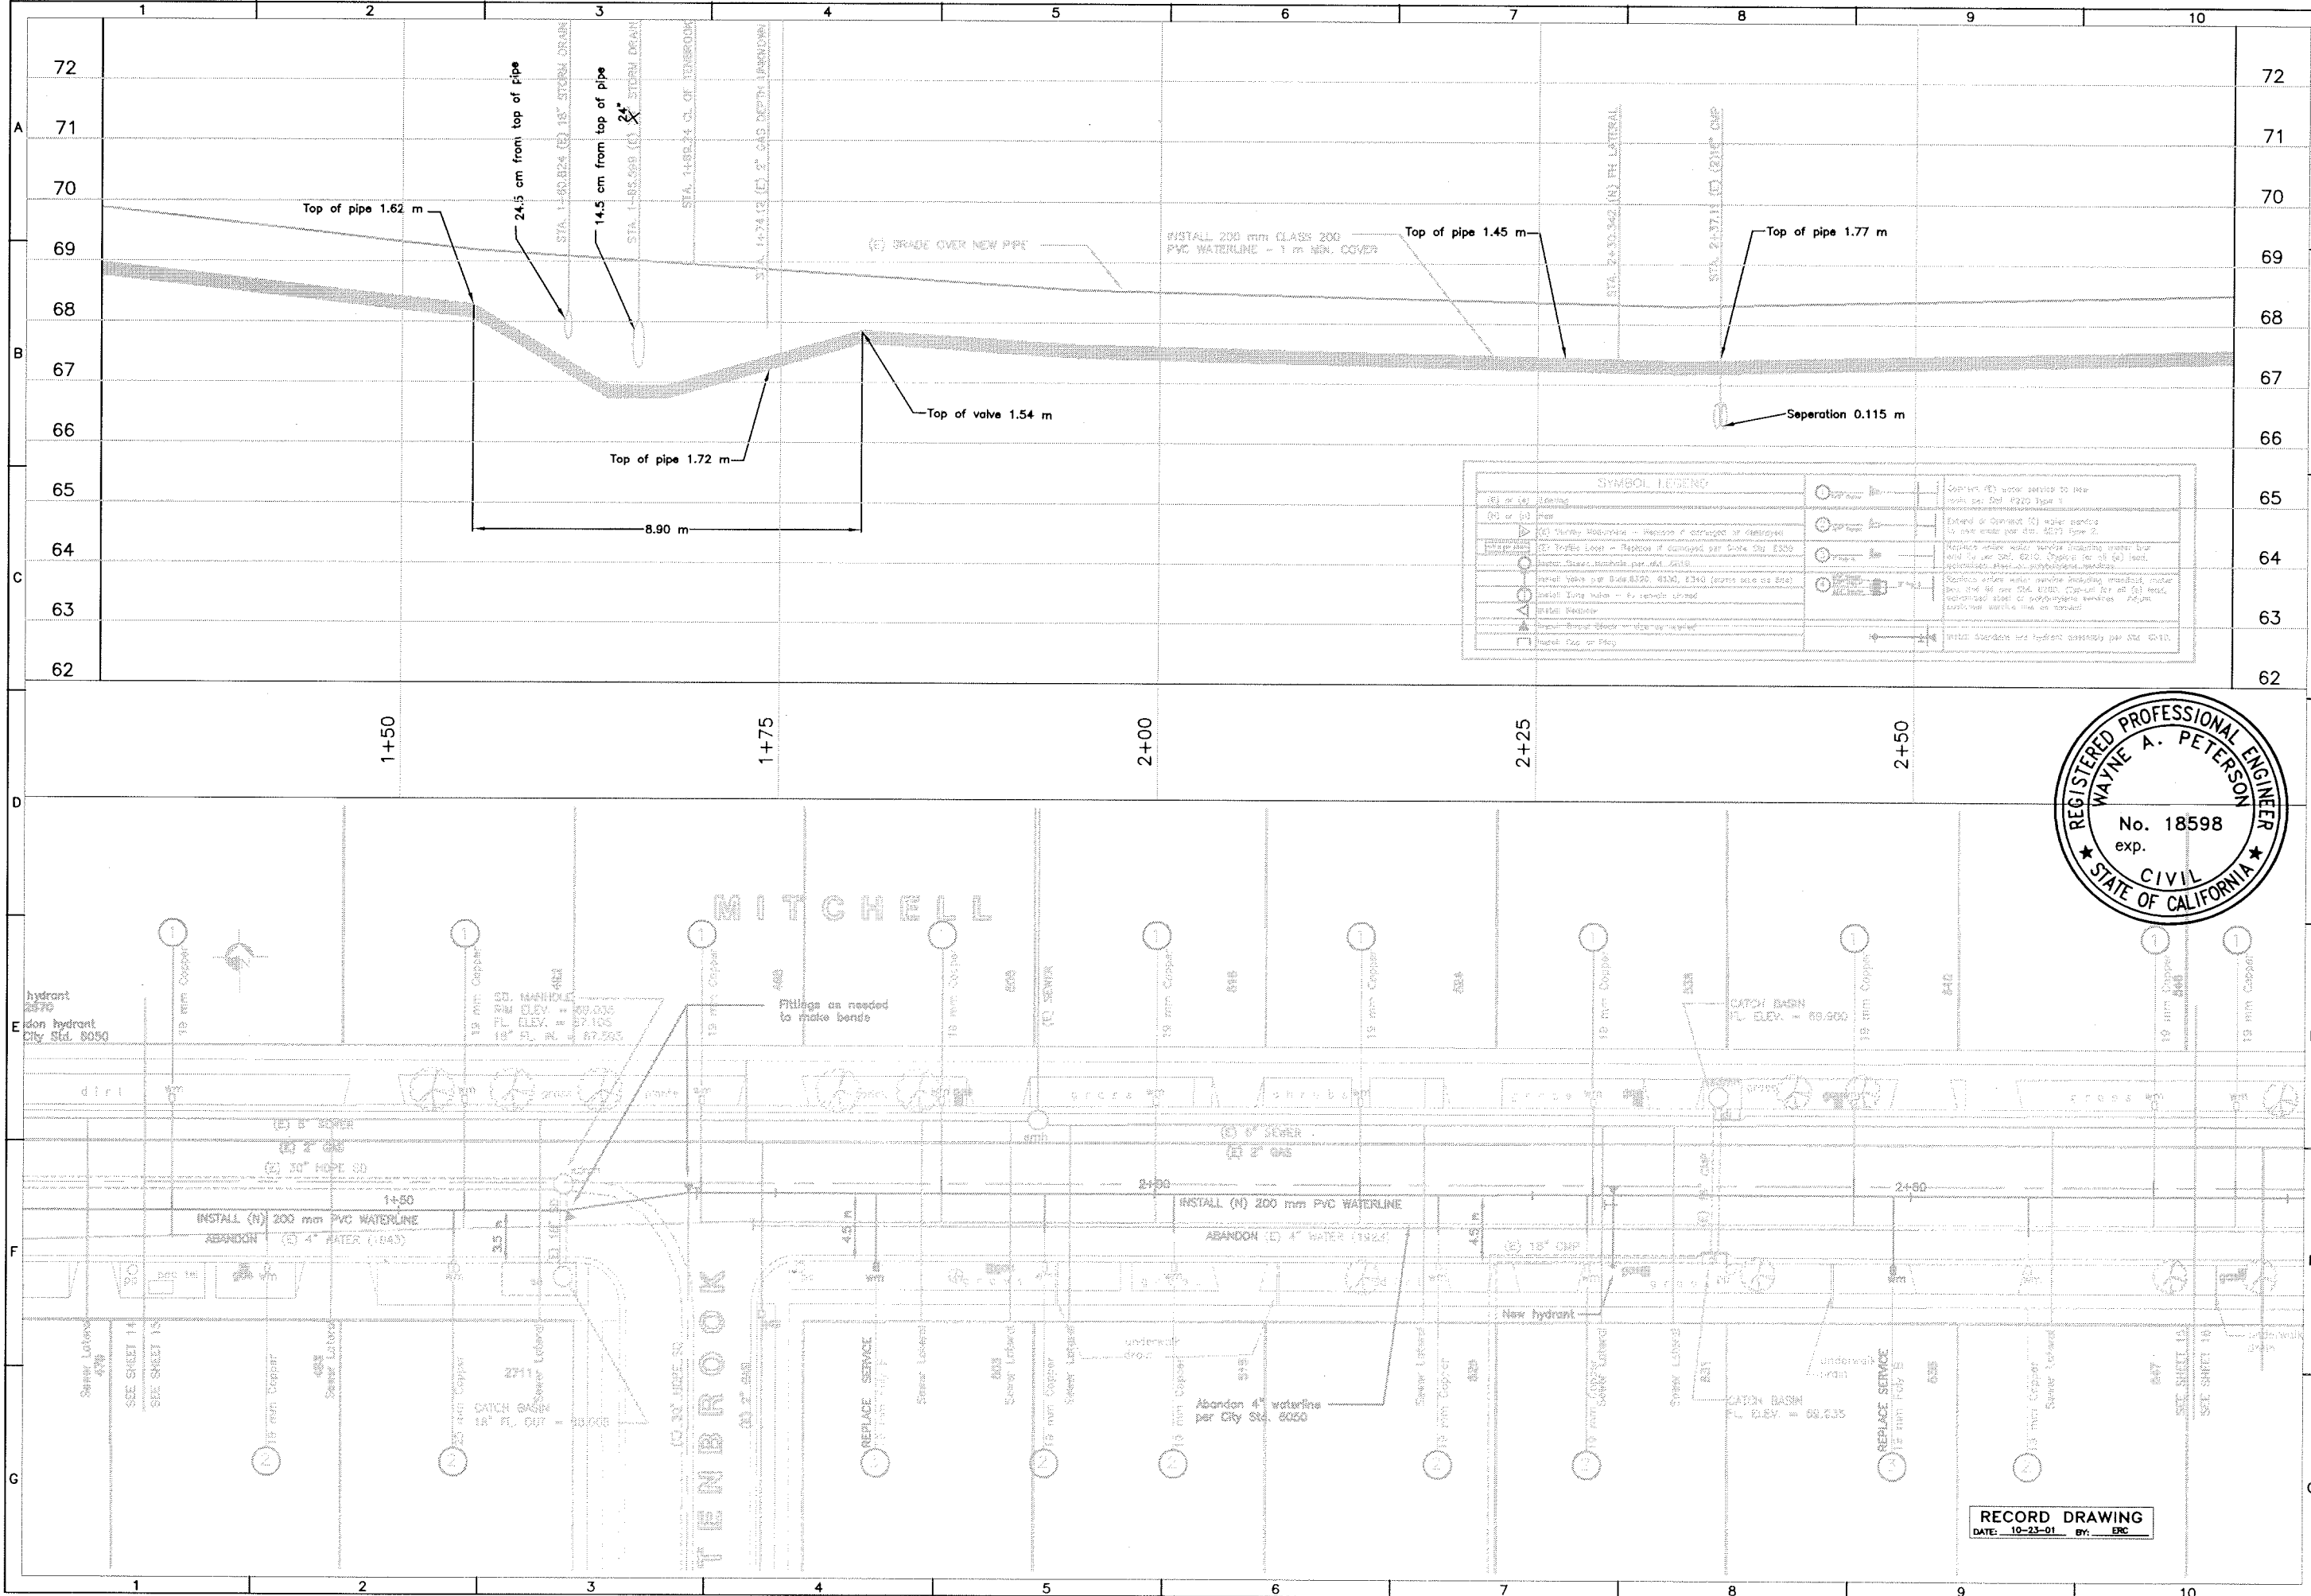

city of

san luis obispo

PROJECT TITLE

MITCHELL STREET
LAWTON ST. - TENBROOK ST.

DESIGNED BY:
JV

DRAWN BY:
SR

CHECKED BY:
[Signature]

APPROVED BY:
[Signature]

DATE:
DEC 1999

CITY SPECIFICATION NO.
90033


SHEET NO.
15a of 25

REVISIONS:

Drawn By & Date
Record Drawing

Drawn By & Date

Scale: 1:400

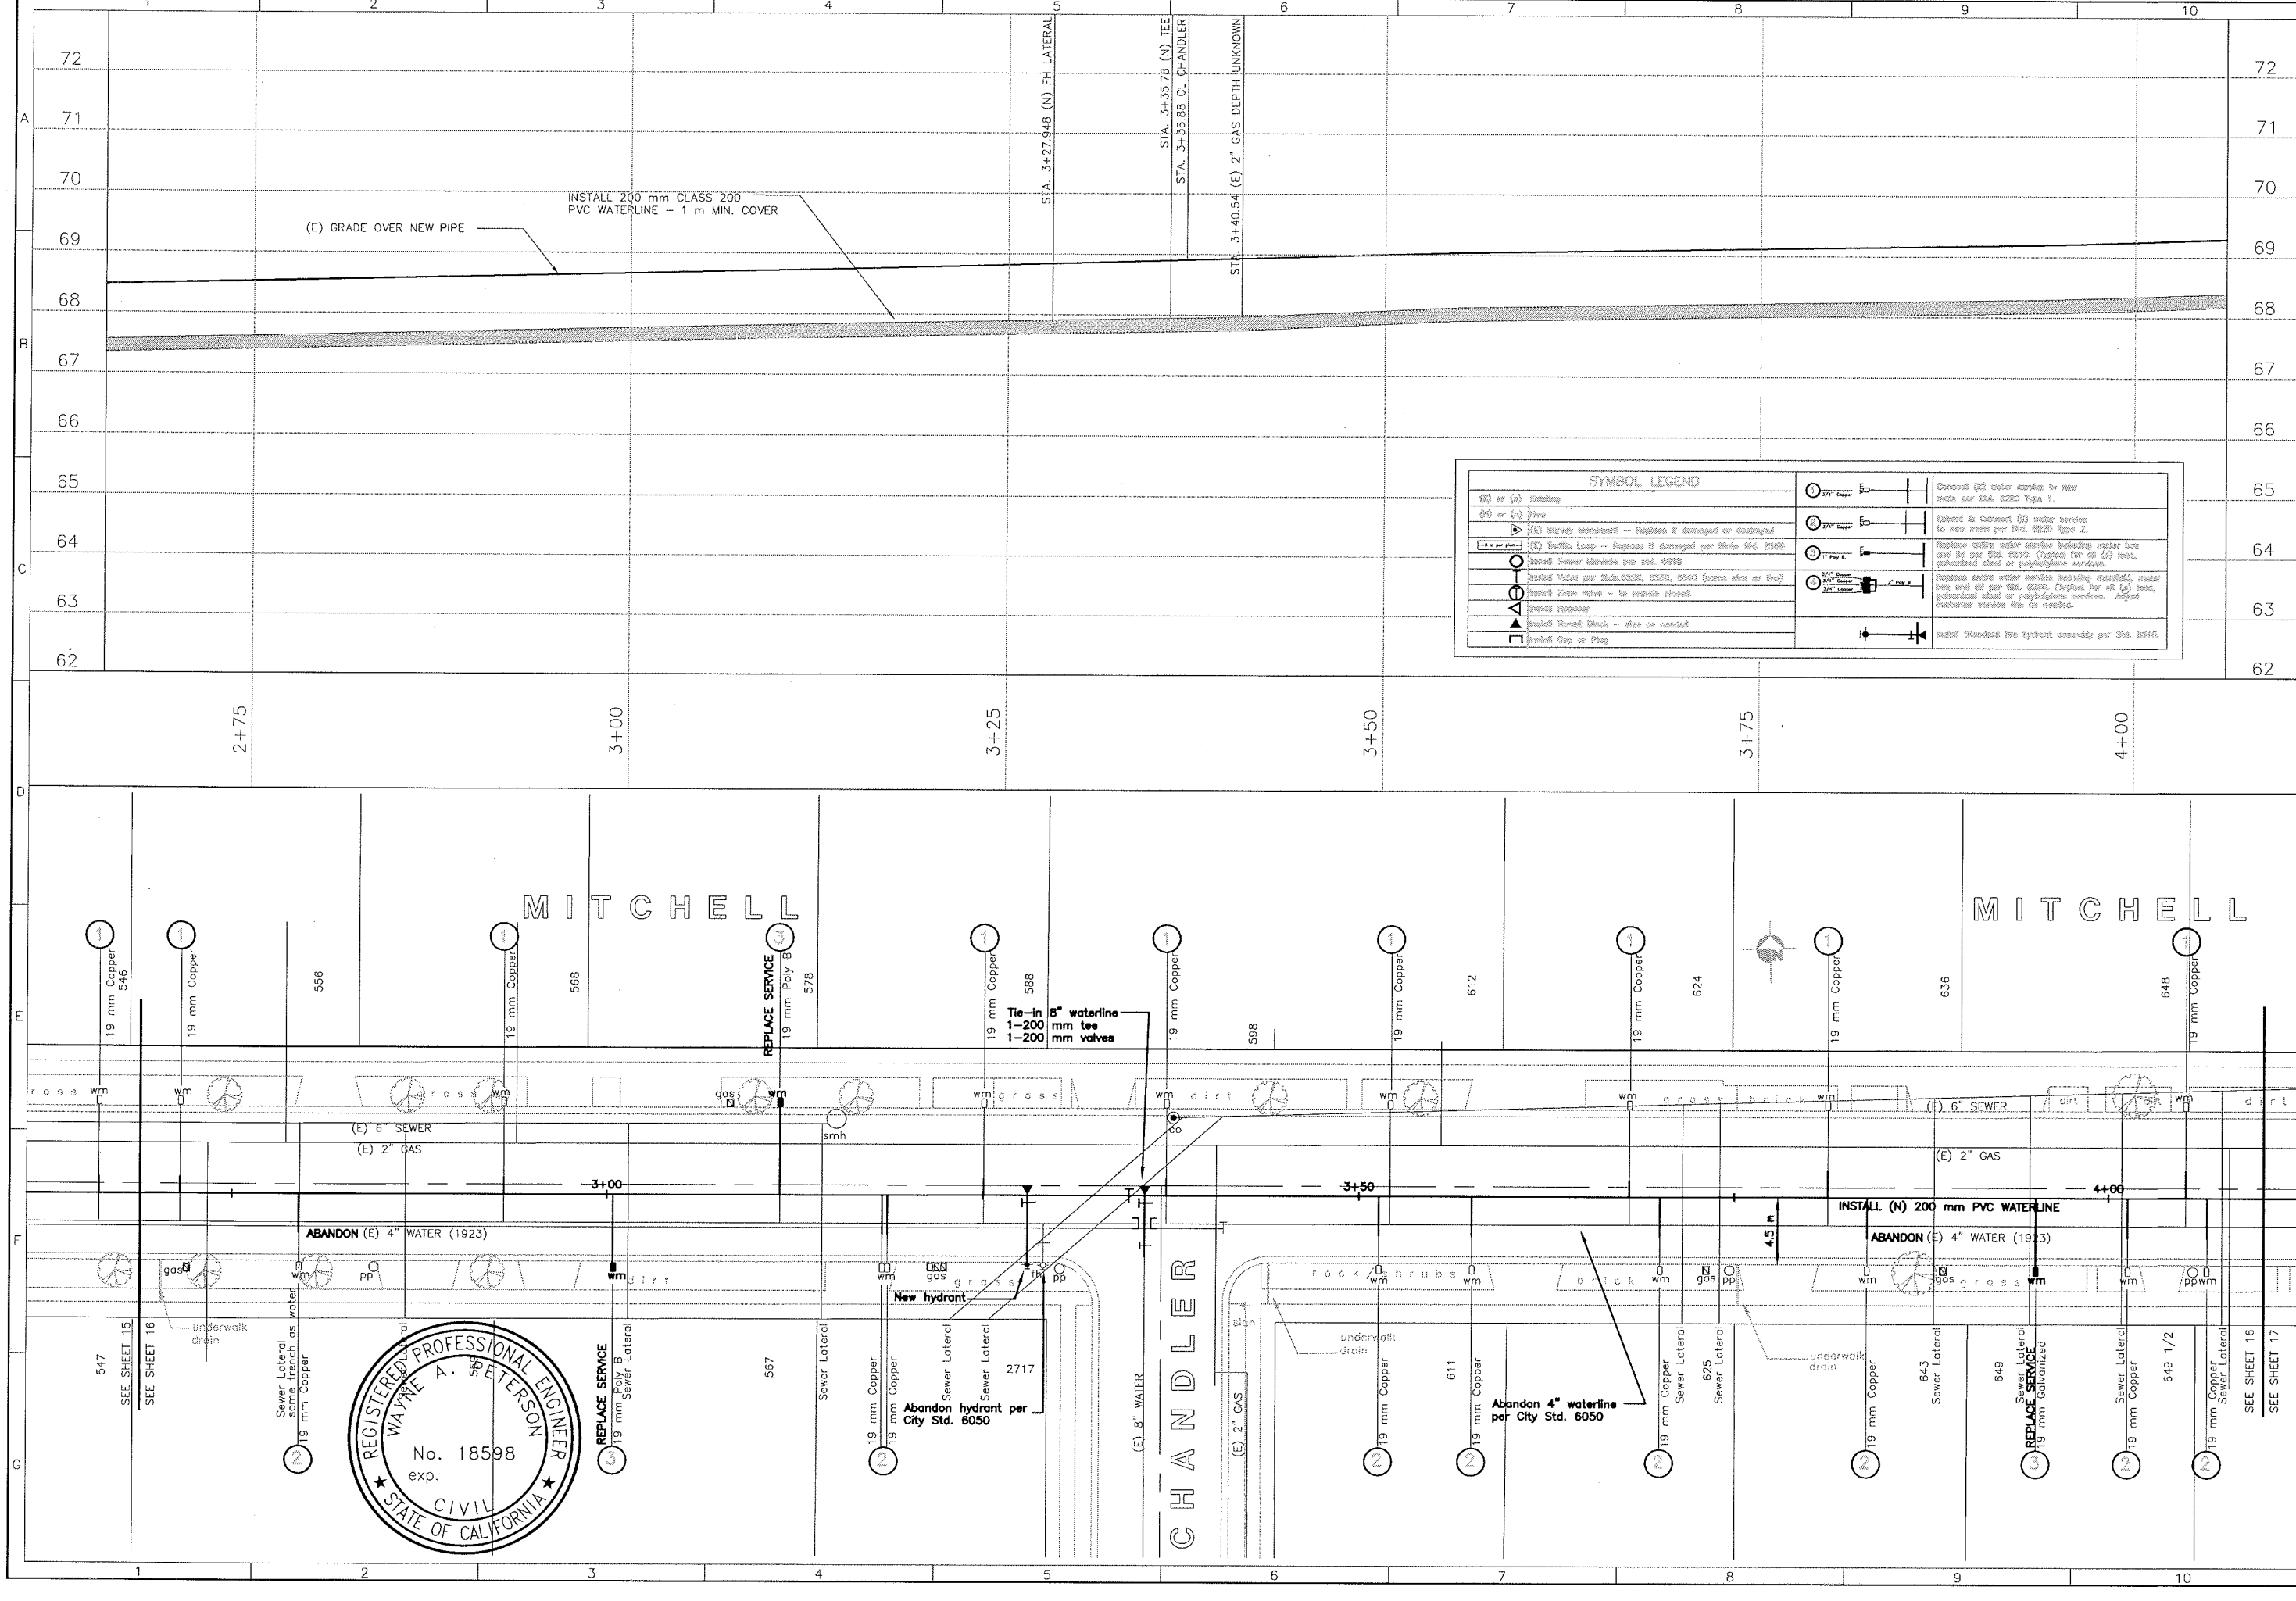

SYMBOL LEGEND		
(E) or (S) Existing		Connect (E) water service to new main per Std. 6220 Type 1.
(P) or (G) New		Reconnect & Connect (P) water service to new main per Std. 6220 Type 2.
(E) Survey Monument - Replace if damaged or destroyed		Replace water meter service including meter box and lid per Std. 6310. (Applied for all (E) lead, galvanized steel or polyethylene services.)
(E) Traffic Loop - Replace if damaged per Std. 6509		Replace water meter service including meter box and lid per Std. 6220. (Applied for all (E) lead, galvanized steel or polyethylene services. Submit customer service form as needed.)
Install Sewer Manhole per Std. 6819		Install Water Meter per Std. 6320, 6320, 6340 (same when as Std.)
Install Valve per Std. 6320, 6320, 6340 (same when as Std.)		Install Zone Valve - to records shown.
Install Zone Valve - to records shown.		Install Reducer
Install Reducer		Install Street Block - size as needed
Install Street Block - size as needed		Install Cap or Plug
Install Cap or Plug		Install Standard fire hydrant assembly per Std. 6310.



city of
san luis obispo

REVISIONS:

Drawn By & Date	Record Drawing	Drawn By & Date

PROJECT TITLE

MITCHELL STREET
AT CHANDLER STREET

DESIGNED BY:

JV

DRAWN BY:

SR

CHECKED BY:

CHECKED BY

APPROVED BY:

DATE:


DEC 1999

CITY SPECIFICATION NO.

90033

SHEET NO.

16 of 25


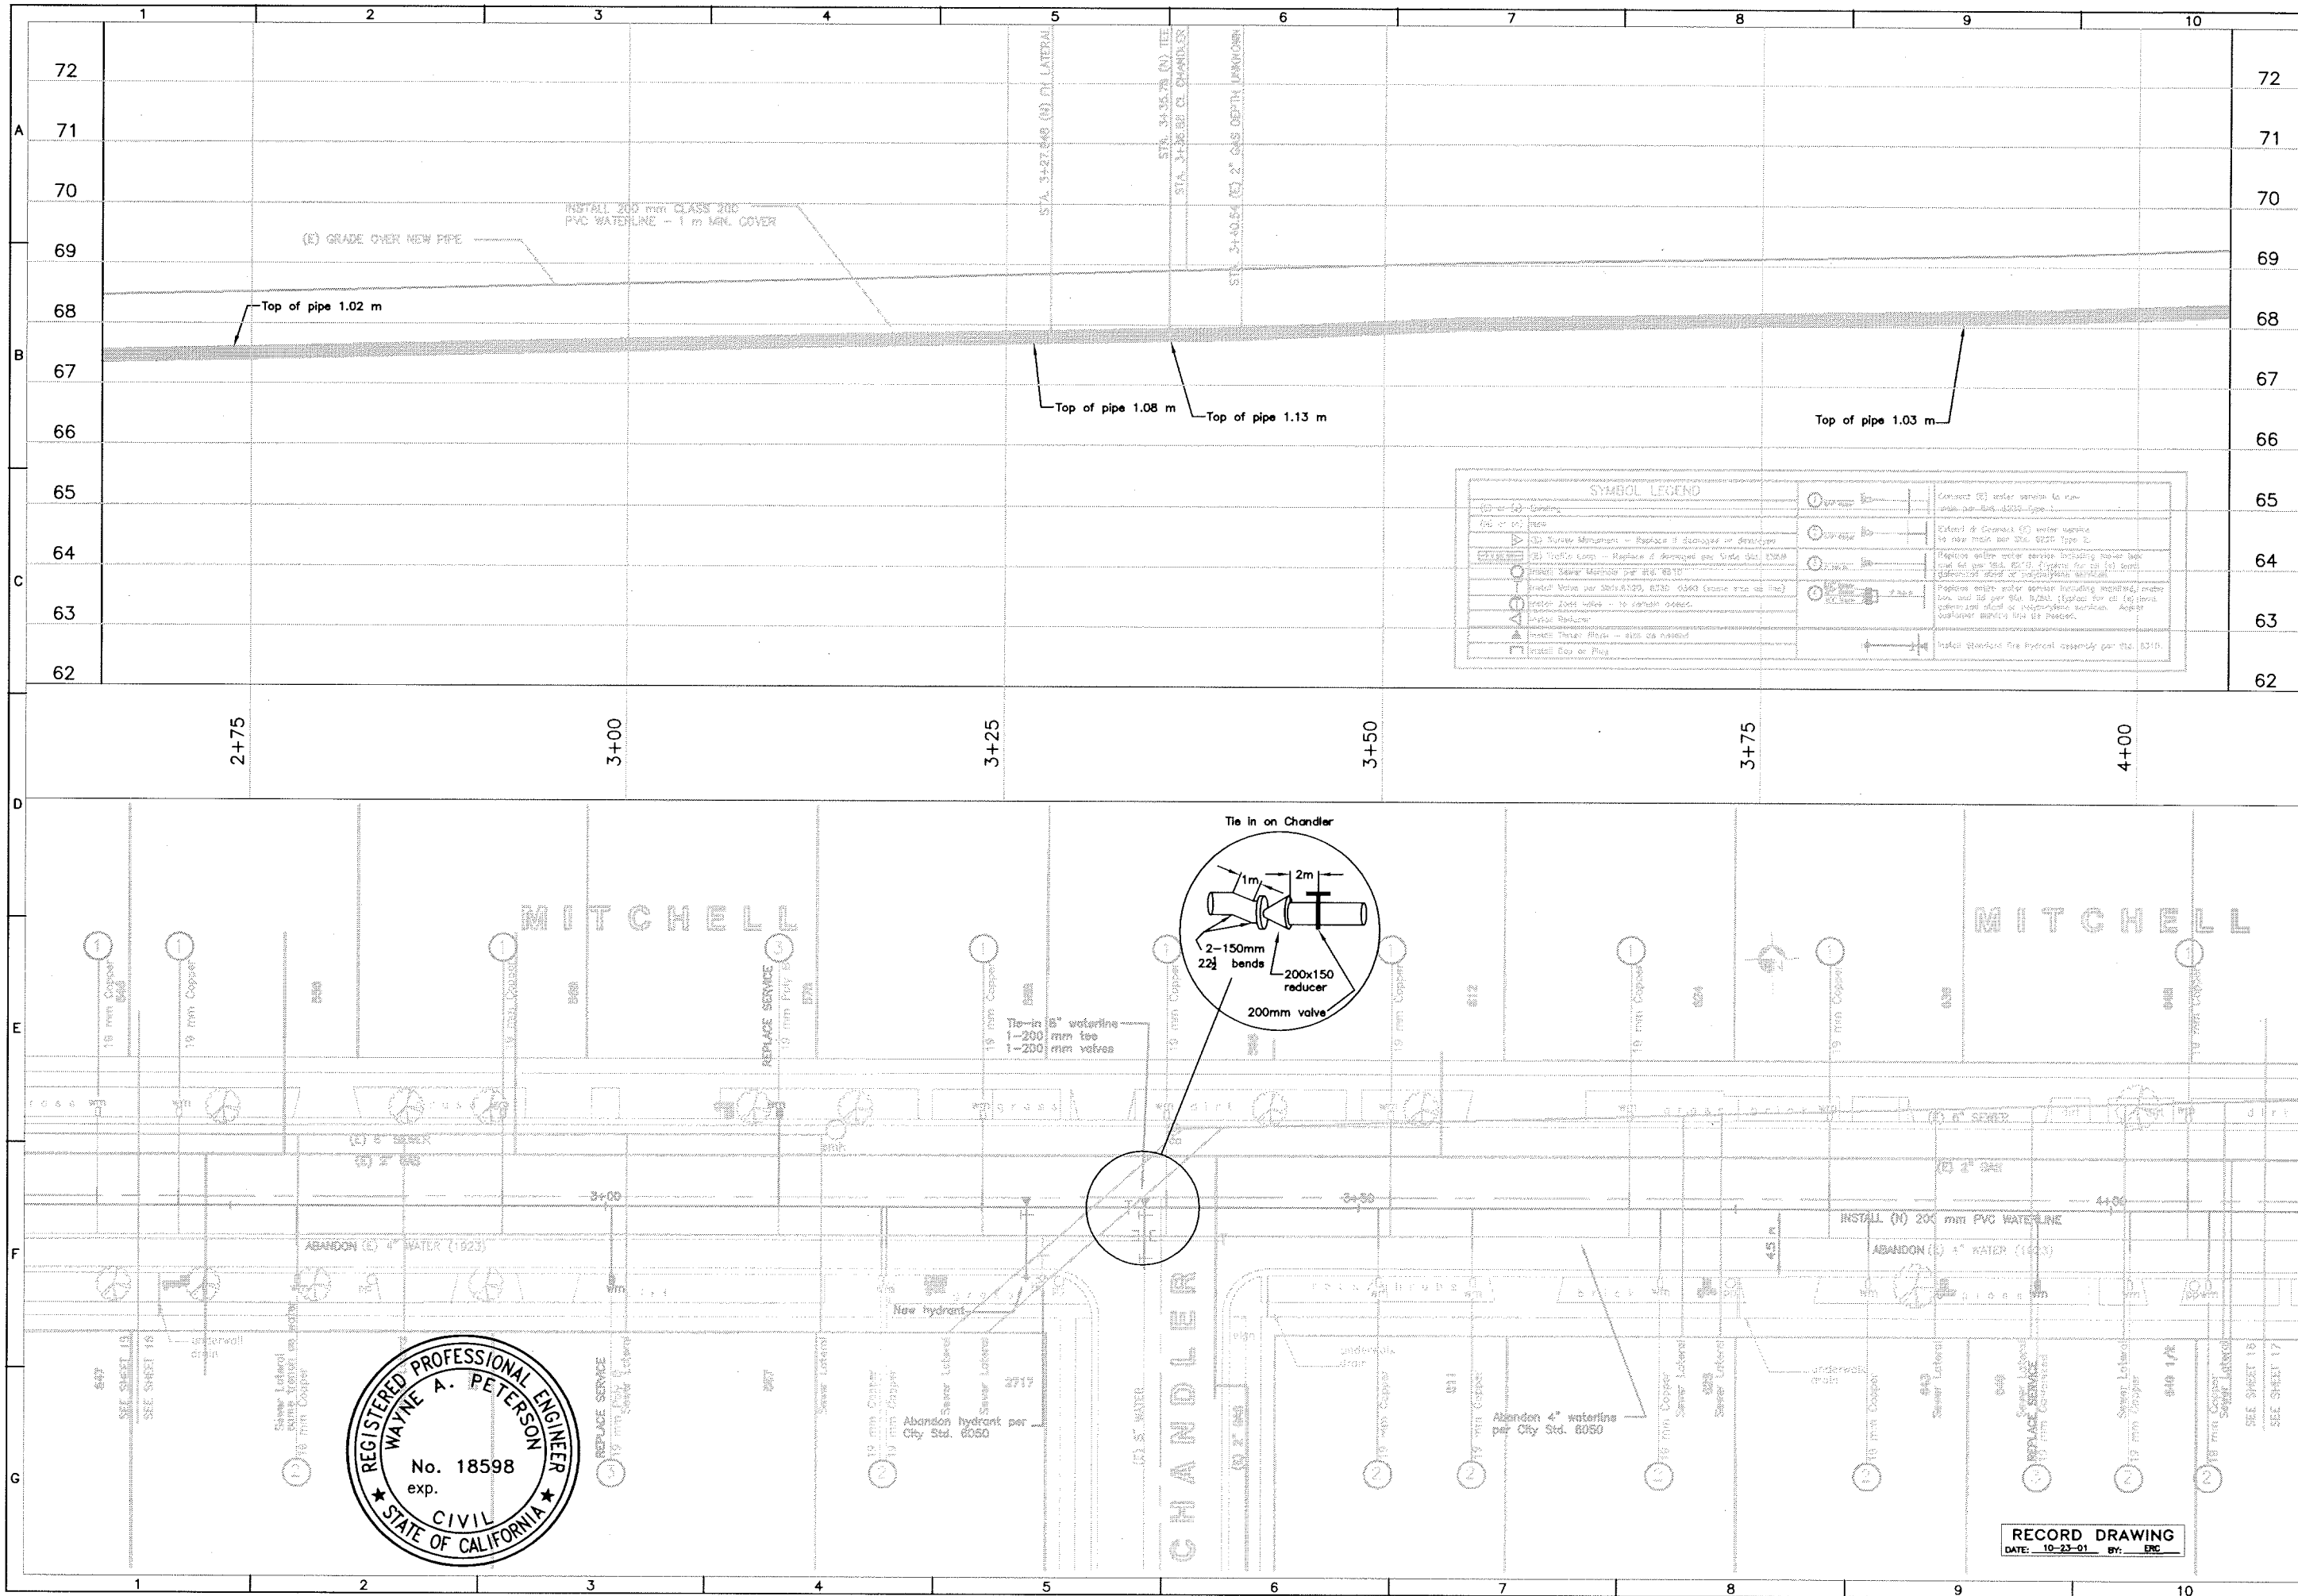


SYMBOL LEGEND	
(1) or (2) - 150mm	Connect (1) under service to new water per City Std. 6050 - Type 1.
(1) or (2) - 150mm	Connect (2) under service to new water per City Std. 6050 - Type 2.
(1) or (2) - 150mm	Connect (3) under service to new water per City Std. 6050 - Type 3.
(1) or (2) - 150mm	Connect (4) under service to new water per City Std. 6050 - Type 4.
(1) or (2) - 150mm	Connect (5) under service to new water per City Std. 6050 - Type 5.
(1) or (2) - 150mm	Connect (6) under service to new water per City Std. 6050 - Type 6.
(1) or (2) - 150mm	Connect (7) under service to new water per City Std. 6050 - Type 7.
(1) or (2) - 150mm	Connect (8) under service to new water per City Std. 6050 - Type 8.
(1) or (2) - 150mm	Connect (9) under service to new water per City Std. 6050 - Type 9.
(1) or (2) - 150mm	Connect (10) under service to new water per City Std. 6050 - Type 10.



REVISIONS:	Drawn By & Date	Record Drawing	Drawn By & Date

PROJECT TITLE	MITCHELL STREET AT CHANDLER STREET
DESIGNED BY:	JV
DRAWN BY:	SR
CHECKED BY:	
APPROVED BY:	
DATE:	DEC 1999
CITY SPECIFICATION NO.	90033
SHEET NO.	16a of 25

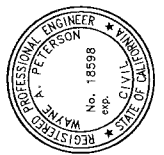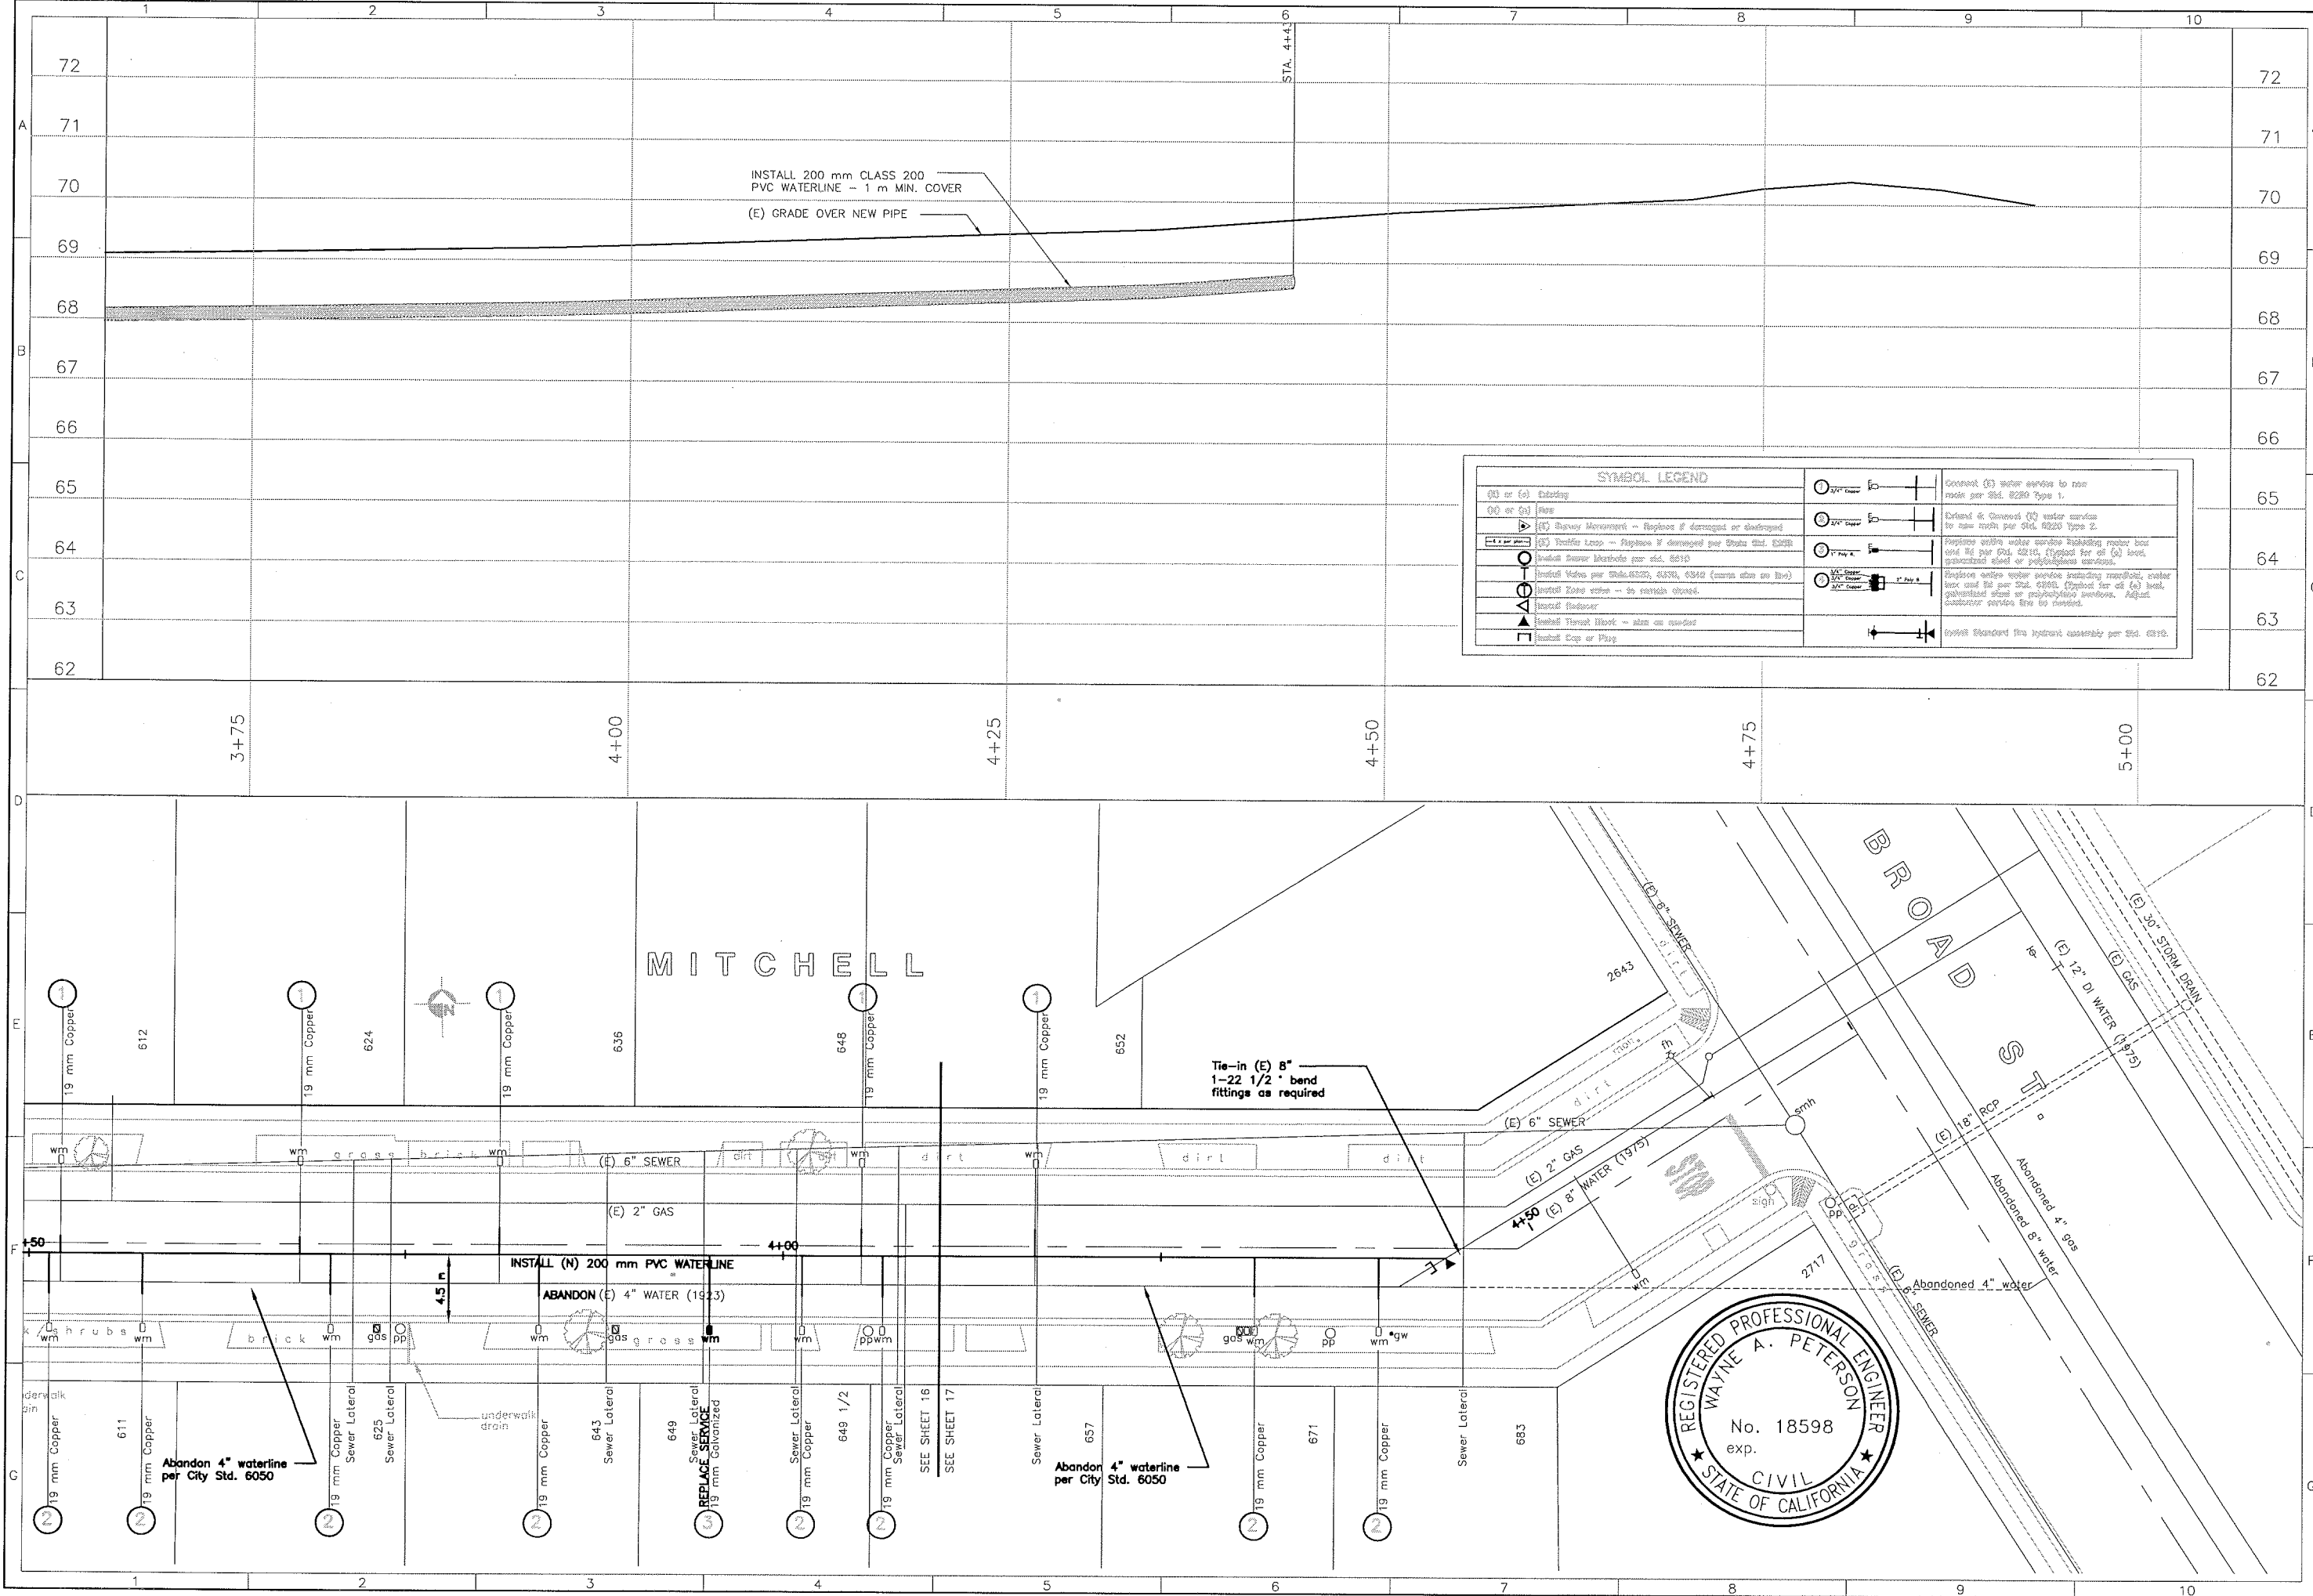The logo for the City of San Luis Obispo, featuring a stylized mountain peak and the text "city of" above "san luis obispo".

etric Scale:
 H: 1:400
 V: SCALE


PROJECT TITLE
MITCHELL STREET
AT BROAD STREET

SHEET TITLE:

SIGNED BY: _____
JV
DRAWN BY: _____
SR
CHECKED BY: _____
CHECKED BY _____
PROVED BY: _____

TE:
DEC 1999
Y SPECIFICATION NO.
90033
EET NO.


7 of 25

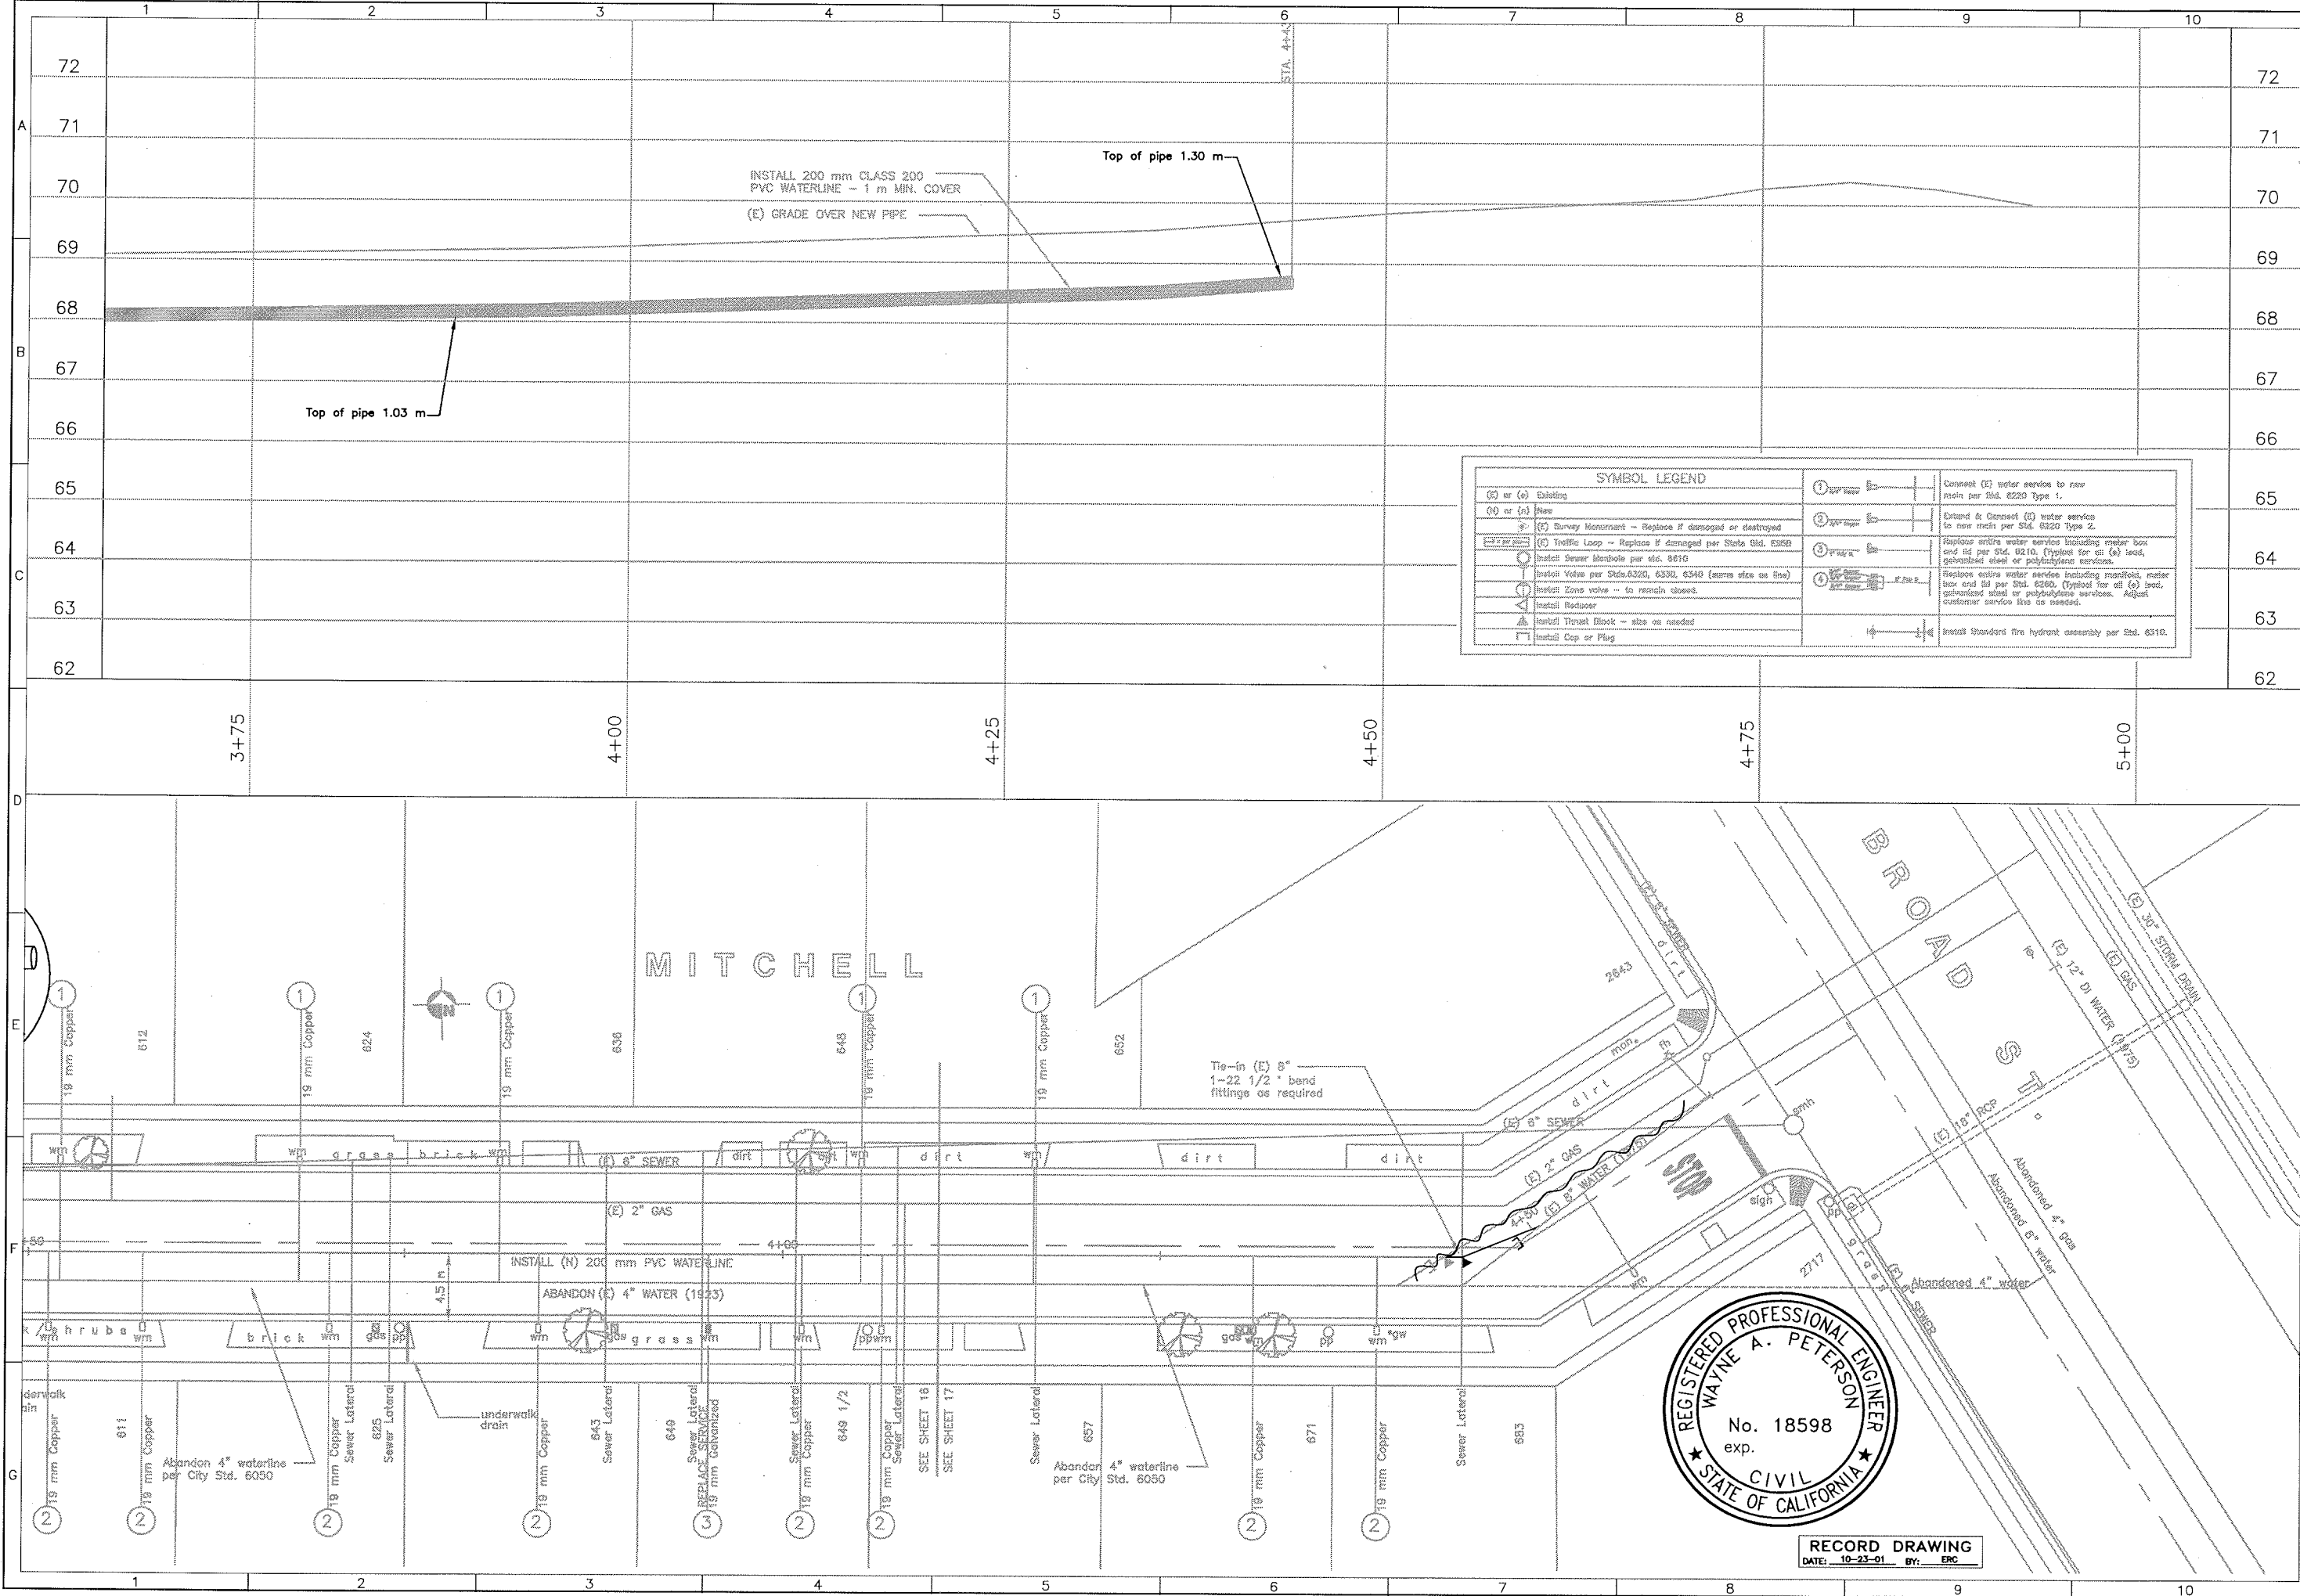

SYMBOL LEGEND	
(E) or (S) Existing	1. Sewer Manhole
(N) or (W) New	2. Water Manhole
(E) Survey Monument - Replace if damaged or destroyed	3. Sewer Valve
(W) Traffic Loop - Replace if damaged per State Std. 635B	4. Water Valve
Install Sewer Manhole per std. 6310	5. Sewer Cleanout
Install Valve per Std. 6320, 6330, 6340 (same size as line)	6. Water Cleanout
Install Zone Valve - to remain closed	7. Sewer Catch Basin
Install Reducer	8. Water Catch Basin
Install Throat Block - size as needed	9. Sewer Hydrant
Install Cap or Plug	10. Water Hydrant



RECORD DRAWING
DATE: 10-23-01 BY: EAC

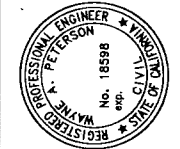


city of
san luis obispo


Drawn By & Date	Record Drawing	Drawn By & Date	Record Drawing
Scale: 1"=40'	Scale: 1"=40'	Scale: 1"=40'	Scale: 1"=40'

PROJECT TITLE
MITCHELL STREET
AT BROAD STREET

DESIGNED BY:	JV
DRAWN BY:	SR
CHECKED BY:	
APPROVED BY:	
DATE:	DEC 1999
CITY SPECIFICATION NO.	90033
SHEET NO.	17a of 25

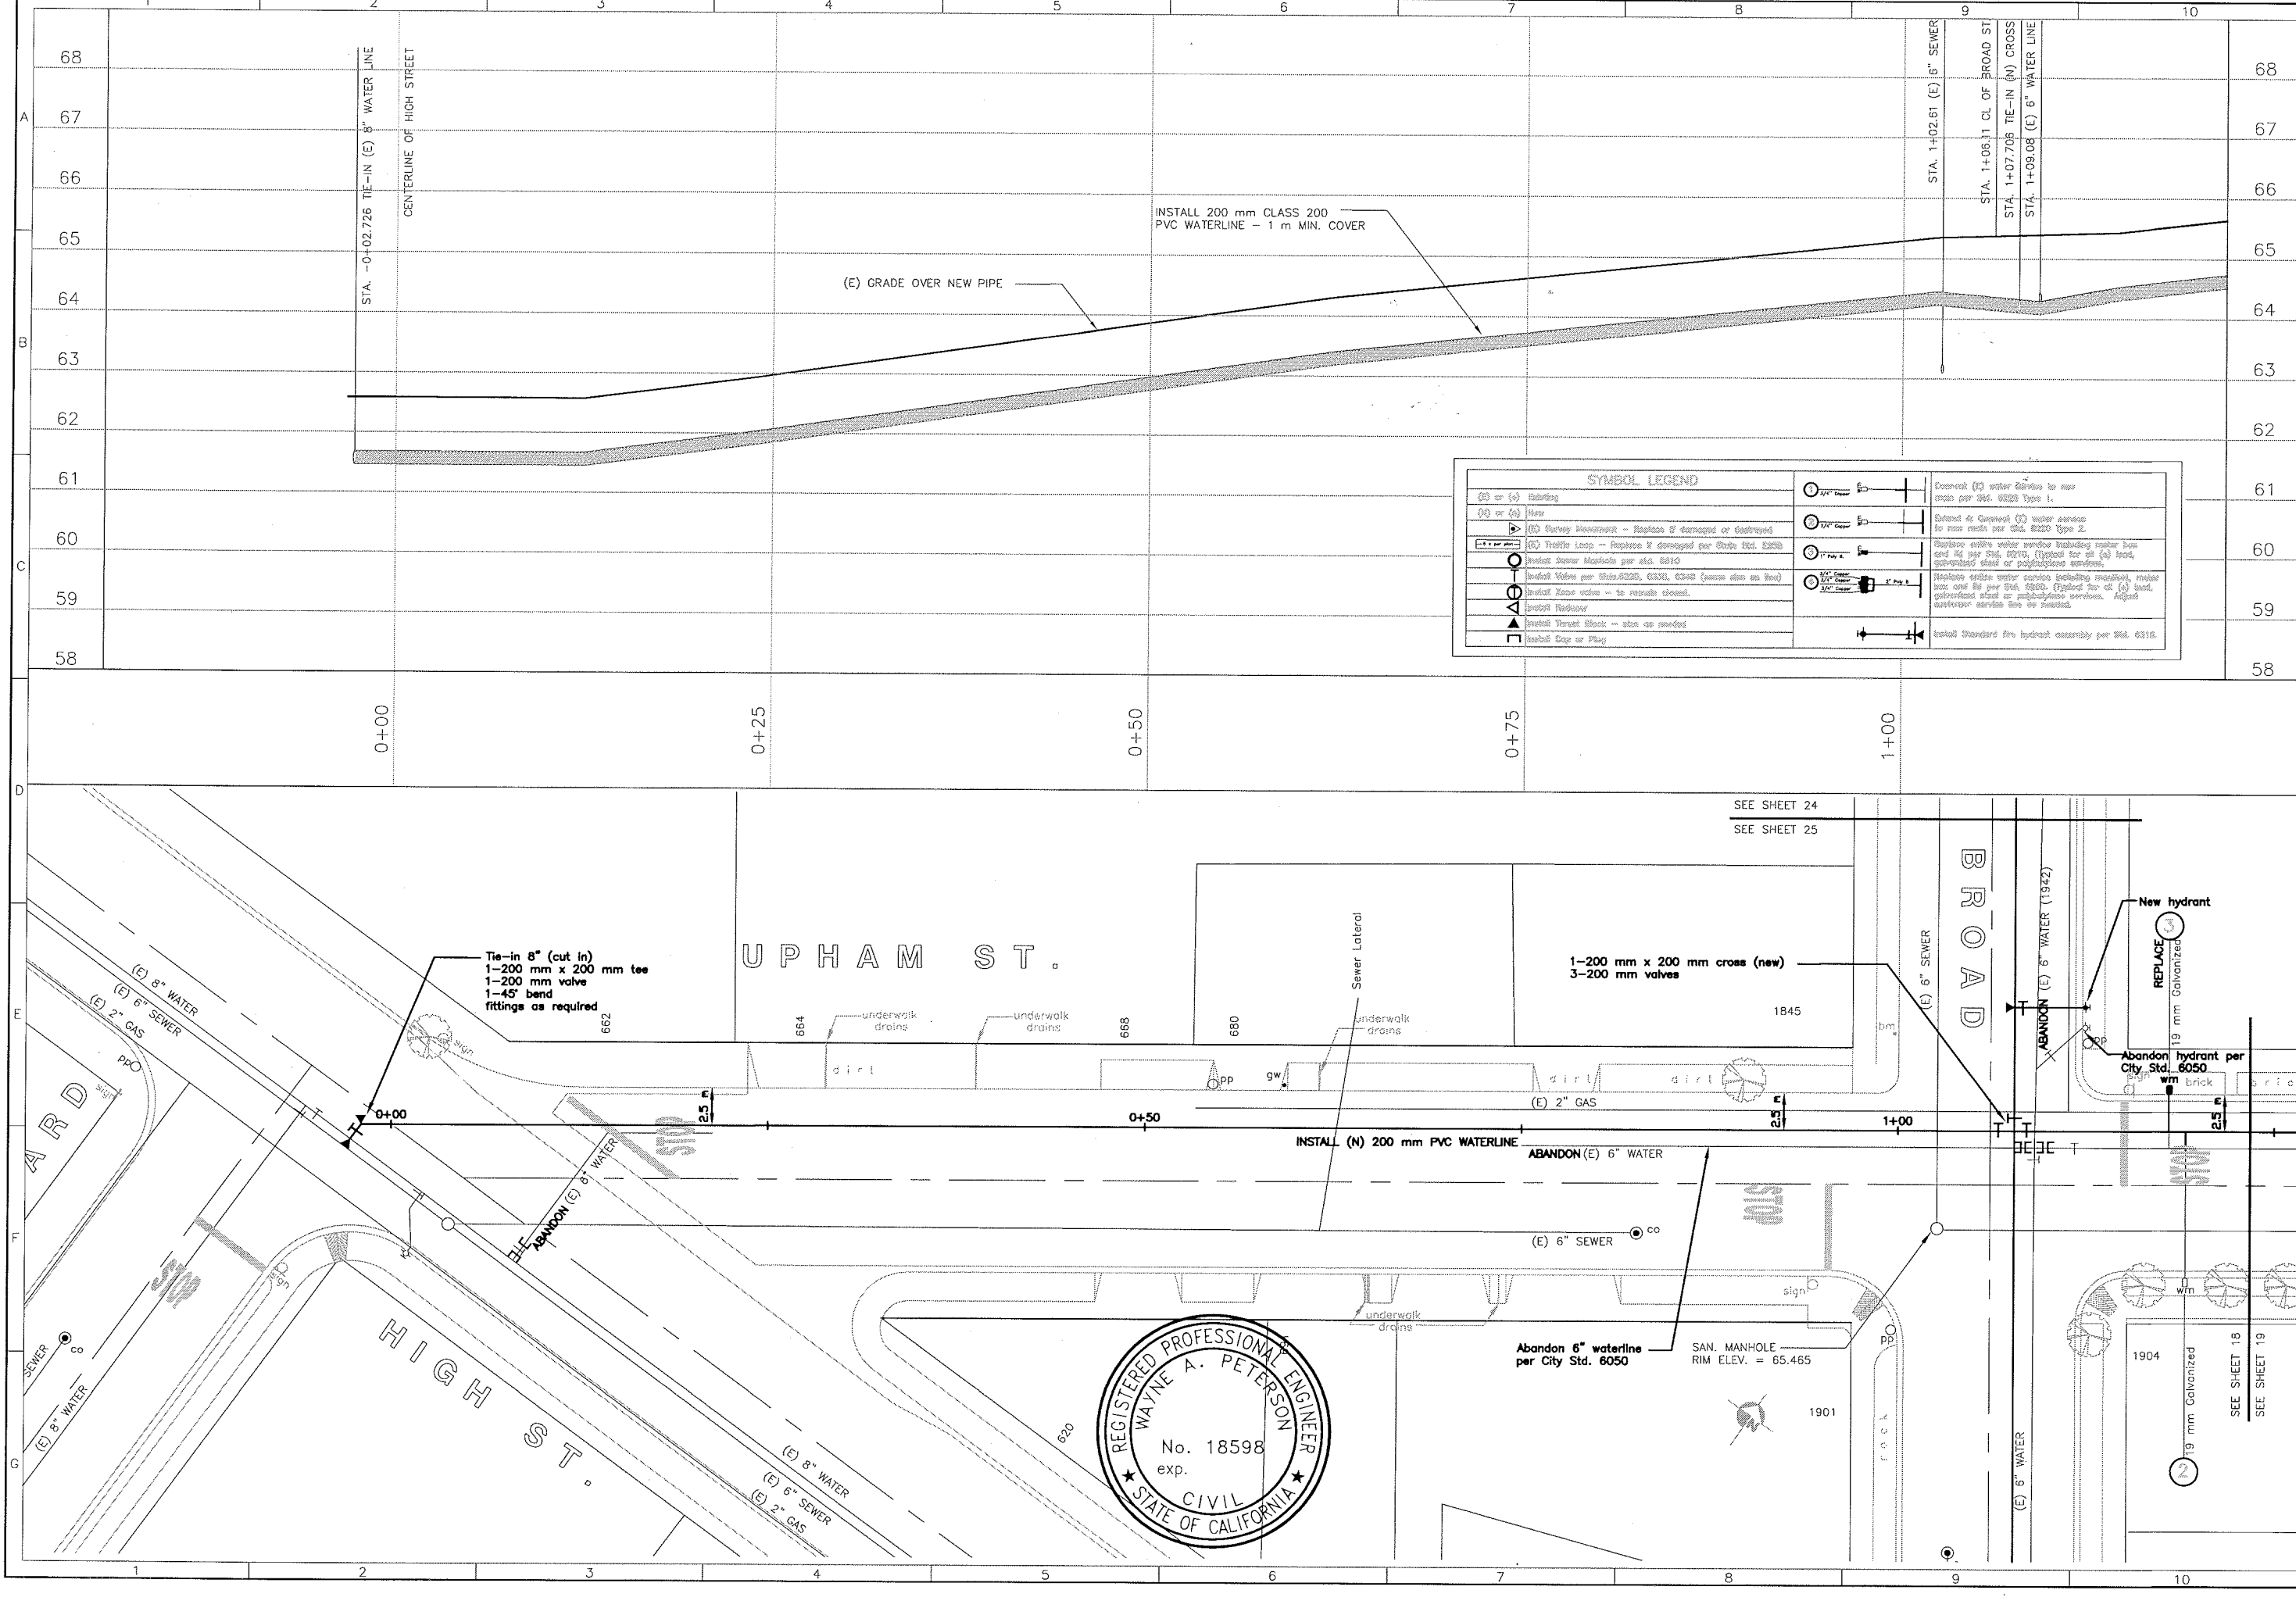


SYMBOL LEGEND	
(S) or (s) Existing	1/2" Cover
(N) or (n) New	1/2" Cover
(E) Survey Measurement - Replace if damaged or destroyed	1" Hydrant
(E) Traffic Loop - Replace if damaged per City Std. 6308	1/2" Cover
Install Valve per City Std. 6310, 6311, 6312 (shown also on sheet)	1/2" Cover
Install Gate valve - to remove them.	1/2" Cover
Install Hydrant	1/2" Cover
Install Street Block - stop as needed	1/2" Cover
Install Cap or Plug	1/2" Cover
Abandon (S) water service to new main per City Std. 6320 Type 1.	1/2" Cover
Abandon & Connect (S) water service to new main per City Std. 6320 Type 2.	1/2" Cover
Replace entire water service including meter box and 1/2" per City Std. 6310. (Applied for all (s) load, galvanized steel or polyethylene service.	1/2" Cover
Replace entire water service including meter box and 1/2" per City Std. 6310. (Applied for all (s) load, galvanized steel or polyethylene service. Adapt waterline service line as needed.	1/2" Cover
Install Standard Fire hydrant assembly per City Std. 6316.	1/2" Cover

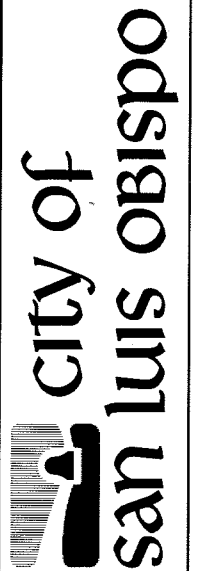


REVISIONS	Drawn By & Date	Record Drawing	Drawn By & Date

Graphic Scale: 1" = 40' V. SCALE


PROJECT TITLE	
UPHAM STREET HIGH ST. - BROAD ST.	
SHEET TITLE	
DESIGNED BY: JV	
DRAWN BY: SR	
CHECKED BY:	
APPROVED BY:	
DATE: DEC 1999	
CITY SPECIFICATION NO. 90033	
SHEET NO.	

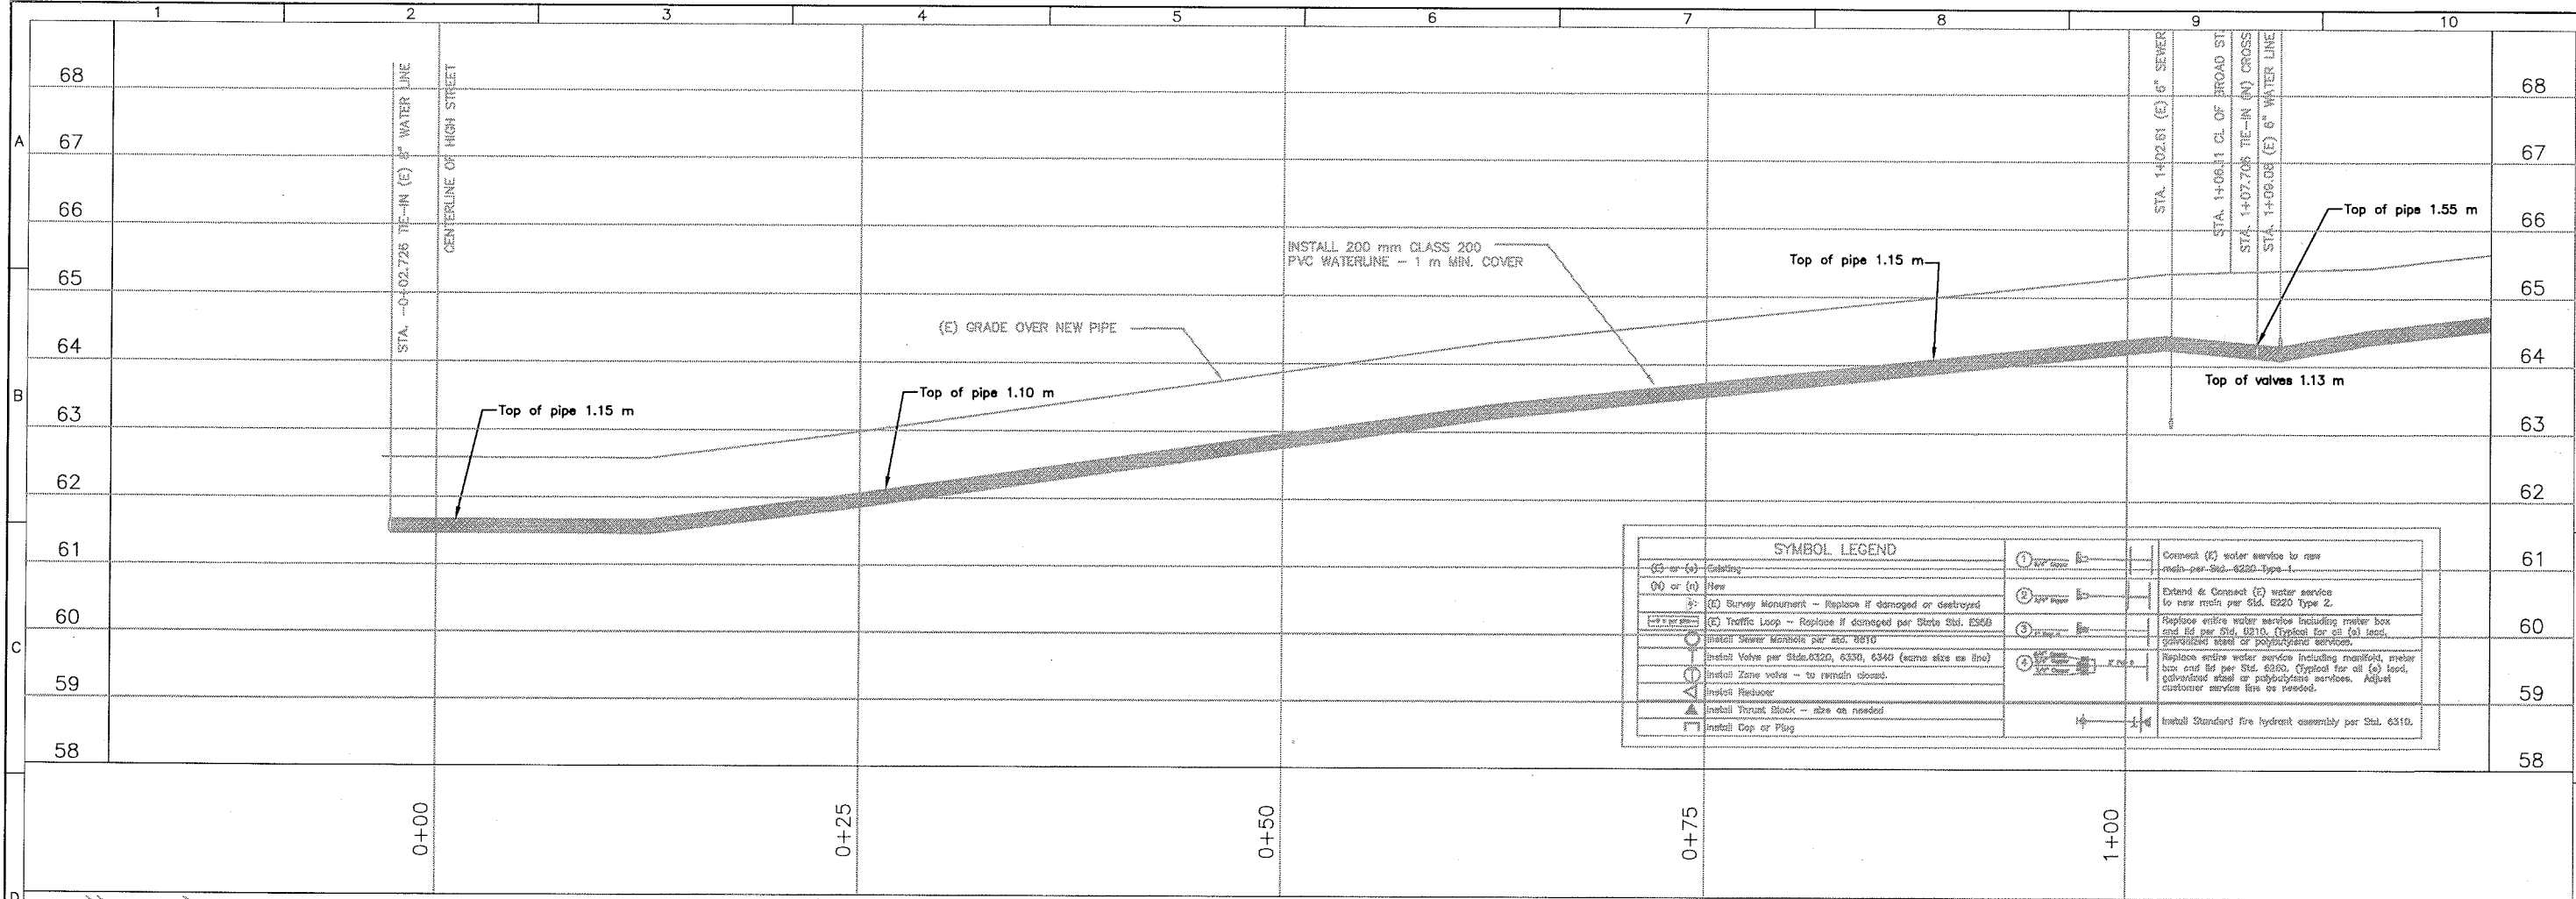

SYMBOL LEGEND	
(E) or (W)	Existing
(N) or (U)	New
(S)	(S) Survey Monument - Replace if damaged or destroyed
(T)	(T) Traffic Loop - Replace if damaged per State Std. 6350
(M)	Install Sewer Manhole per std. 6810
(V)	Install Valve per State Std. 6330, 6340 (name also see line)
(Z)	Install Zone valve - to remain closed
(R)	Install Reducer
(B)	Install Thrust Block - size as needed
(C)	Install Cap or Plug
(1)	Connect (E) water service to new main per Std. 6220 Type 1
(2)	Extend & Connect (E) water service to new main per Std. 6220 Type 2
(3)	Replace entire water service including meter box and lid per Std. 6210. (Typical for all (a) lead, galvanized steel or polybutylene services)
(4)	Replace entire water service including manifold, meter box and lid per Std. 6280. (Typical for all (a) lead, galvanized steel or polybutylene services. Adjust customer service line as needed)
(5)	Install Standard Fire hydrant assembly per Std. 6310.

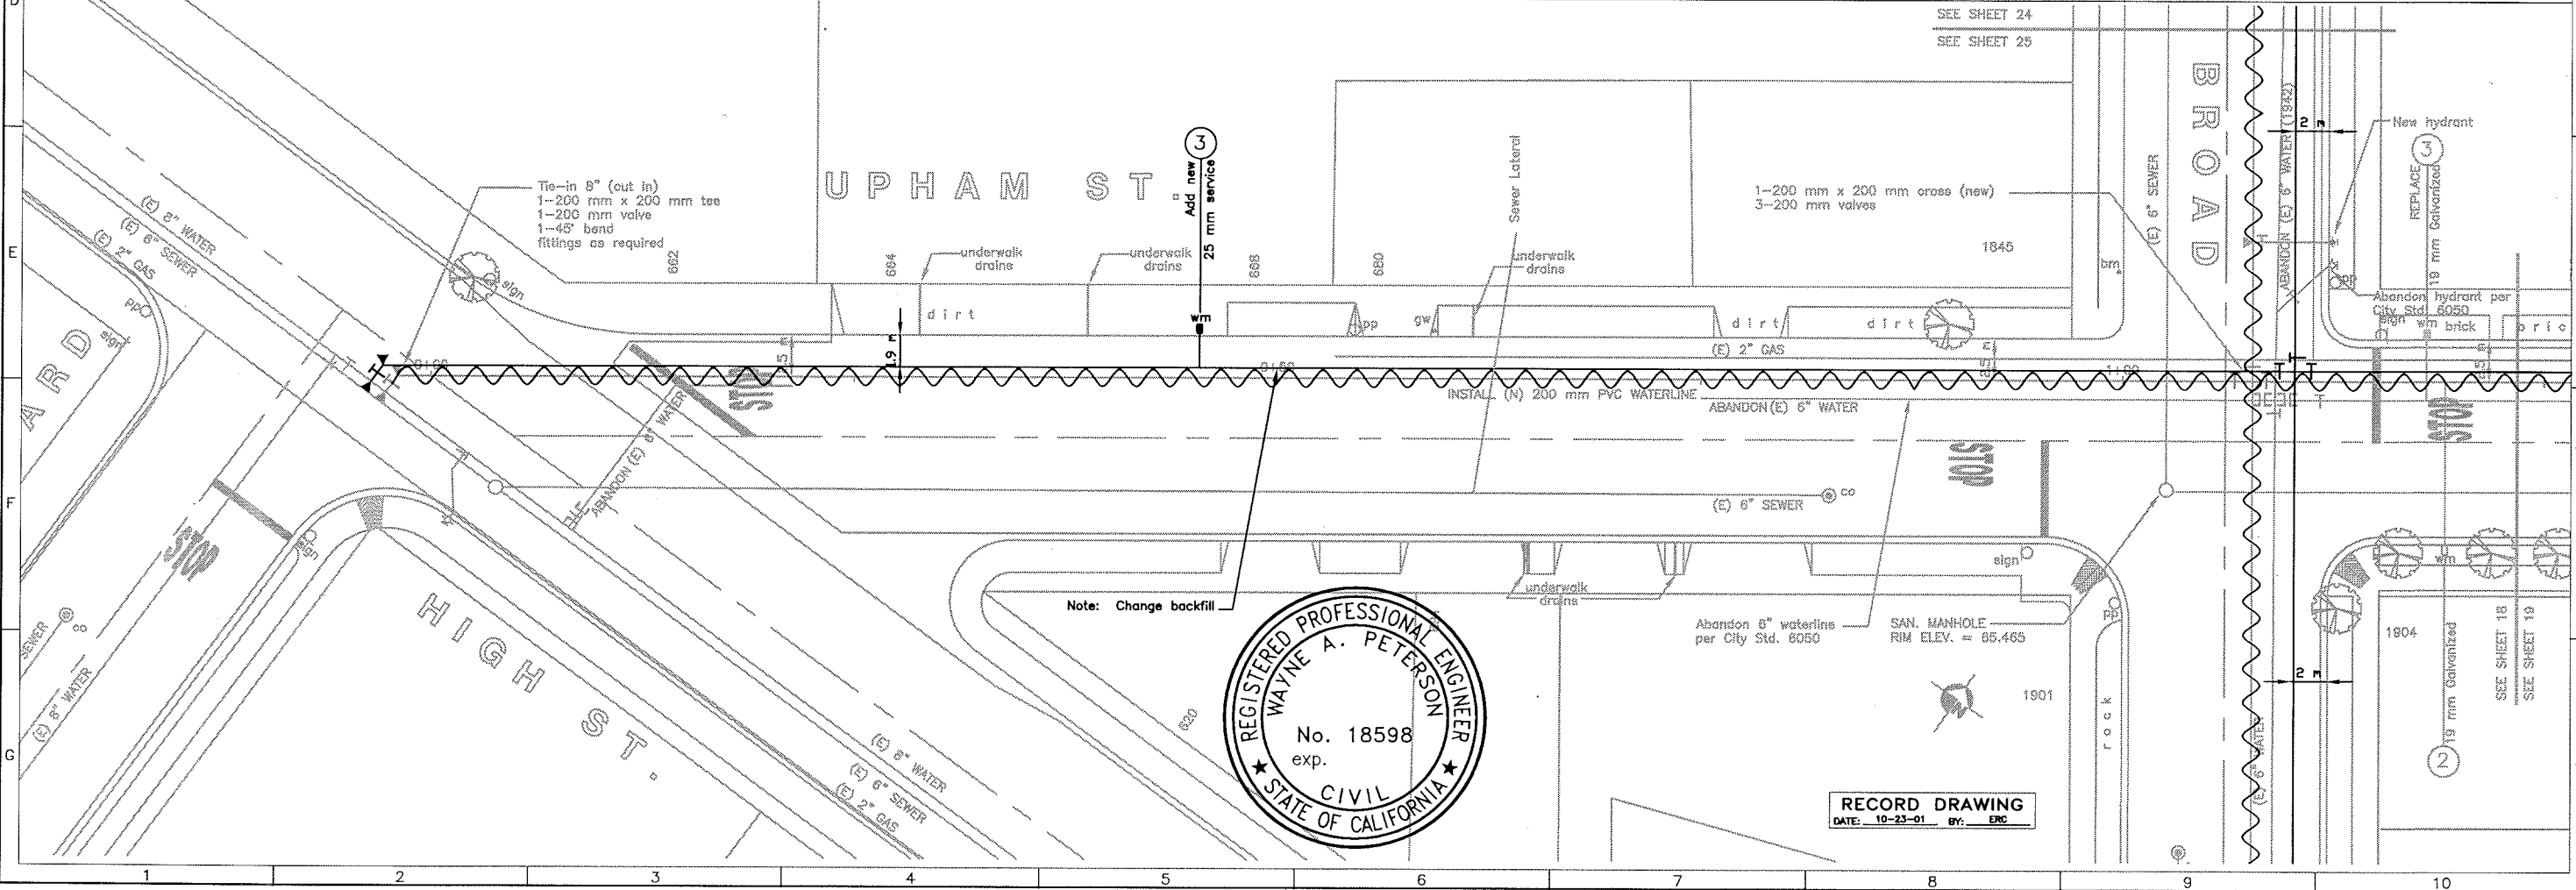


RECORD DRAWING
DATE: 10-23-01 BY: ENC

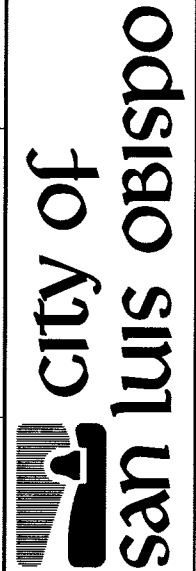


REVISIONS:	Drawn By & Date	Record Drawing	Drawn By & Date

PROJECT TITLE	UPHAM STREET HIGH ST. - BROAD ST.
DESIGNED BY:	JV
DRAWN BY:	SR
CHECKED BY:	CHECKED BY
APPROVED BY:	APPROVED BY
DATE:	DEC 1999
CITY SPECIFICATION NO.	90033
SHEET NO.	18a of 25

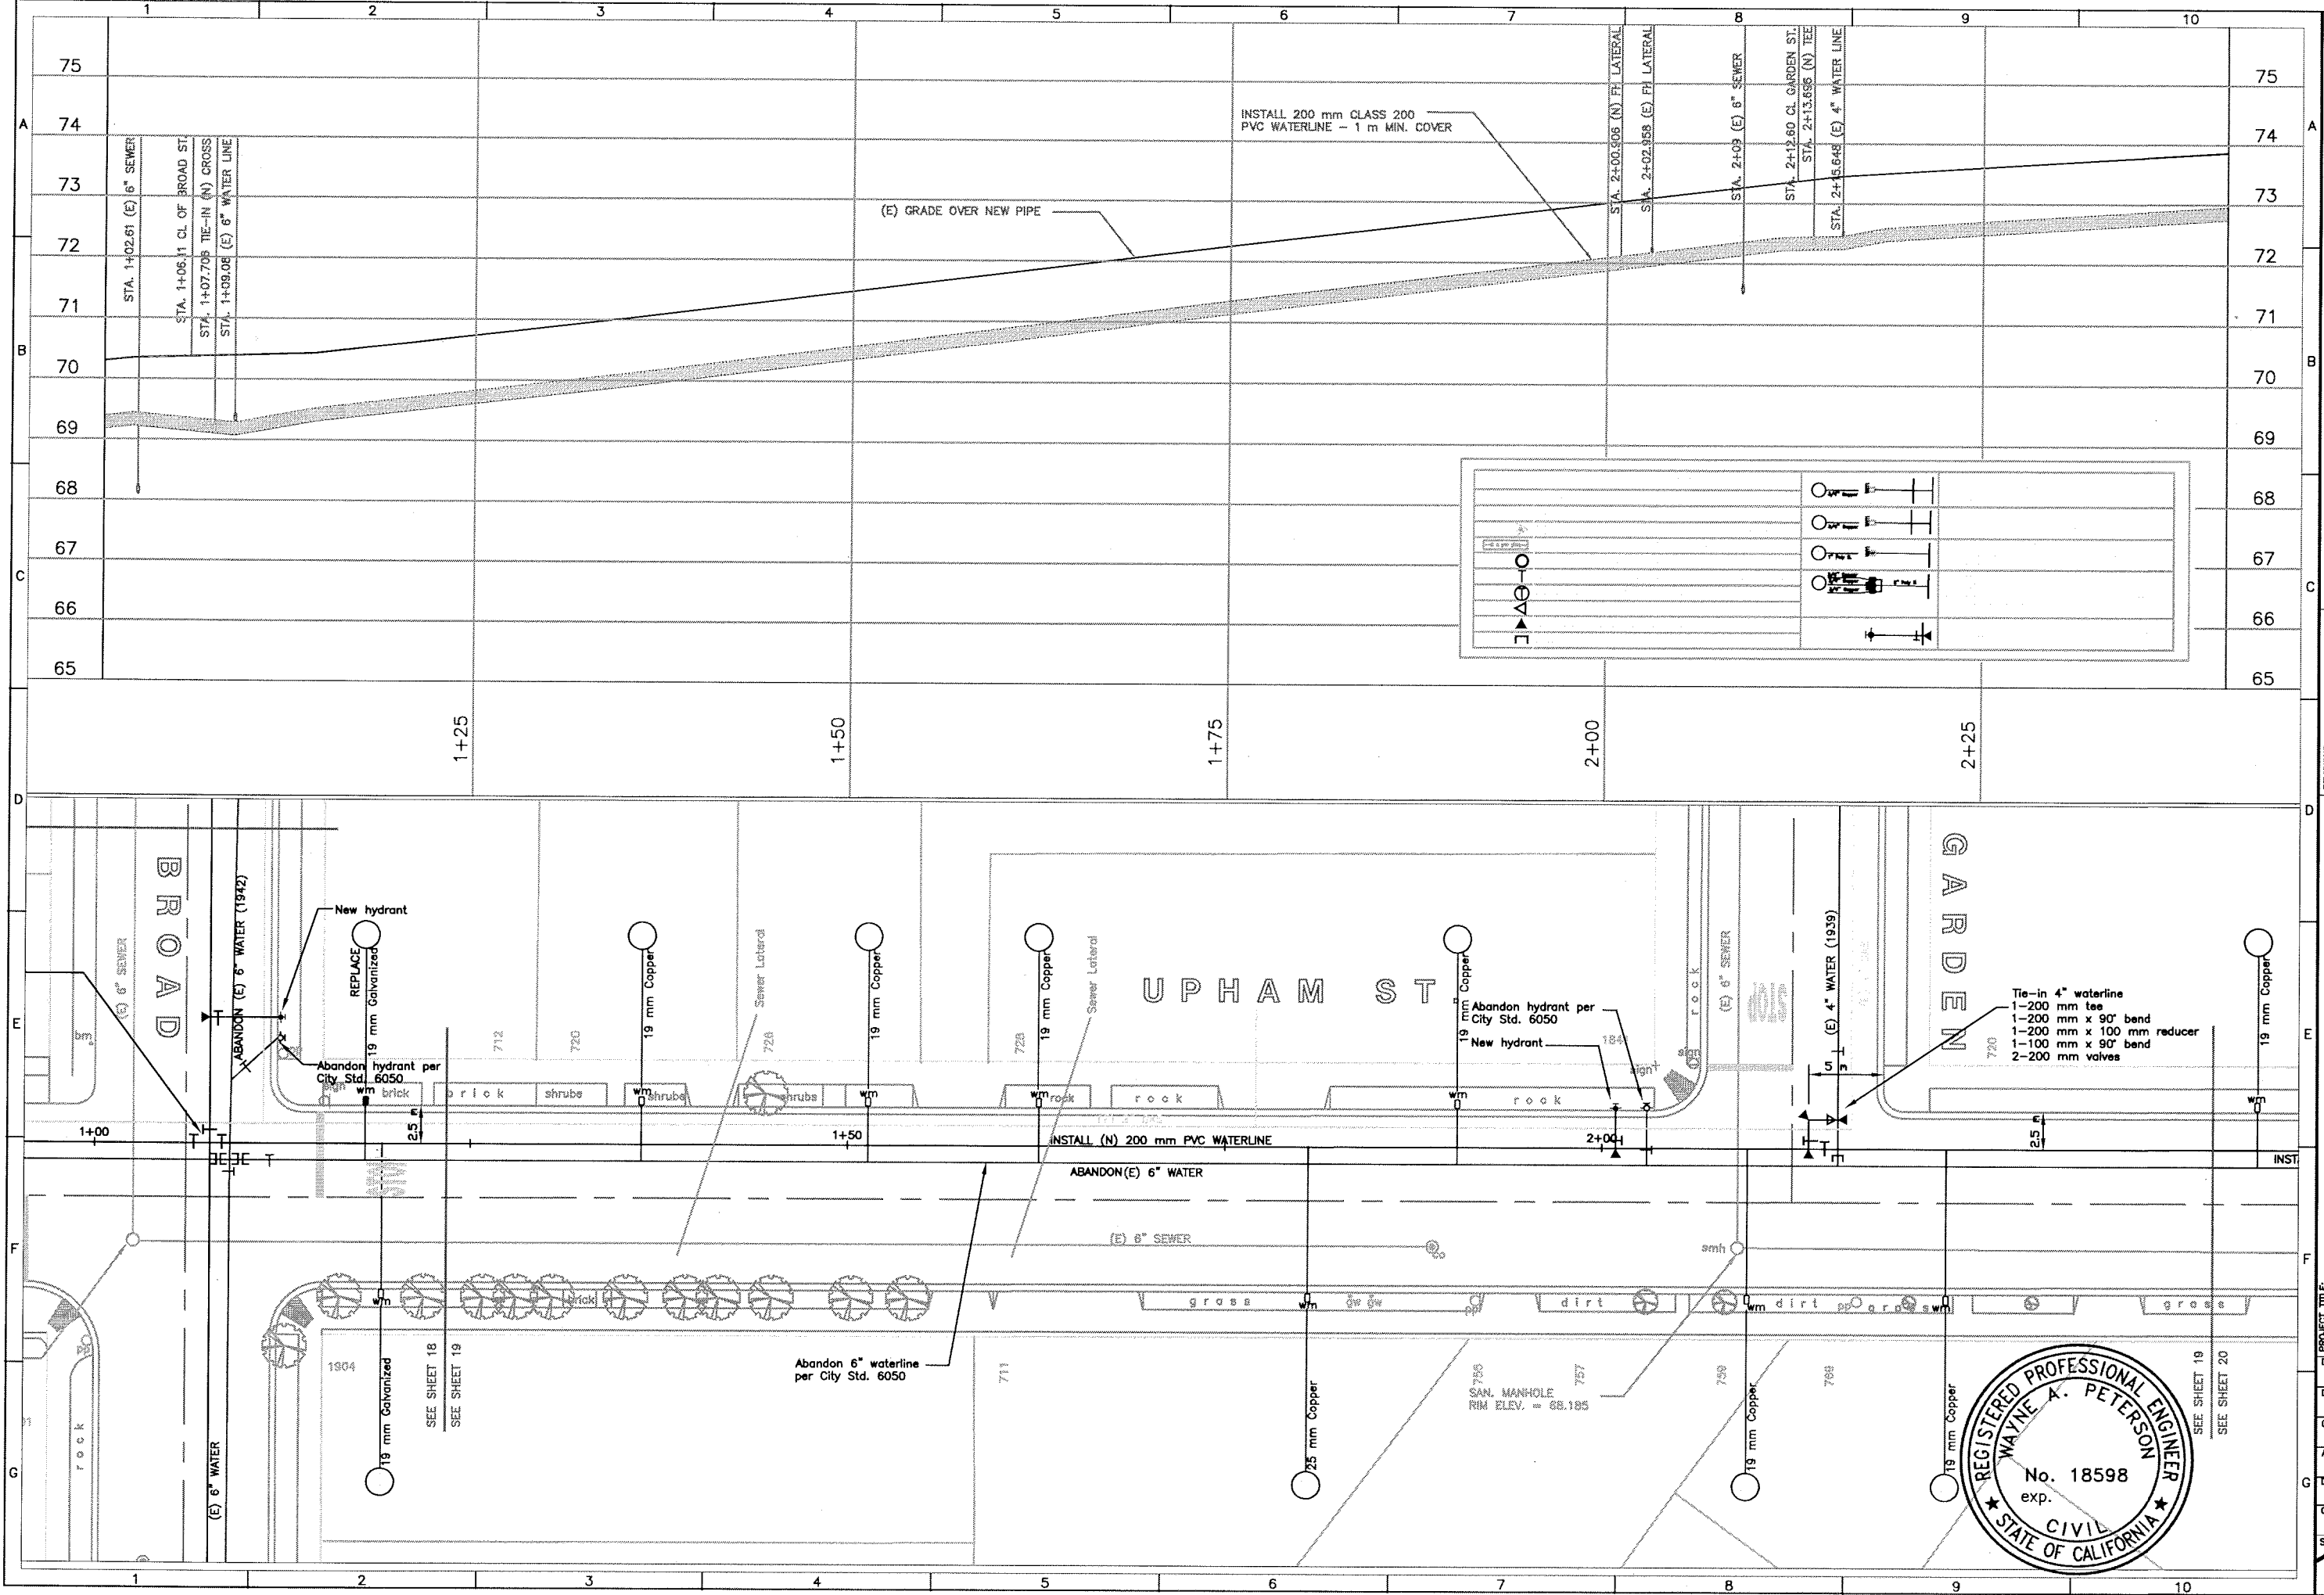

1	2	3	4	5	6	7	8	9	10
75	74	73	72	71	70	69	68	67	66
65	66	67	68	69	70	71	72	73	74
75	74	73	72	71	70	69	68	67	66
65	66	67	68	69	70	71	72	73	74

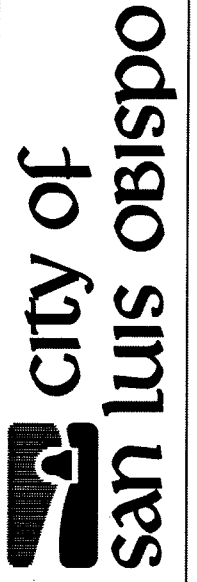

REVISIONS:	Drawn By & Date	Record Drawing	Drawn By & Date

Scale: 1" = 40' SCALE

PROJECT TITLE: UPHAM STREET BROAD ST. - GARDEN ST.

DESIGNED BY: JV

DRAWN BY: SR

CHECKED BY:


APPROVED BY:

DATE: DEC 1999

CITY SPECIFICATION NO. 90033

SHEET NO. 19 of 25



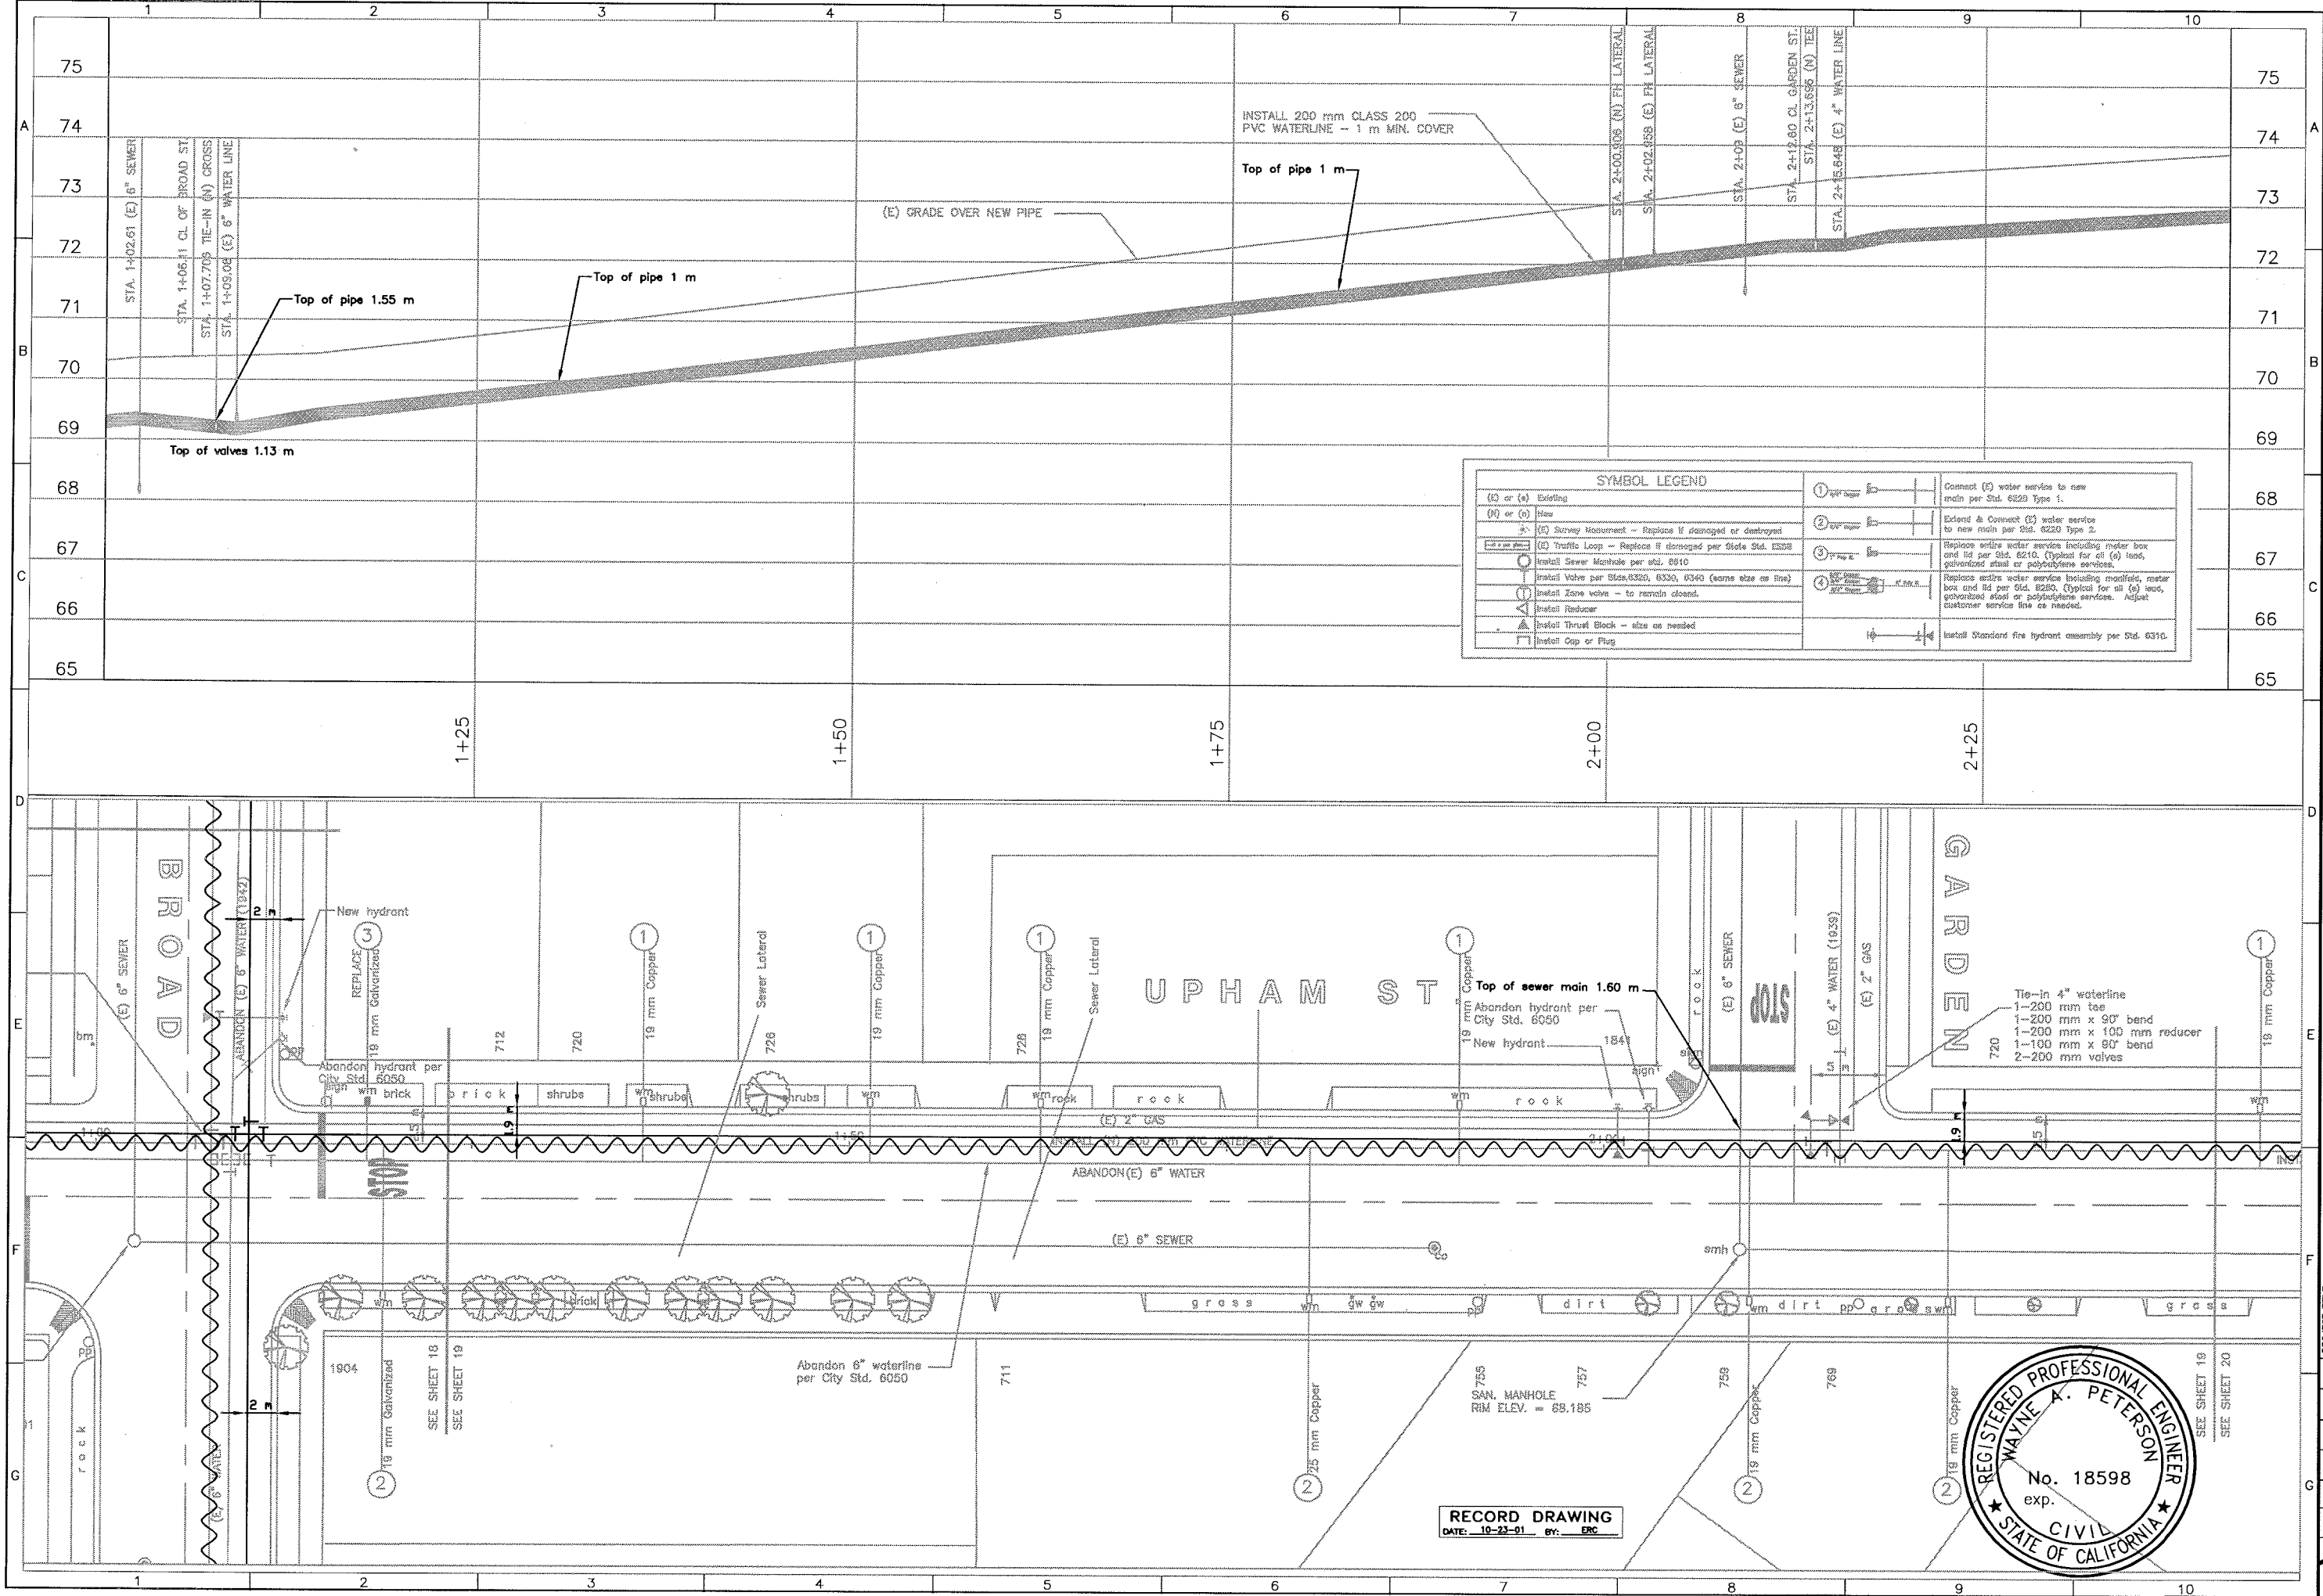

REVISIONS

Drawn By & Date

Record Drawing

Drawn By & Date

PROJECT TITLE

UPHAM STREET

BROAD ST. - GARDEN ST.

DESIGNED BY:

JV

DRAWN BY:

SR

CHECKED BY:

CHECKED BY

APPROVED BY:

DATE:

DEC 1999

CITY SPECIFICATION NO.

90033

SHEET NO.

19a of 25

city of

san luis obispo

PROJECT TITLE

UPHAM STREET

BROAD ST. - GARDEN ST.

REGISTERED PROFESSIONAL ENGINEER

WAYNE A. PETERSON

No. 18598

exp.


CIVIL

STATE OF CALIFORNIA

Scale:

1:400

SCALE

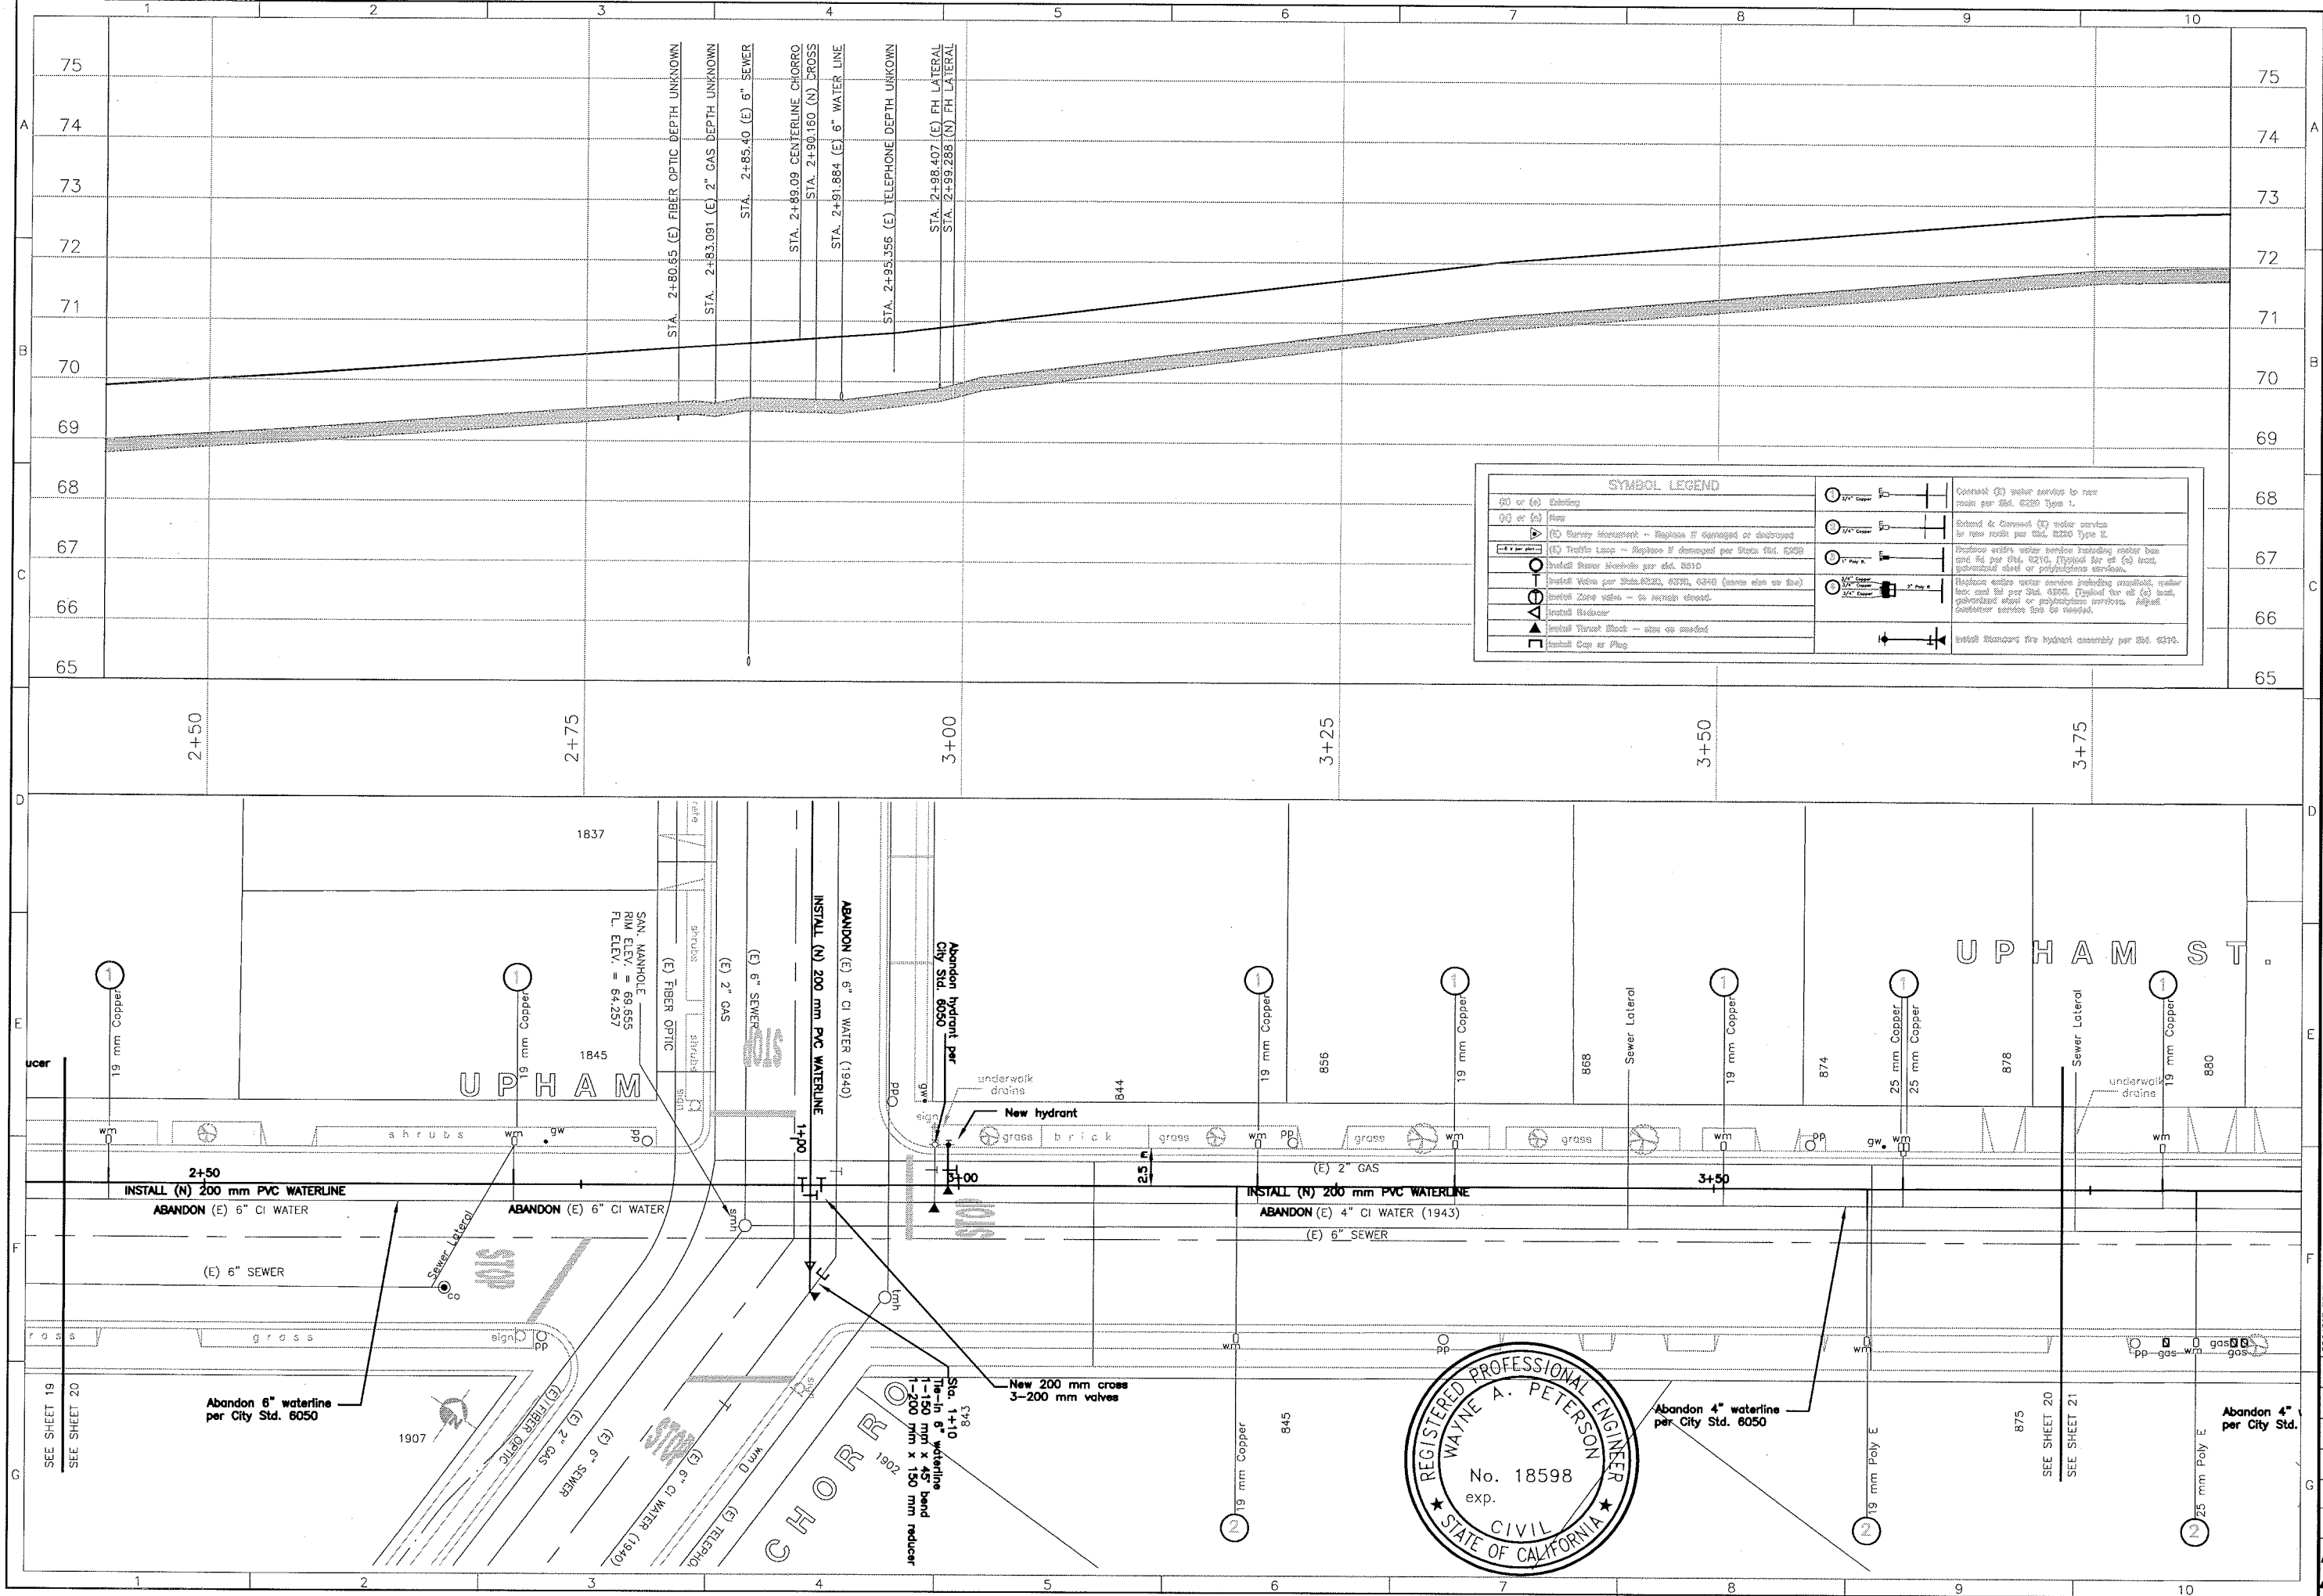

SYMBOL LEGEND	
60 or (e) Existing	1/4" Copper
90 or (e) New	1/4" Copper
(S) Survey Monument - Replace if damaged or destroyed	1/4" Copper
(Q) Traffic Lamp - Replace if damaged per State Std. 6050	1" Poly E
Installed Water Meters per Std. 6050	1/4" Copper
Installed Valves per Std. 6050, 6070, 6240 (note also see Std.)	1/4" Copper
Installed Zoning Valve - to match closed.	1/4" Copper
Installed Hydrant	1" Poly E
Installed Street Light - note on standard	1" Poly E
Installed Cap or Plug	1" Poly E
Connect (S) water service to new main per Std. 6220 Type 1.	
Reconnect & Connect (S) water service to new main per Std. 6220 Type 2.	
Replace water service including meter box and 1/2" per Std. 6070, (typical for all (e) lines, government street or private street).	
Replace water service including meter box and 1/2" per Std. 6070, (typical for all (e) lines, government street or private street). Adjust customer service line to match.	
Install Standard fire hydrant assembly per Std. 6070.	

city of
san luis obispo


REVISIONS:	Drawn By & Date	Record Drawing	Drawn By & Date

PROJECT TITLE

UPHAM STREET
CHORRO ST. - SANTA BARBARA ST.

SHEET TITLE


DESIGNED BY:	JV
DRAWN BY:	SR
CHECKED BY:	
APPROVED BY:	
DATE:	DEC 1999
CITY SPECIFICATION NO.	90033
SHEET NO.	20 of 25

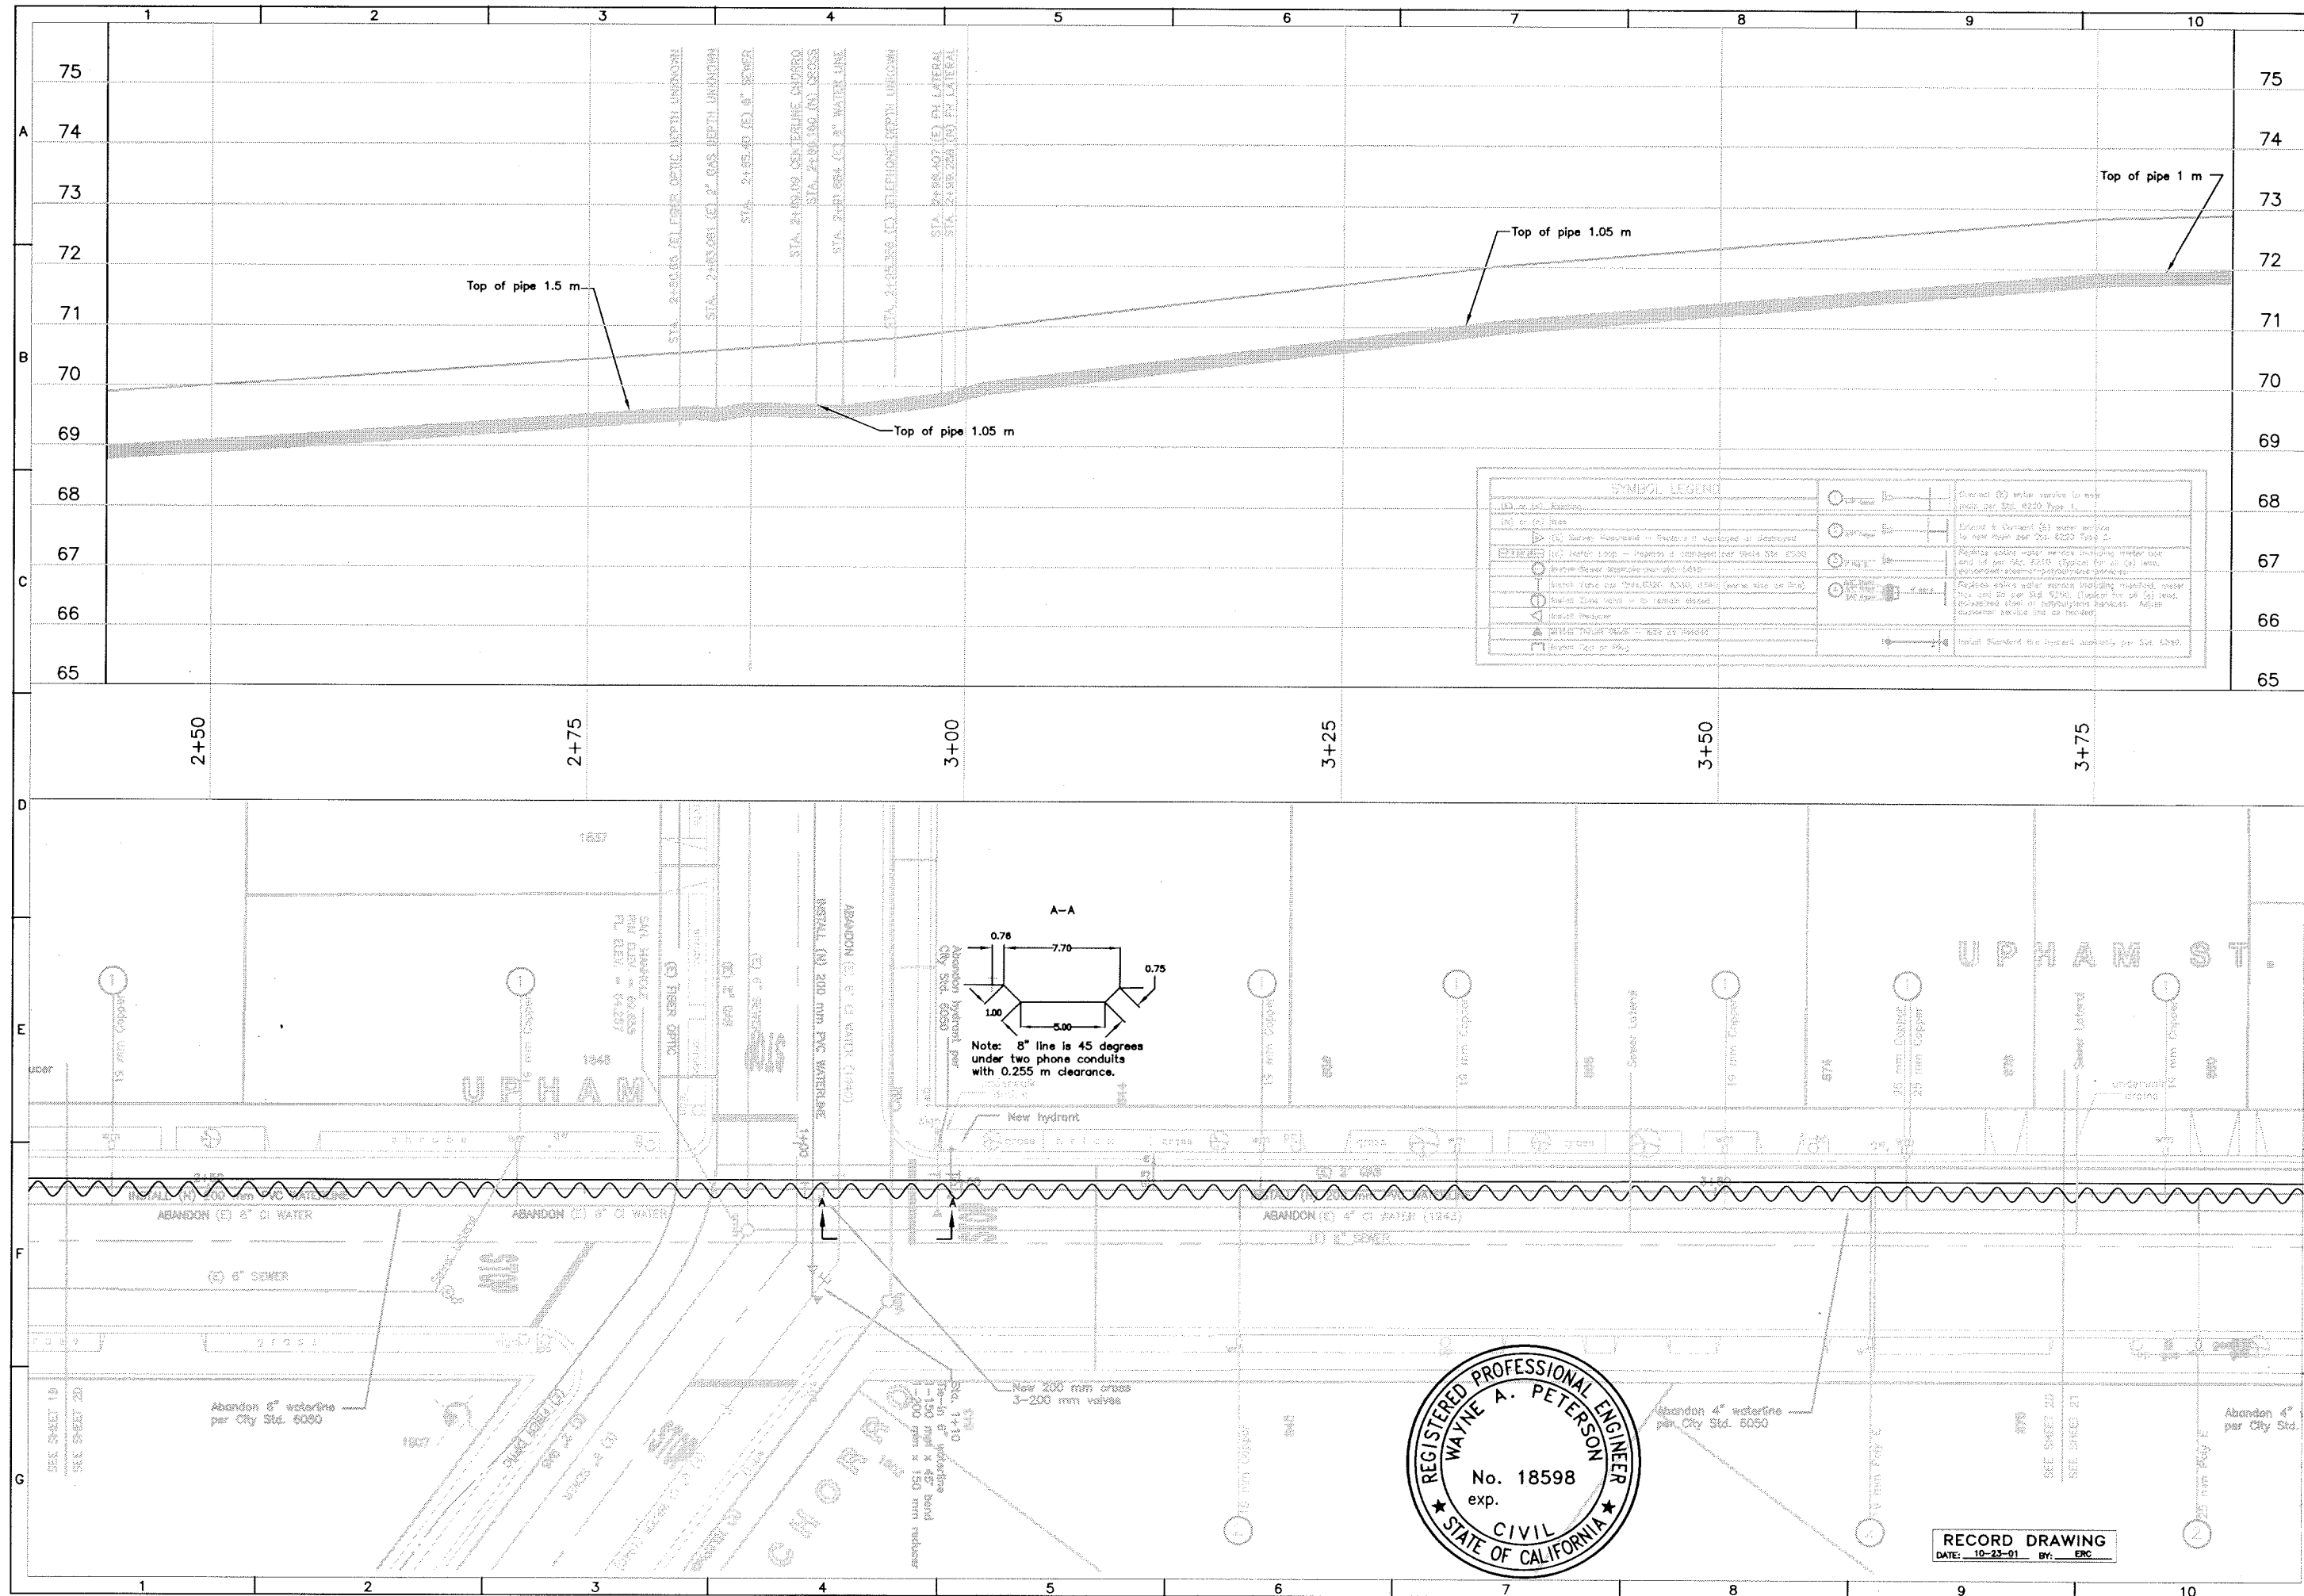

city of
san luis obispo

REVISIONS:
Drawn By & Date
Record Drawing
Drawn By & Date
Scale: 1:400
H: 1:400
V: SCALE

PROJECT TITLE
UPHAM STREET
CHORRO ST. - SANTA BARBARA ST.
DESIGNED BY: JV
DRAWN BY: SR
CHECKED BY:
APPROVED BY:
DATE: DEC 1999
CITY SPECIFICATION NO. 90033
SHEET NO. 20a of 25

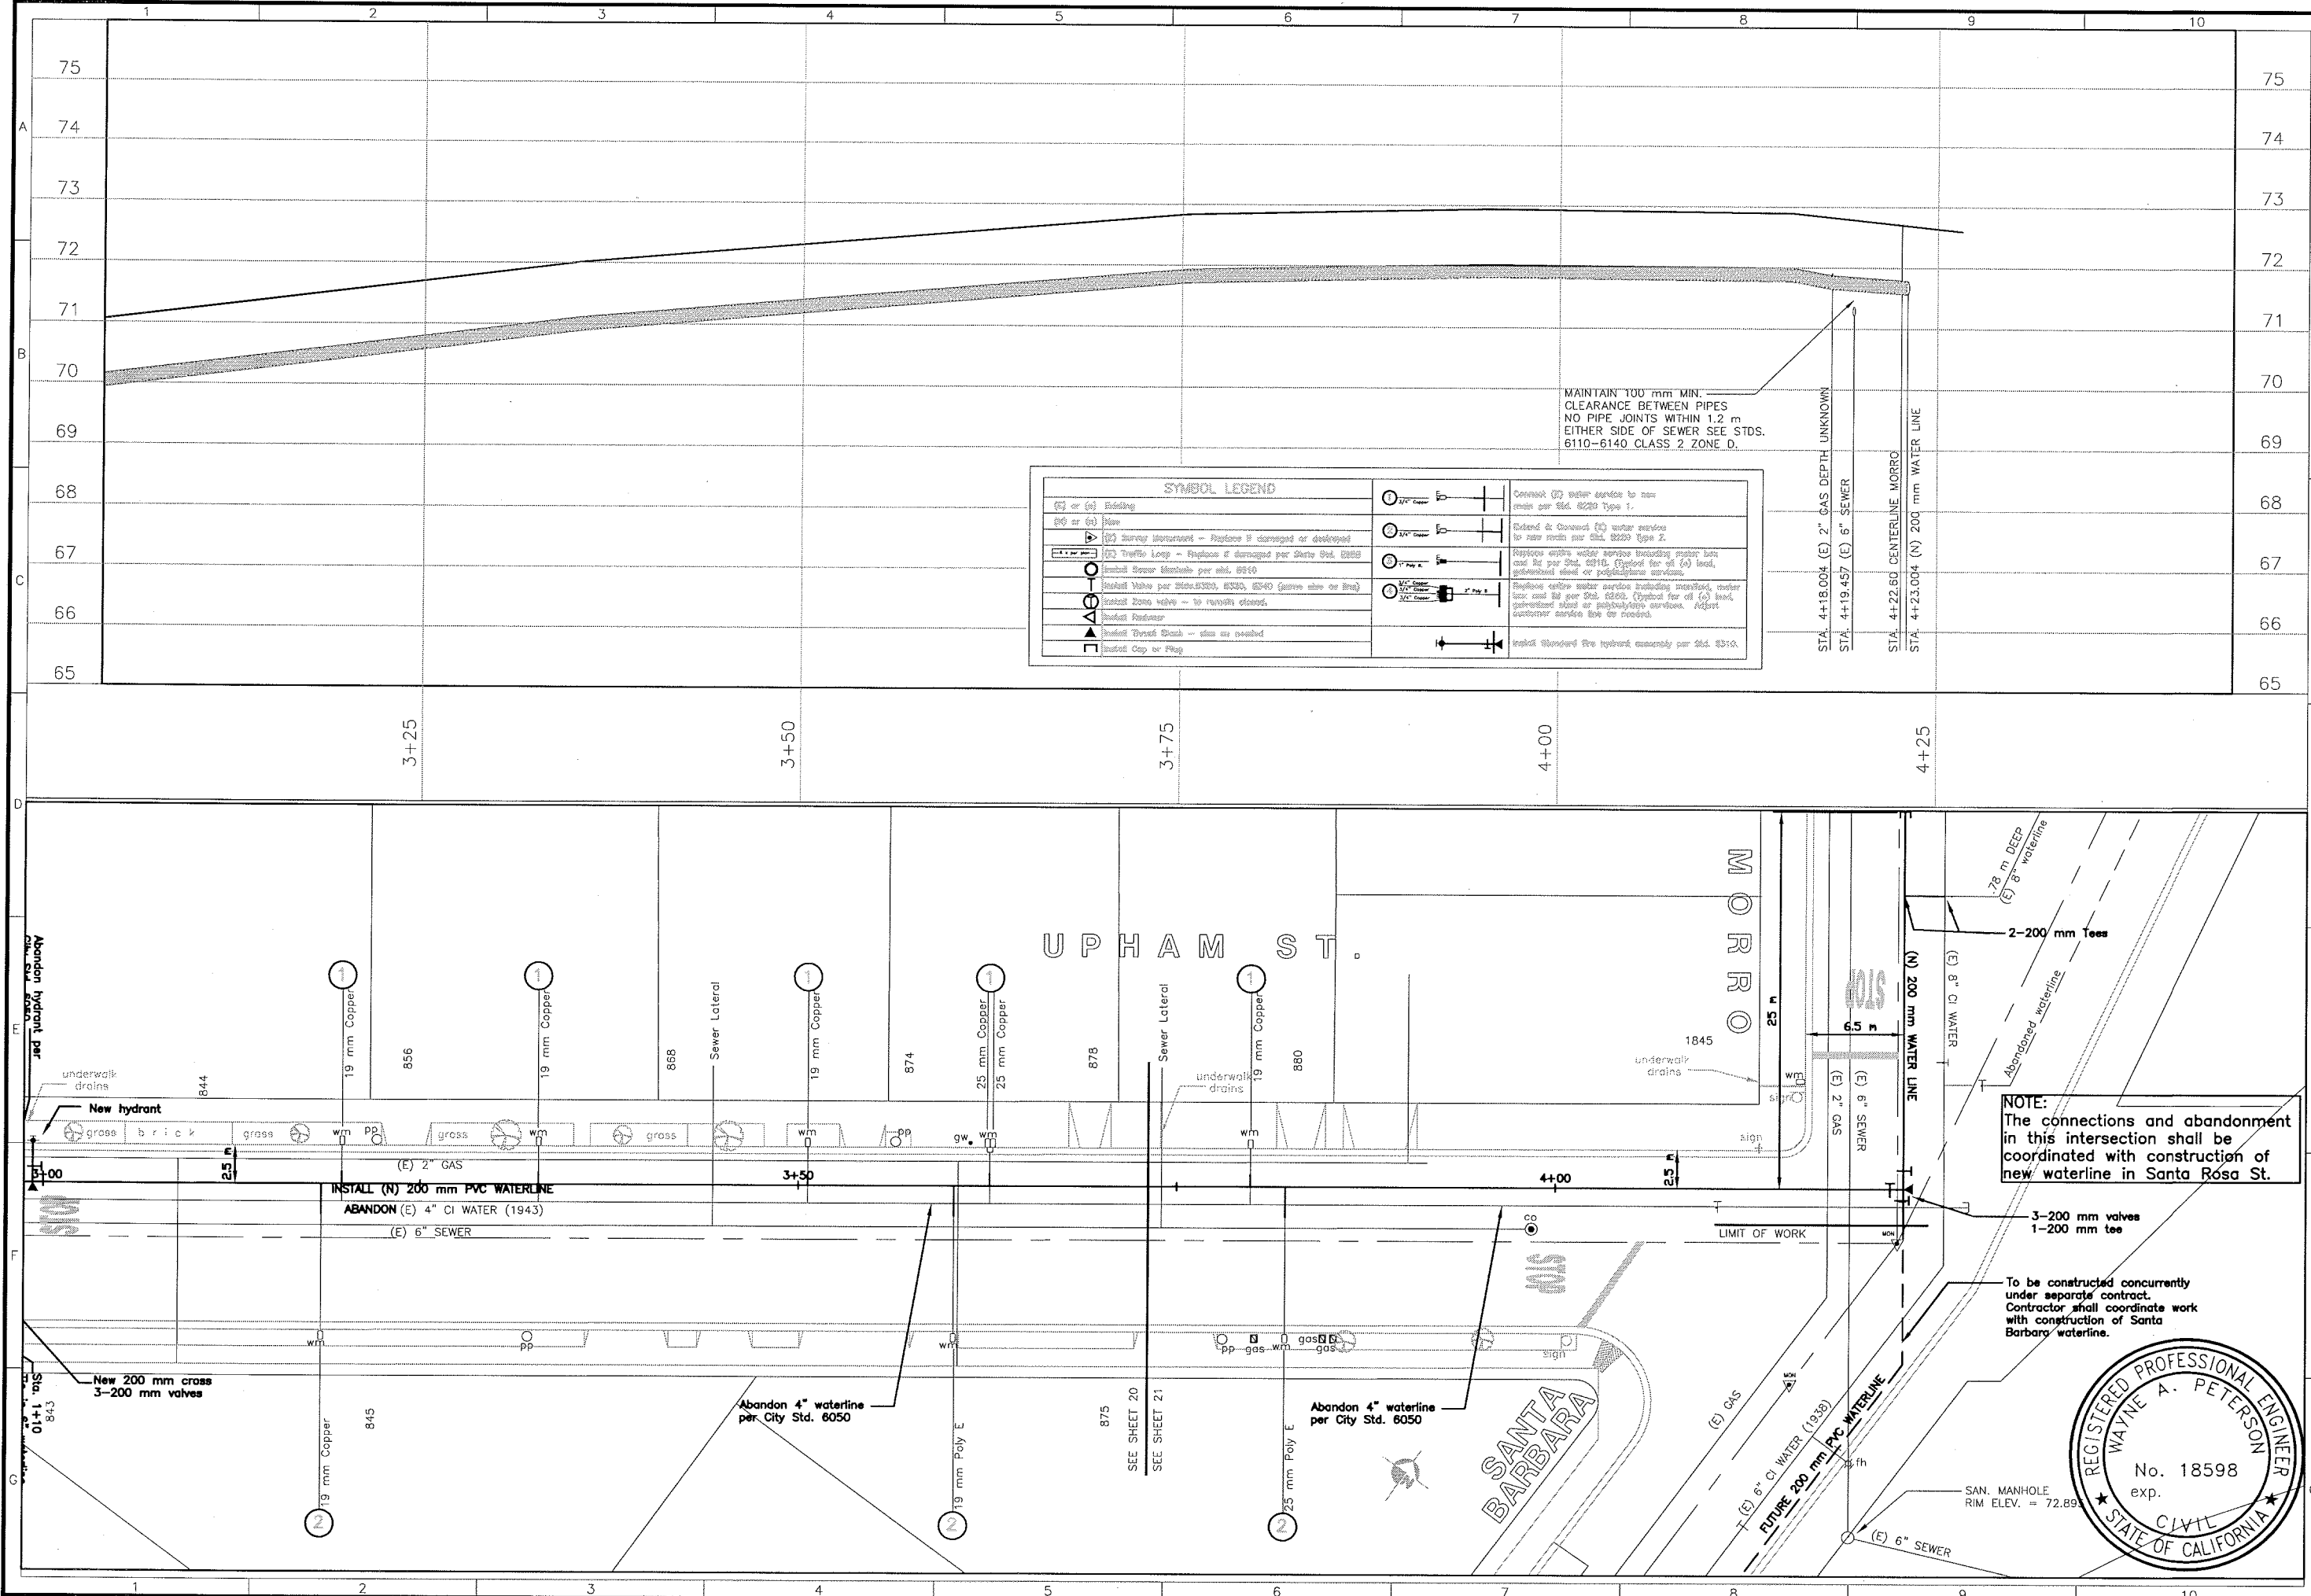

SYMBOL LEGEND	
(E) or (S) Existing	3/4" Copper
(E) or (S) New	1/4" Copper
(E) Survey Monument - Replace if damaged or destroyed	1" Poly E
(E) Traffic Loop - Replace if damaged per State Std. 6050	2" Poly E
Install Sewer Manhole per std. 6050	3/4" Copper
Install Valve per State Std. 6050, 6055, 6060 (same size as line)	3/4" Copper
Install Zone valve - to remain closed	3/4" Copper
Install Hydrant	3/4" Copper
Install Street Curb - same as needed	3/4" Copper
Install Cap or Plug	3/4" Copper
Connect (E) water service to new main per Std. 6050 Type 1.	3/4" Copper
Extend & Connect (E) water service to new main per Std. 6050 Type 2.	3/4" Copper
Replace entire water service including water line and fit per Std. 6050. (Typical for all (S) line, galvanized steel or polyethylene services)	3/4" Copper
Replace entire water service including manifold, water line and fit per Std. 6050. (Typical for all (S) line, galvanized steel or polyethylene services. Report customer service line as needed)	3/4" Copper
Install Standard fire hydrant assembly per Std. 6050	3/4" Copper

City of
san luis obispo

REVISIONS:	Drawn By & Date	Record Drawing	Drawn By & Date

PROJECT TITLE

UPHAM STREET

CHORRO ST. - SANTA BARBARA ST.

DESIGNED BY: JV

DRAWN BY: SR

CHECKED BY: SR

APPROVED BY:

DATE: DEC 1999

CITY SPECIFICATION NO. 90033

SHEET NO. 21 of 25

REGISTERED PROFESSIONAL ENGINEER


WAYNE A. PETERSON

No. 18598


exp.

CIVIL


STATE OF CALIFORNIA

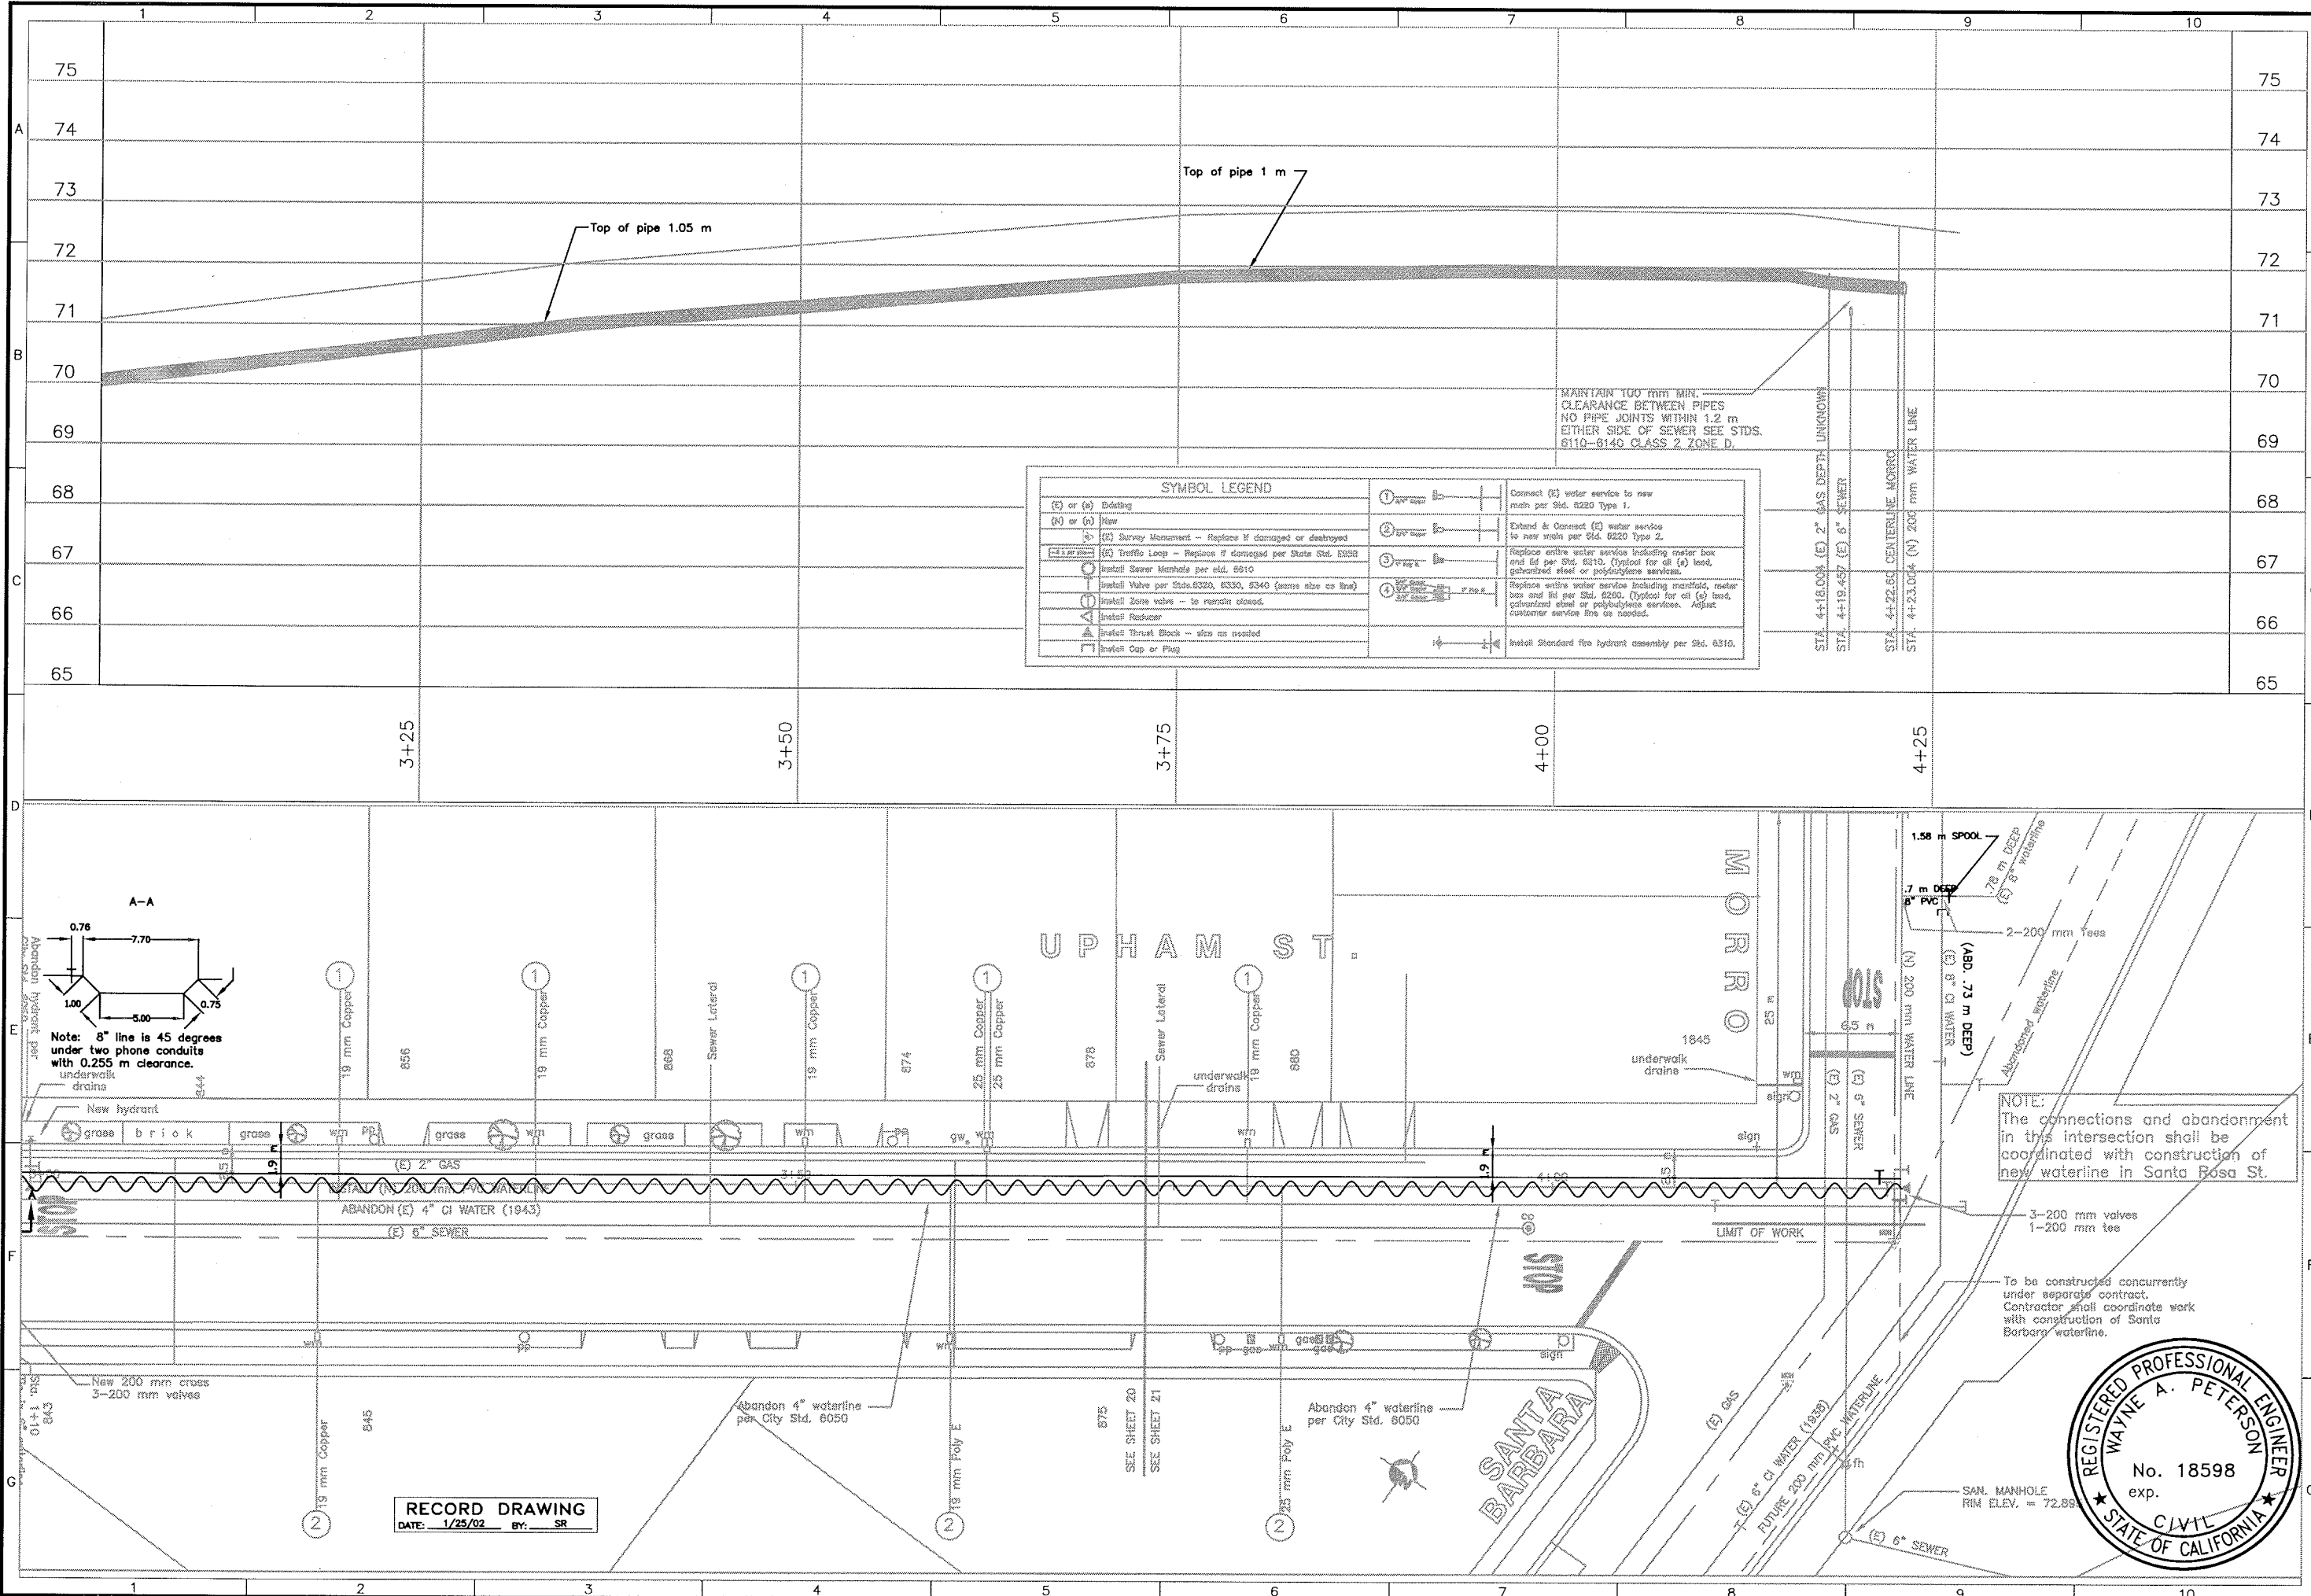

SYMBOL LEGEND	
(E) or (N) Existing	1. 4" gas
(N) or (E) New	2. 6" gas
(E) Survey Monument - Replace if damaged or destroyed	3. 8" gas
(E) Traffic Loop - Replace if damaged per State Std. 6050	4. 10" gas
Install Sewer Manhole per std. 6010	5. 12" gas
Install Valve per Std. 6030, 6030, 6040 (same size as line)	6. 14" gas
Install Zone valve - to remain closed	7. 16" gas
Install Reducer	8. 18" gas
Install Thrust Block - also as needed	9. 20" gas
Install Cap or Plug	10. 22" gas
	11. 24" gas
	12. 26" gas
	13. 28" gas
	529. 1060" gas
	530. 1062"

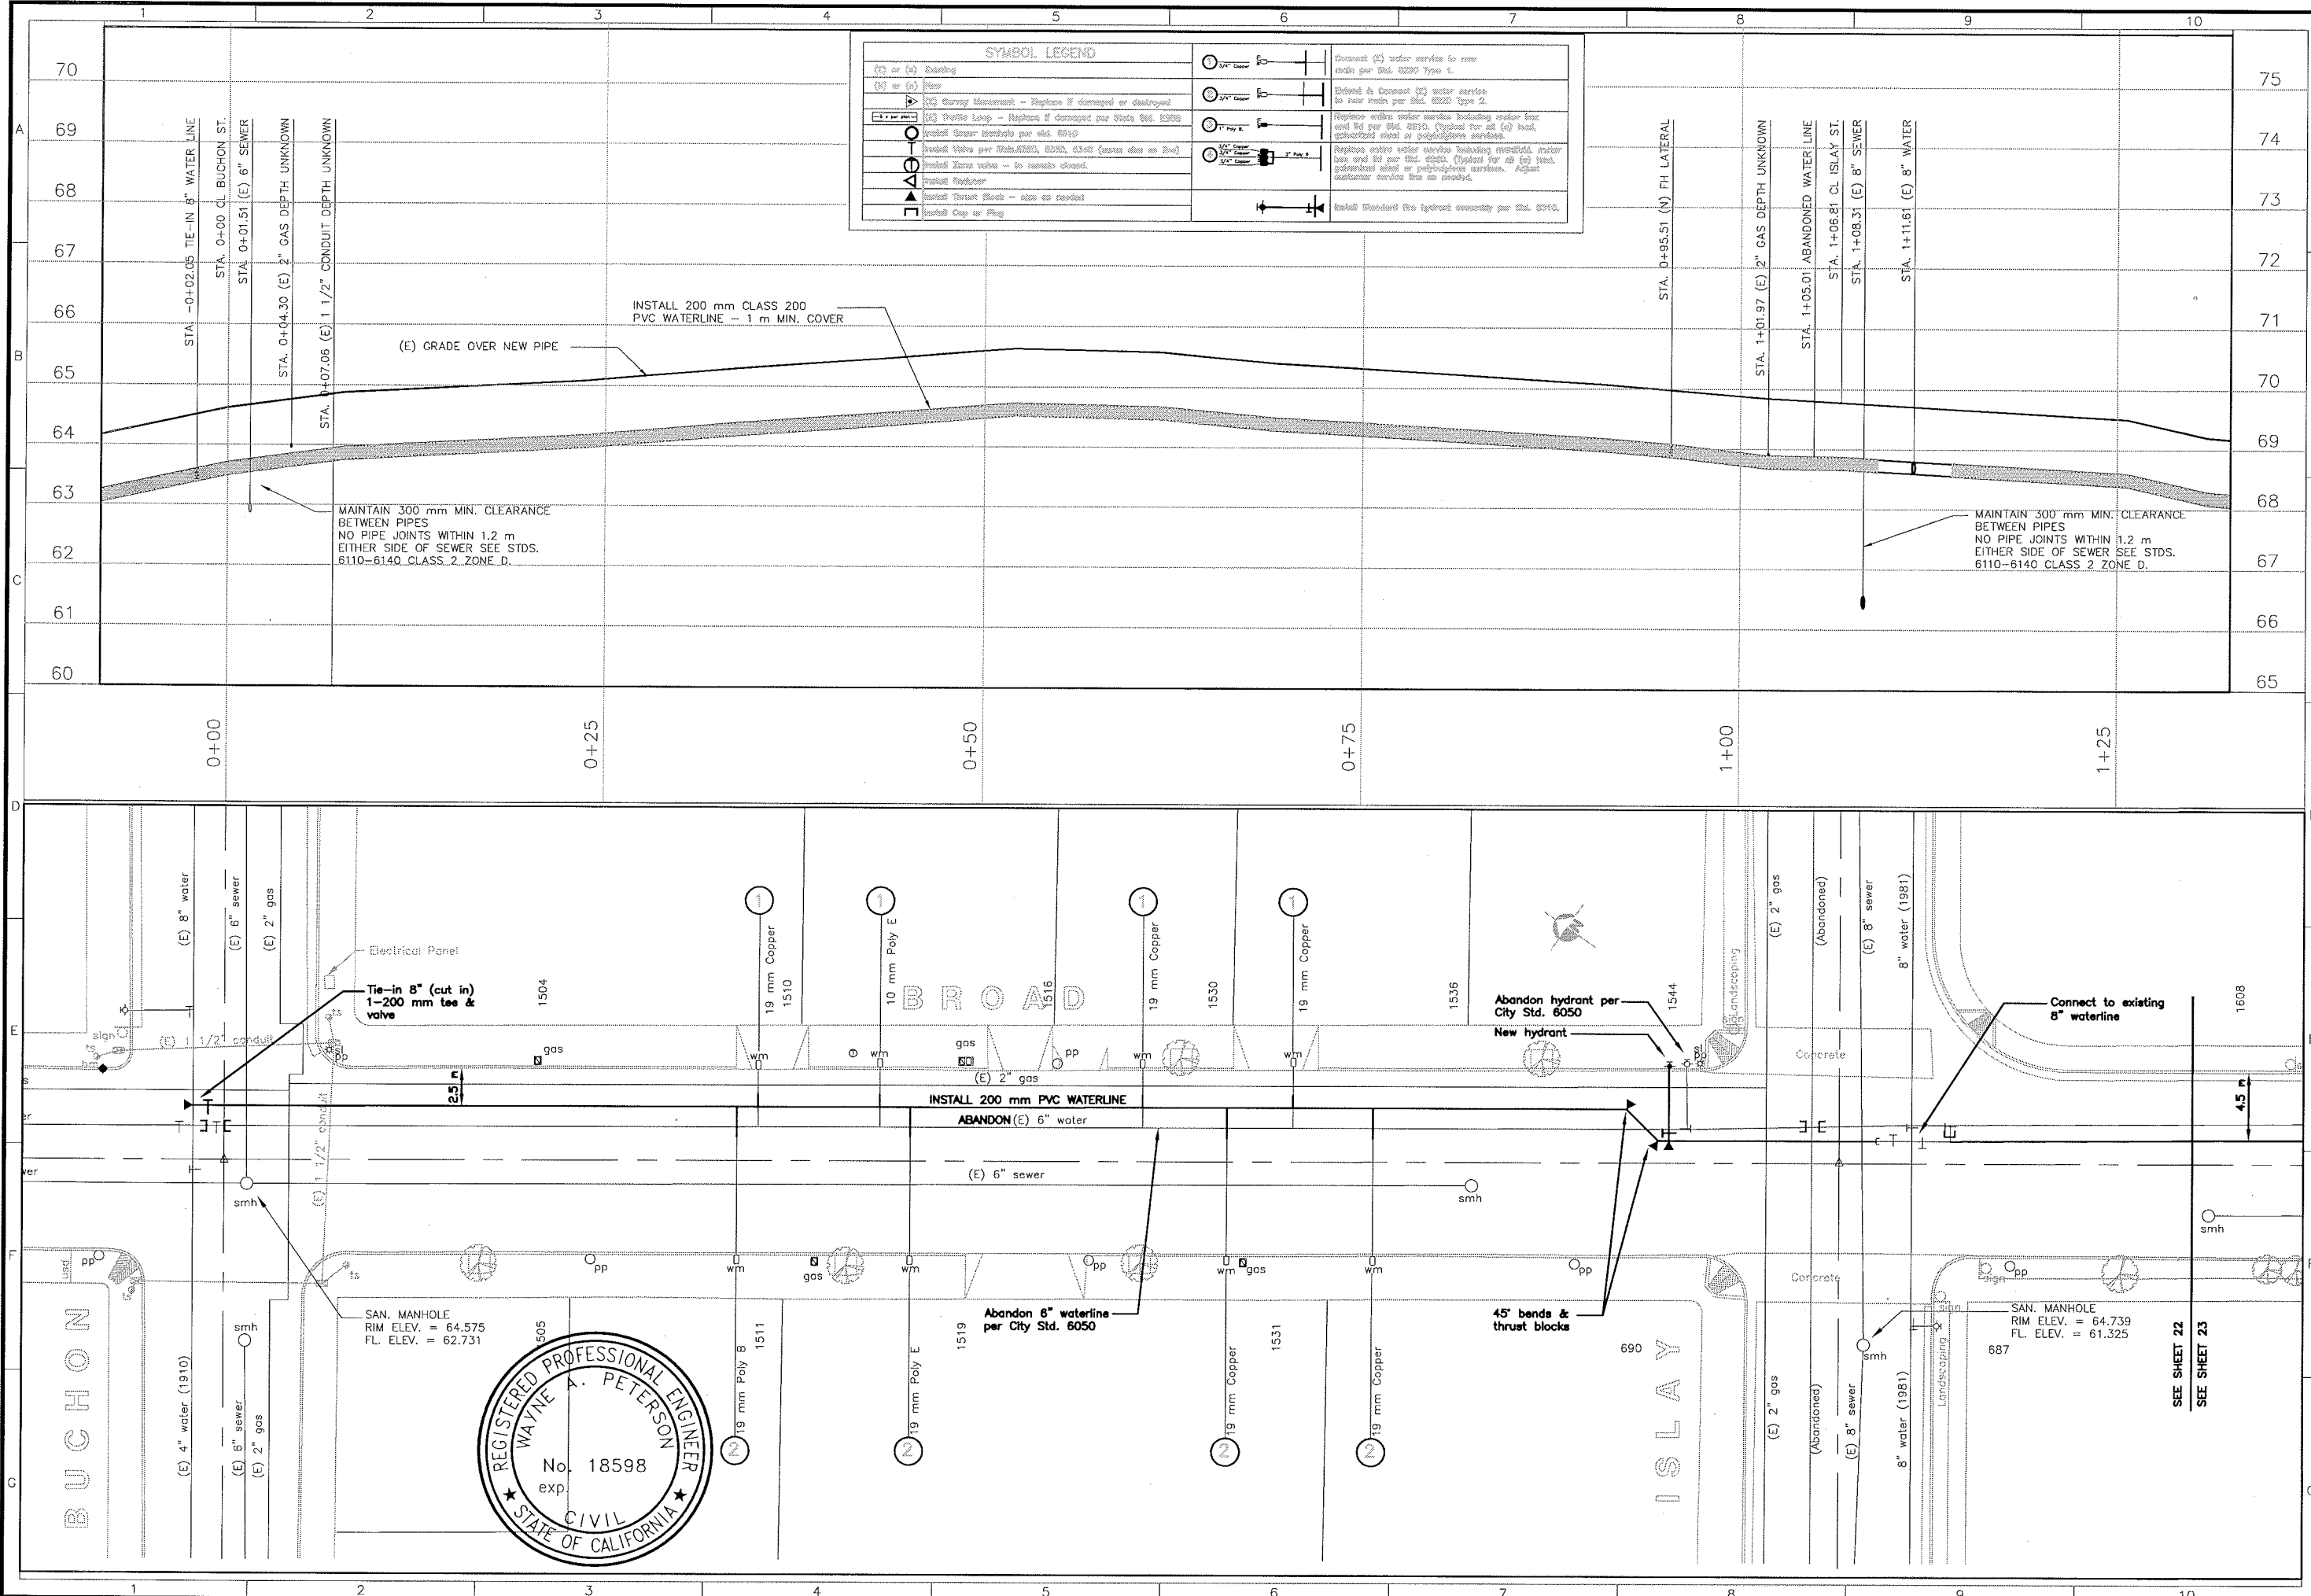




SYMBOL LEGEND	
(C) or (S) Existing	Connect (C) water service to new main per Std. 6220 Type 1.
(E) or (S) New	Reinforced Concrete (C) water service to new main per Std. 6220 Type 2.
(E) or (S) New	Reinforced Concrete (C) water service to new main per Std. 6220 Type 2.
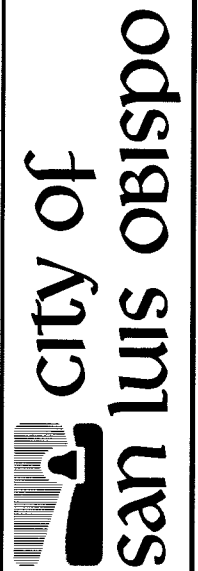

REVISIONS:	Drawn By & Date	Record Drawing	Drawn By & Date

PROJECT TITLE	BROAD STREET BUCHON ST. - ISLAY ST.
DESIGNED BY:	JV
DRAWN BY:	SR
CHECKED BY:	
APPROVED BY:	
DATE:	DEC 1999
CITY SPECIFICATION NO.	90033
SHEET NO.	22 of 25

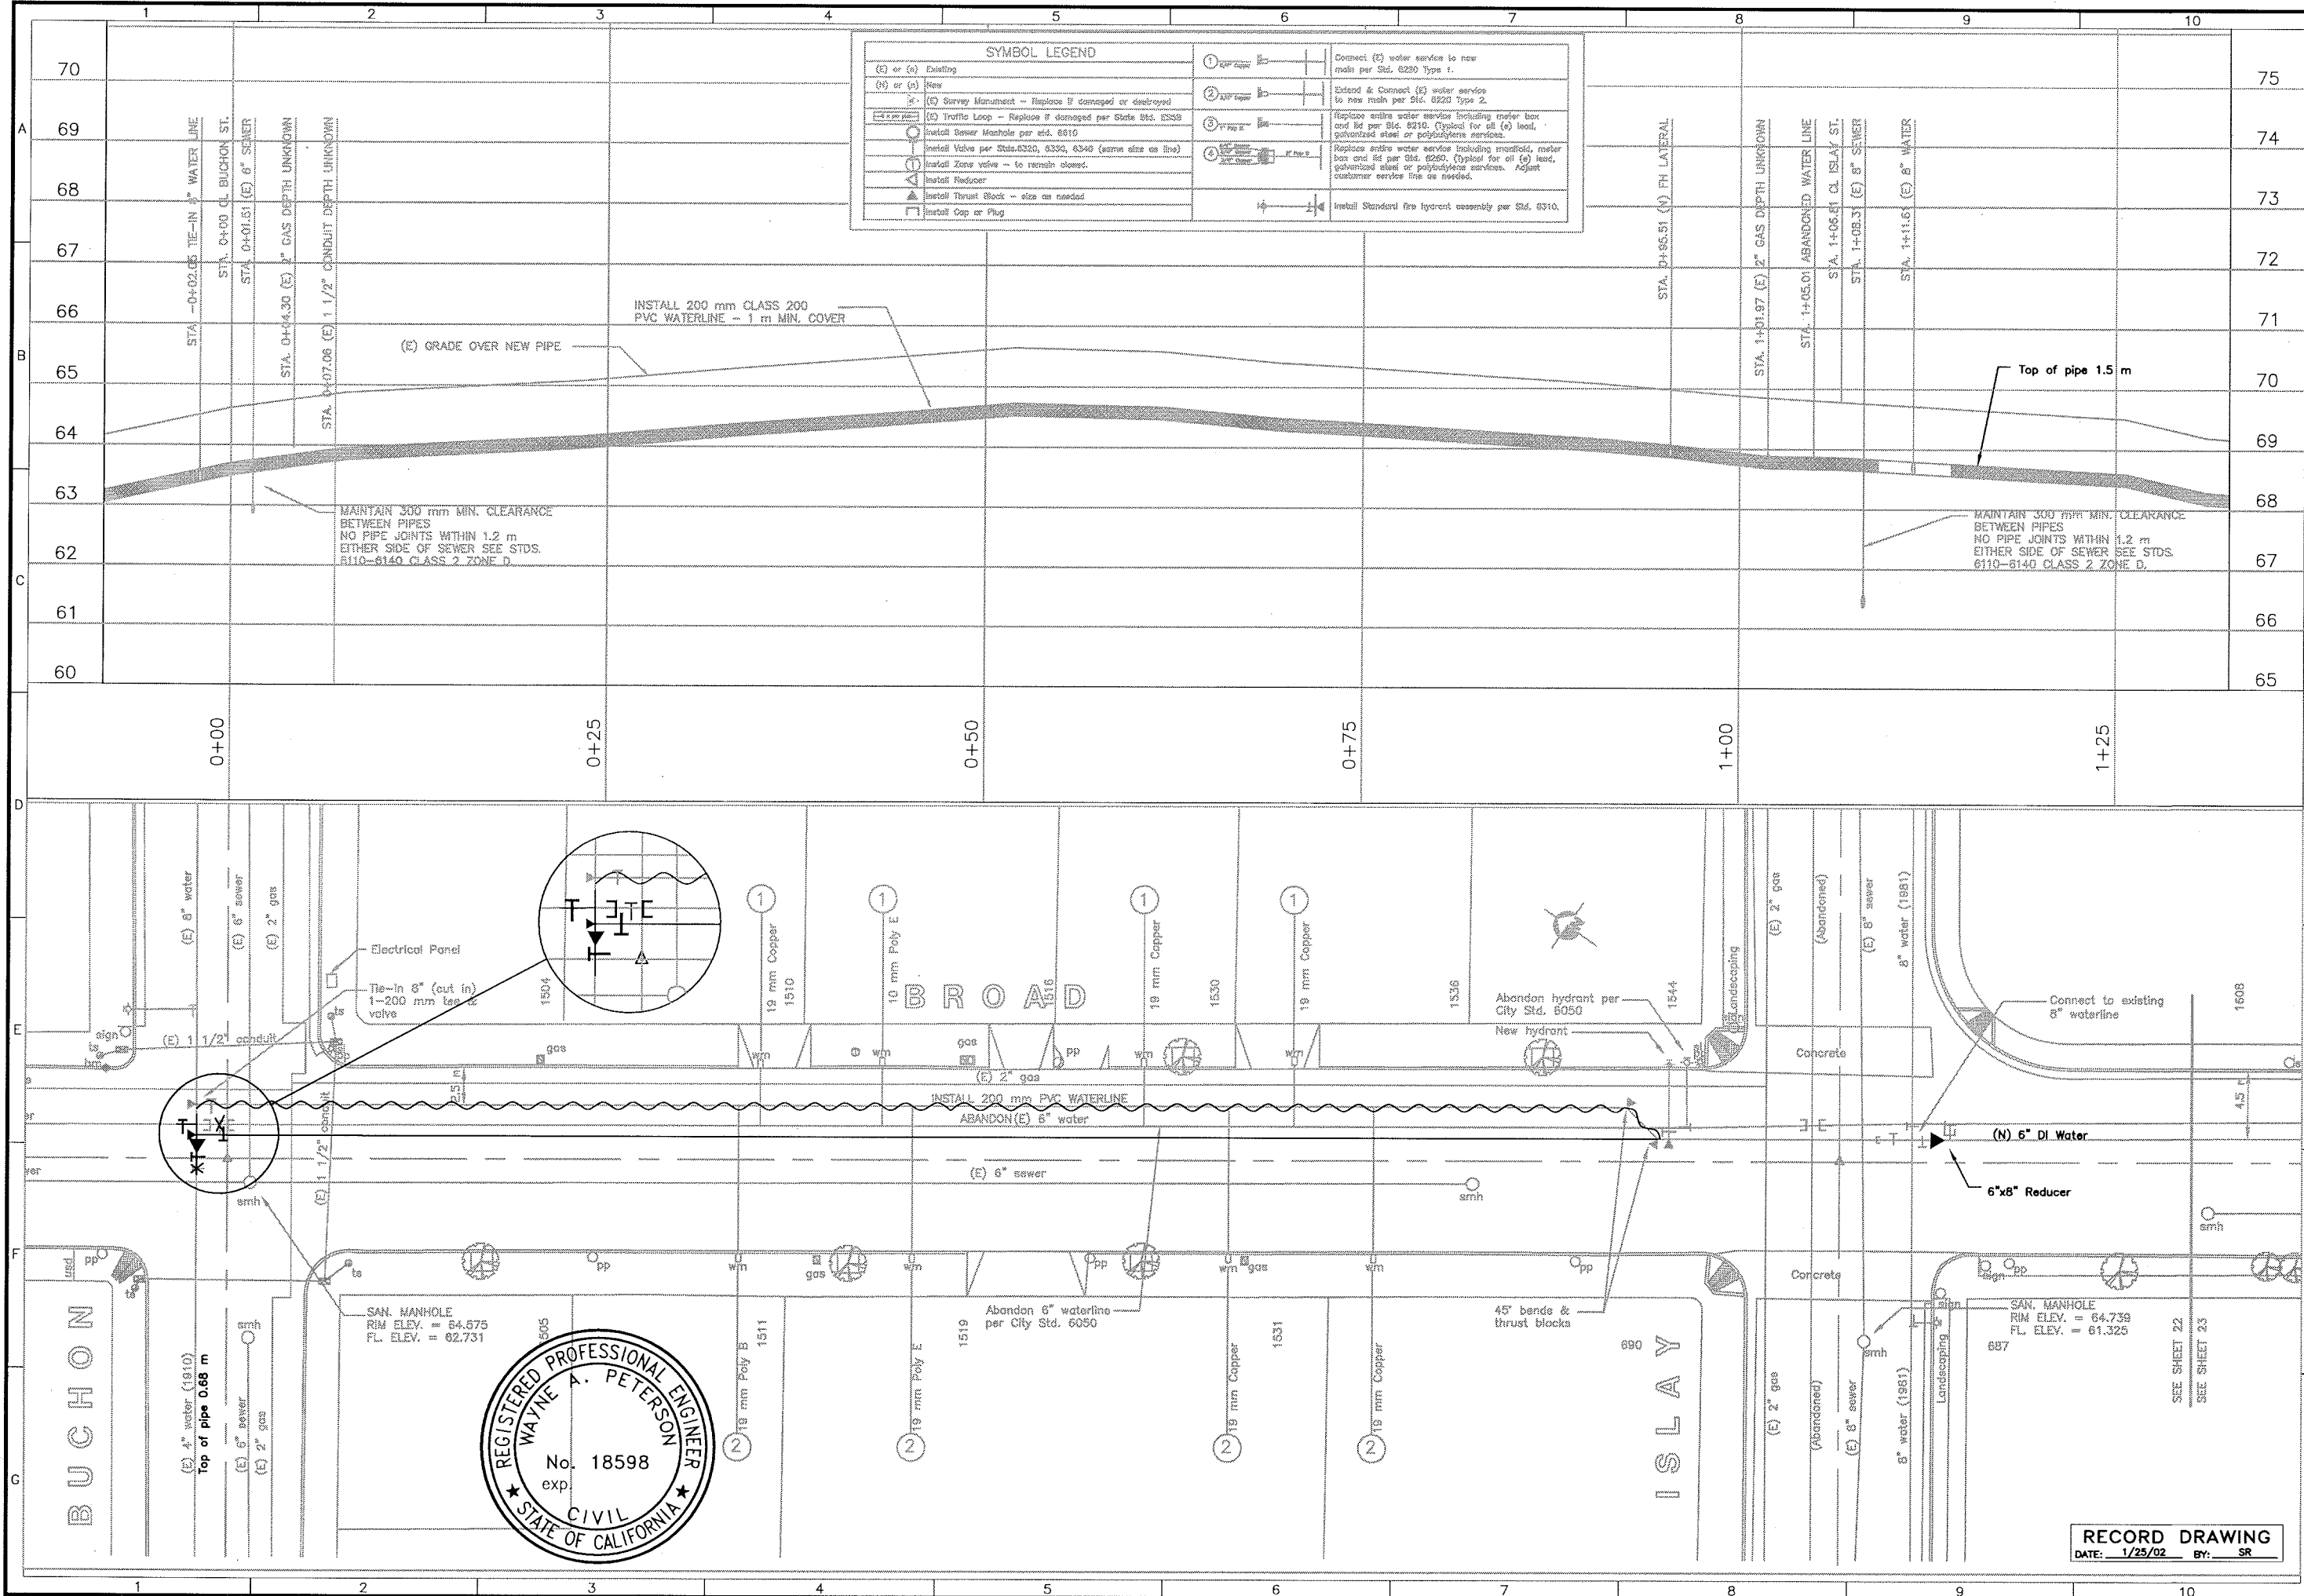

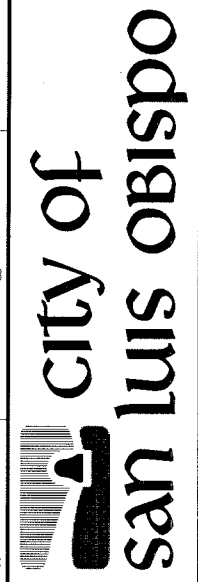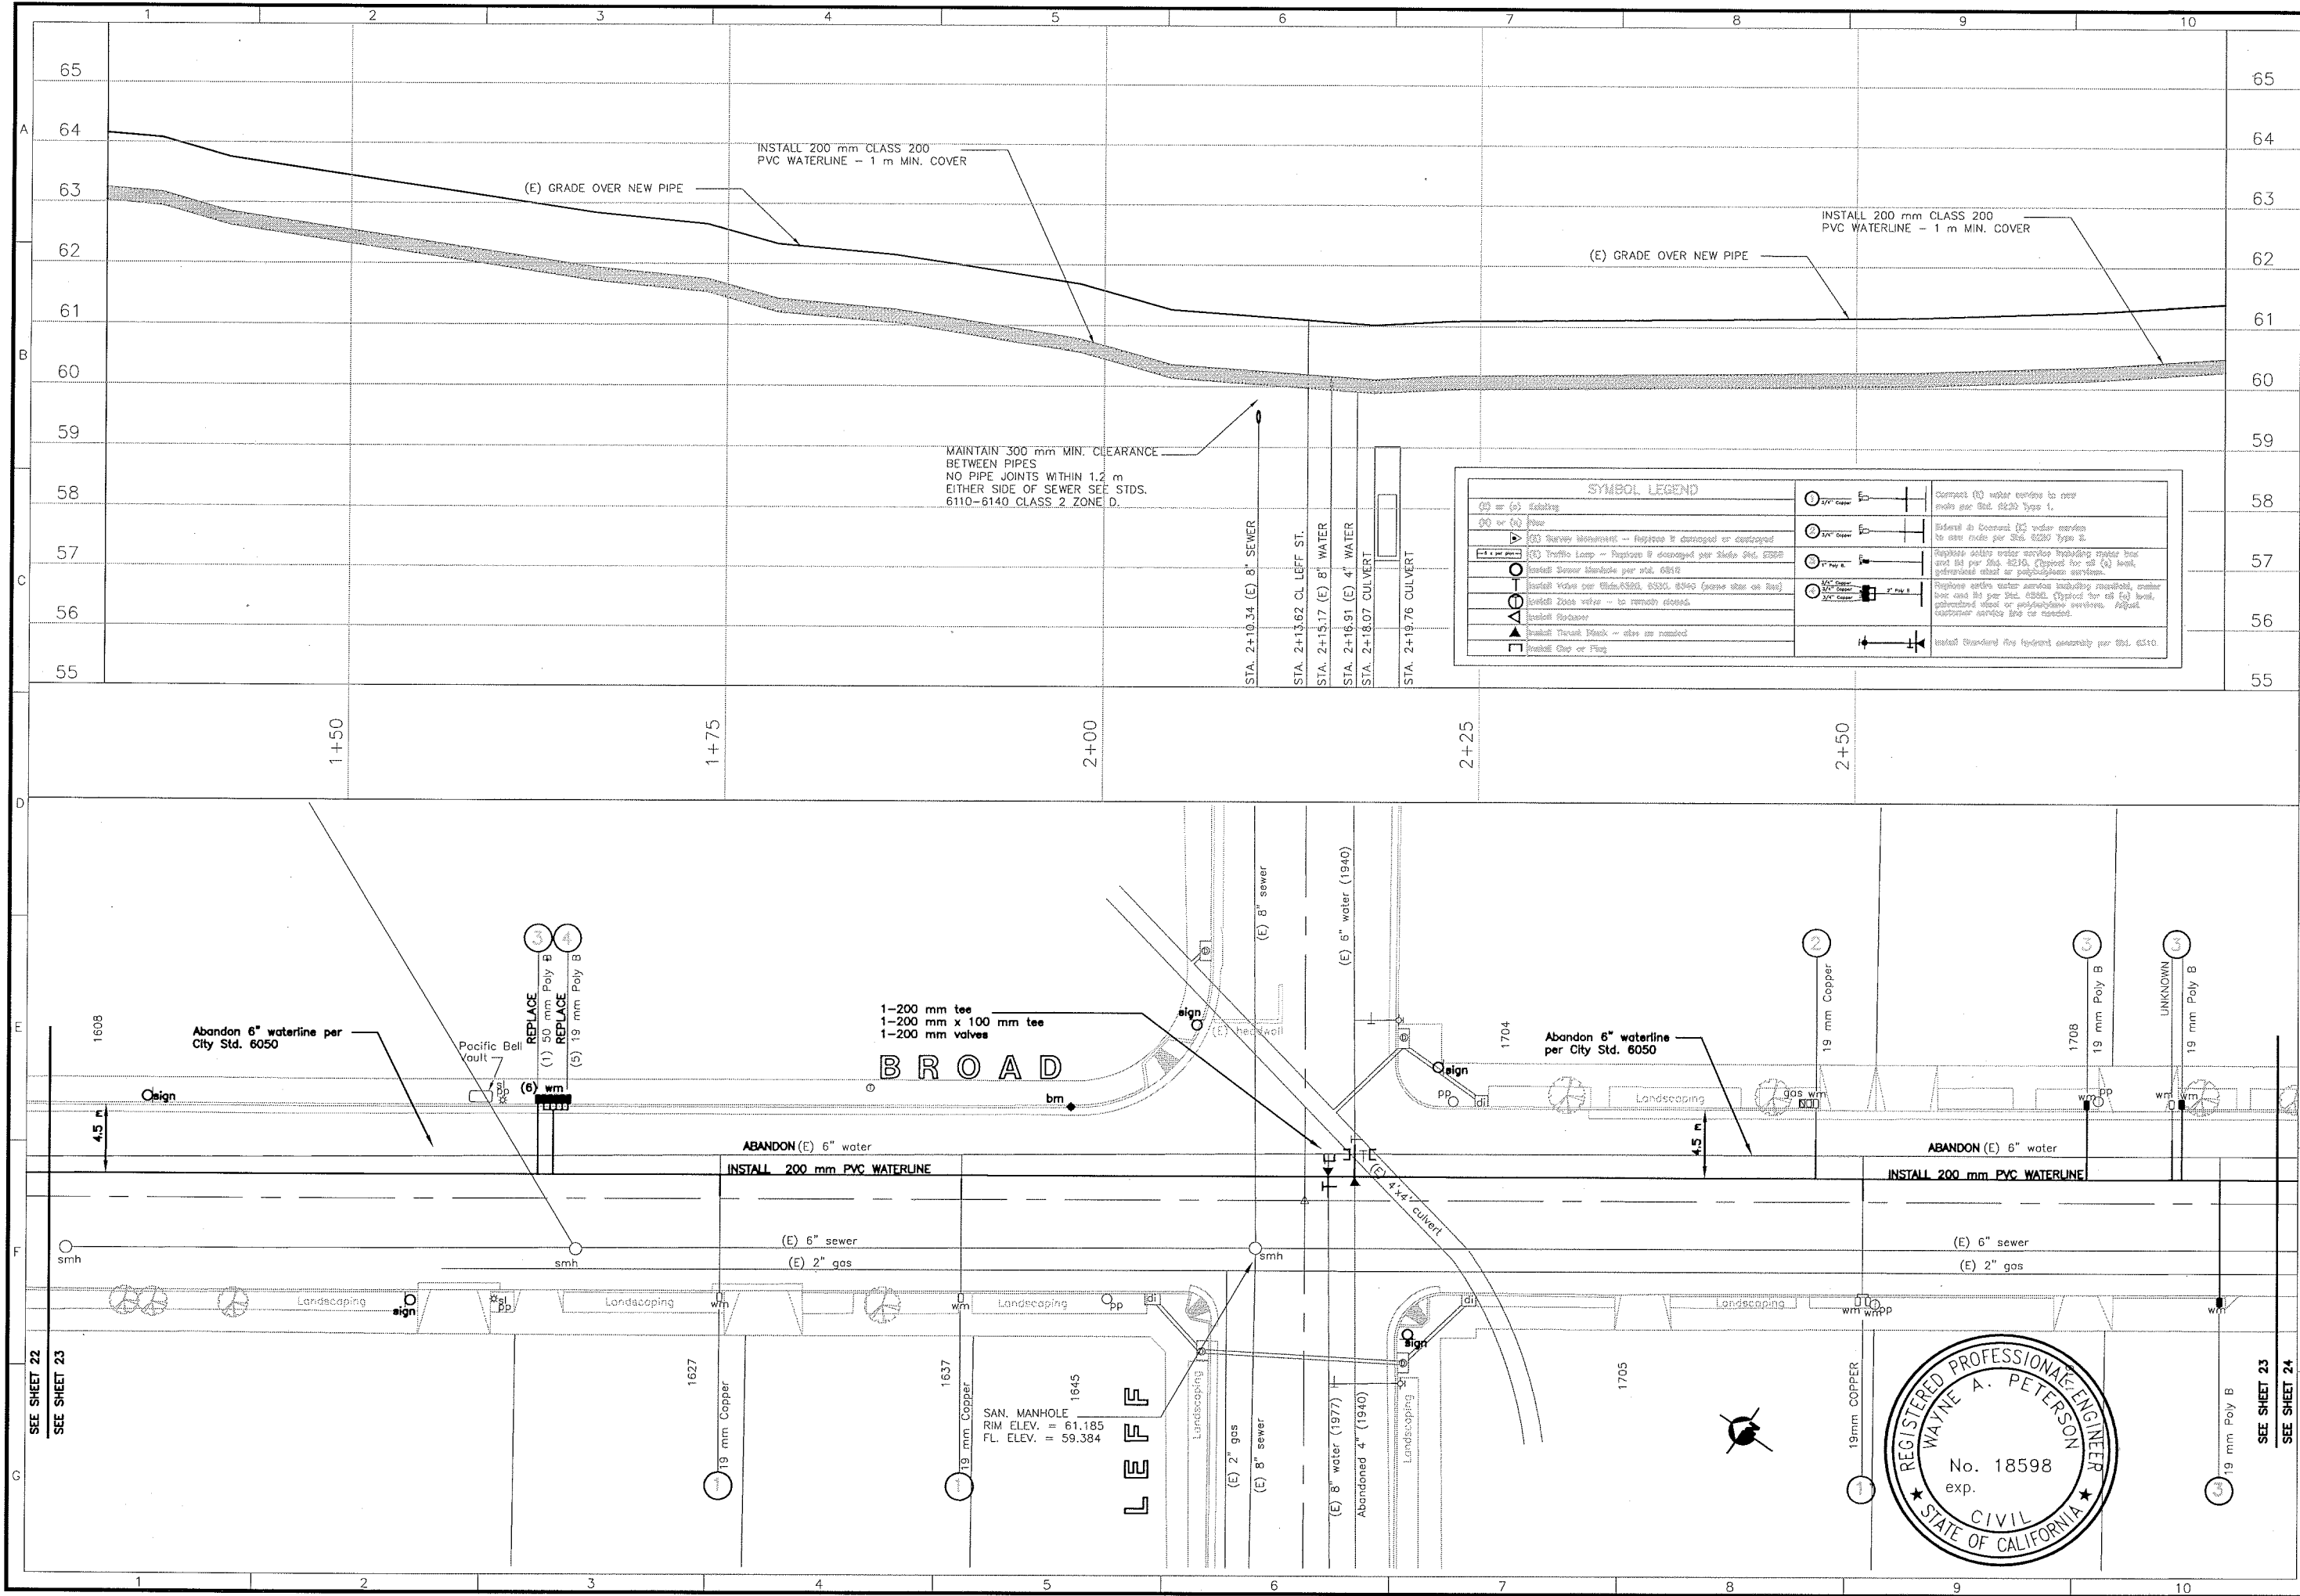


REVISIONS:	Drawn By & Date	Record Drawing	Drawn By & Date

PROJECT TITLE
BROAD STREET
ISLAY ST. - LEFT ST.

DESIGNED BY: JV
DRAWN BY: SR
CHECKED BY:
APPROVED BY:

DATE:
CITY SPECIFICATION NO. 90033
SHEET NO. 23 of 25



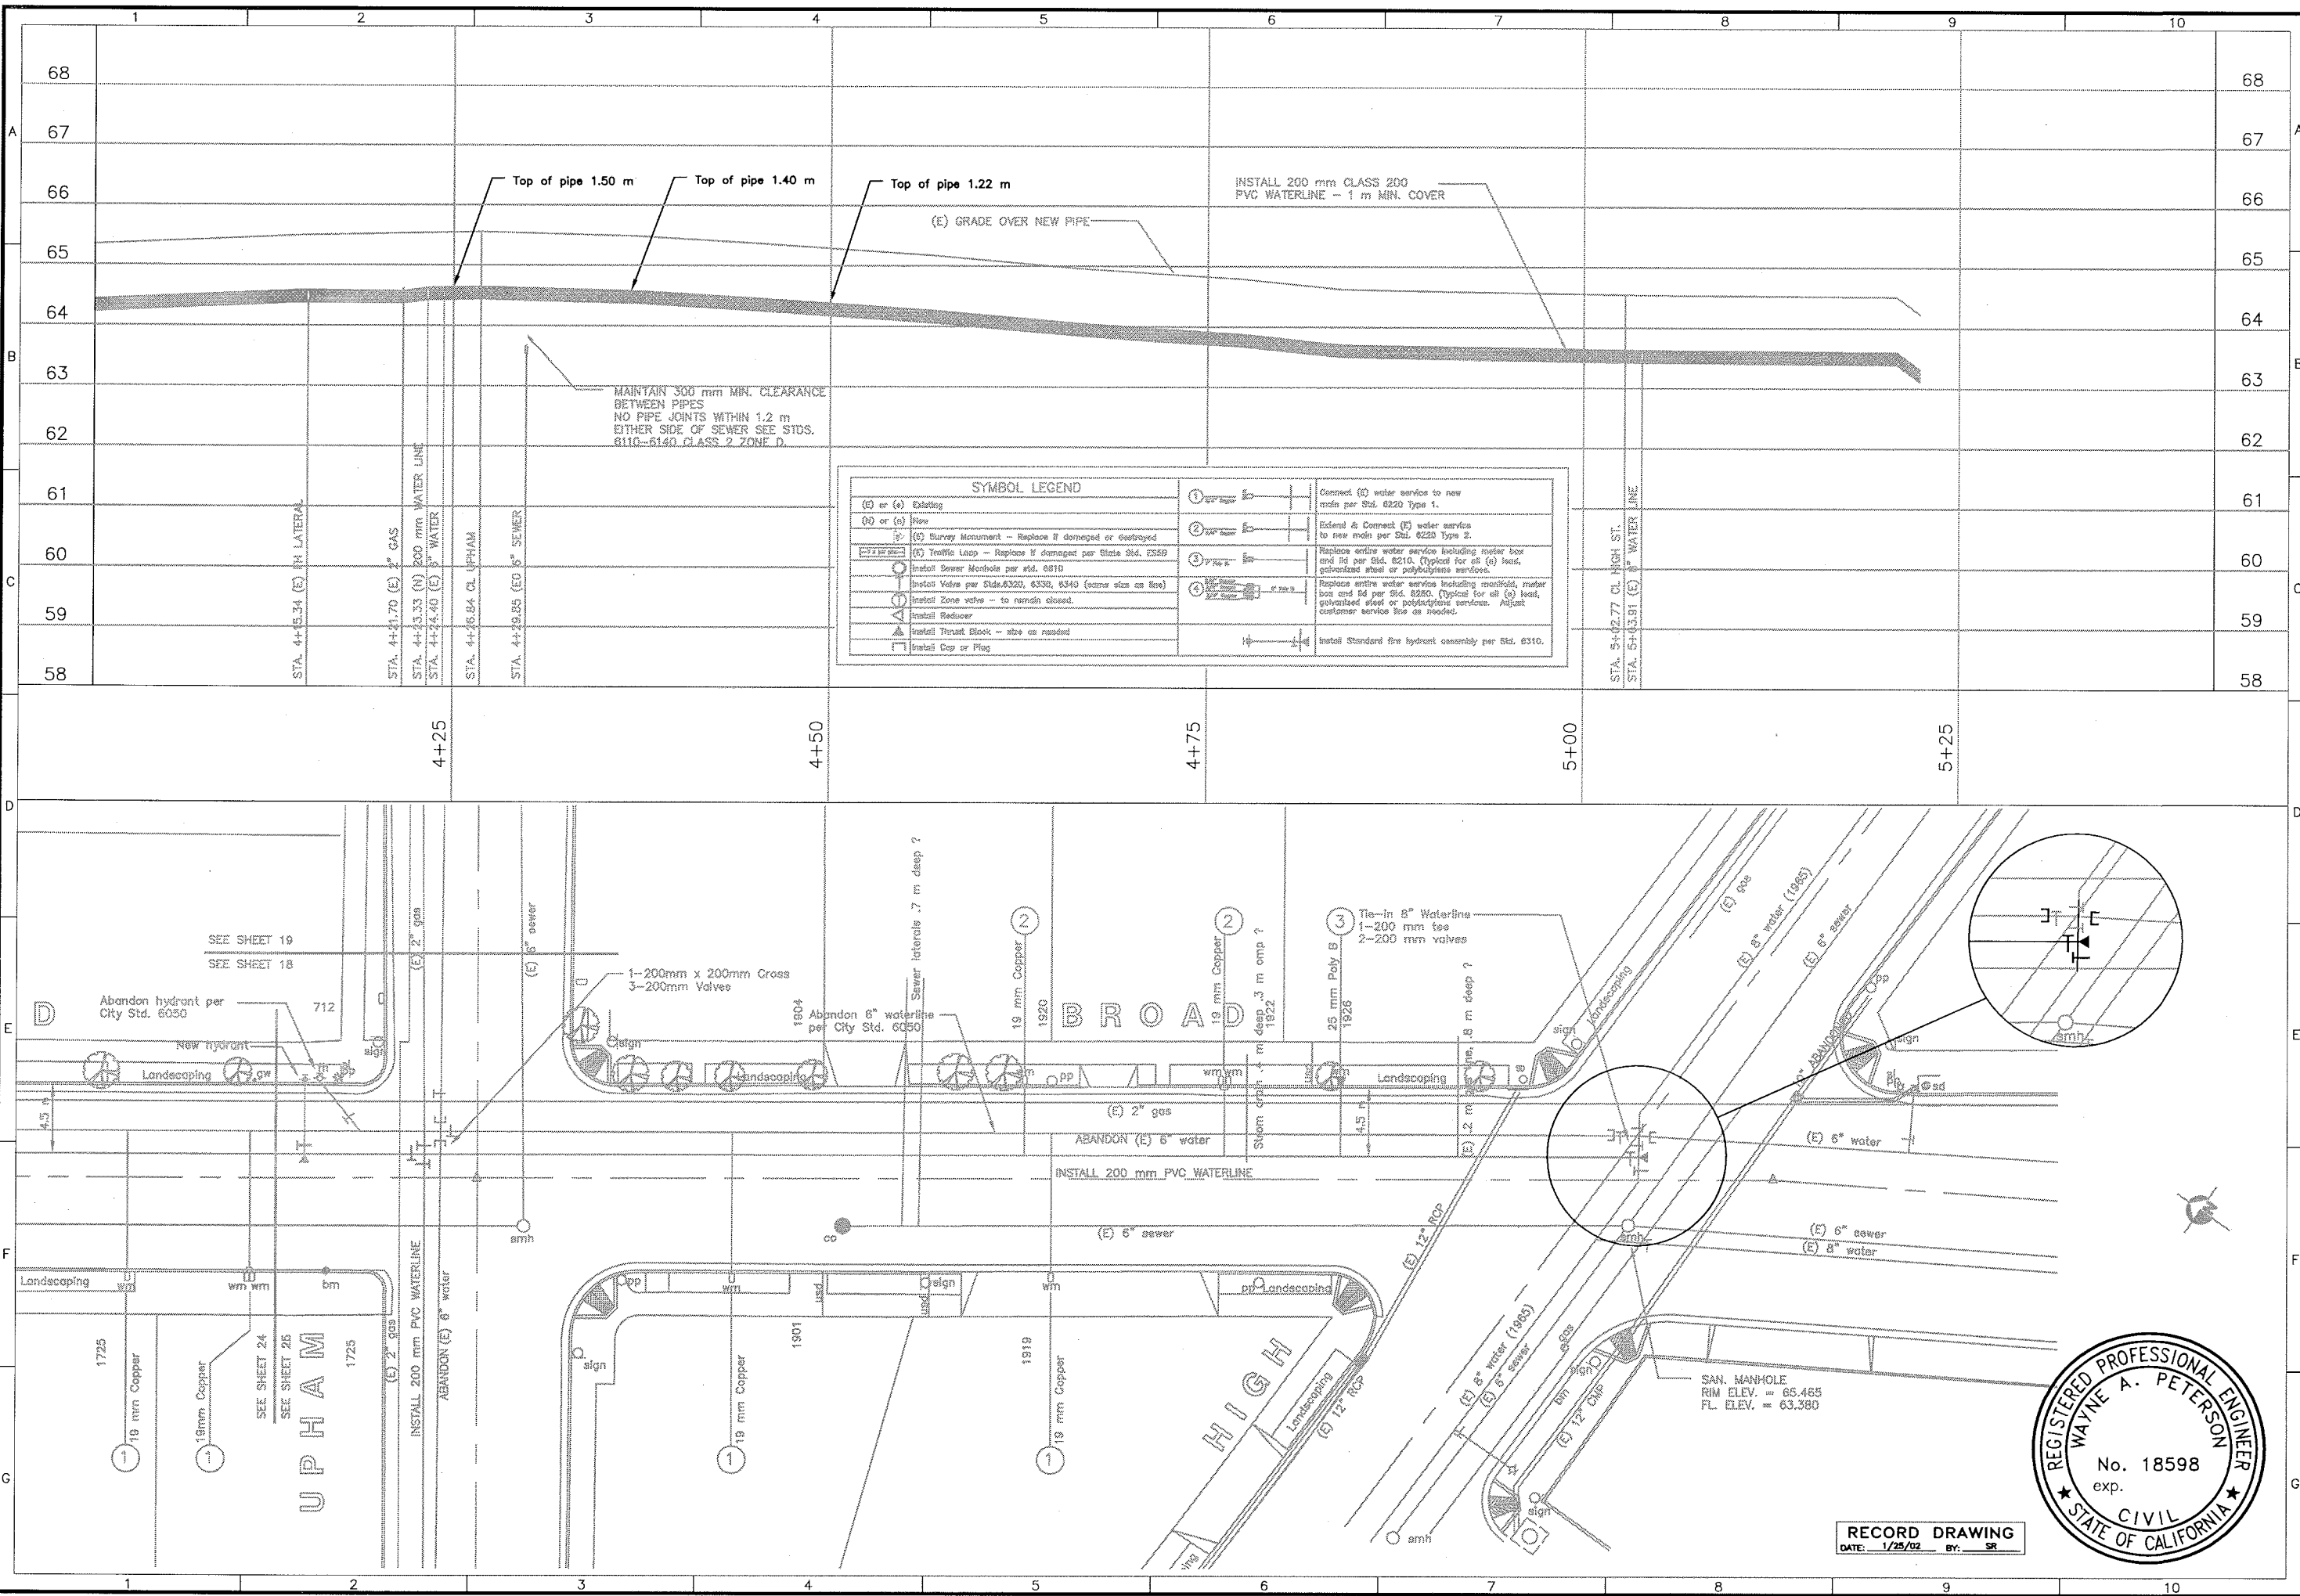

SYMBOL LEGEND	
(E) or (A) Existing	1" 2" 3" 4" 6" 8" 12" 18" 24" 12006"