

general notes


- 1. IT SHALL BE THE RESPONSIBILITY OF THE CONTRACTOR OR PERMITTEE TO CONTACT "UNDERGROUND SERVICE ALERT U.S.A." TOLL FREE AT 1-800-227-2600 FORTY-EIGHT (48) HOURS PRIOR TO START OF CONSTRUCTION, FOR LOCATION OF POWER, TELEPHONE, OIL AND NATURAL GAS UNDERGROUND FACILITIES. CONTRACTOR OR PERMITTEE SHALL ALSO CONTACT THE APPROPRIATE AGENCY FOR THE LOCATION OF CABLE T.V., WATER, SEWER, DRAINAGE OR UNDERGROUND FACILITIES.
- 2. THE CONTRACTOR SHALL POSSESS A GLASS "A or C34" LICENSE AT THE TIME THE CONTRACT IS AWARDED.

construction notes

- 1. (N) = New - to be installed
(E) = Existing
- 2. Contractor shall verify depth/dimensions of existing waterlines prior to tie-in.
- 3. All water services (main to meter) shall be 25 mm copper except 299 Albert & manifolds which shall be 50 mm copper.
- 4. The City will furnish new water meters & washers for relocated water meters. Information on water meter size & location can be found on the details for each individual residence. Meter information is furnished for spacing purposes.
- 5. Water services on private property (meter to residence) shall be per the details for each individual residence.

legend

W — W — W	Existing water line
S — S — S	Existing sewer line
G — G — G	Existing gas line
-----	Existing wall
— T —	Existing telephone
▲	Install new thrust block
△	Install reducer
△	Monument
⊙	Existing sewer clean out
⊗	Existing hose bib
⊗	Install new hose bib
⊙	Existing drainage
⊗	Boring locations
☆	Existing street lights
—	Existing street lights
●	Install Fire Hydrant Assembly, Eng. Std. 6310
	Existing drain inlets
T	Install valve, Eng. Std. 6340
T	Existing water valve
□	Install water service Eng. Std. 6210 or 6260
⊗	Existing gas meter
⊗	Existing power

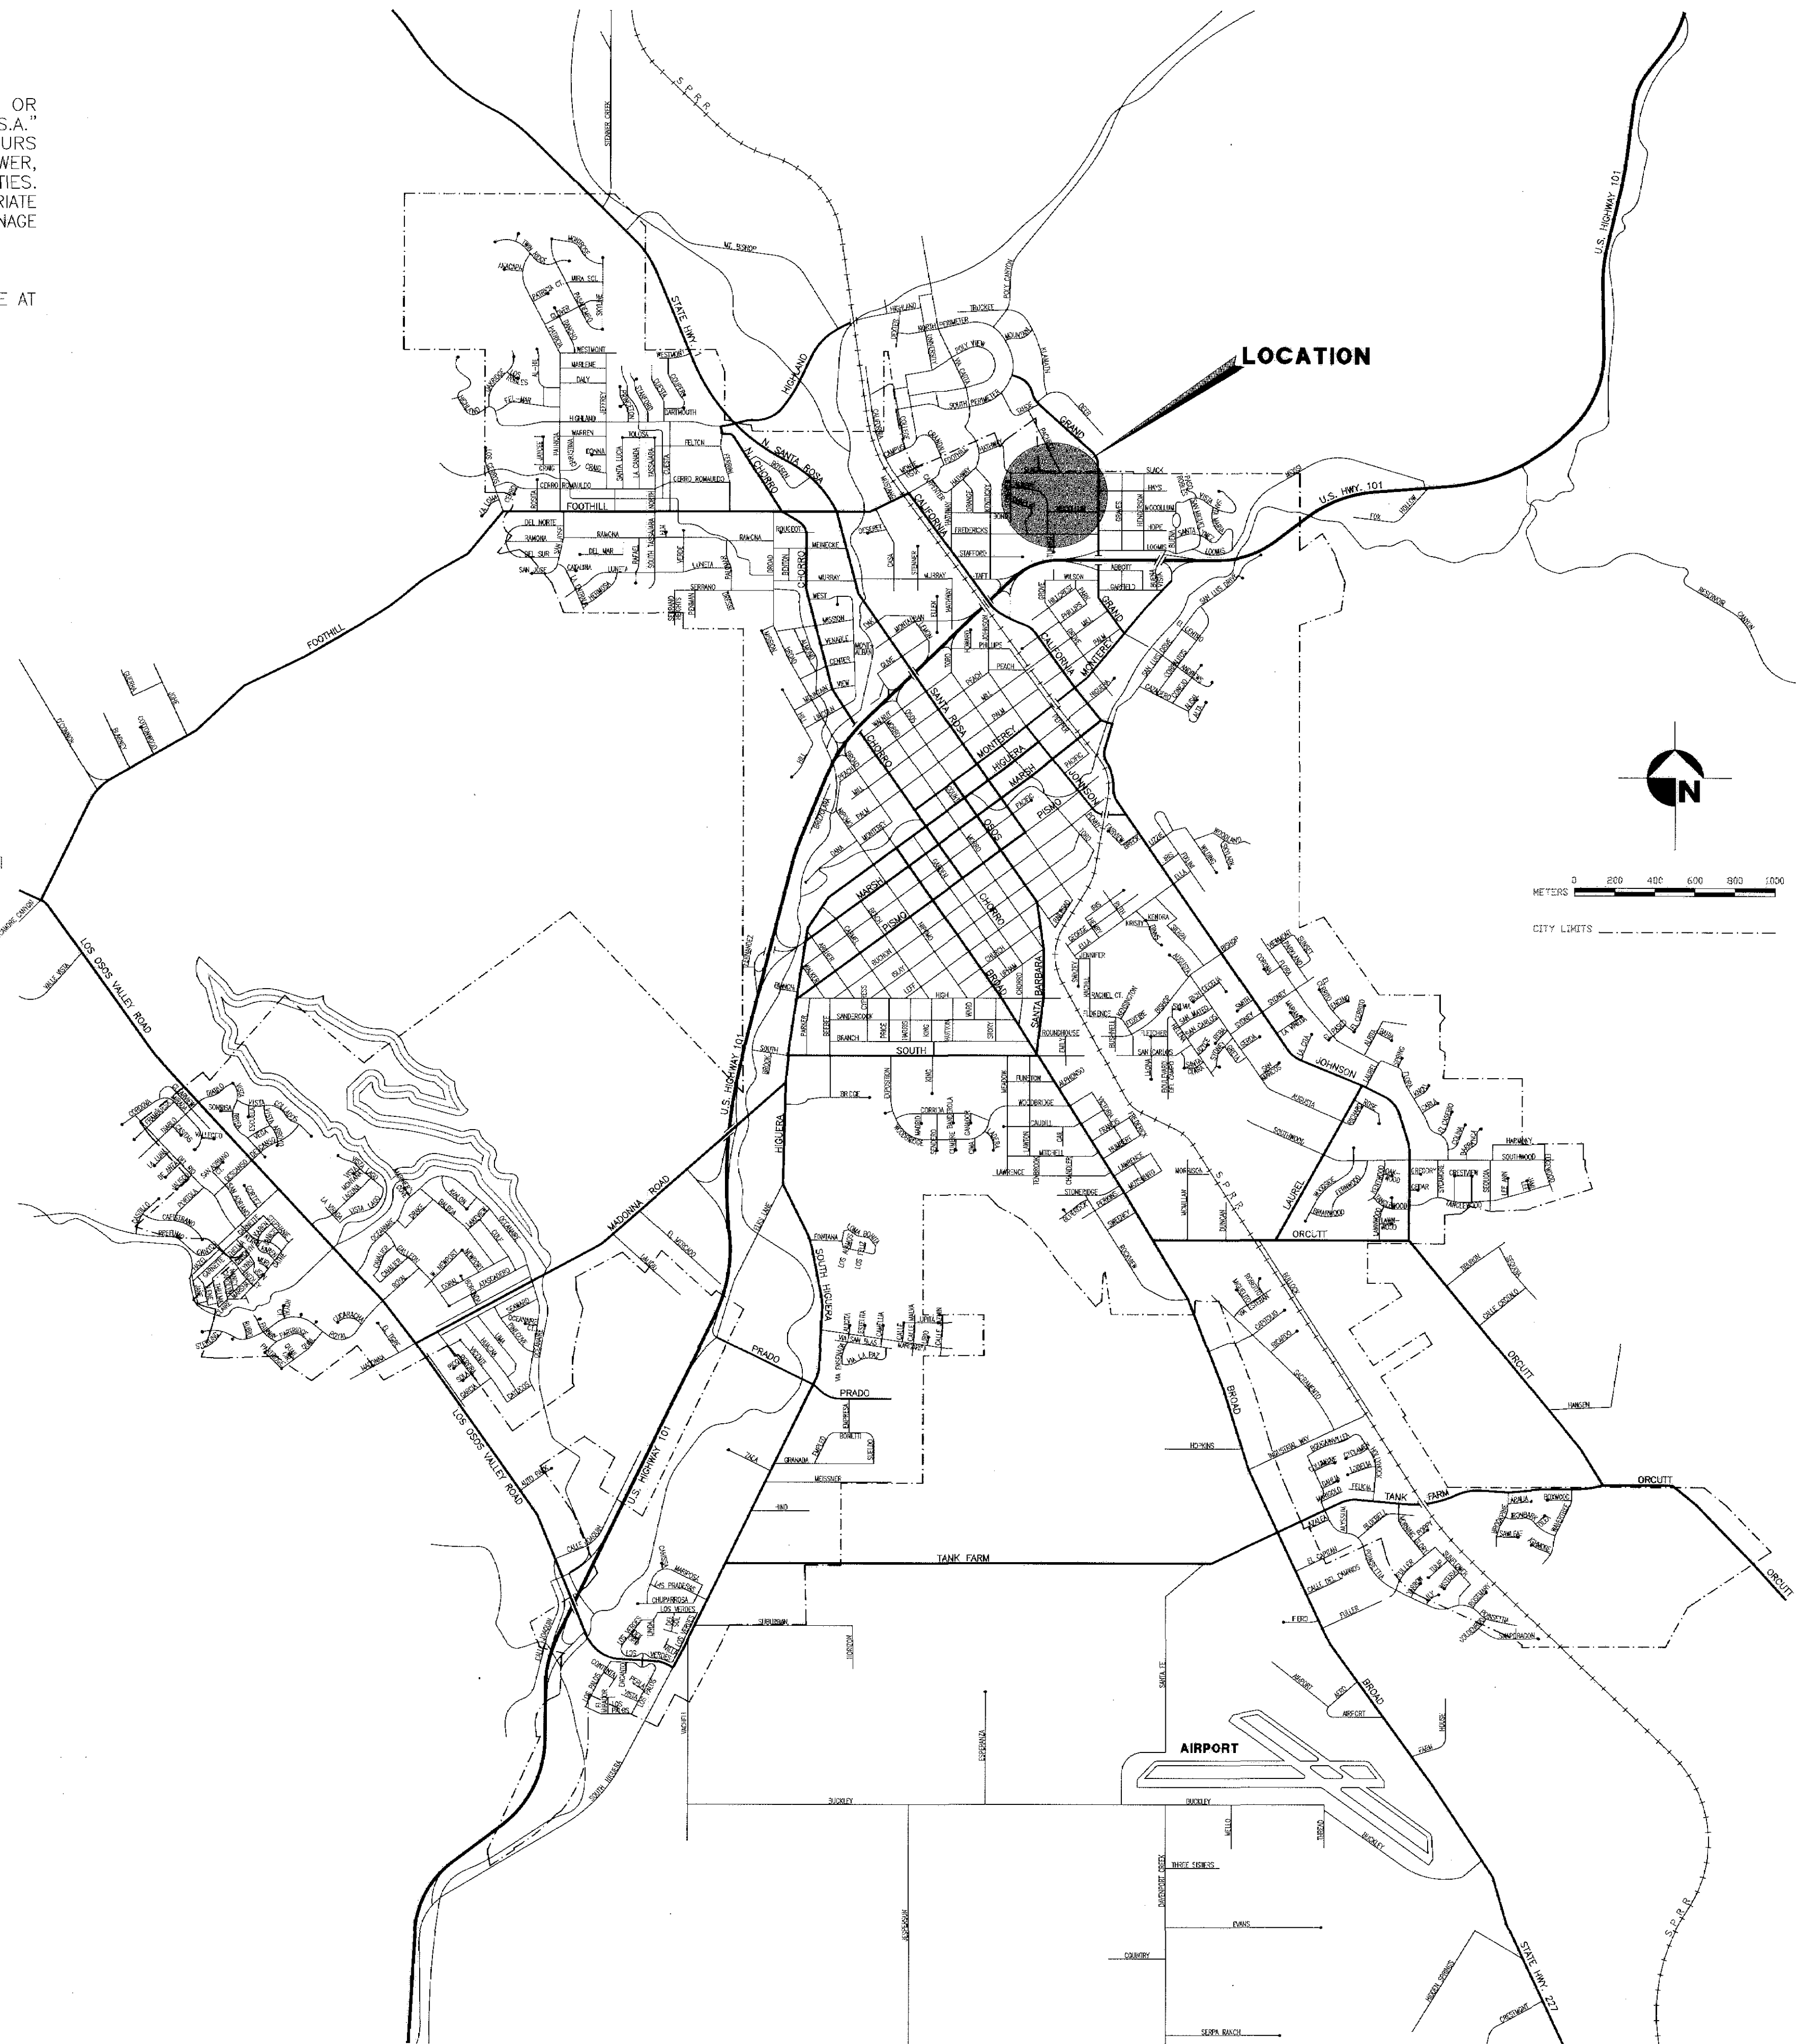

index to plans

sheet no.	description
1.	Cover Sheet
2.	Albert Drive
3.	Albert Drive
4.	Chaplin Lane
5.	Chaplin Lane
6.	Slack Street
7.	Slack Street
8.	Longview, Fredericks, Details



ALBERT, CHAPLIN, SLACK
WATER MAINS



SPECIFICATION NO. 98-79

APPROVED BY

Barbara Lynck
Barbara Lynck
Civil Engineer
R.C.E. 53418



DATE	7/23/98
FILE NO./LOCATION	
SHEET	1 OF 8

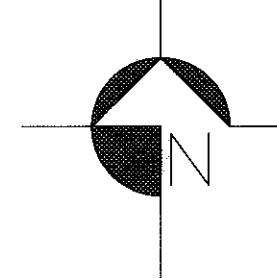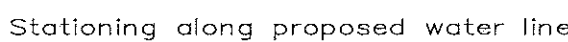


ALBERT, CHAPLIN & SLACK WATER MAINS





DATE	July 23, 1995
SCALE	1:300
DESIGNED BY	R.
DRAWN BY	S.
CHECKED BY	B.
APPROVED BY	

ALBERT DRIVE
PLAN & PROFILE

SPECIFICATION NO.	98-79
FILE NO./LOCATION	
SHEET	2 of 8

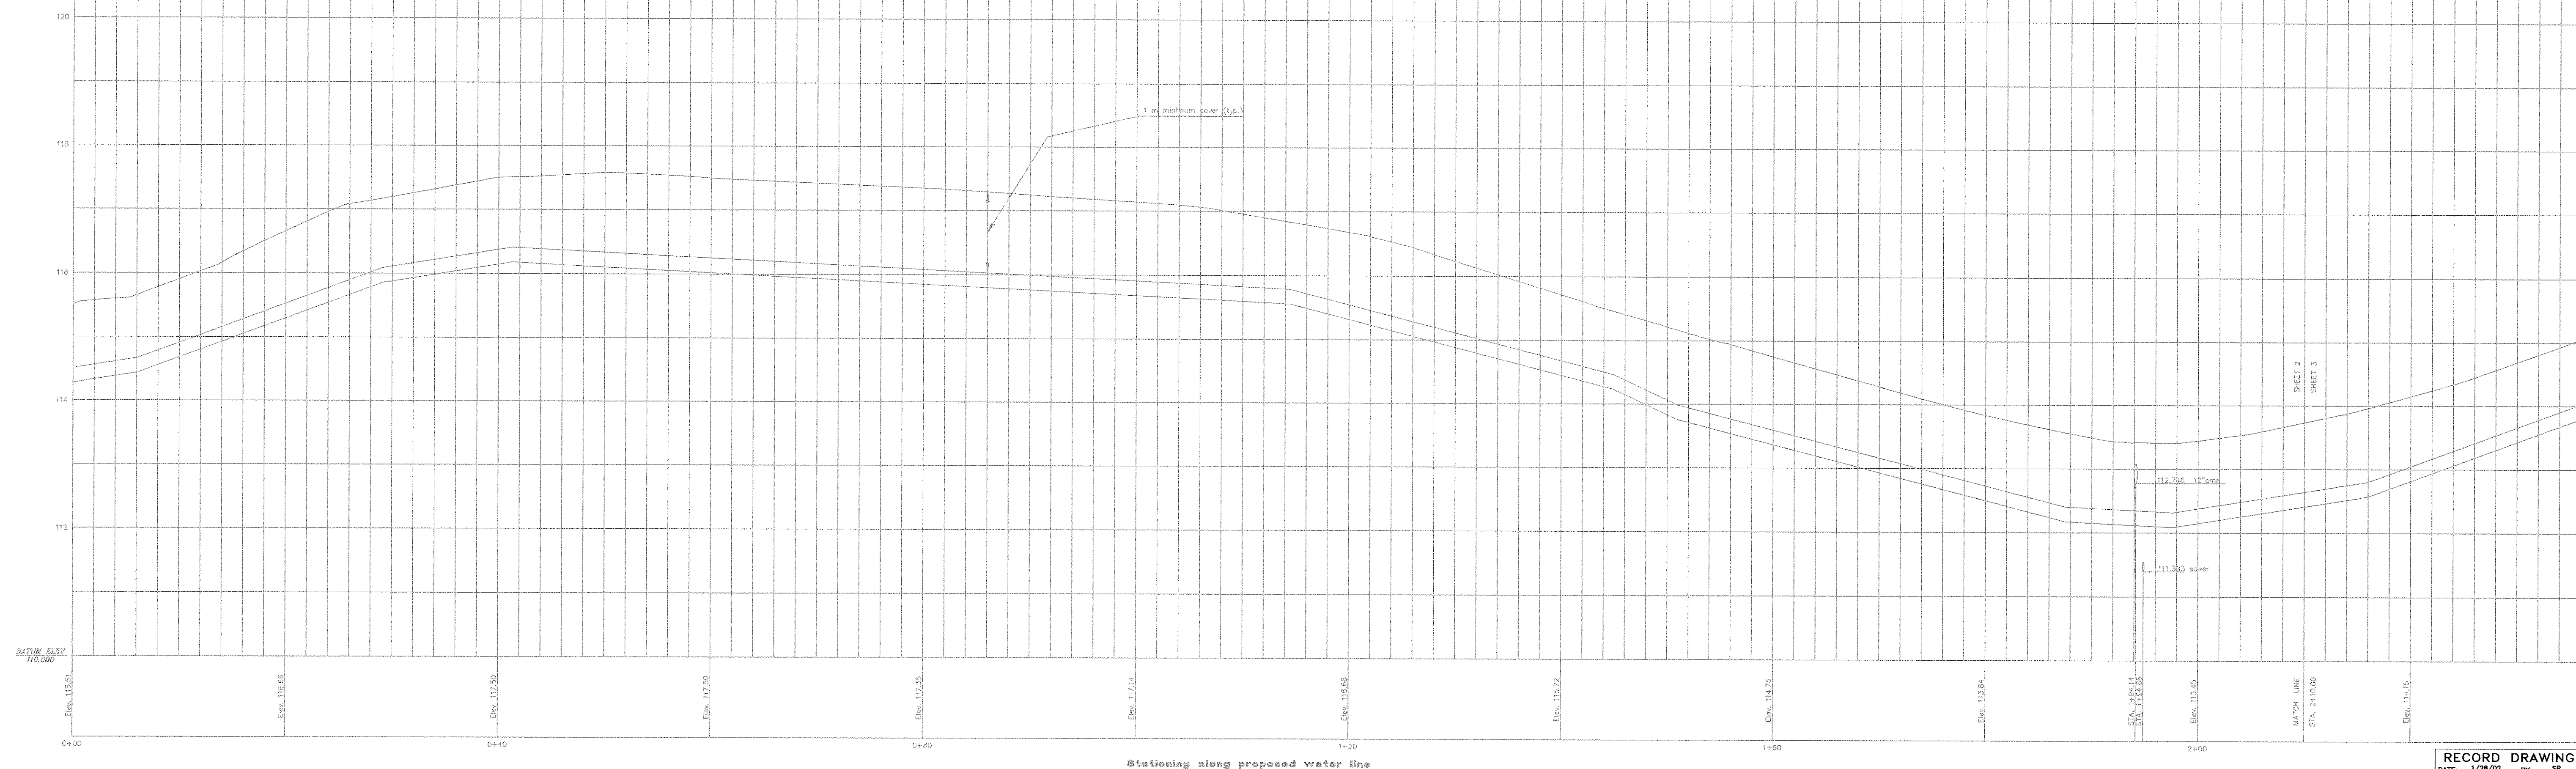
[illegible]

RECORD DRAWING
DATE: 1/28/02 BY: SR

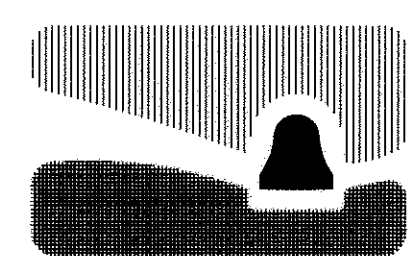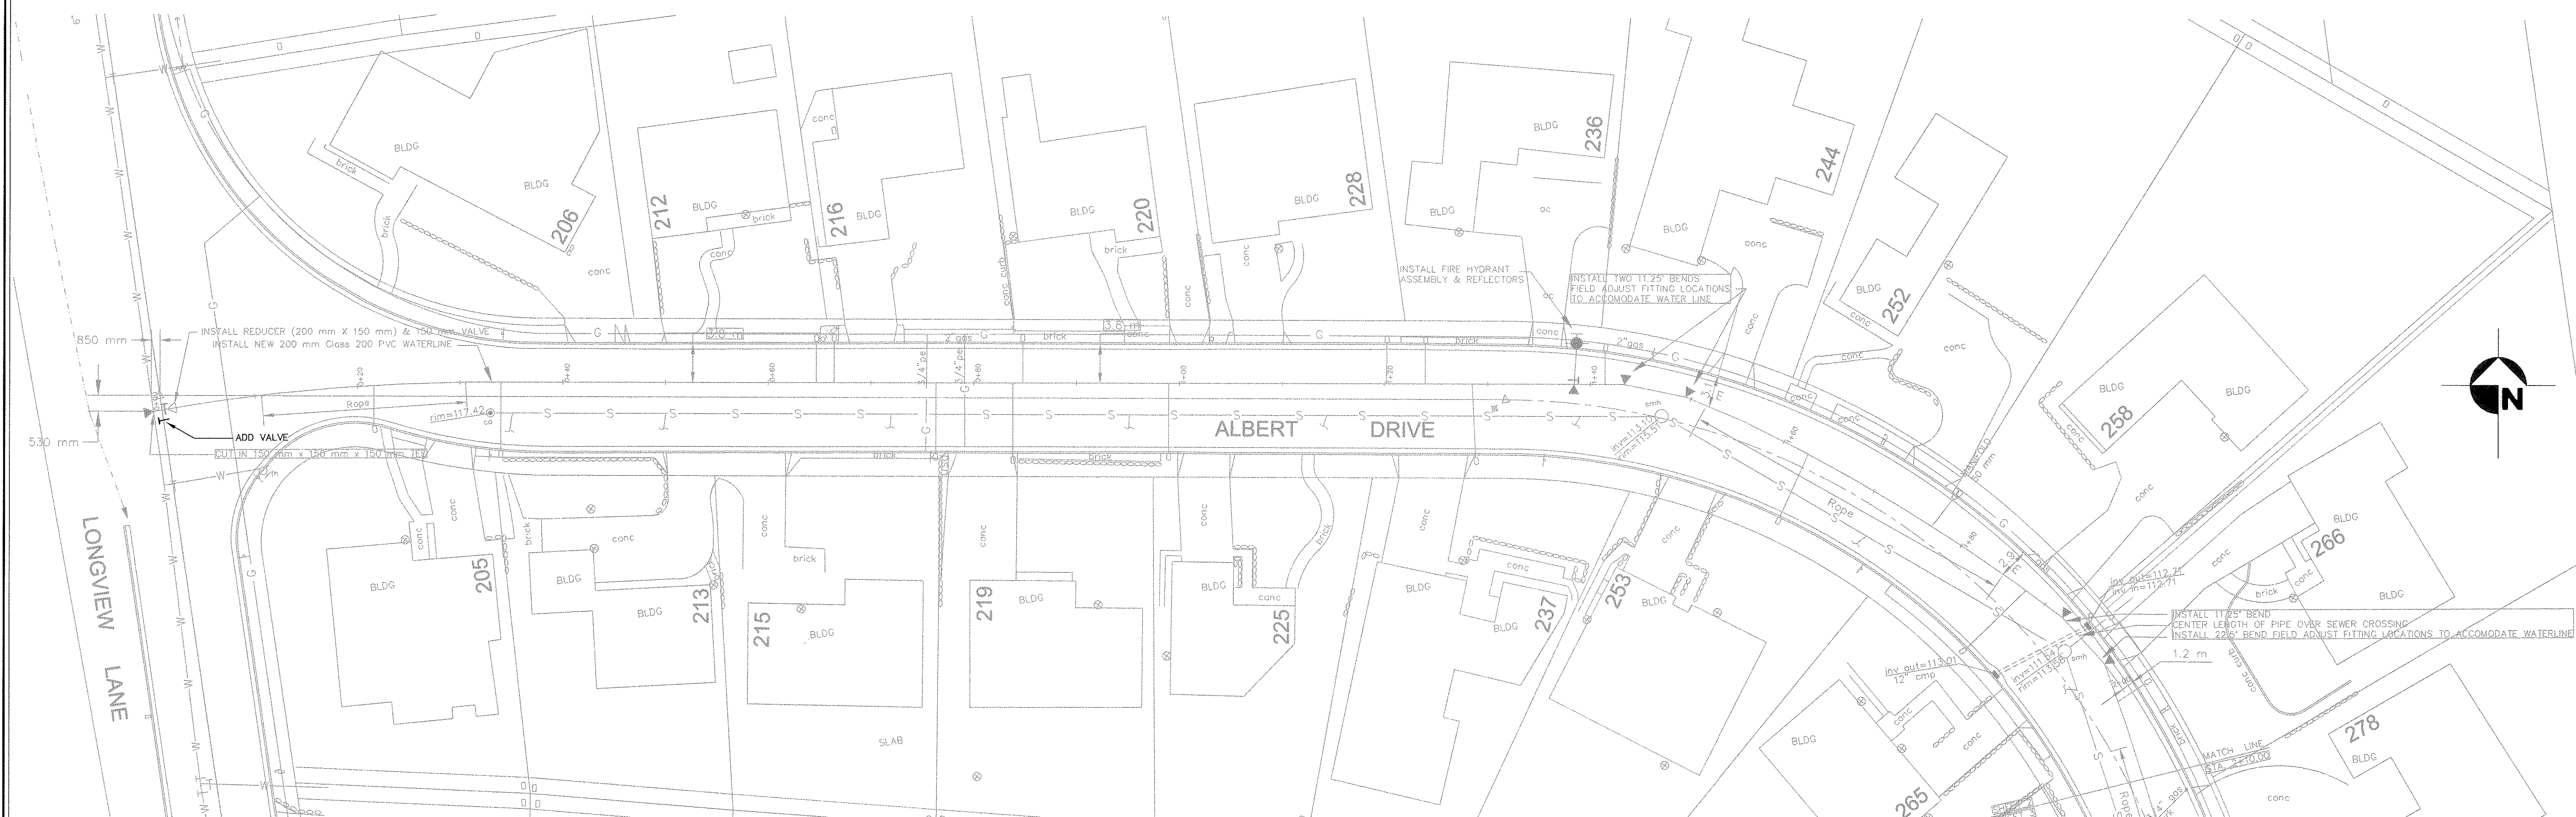

city of san luis obispo

ALBERT, CHAPLIN & SLACK WATER MAINS

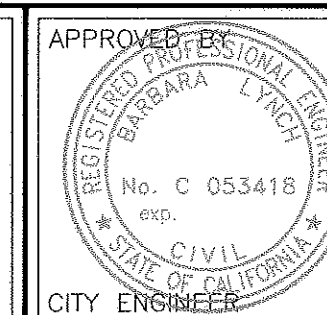

DATE	July 23, 1998
SCALE	1:300
DESIGNED BY	R. J.
DRAWN BY	S. R.
CHECKED BY	B. L.
APPROVED BY	
UTILITIES DEPARTMENT	


ALBERT DRIVE PLAN & PROFILE

SPECIFICATION NO.
98-79


FILE NO./LOCATION

SHEET
2 a OF **8**


NATURE / STATUS OF PLANS	BY	DATE

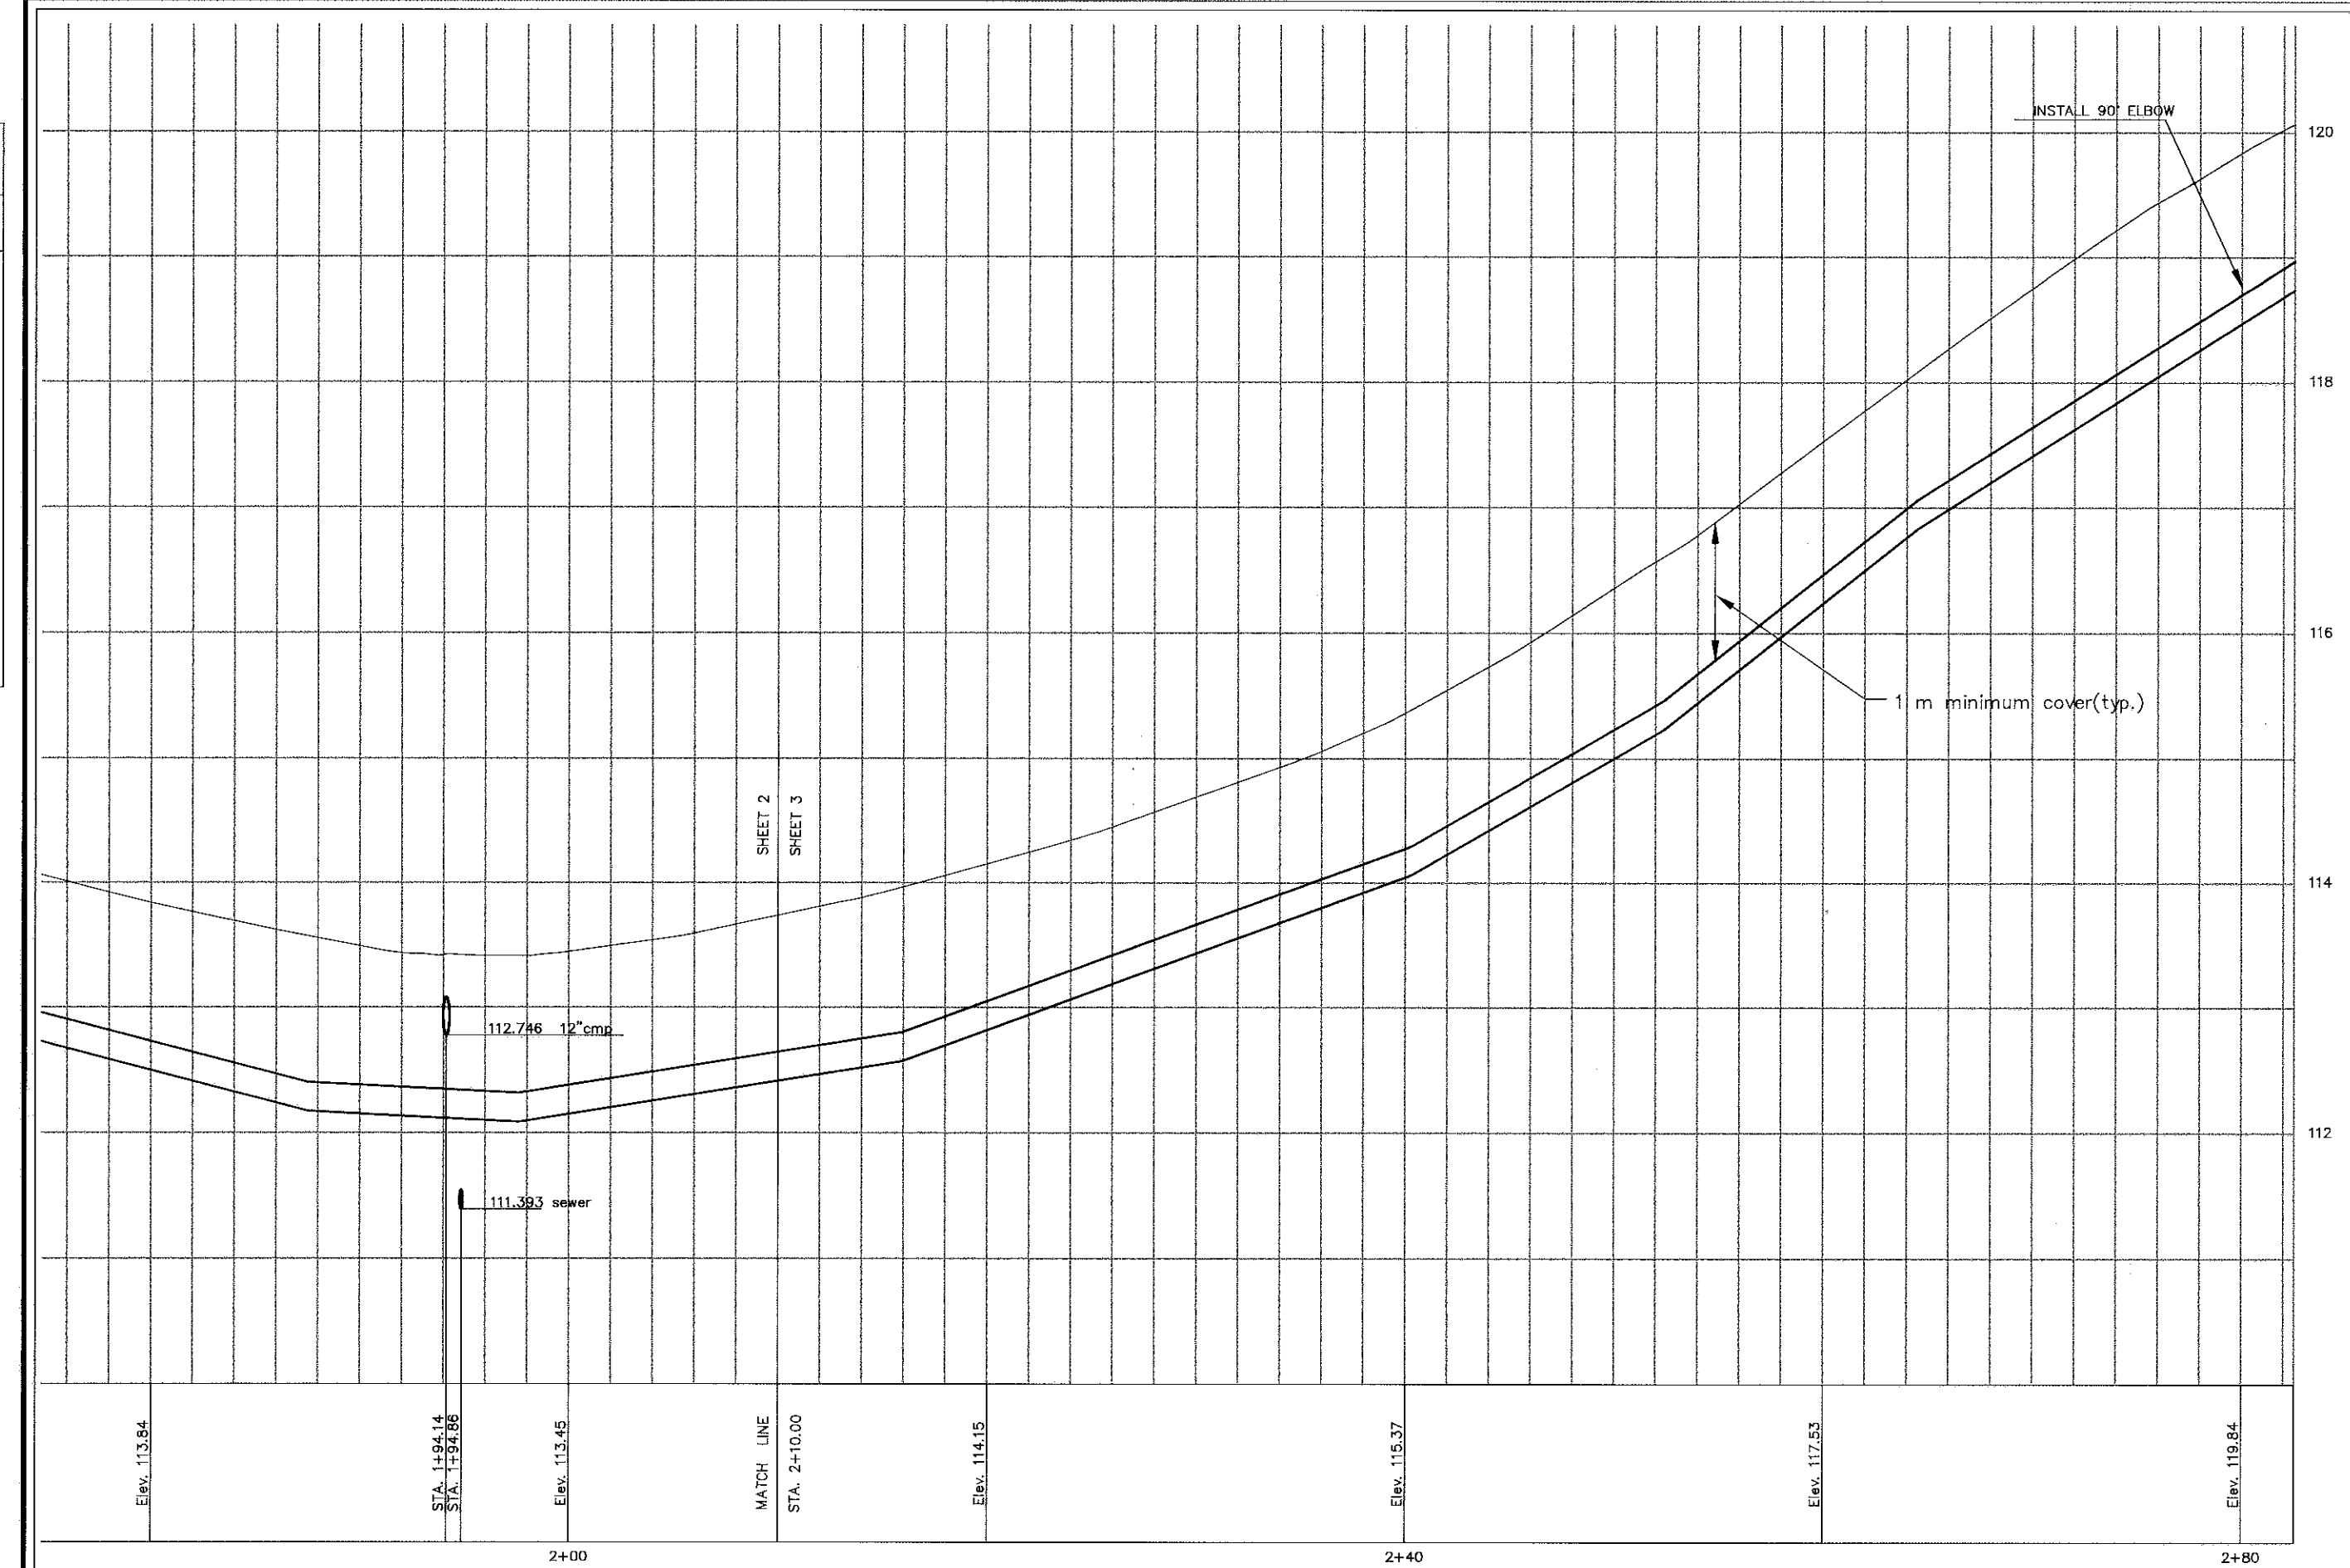

Stationing along proposed water line

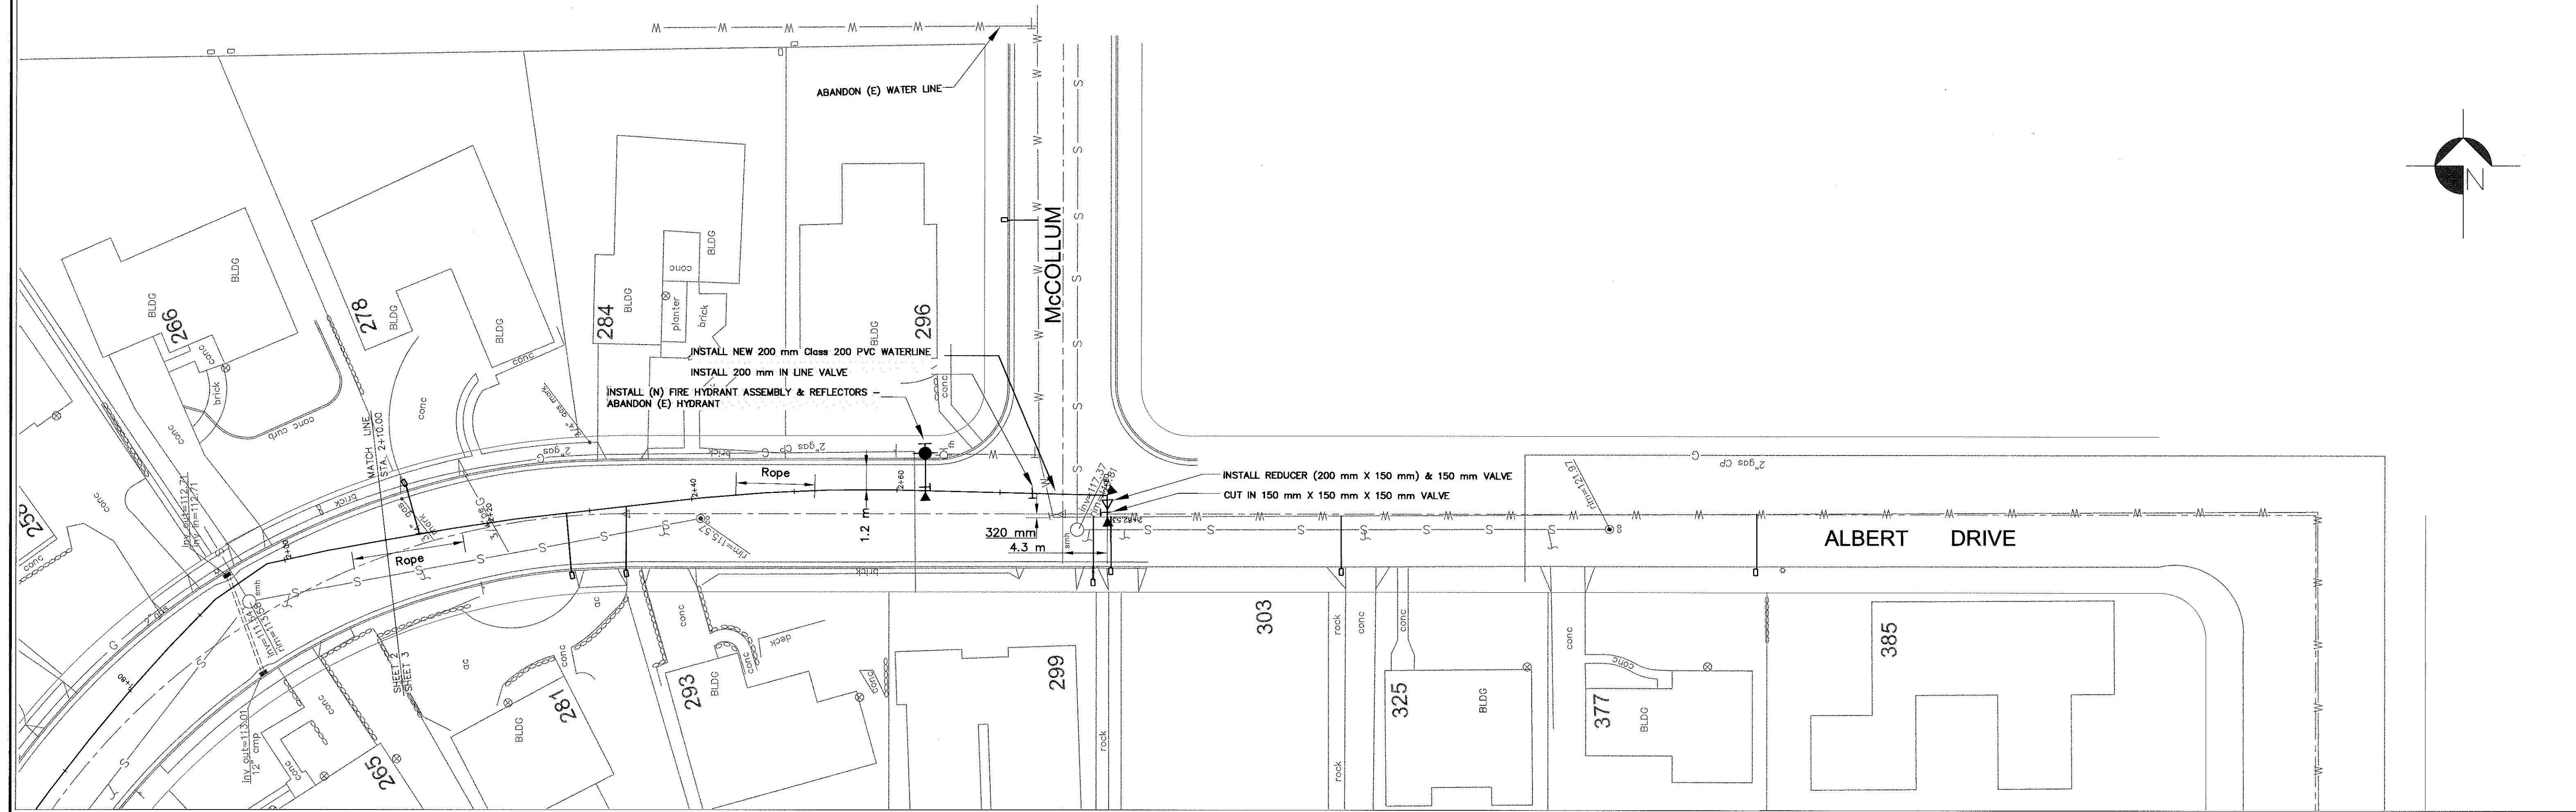

ALBERT, CHAPLIN & SLACK WATER MAINS
SUBTITLE


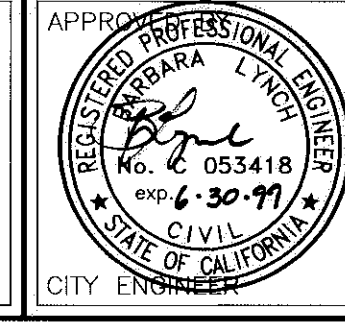


DATE	July 23, 1998
SCALE	1:300
DESIGNED BY	R. J.
DRAWN BY	S. R.
CHECKED BY	B. L.
APPROVED BY	<i>[Signature]</i>
UTILITIES DEPARTMENT	


ALBERT DRIVE
PLAN & PROFILE

SPECIFICATION NO.	98-79
FILE NO./LOCATION	
SHEET	3 of 8

NATURE / STATUS OF PLANS	BY	DATE

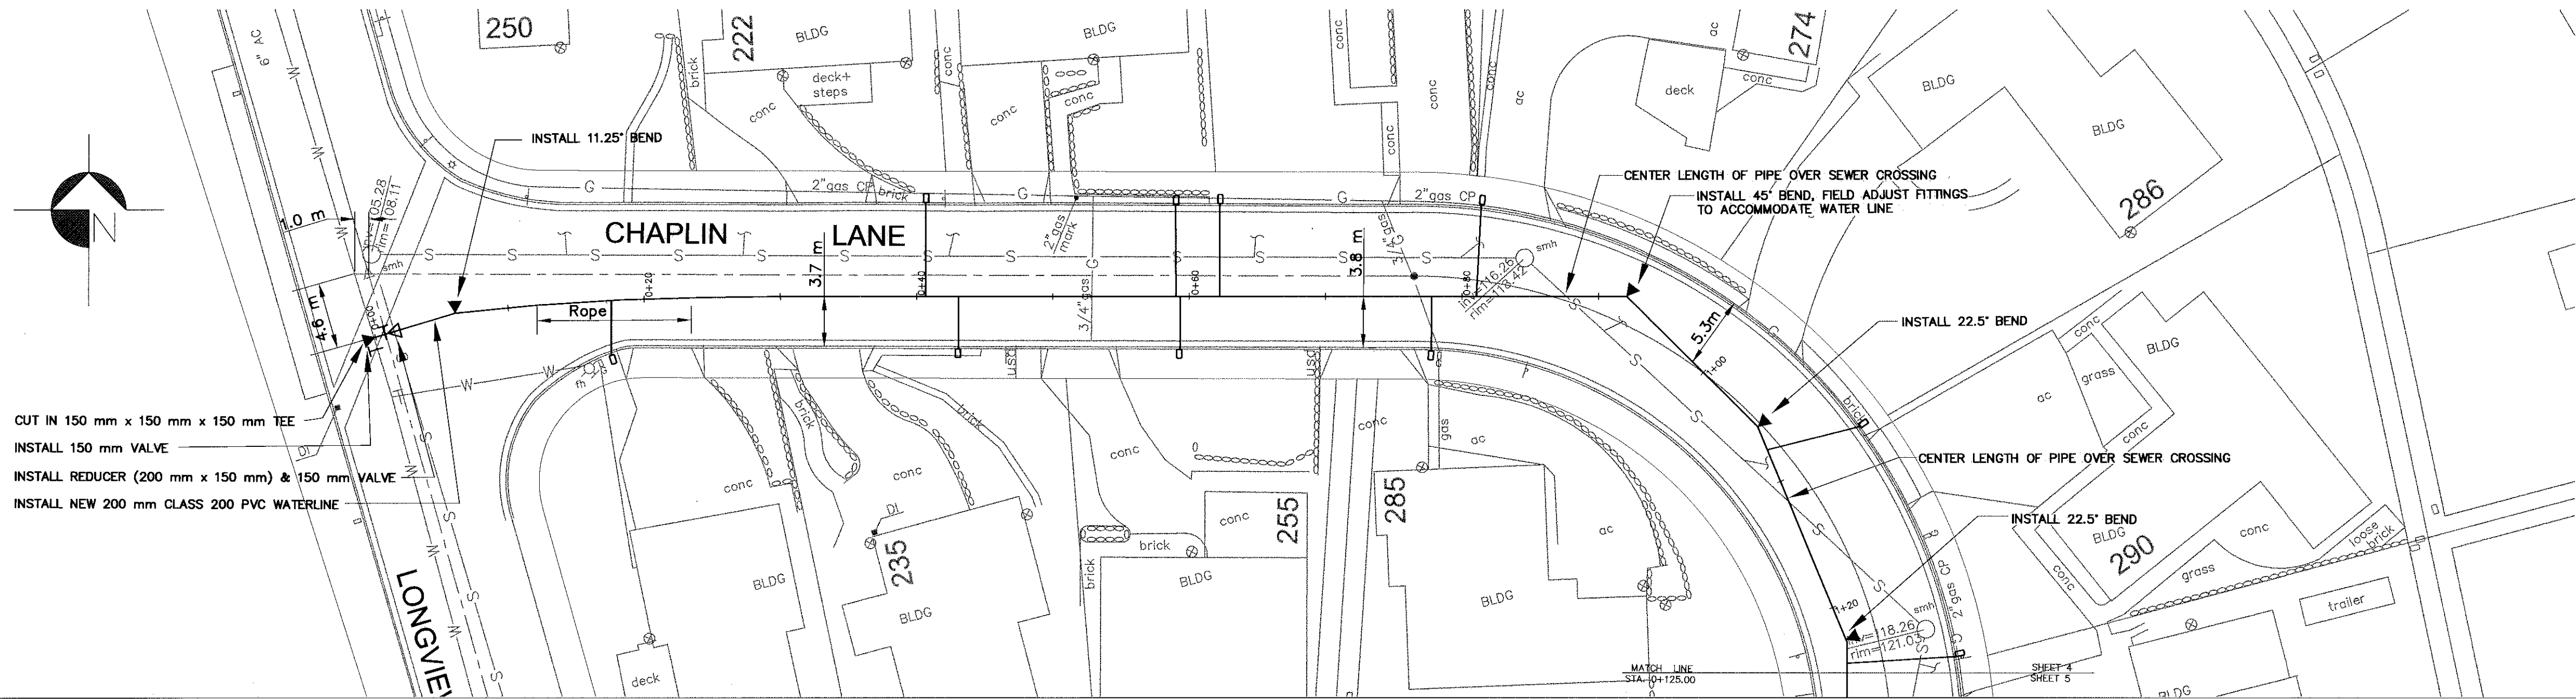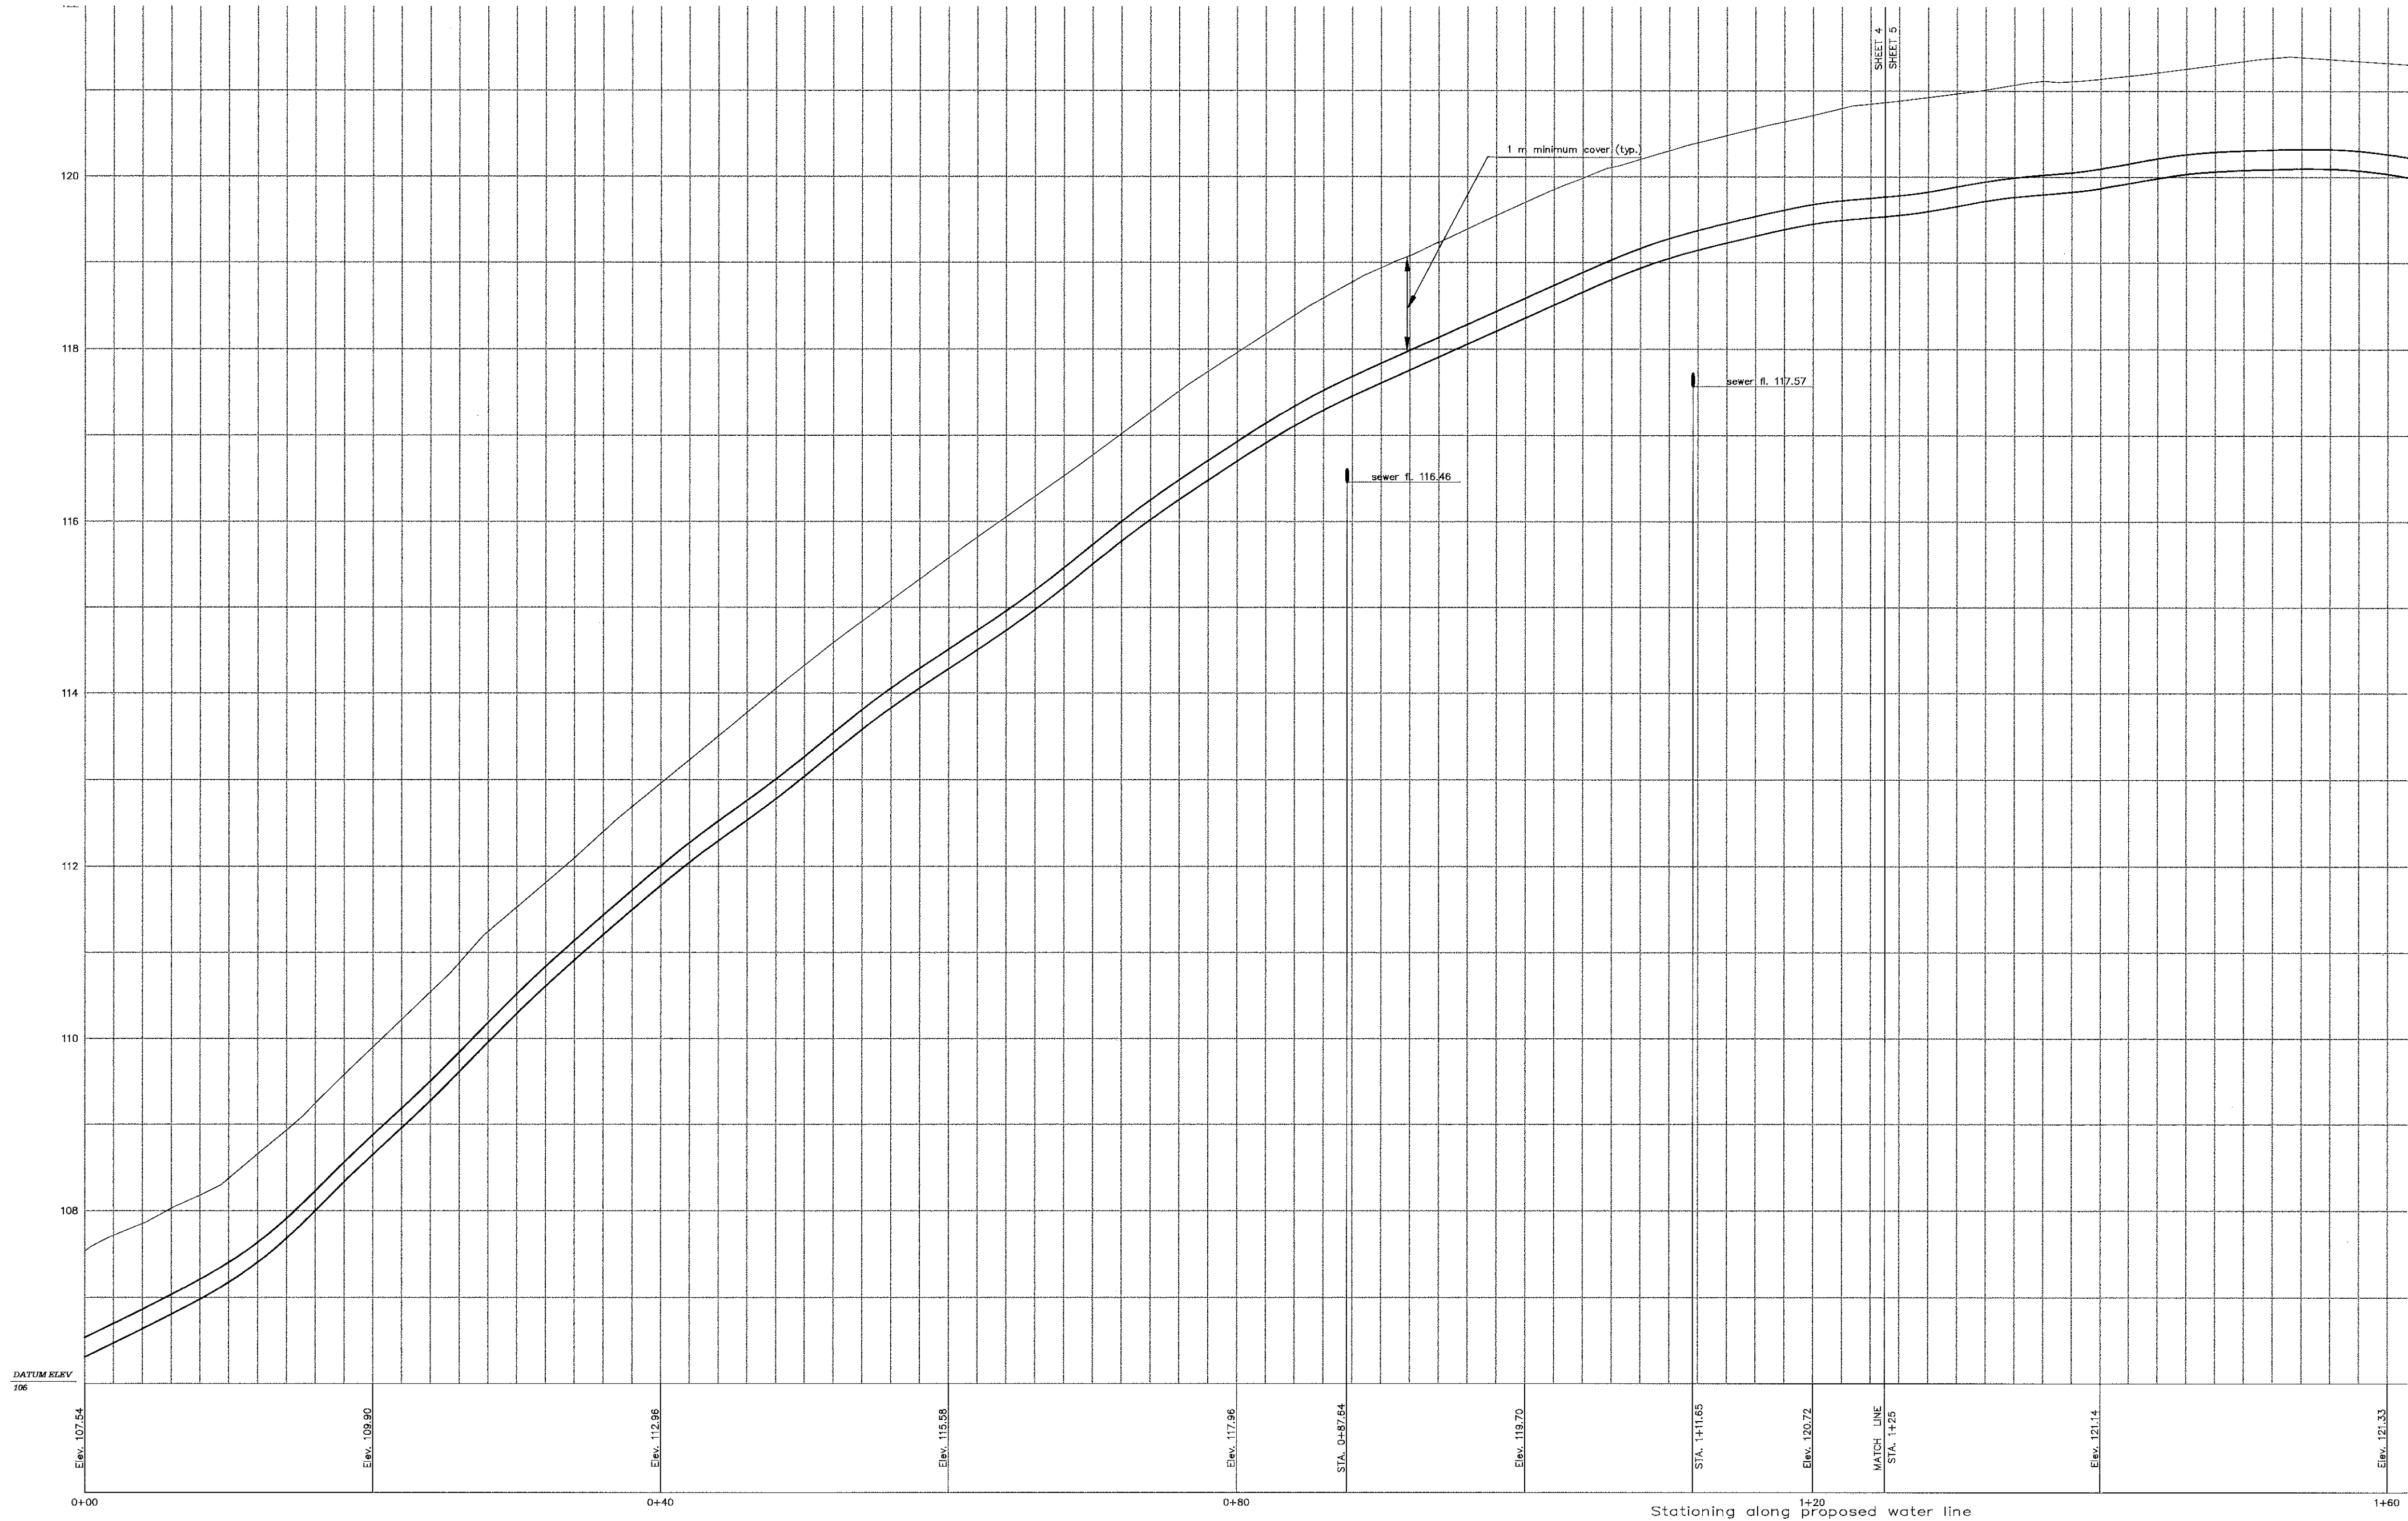



ALBERT, CHAPLIN & SLACK WATER MAINS

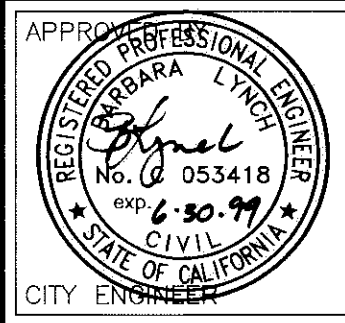


DATE	July 23, 1998
SCALE	1:300
DESIGNED BY	R. J.
DRAWN BY	S. R.
CHECKED BY	B. L.
APPROVED BY	<i>[Signature]</i>
CITY ENGINEER	UTILITIES DEPARTMENT

CHAPLIN LANE
PLAN & PROFILE

SPECIFICATION NO.	98-79
FILE NO./LOCATION	
SHEET	4 of 8

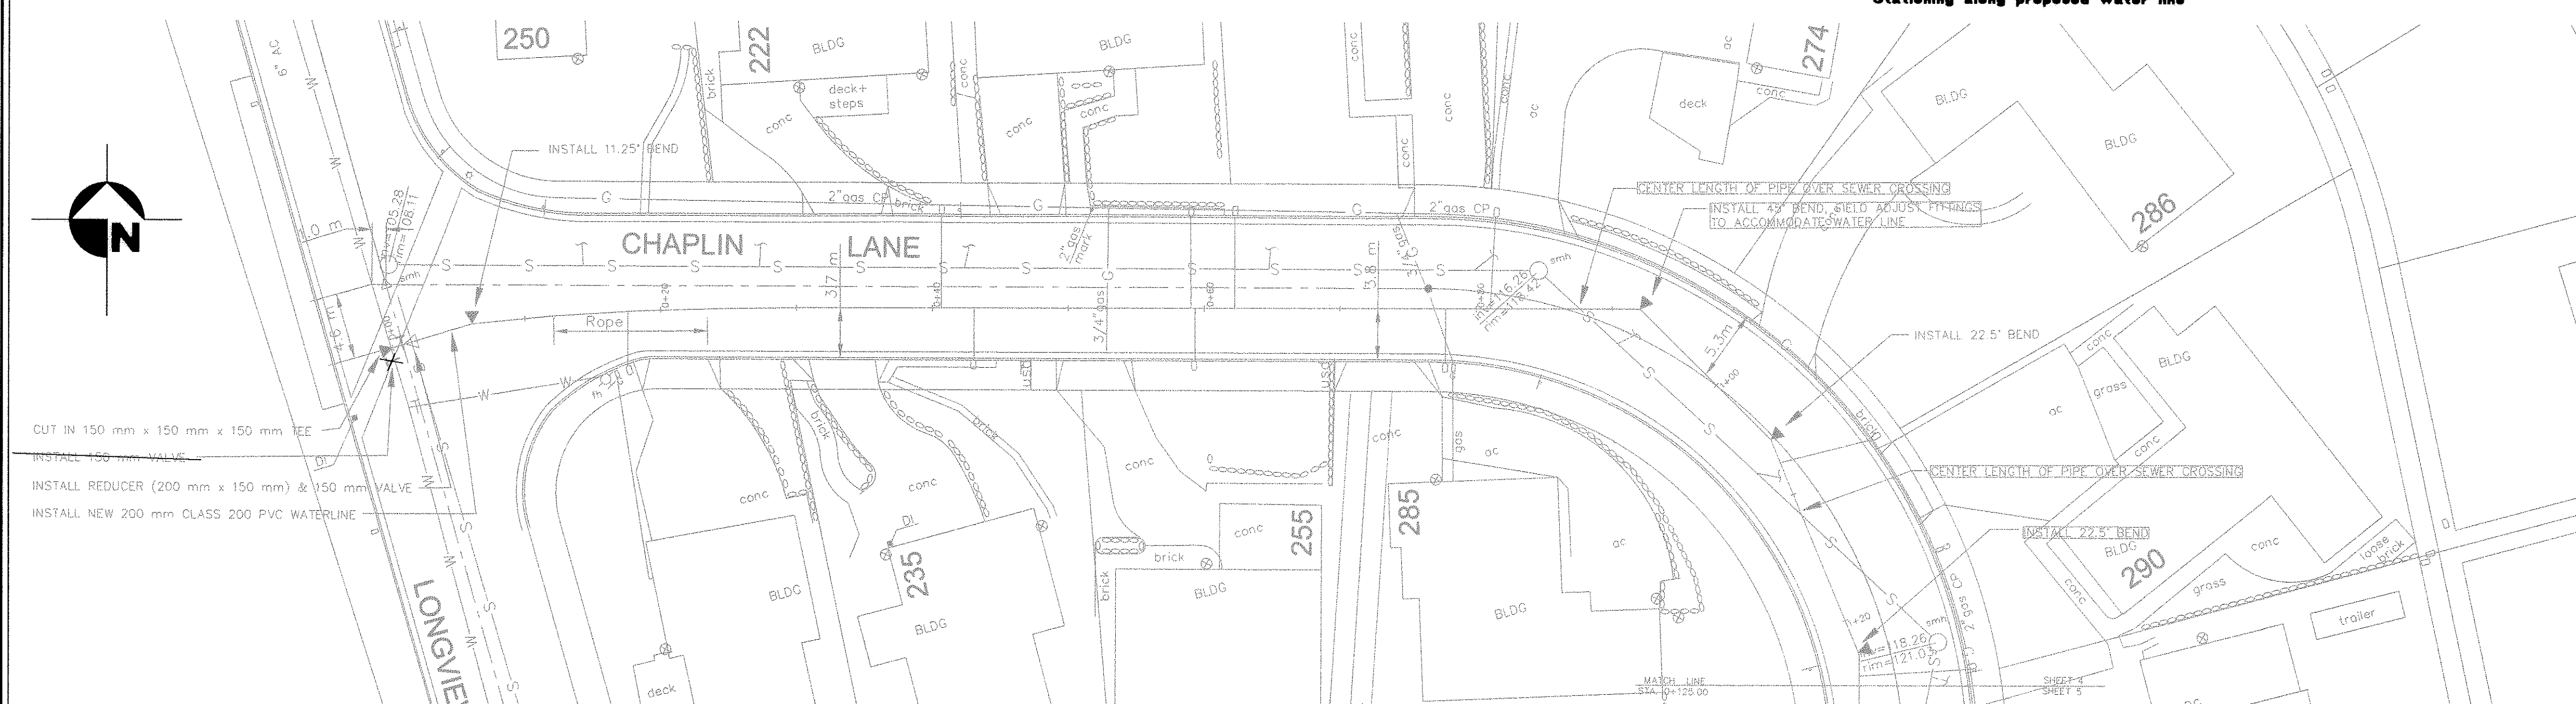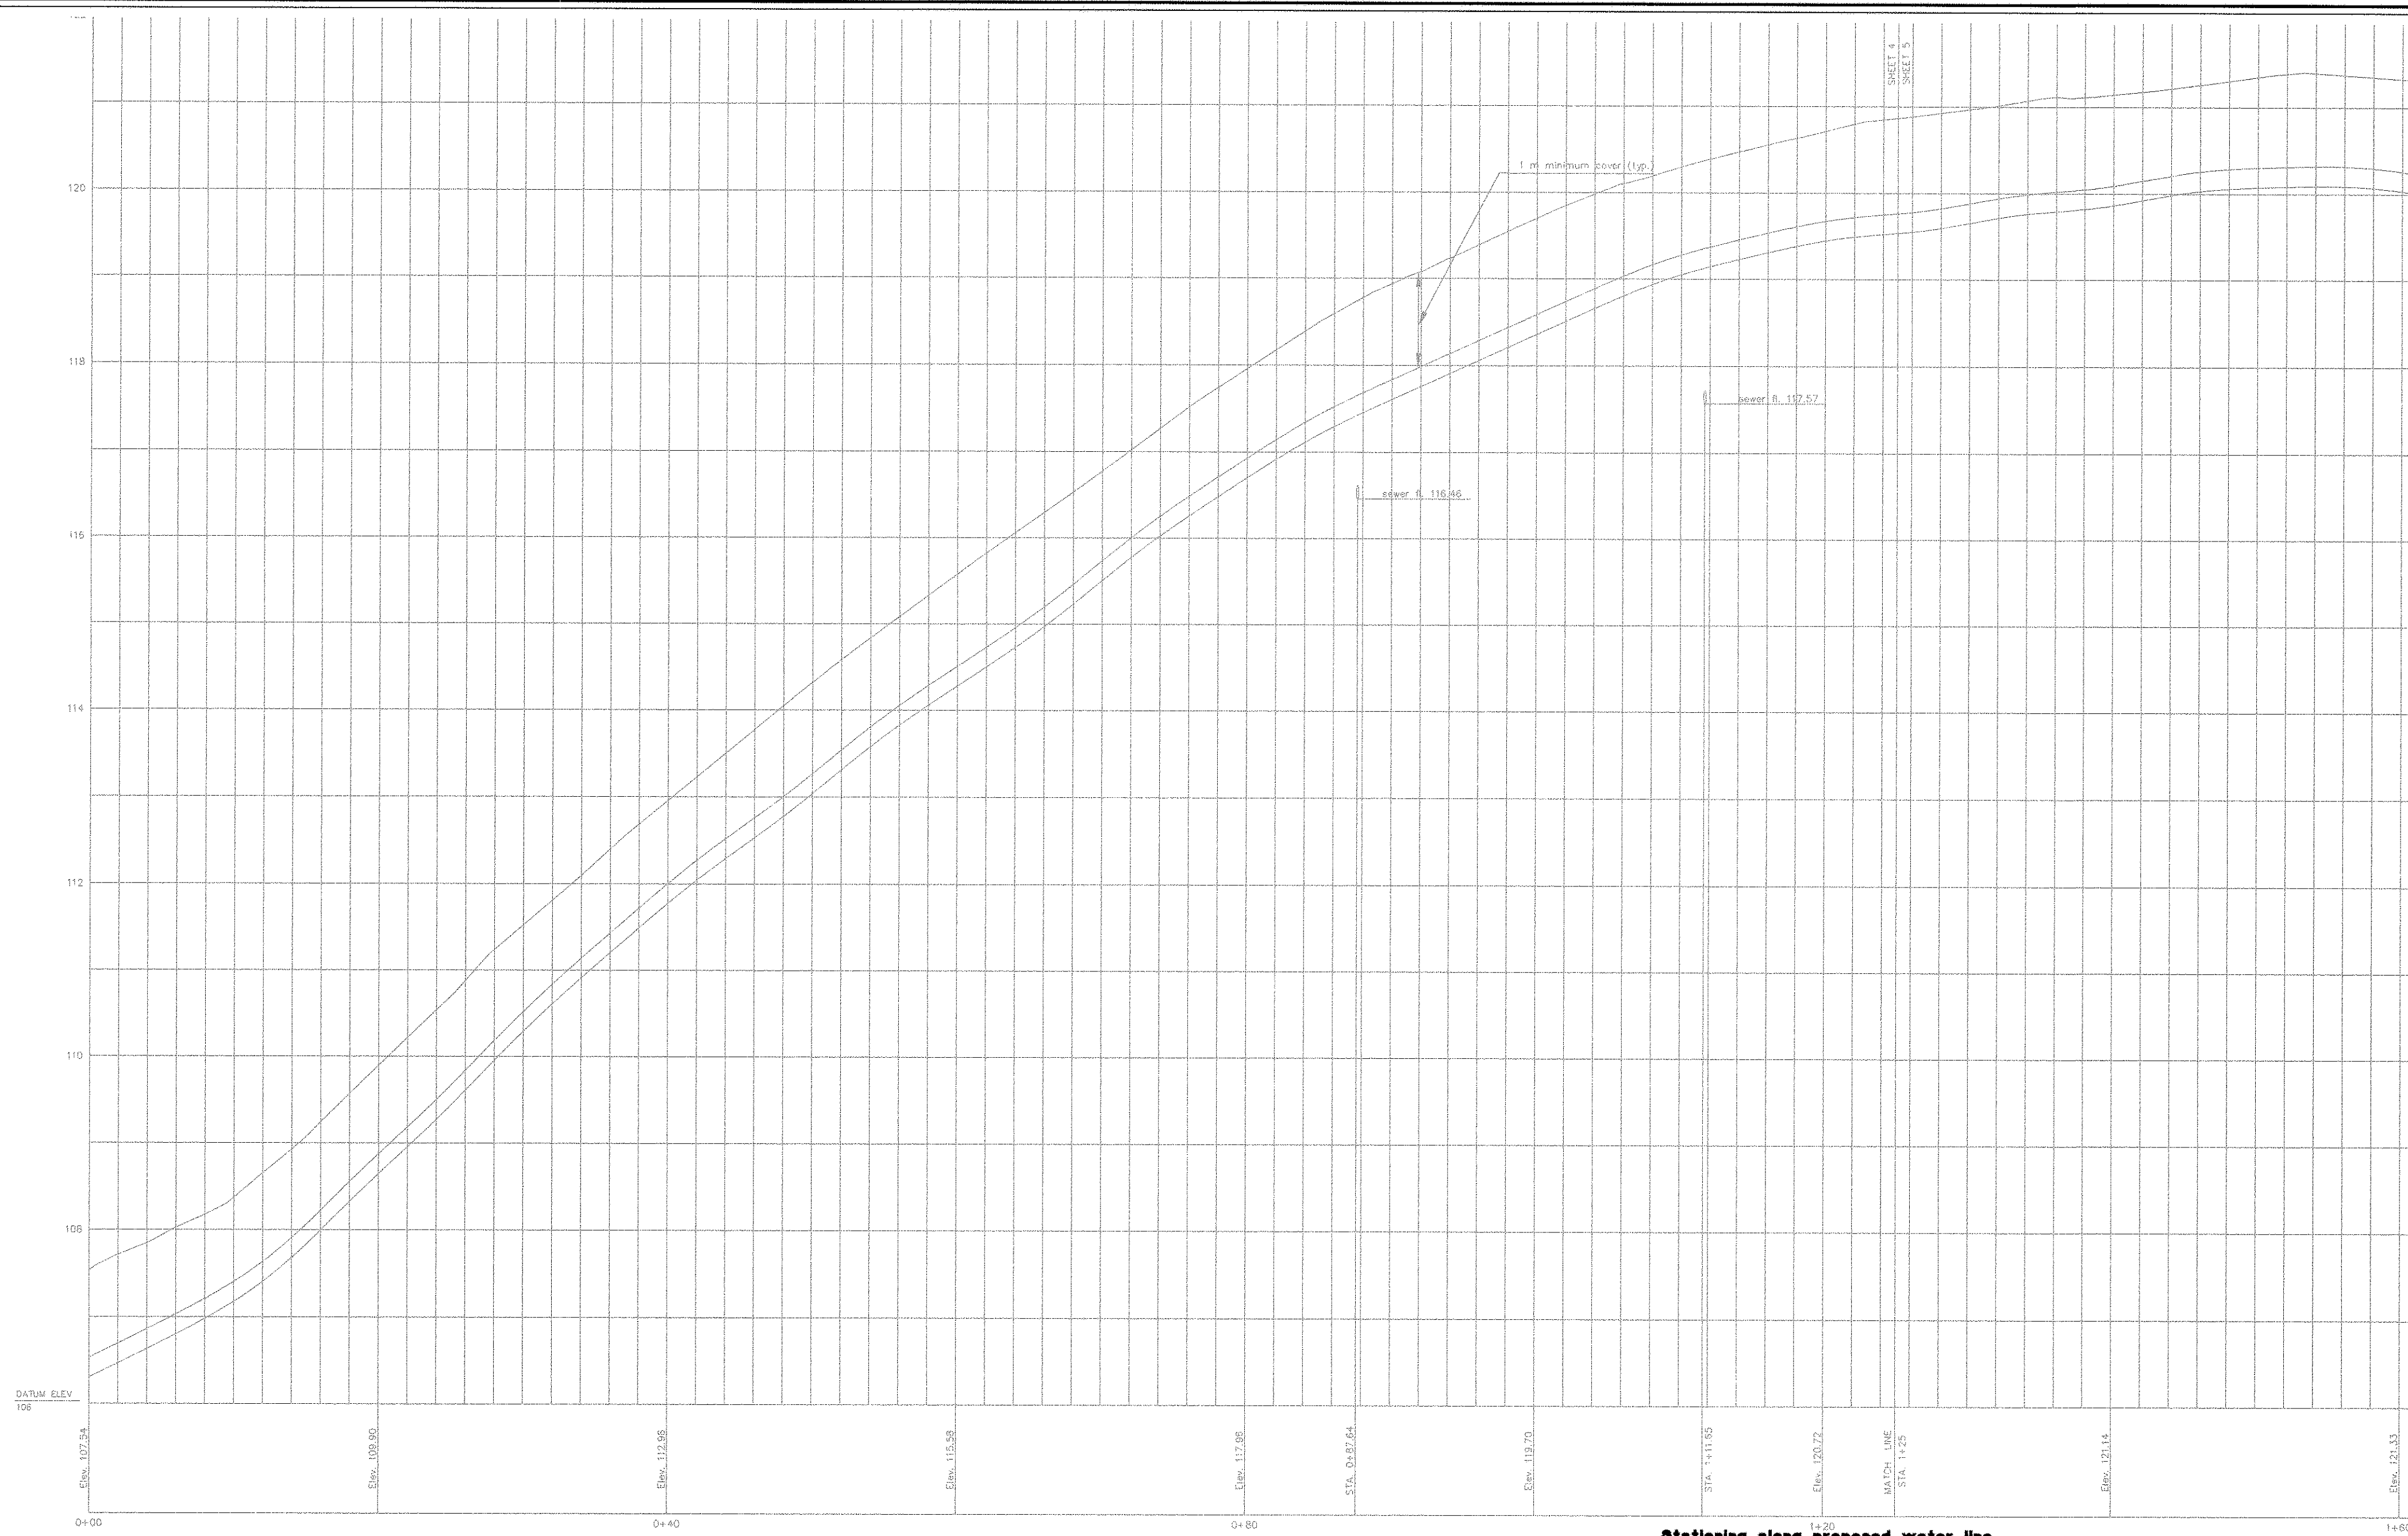
[illegible]

RECORD DRAWING
DATE: 1/28/02 BY: SR

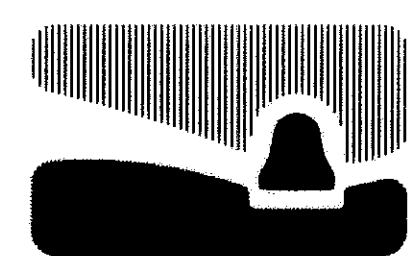

city of san luis obispo

ALBERT, CHAPLIN & SLACK
WATER MAINS

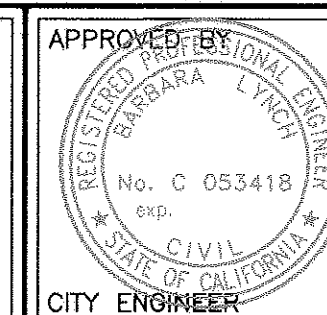

DATE	July 23, 1998
SCALE	1:300
DESIGNED BY	R. J.
DRAWN BY	S. R.
CHECKED BY	B. L.
APPROVED BY	
UTILITIES DEPARTMENT	



CHAPLIN LANE PLAN & PROFILE


SPECIFICATION NO.
98-79

FILE NO./LOCATION

SHEET
4A OF 8

NATURE / STATUS OF PLANS	BY	DATE

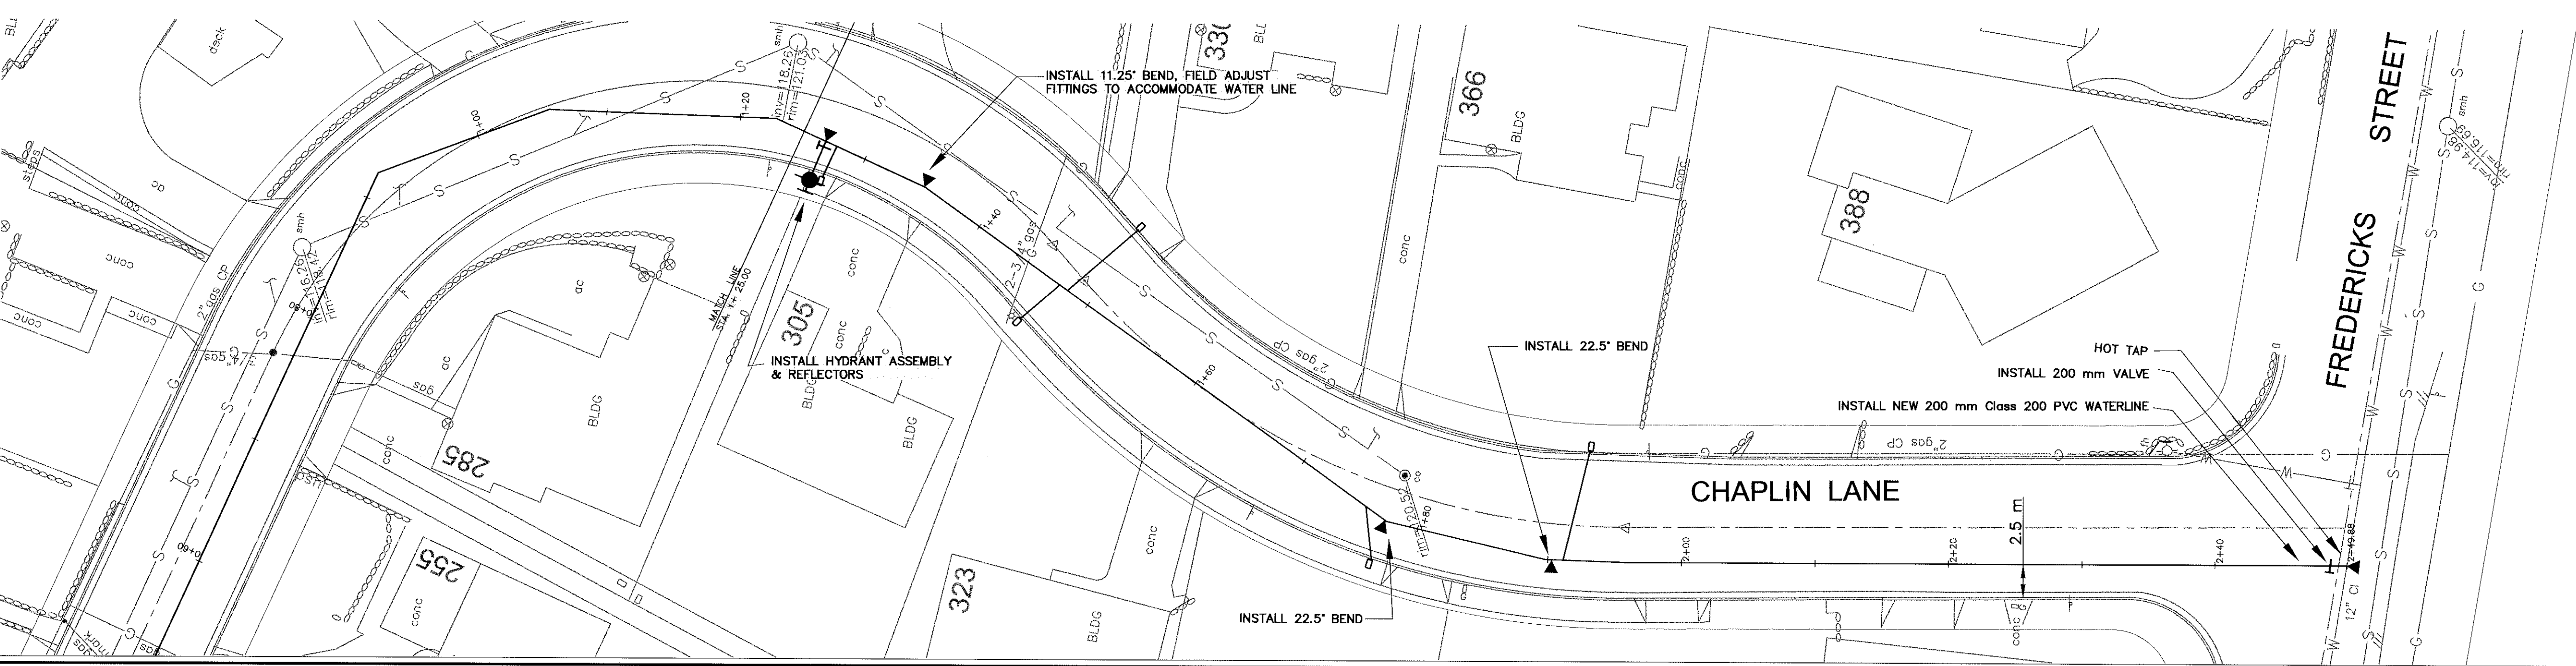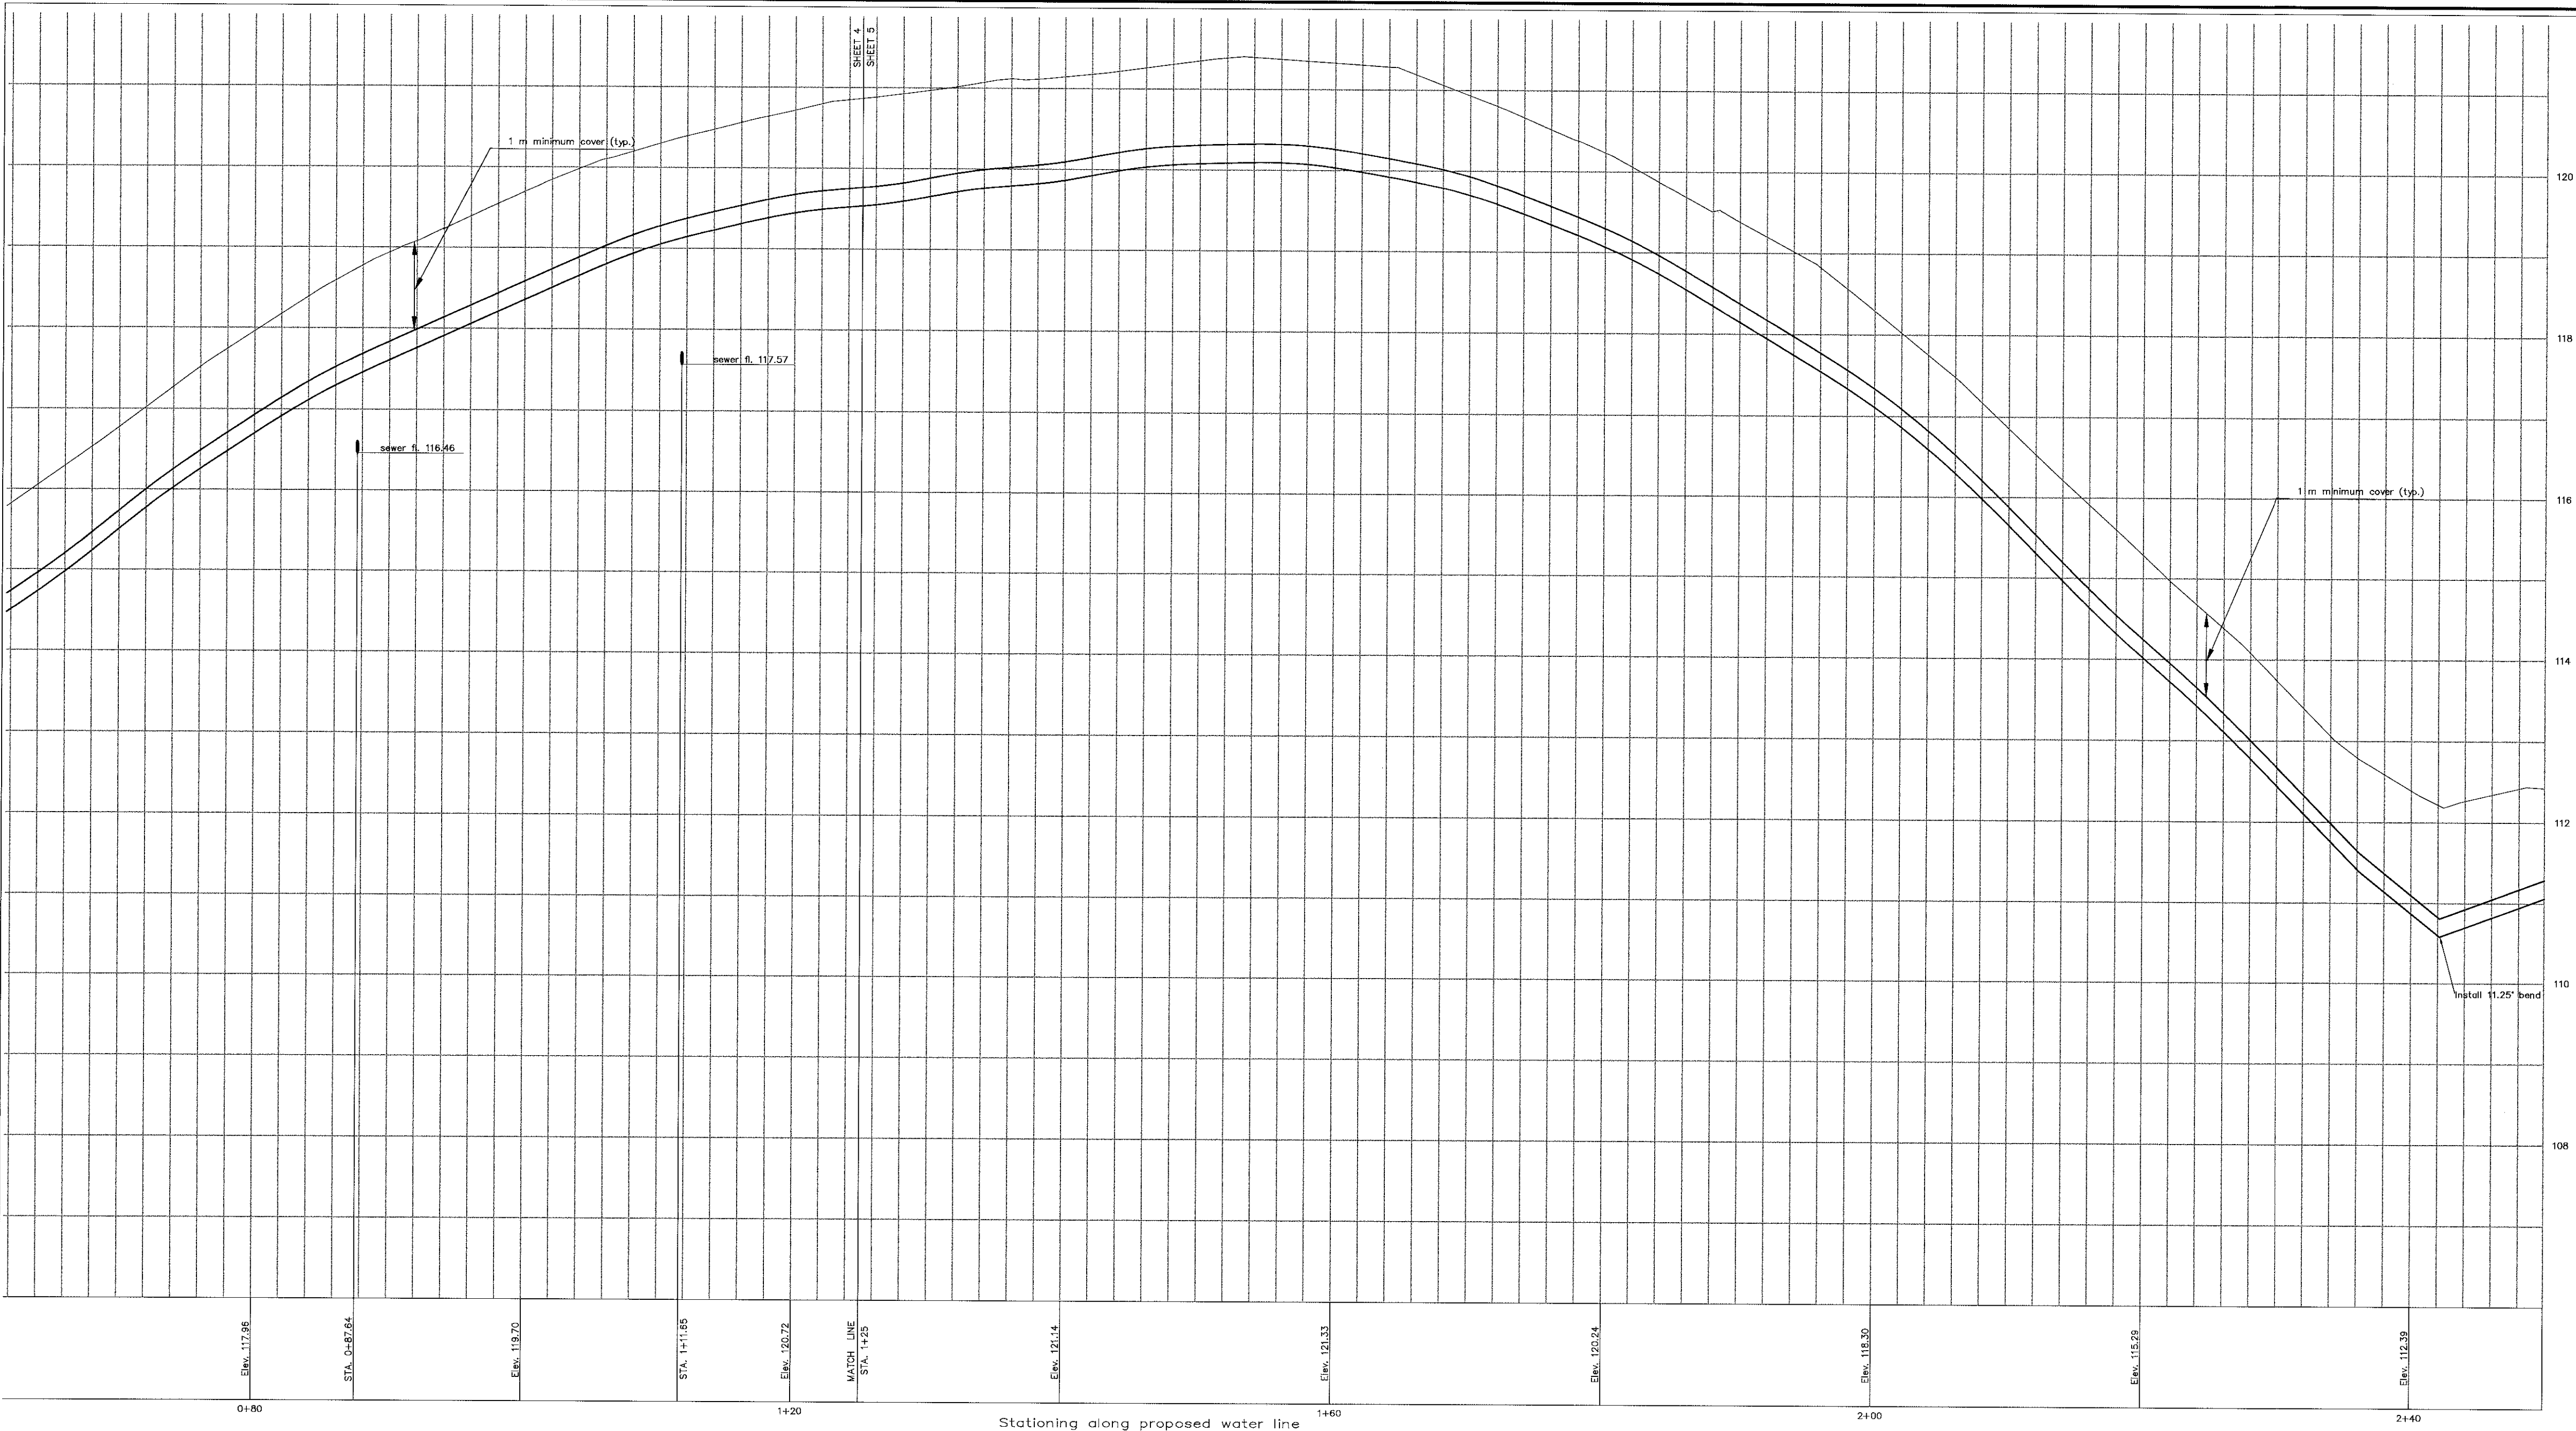

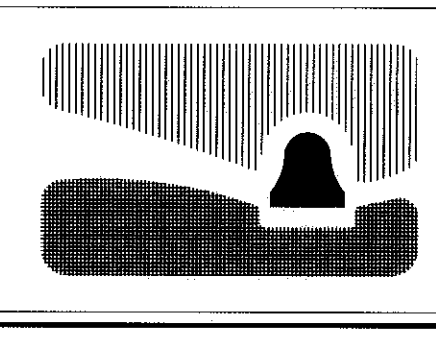

city of san luis obispo

ALBERT, CHAPLIN & SLACK WATER MAINS

APPROVED

REGISTERED PROFESSIONAL ENGINEER

BARBARA L. LYNN

No. 053418

exp. 6-30-99

CITY ENGINEER

DATE July 23, 1998

SCALE 1:300

DESIGNED BY R. J.

DRAWN BY S. R.

CHECKED BY B. L.

APPROVED BY

UTILITIES DEPARTMENT




CHAPLIN LANE
PLAN & PROFILE

SPECIFICATION NO.
98-79


FILE NO./LOCATION

SHEET
5 of 8

NATURE / STATUS OF PLANS	BY	DATE

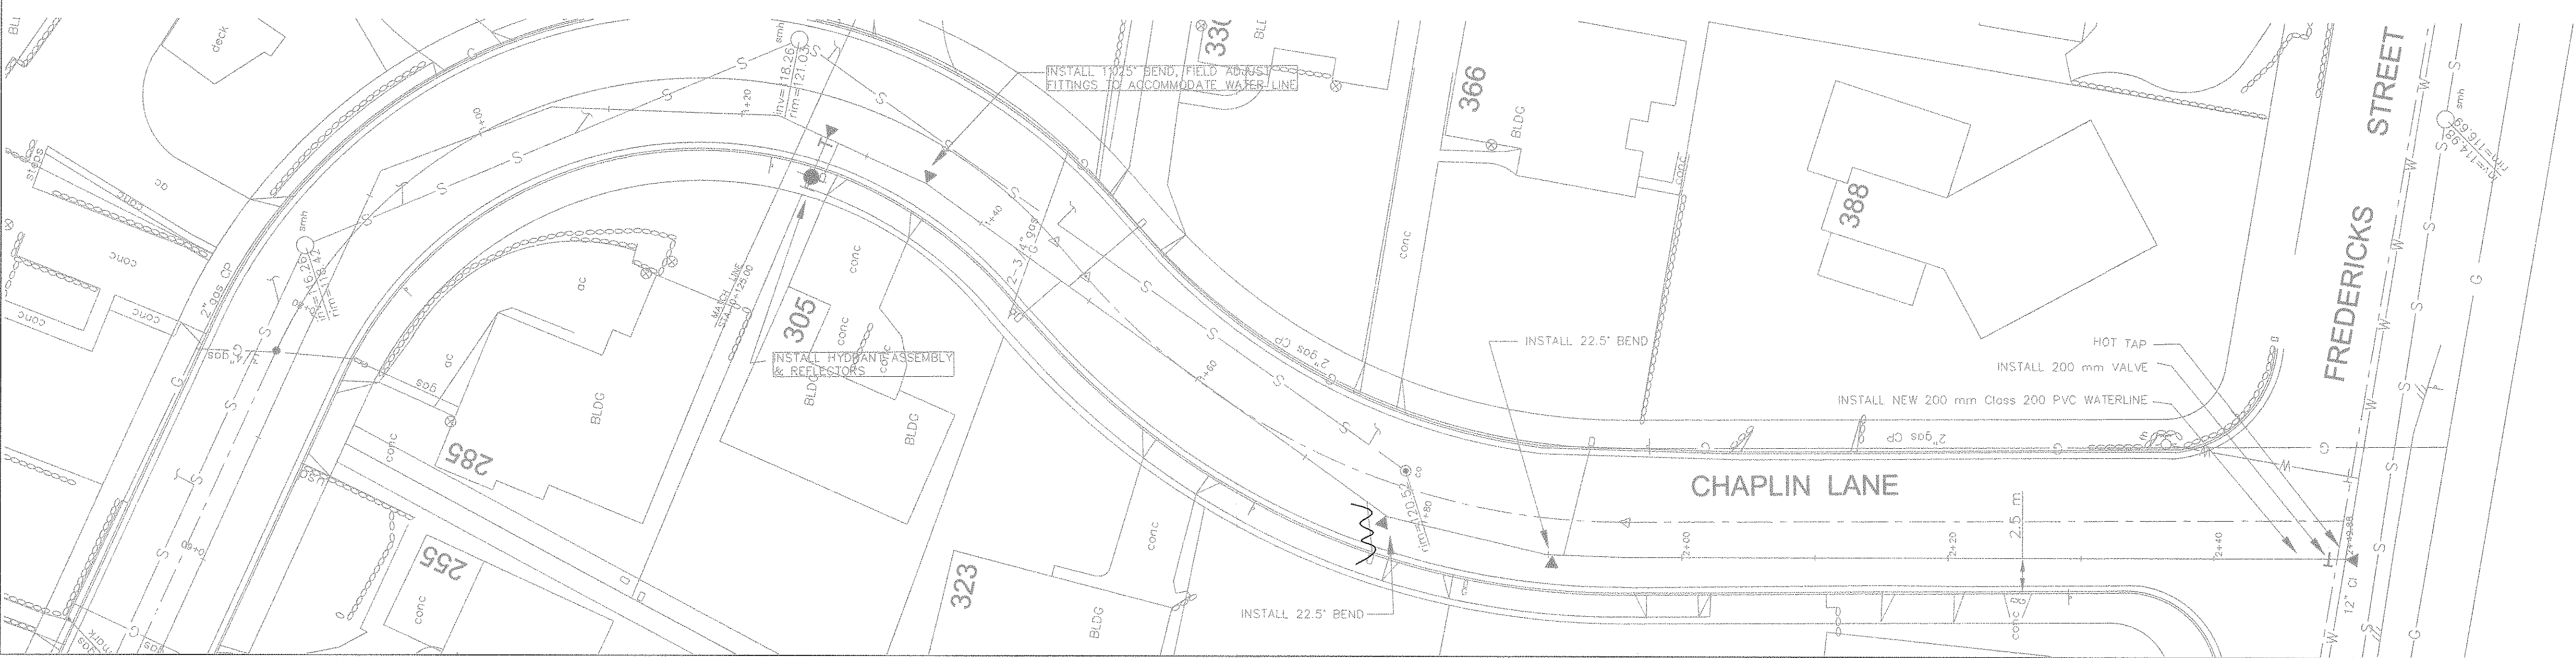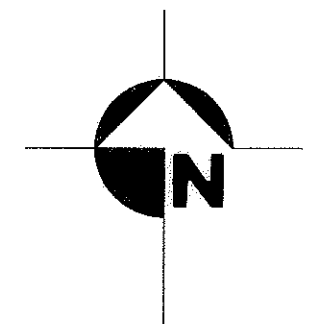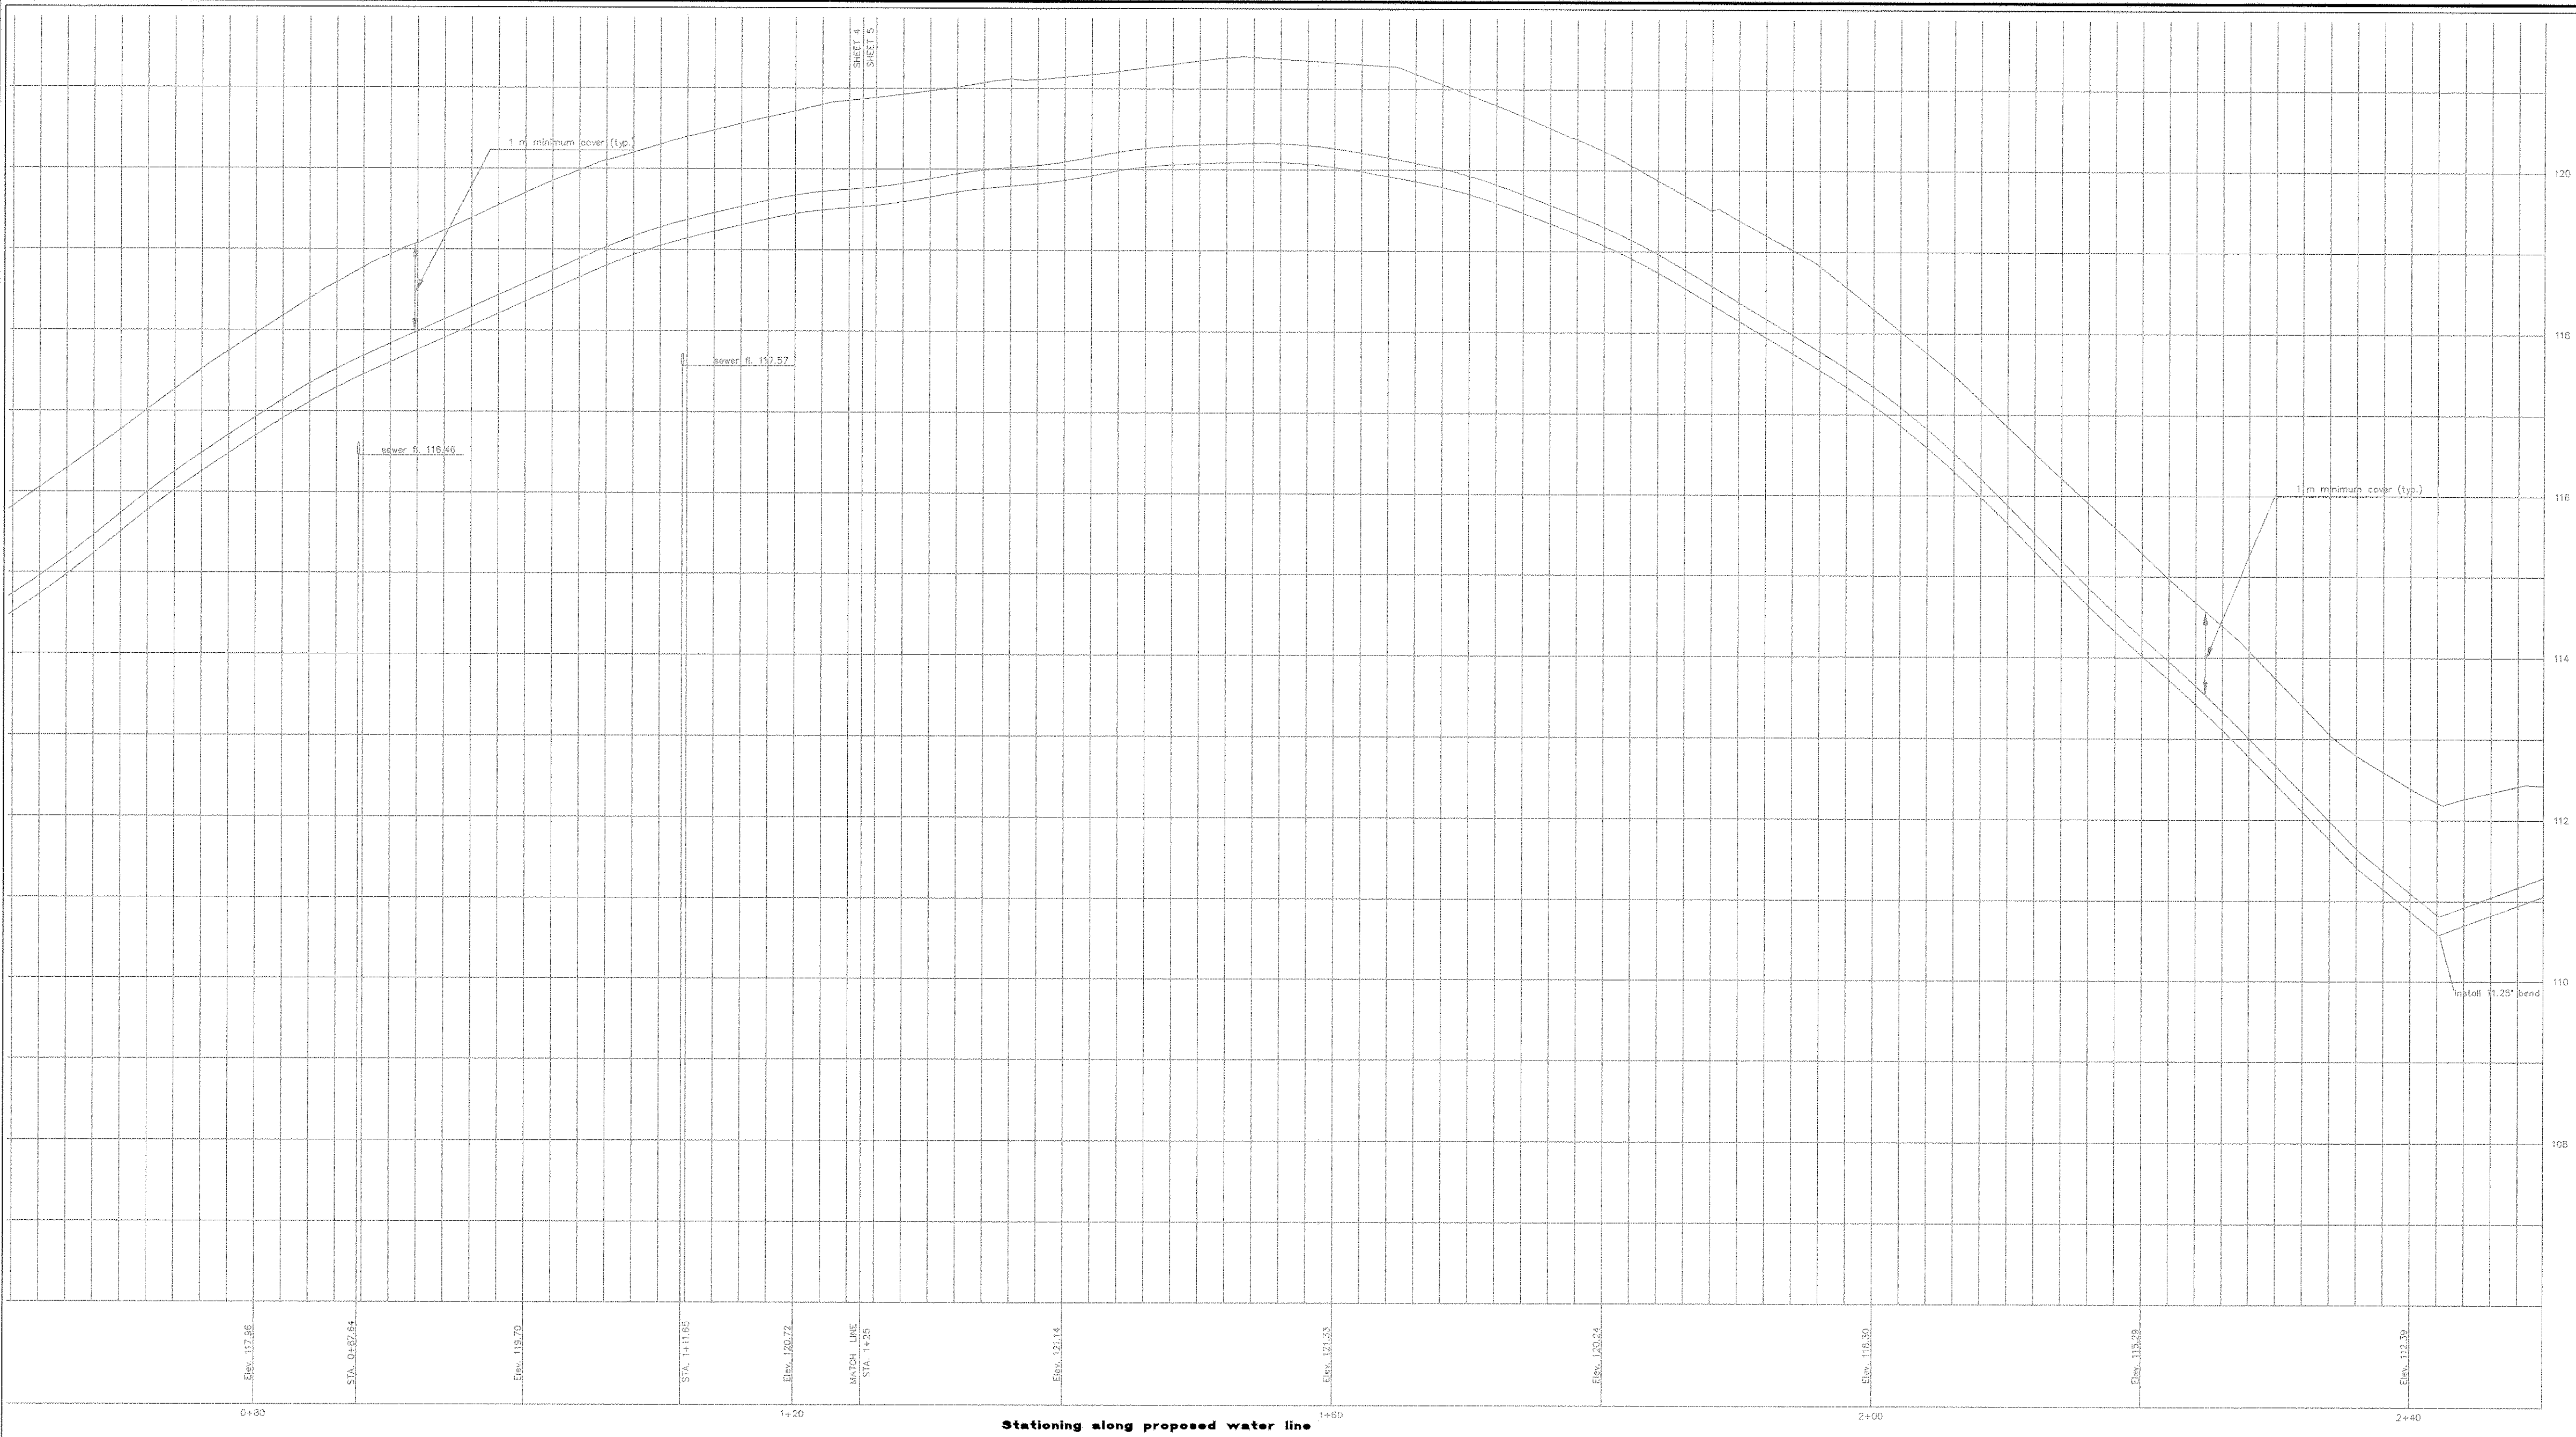

RECORD DRAWING
DATE: 1/28/98 BY: [signature]

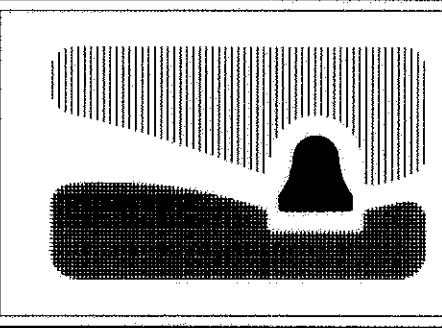

city of san luis obispo

ALBERT, CHAPLIN & SLACK WATER MAINS

APPROVED BY: [signature]
CITY ENGINEER

DATE: July 23, 1998
SCALE: 1:300
DESIGNED BY: R. J.
DRAWN BY: S. R.
CHECKED BY: B. L.
APPROVED BY: [signature]
UTILITIES DEPARTMENT

CHAPLIN LANE
PLAN & PROFILE


SPECIFICATION NO.
98-79

FILE NO./LOCATION




SHEET
5A OF 8

Profile view of a proposed water line. The horizontal axis represents stationing along the proposed water line, ranging from 0+00 to 2+00. The vertical axis represents elevation in meters, ranging from 106 to 114. The profile shows a proposed water line (solid line) and an existing water line (dashed line). A 1 m minimum cover (typ.) is indicated for the proposed water line. The profile also shows a match line at station 2+42.00 and a station 22.51 bar.

Station	Proposed Elevation (m)	Existing Elevation (m)
0+00	113.52	113.52
0+40	112.50	112.50
0+80	111.46	111.46
1+20	110.72	110.72
1+60	109.89	109.89
2+00	108.32	108.32
2+42.00	107.50	107.50
2+51.00	107.50	107.50

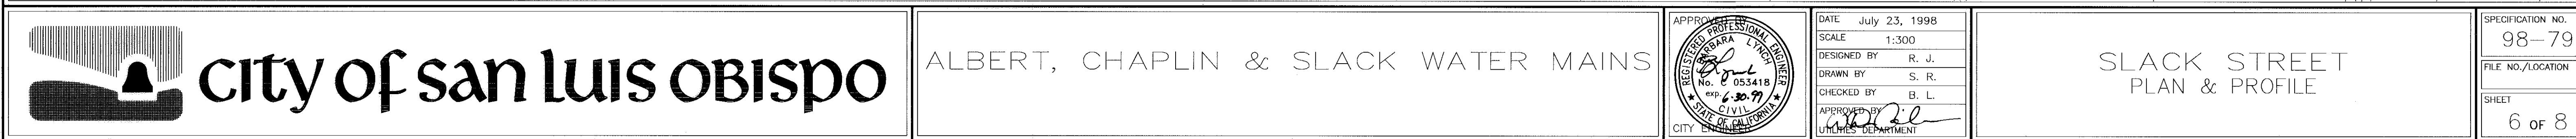


NATURE / STATUS OF PLANS	BY	DATE

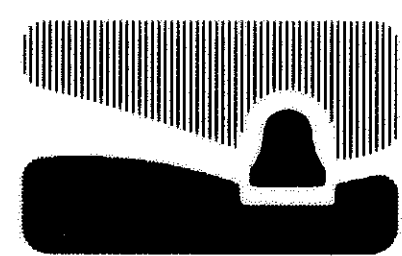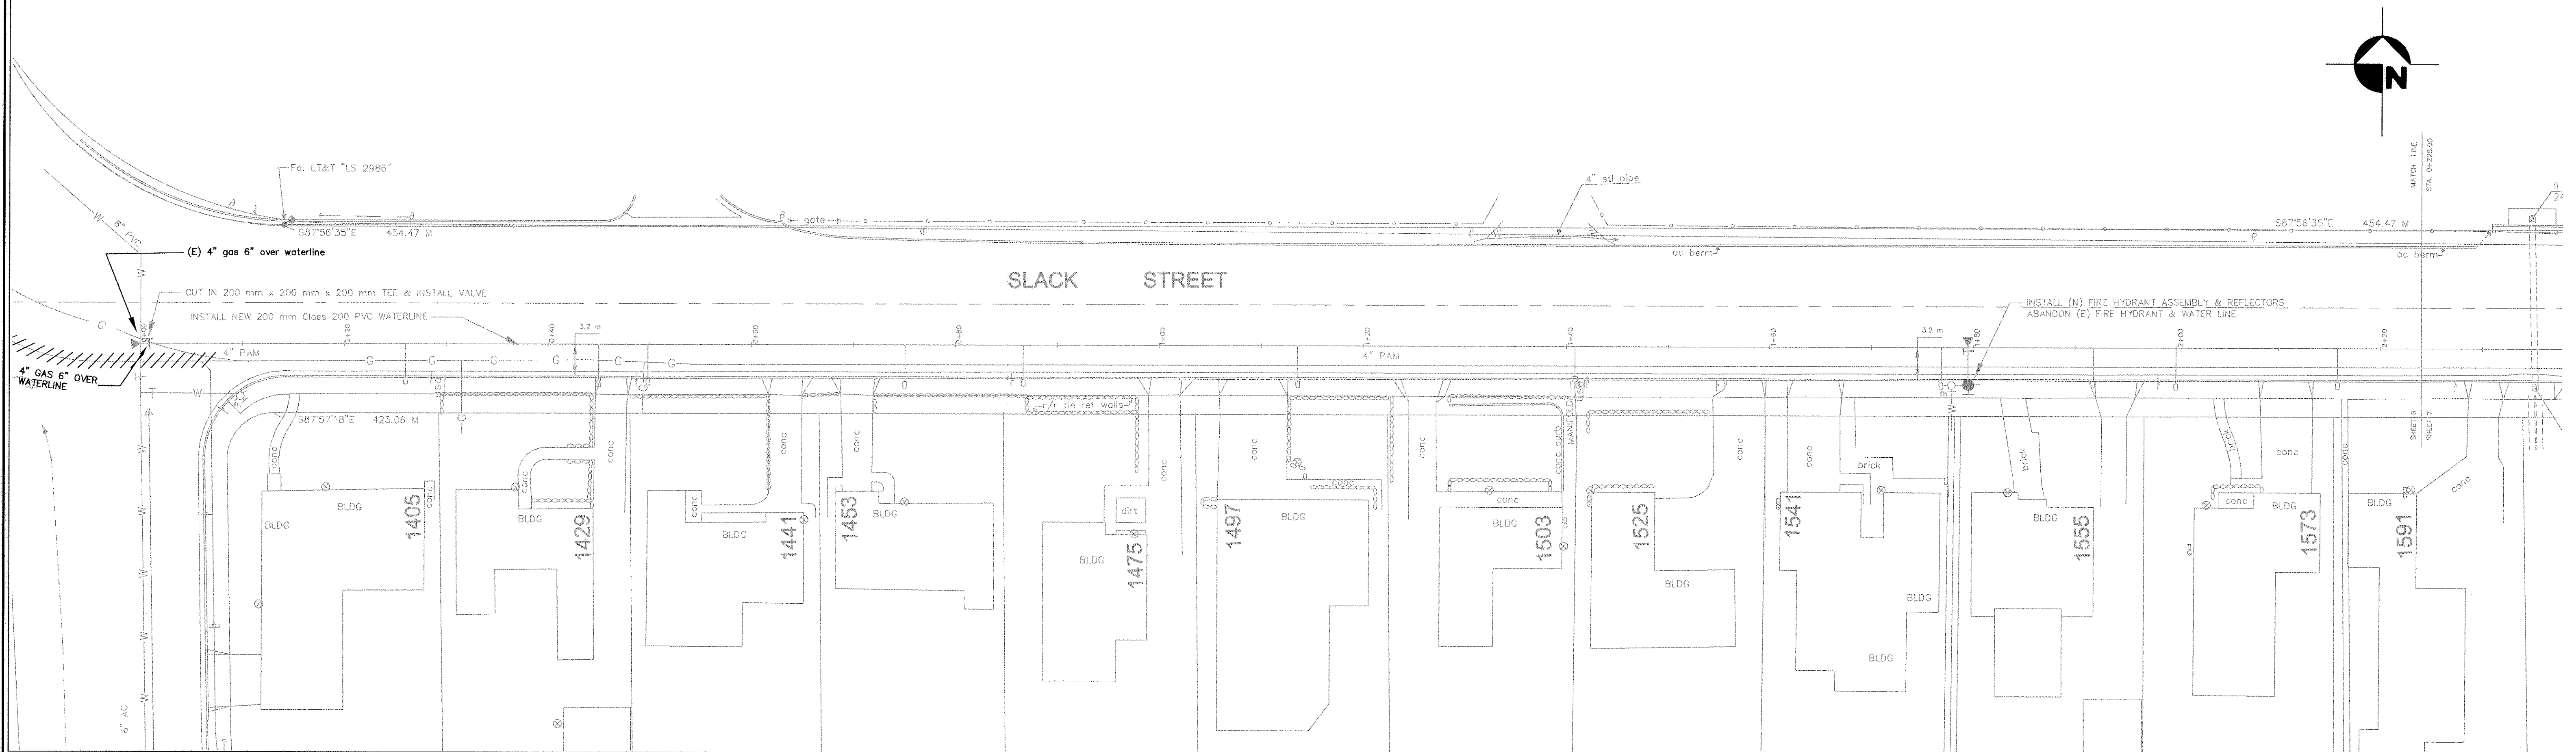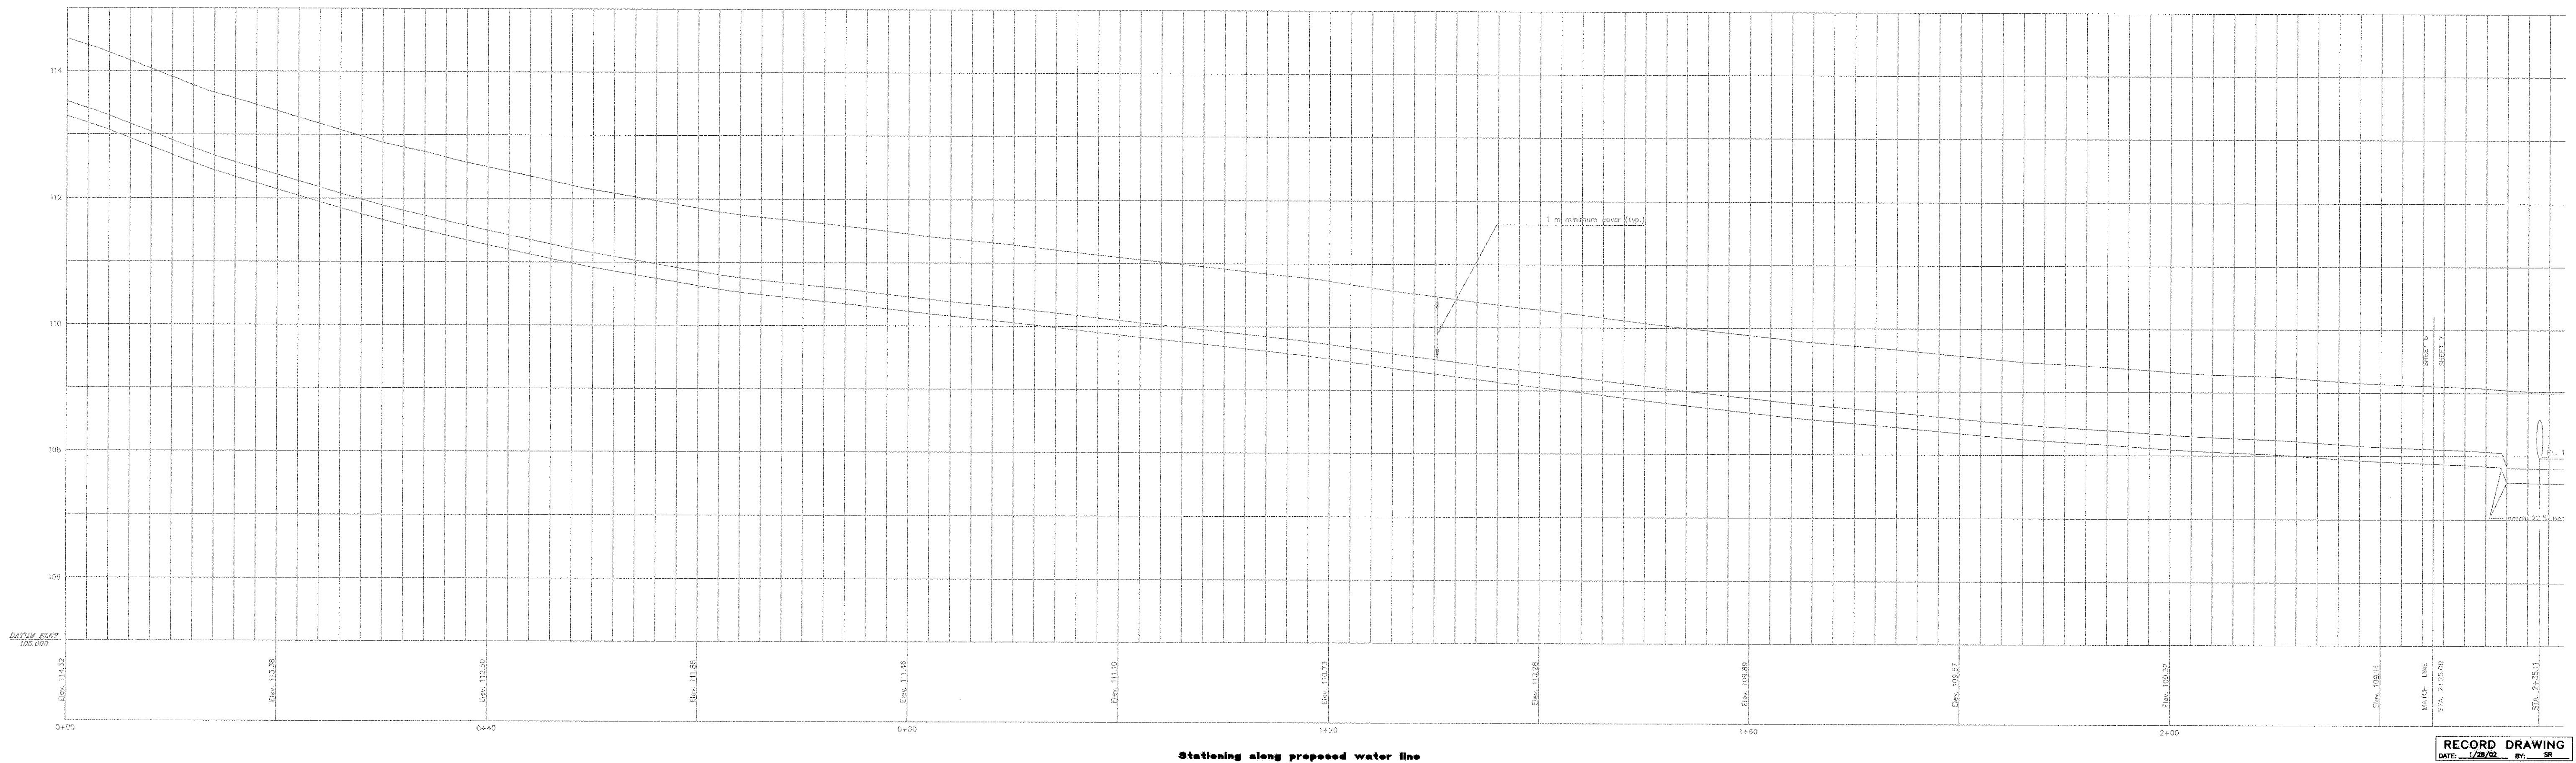

city of san luis obispo

ALBERT, CHAPLIN & SLACK WATER MAINS

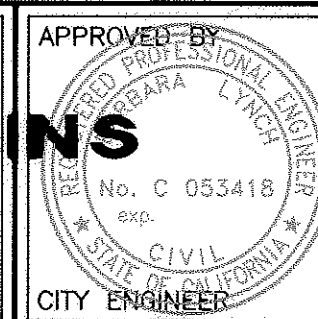



DATE	July 23, 1998
SCALE	1:300
DESIGNED BY	R. J.
DRAWN BY	S. R.
CHECKED BY	B. L.
APPROVED BY	
UTILITIES DEPARTMENT	

SLACK STREET PLAN & PROFILE

SPECIFICATION NO.
98-79

FILE NO./LOCATION

SHEET
6A OF 8

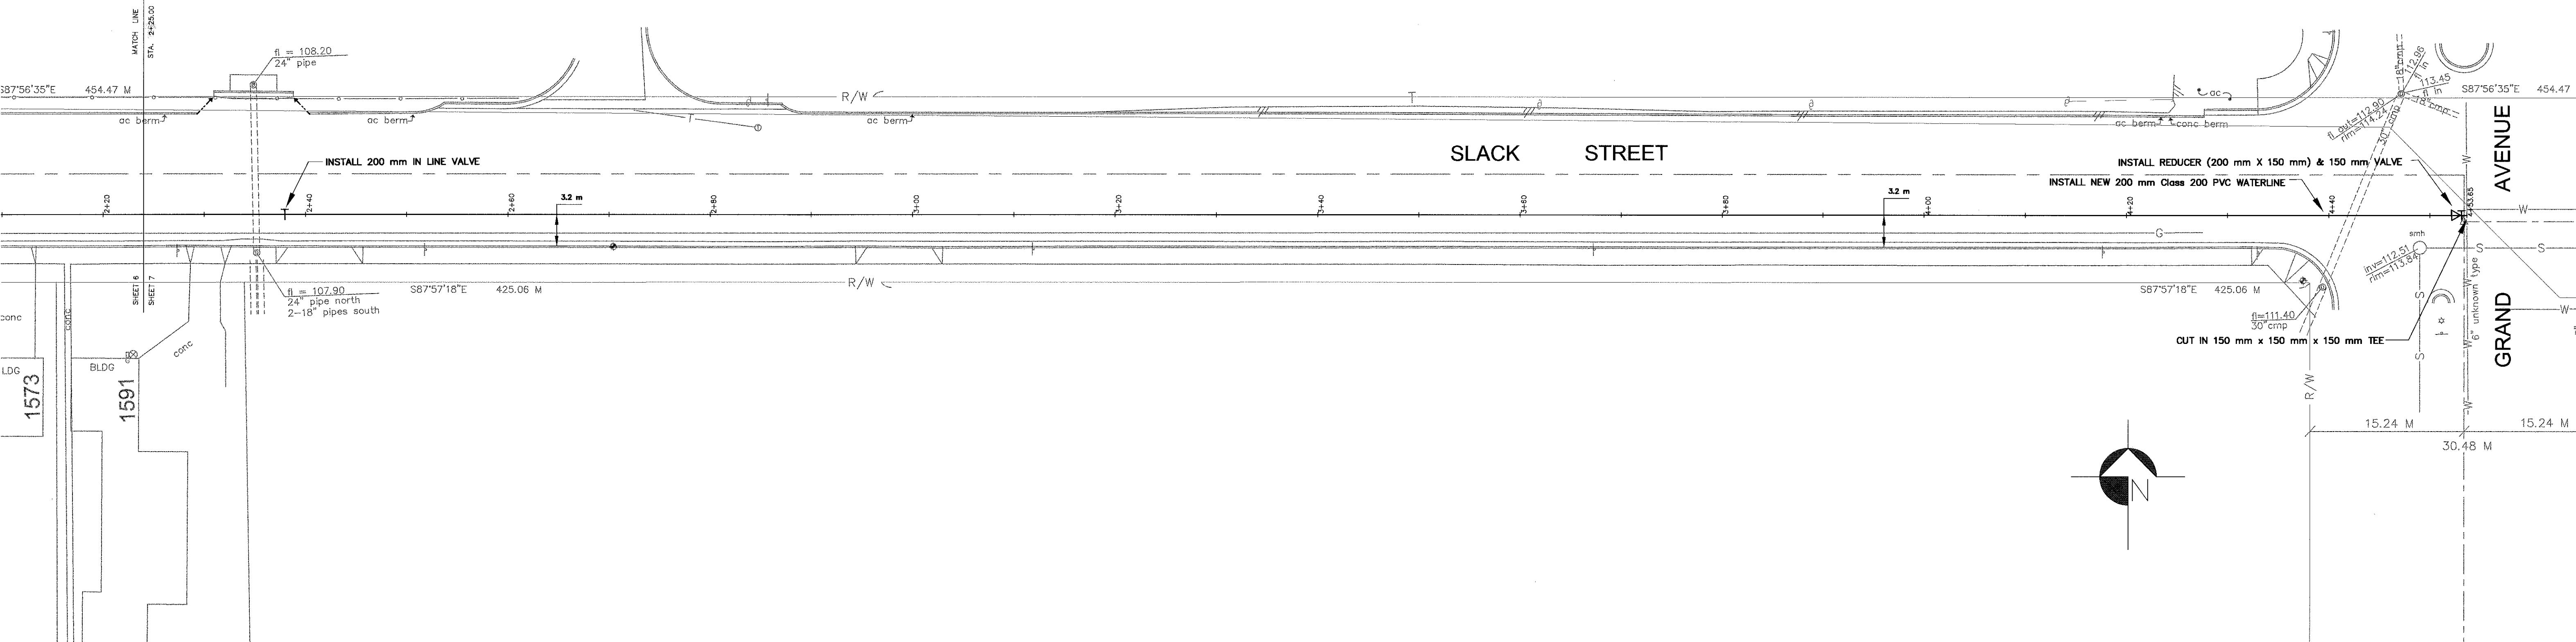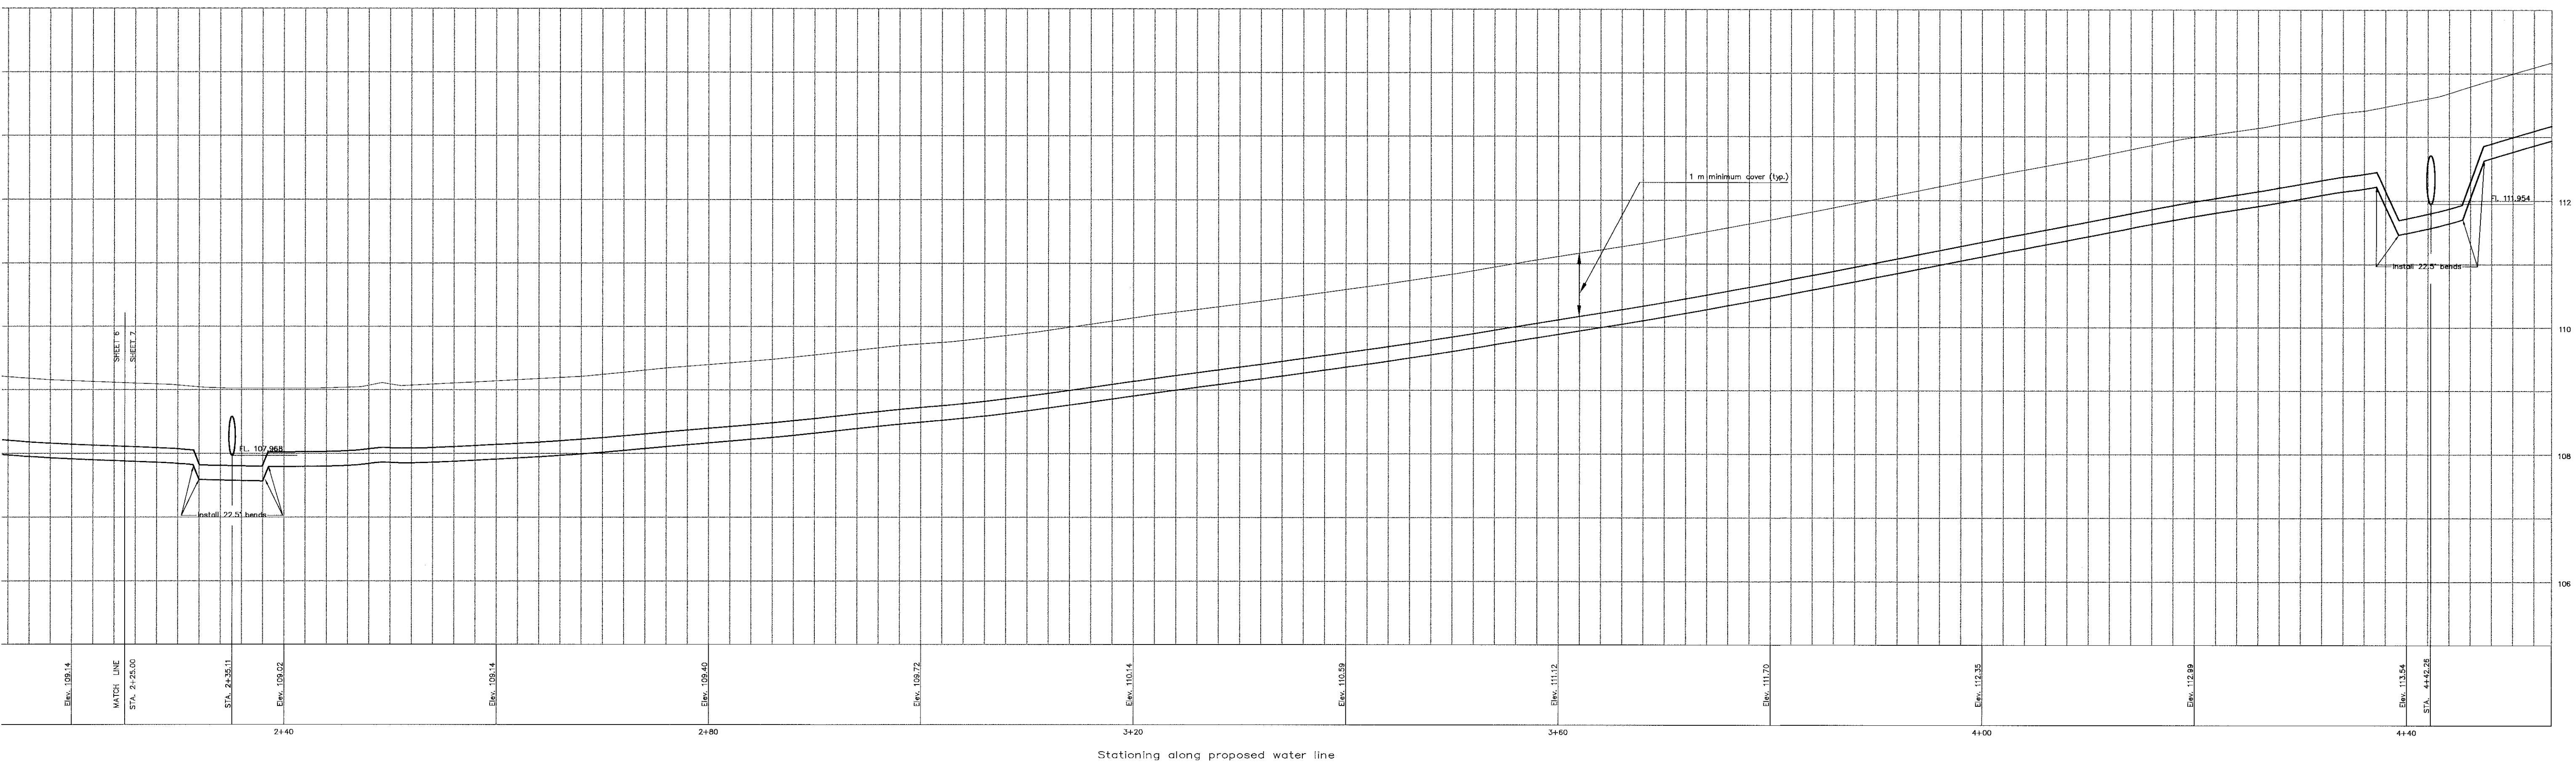[illegible]

ALBERT, CHAPLIN & SLACK WATER MAINS






DATE	July 23, 1998
SCALE	1:300
DESIGNED BY	R. J.
DRAWN BY	S. R.
CHECKED BY	B. L.
APPROVED BY	
UTILITIES DEPARTMENT	

SLACK STREET PLAN & PROFILE

SPECIFICATION NO. 98-79
FILE NO./LOCATION
SHEET 7 OF 8


NATURE / STATUS OF PLANS	BY	DATE

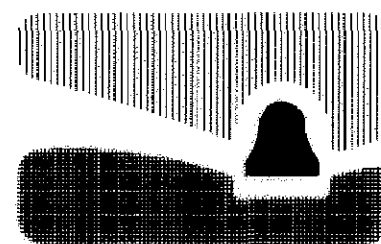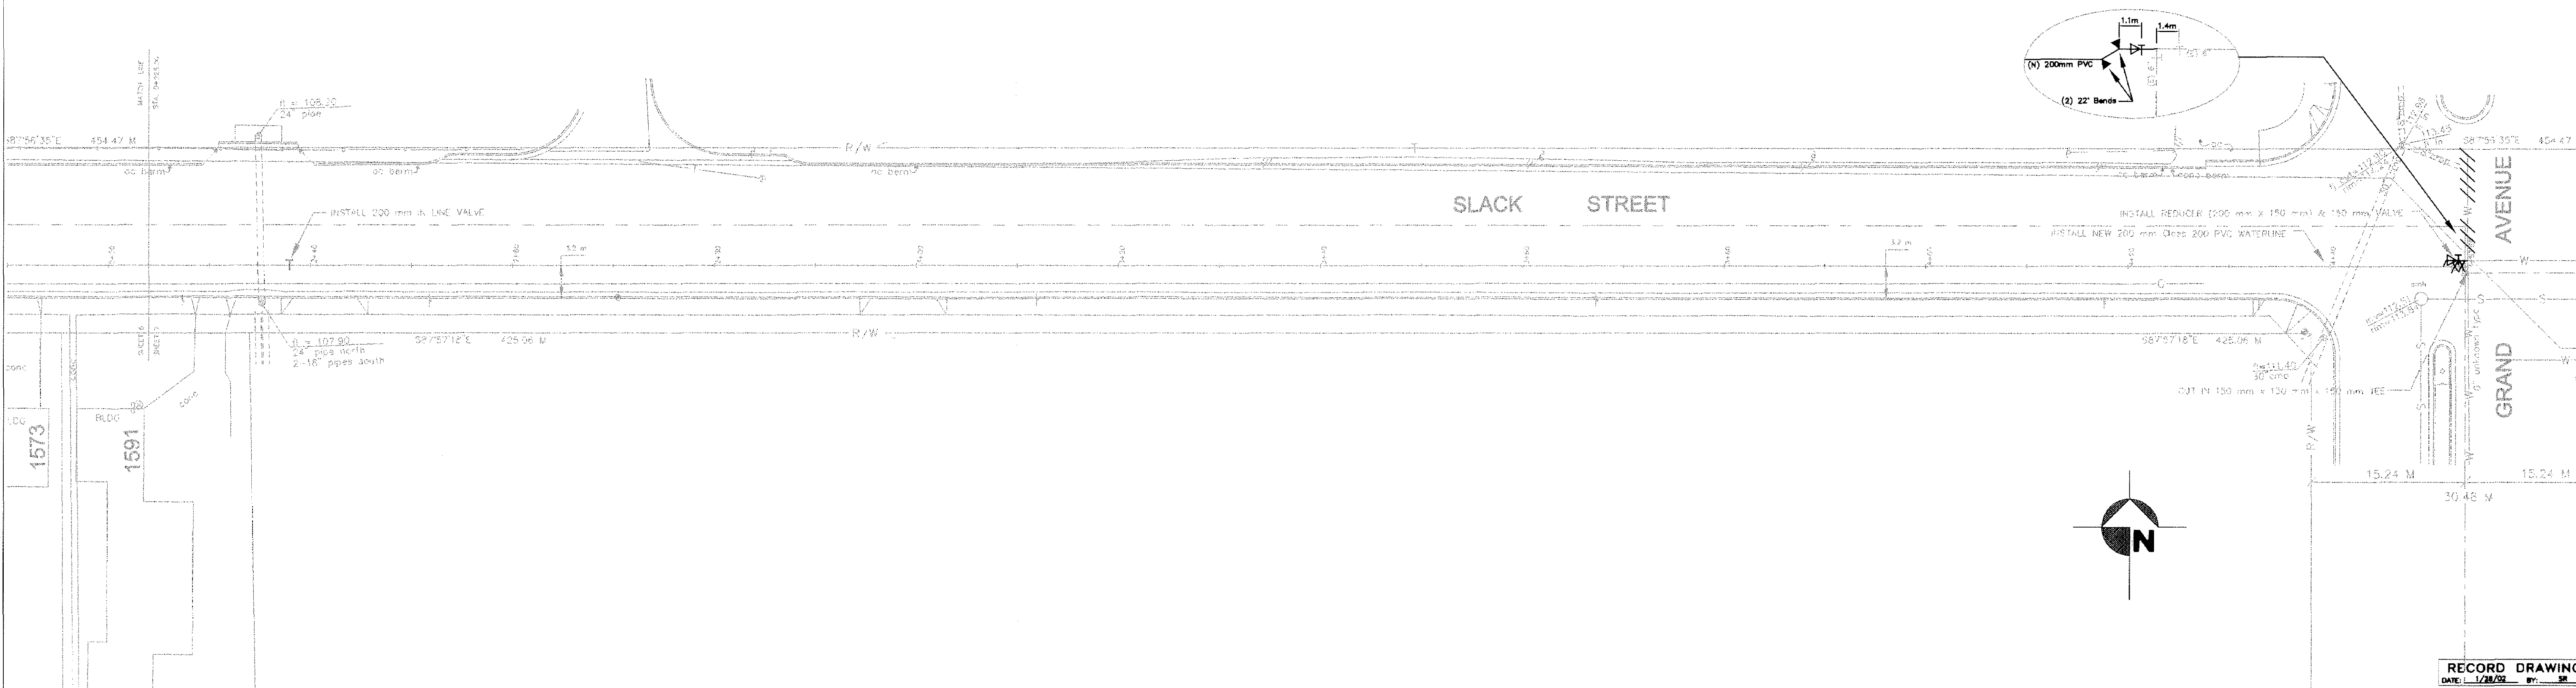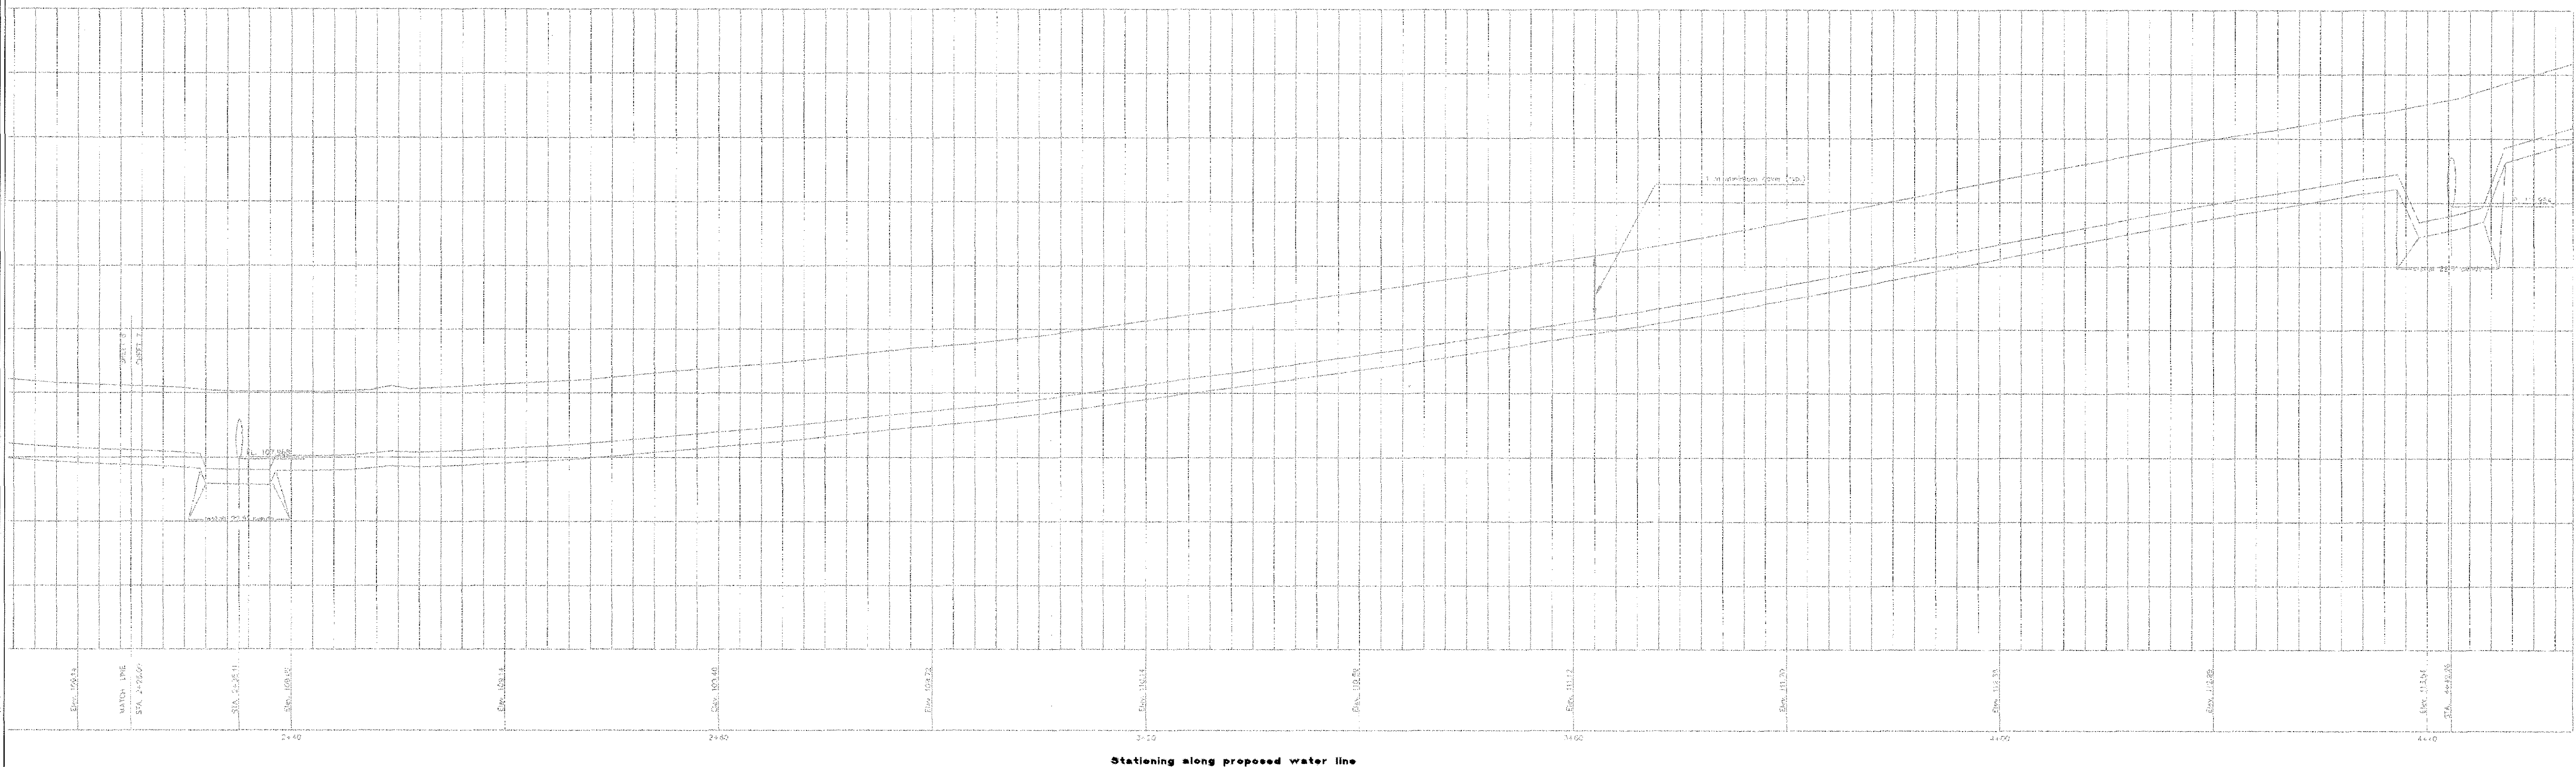

city of san luis obispo

ALBERT, CHAPLIN & SLACK

WATER MAINS

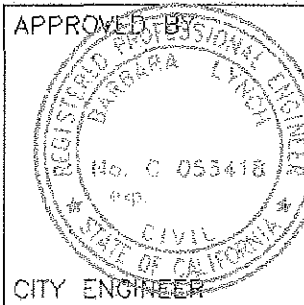

DATE	JUL 23, 1988
SCALE	1:300
DESIGNED BY	R. J.
DRAWN BY	S. F.
CHECKED BY	B. L.
APPROVED BY	
UTILITIES DEPARTMENT	









SLACK STREET PLAN & PROFILE

SPECIFICATION NO.
98-79

FILE NO./LOCATION


SHEET
7A OF **8**

NATURE / STATUS OF PLANS	BY	DATE

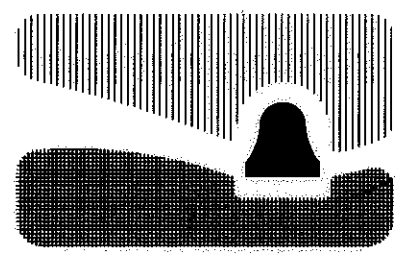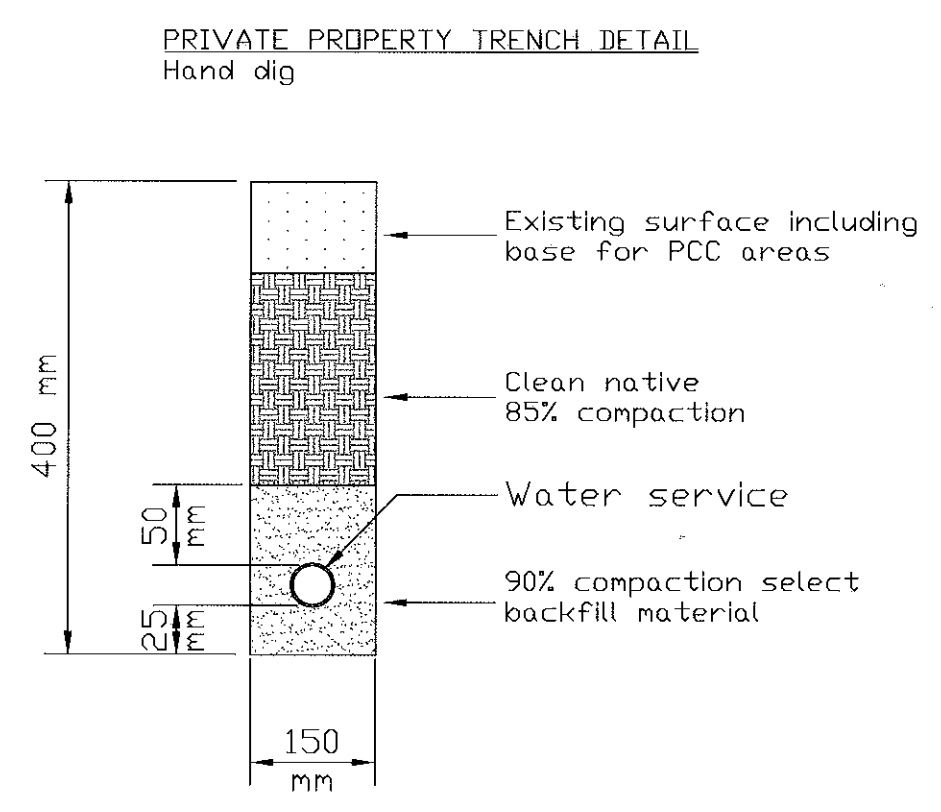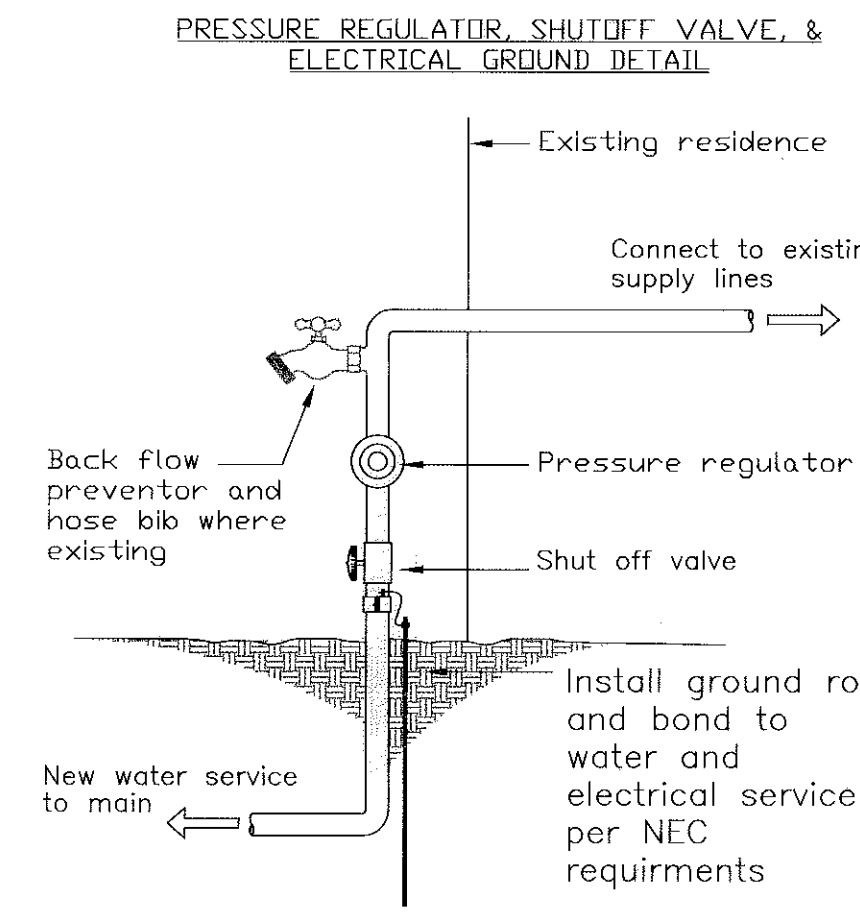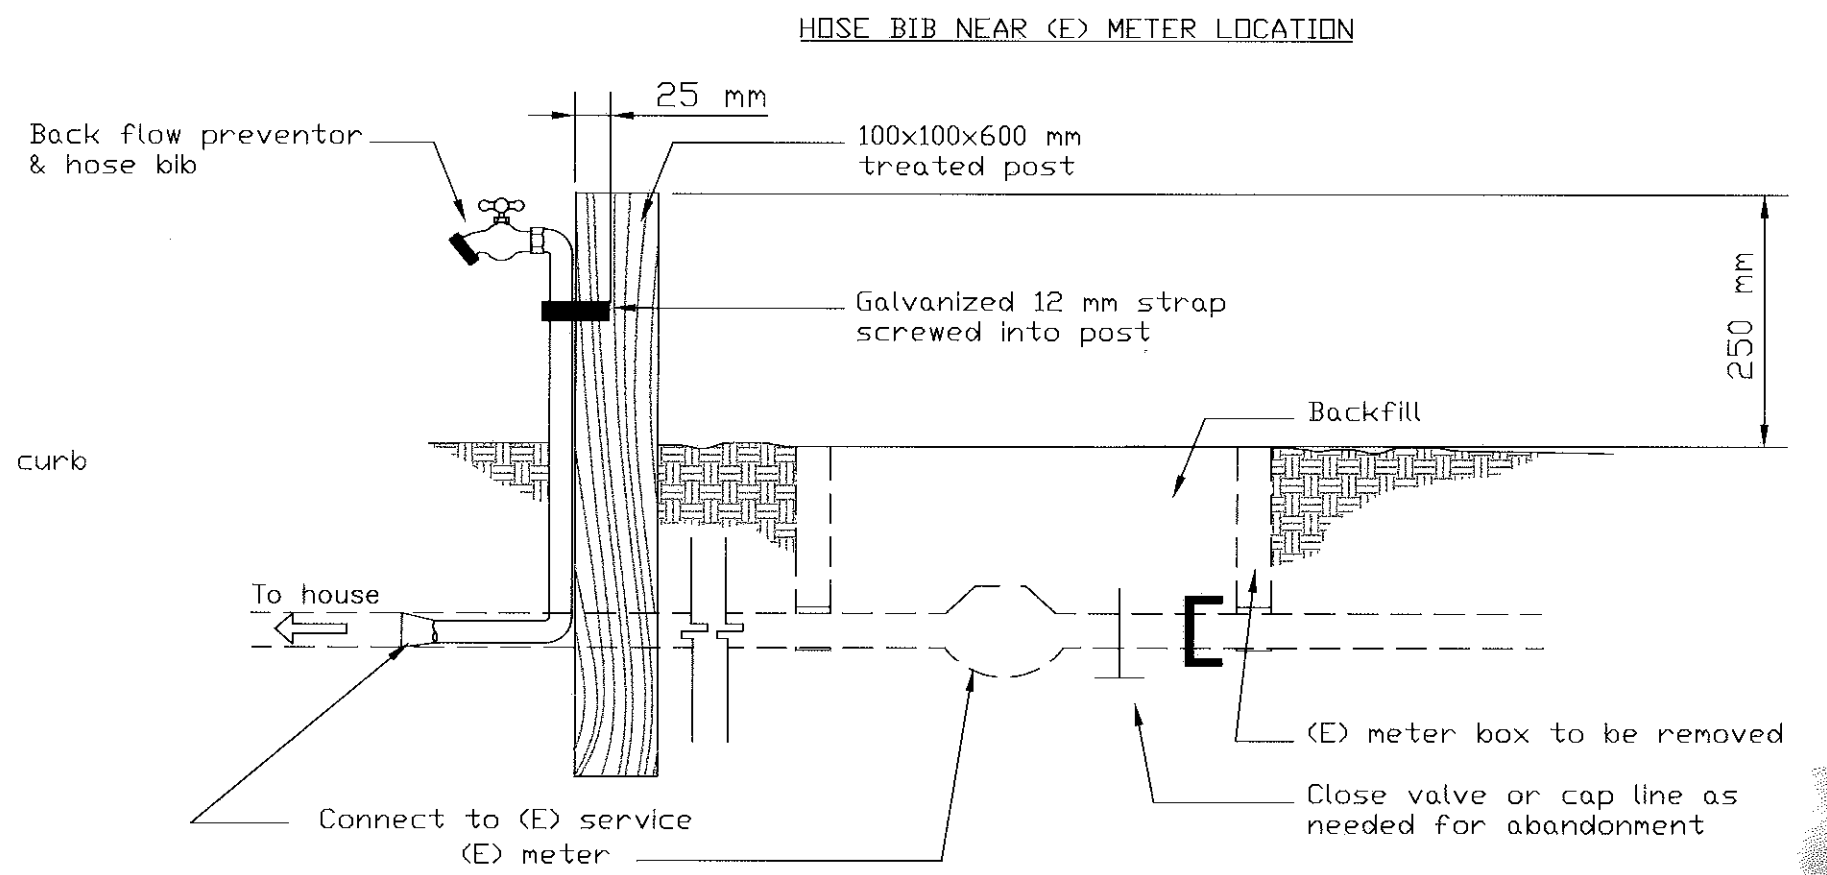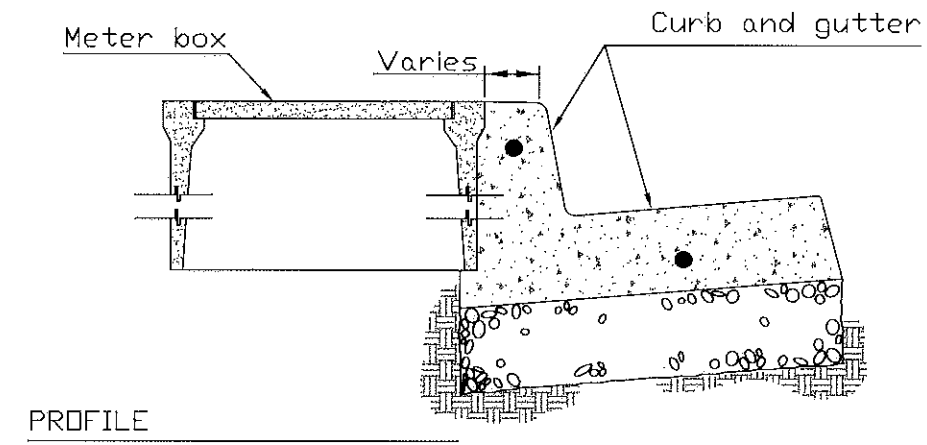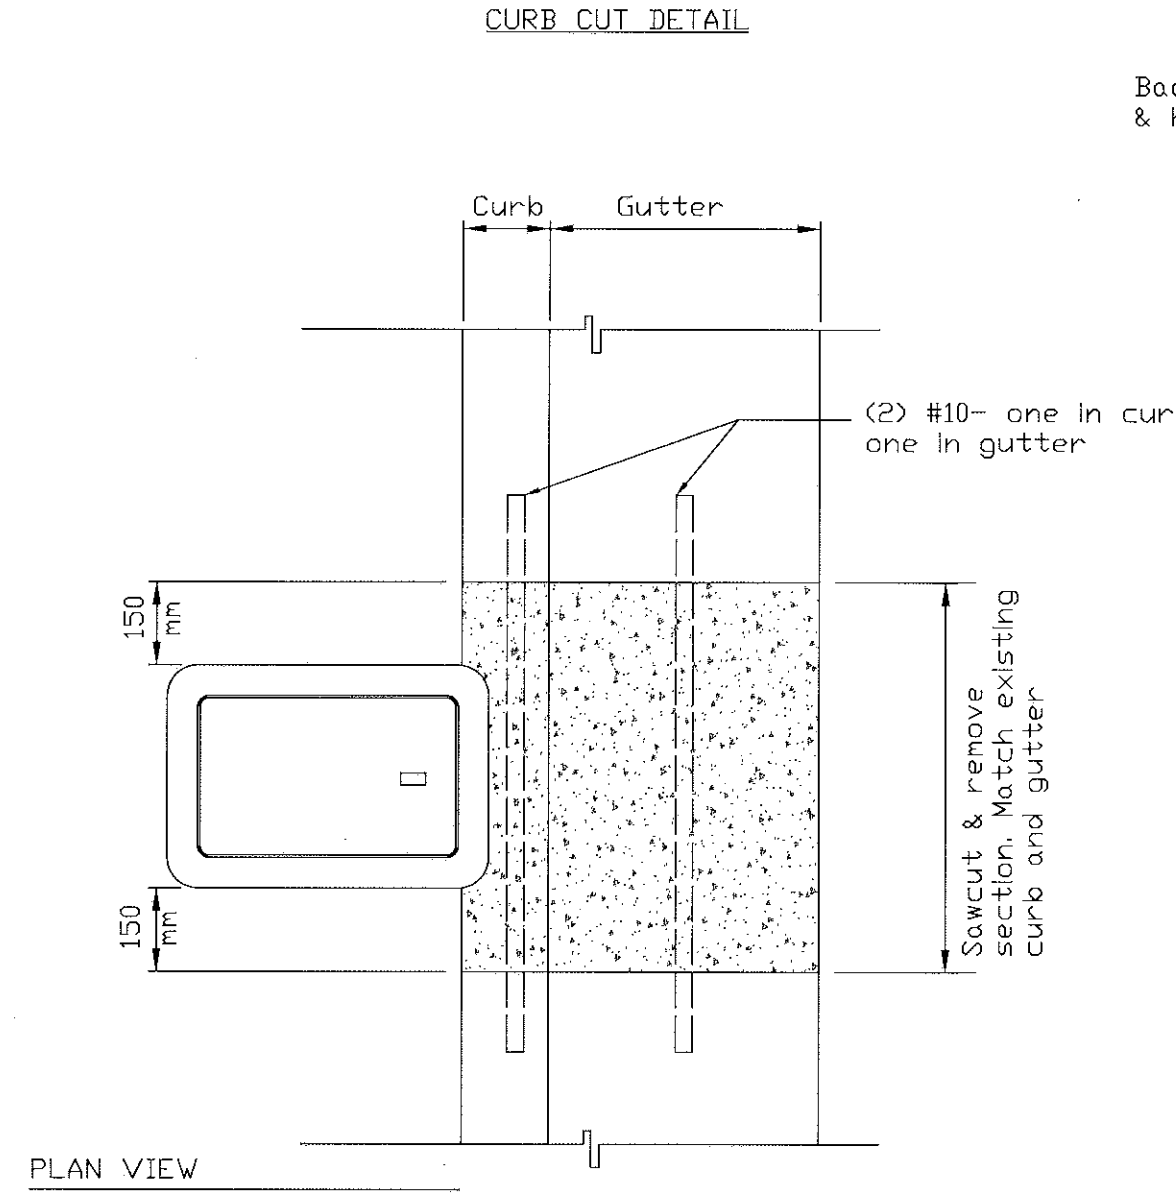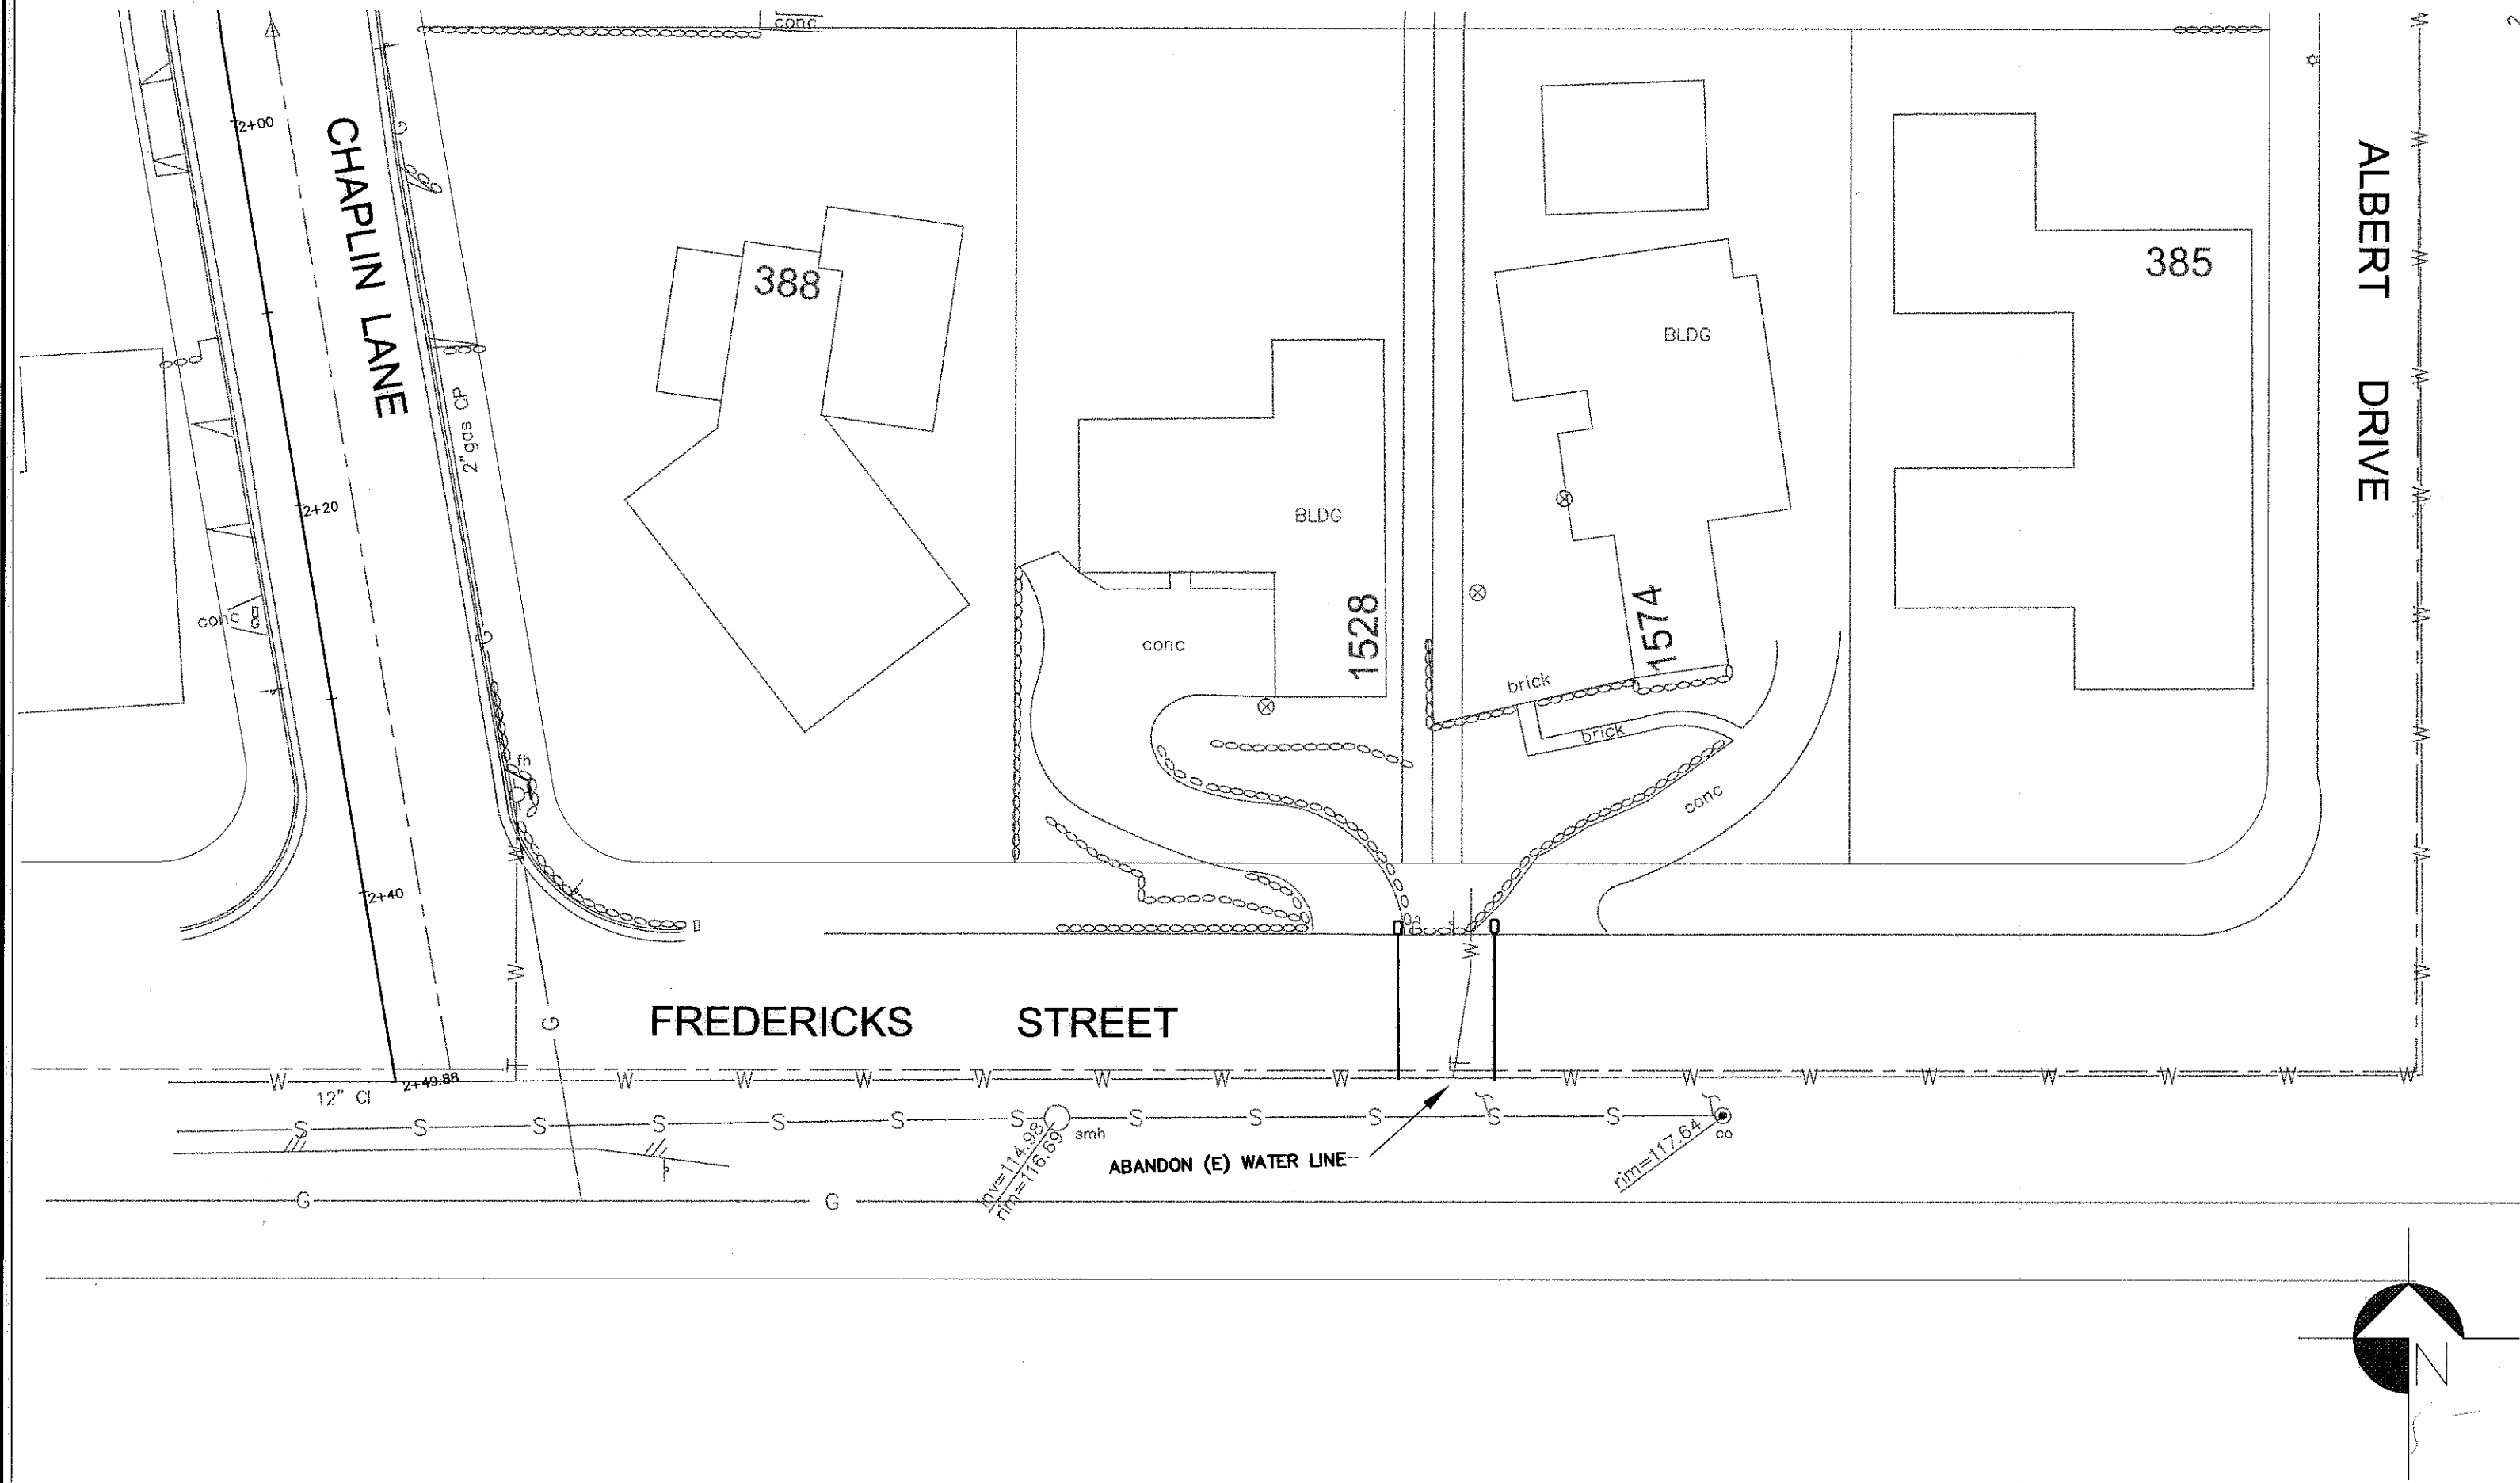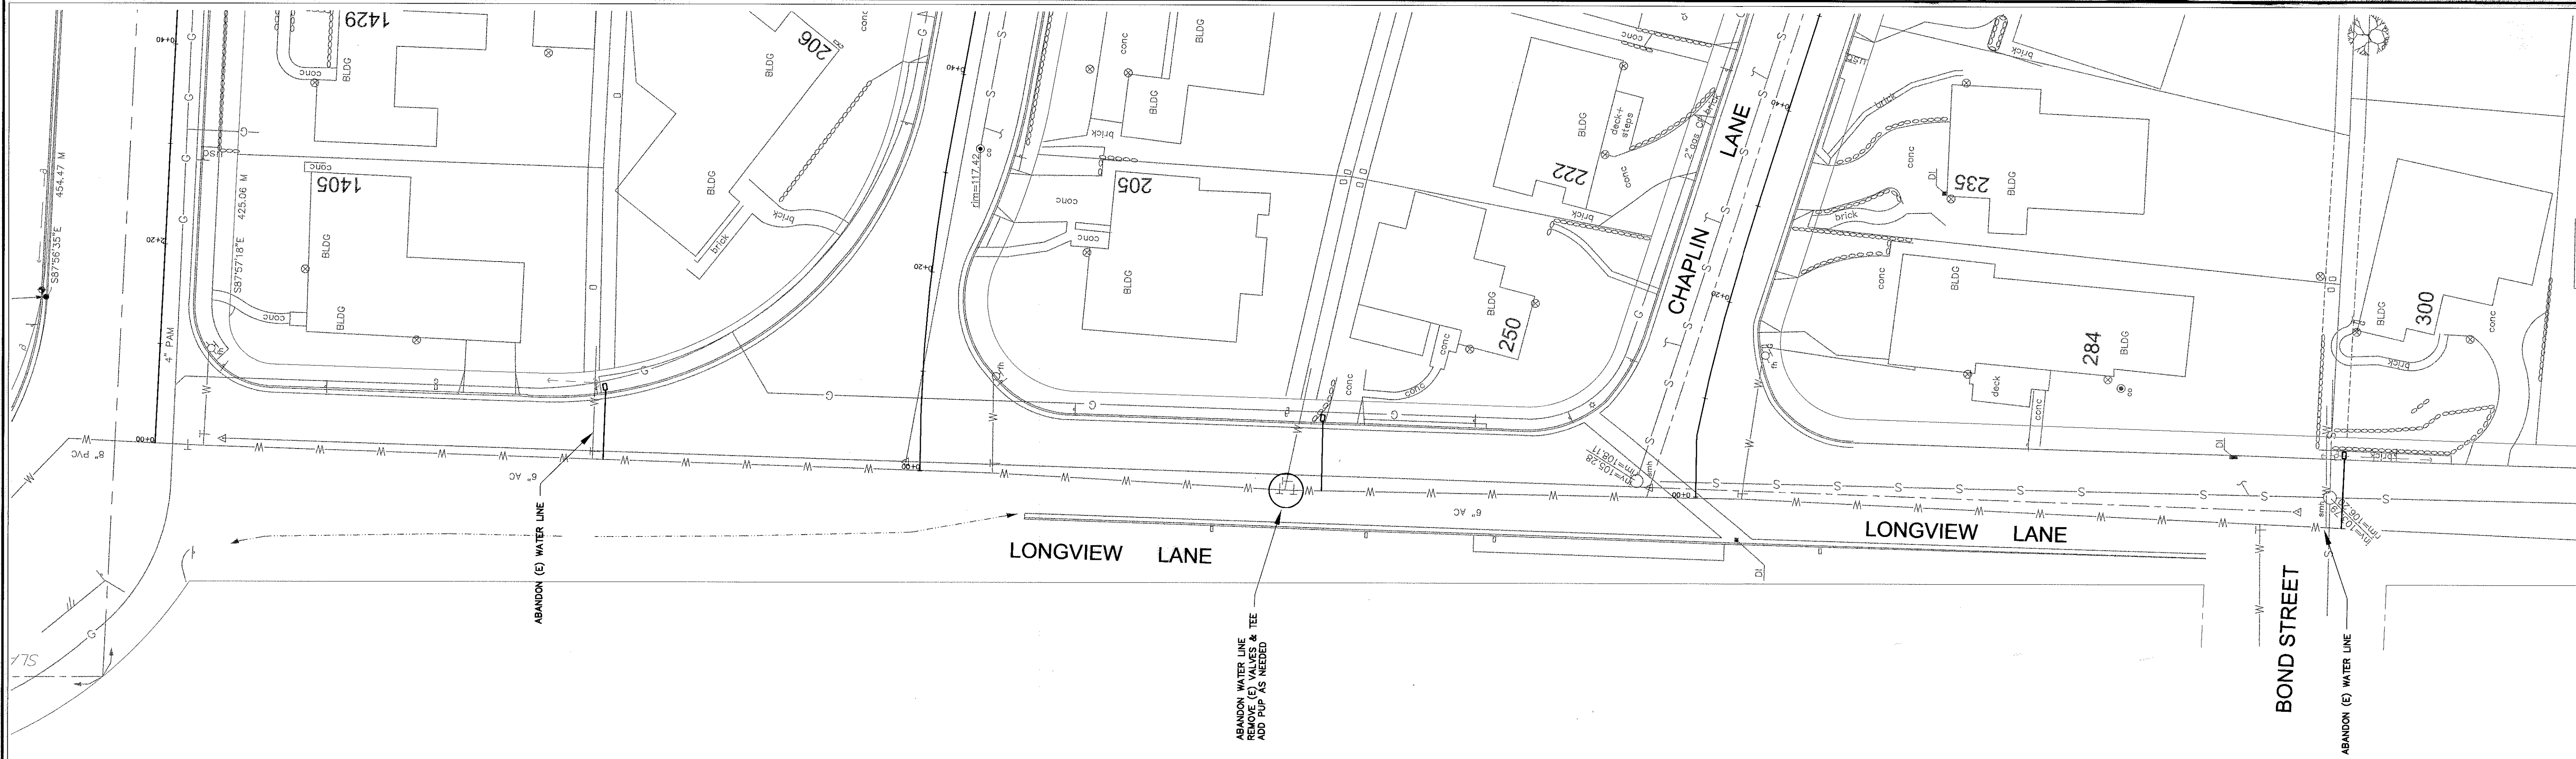

city of san luis obispo

ALBERT, CHAPLIN & SLACK WATER MAINS

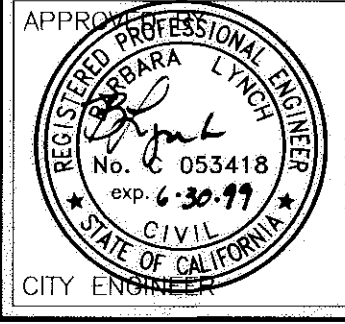

DATE July 23, 1998
SCALE 1:300
DESIGNED BY R. J.
DRAWN BY S. R.
CHECKED BY B. L.
APPROVED BY [Signature]
CITY ENGINEER

LONGVIEW & FREDERICKS
PLAN & PROFILE

SPECIFICATION NO.
98-79
FILE NO./LOCATION
SHEET
8 of 8