


E/O JOHNSON (HOUSING AUTHORITY)

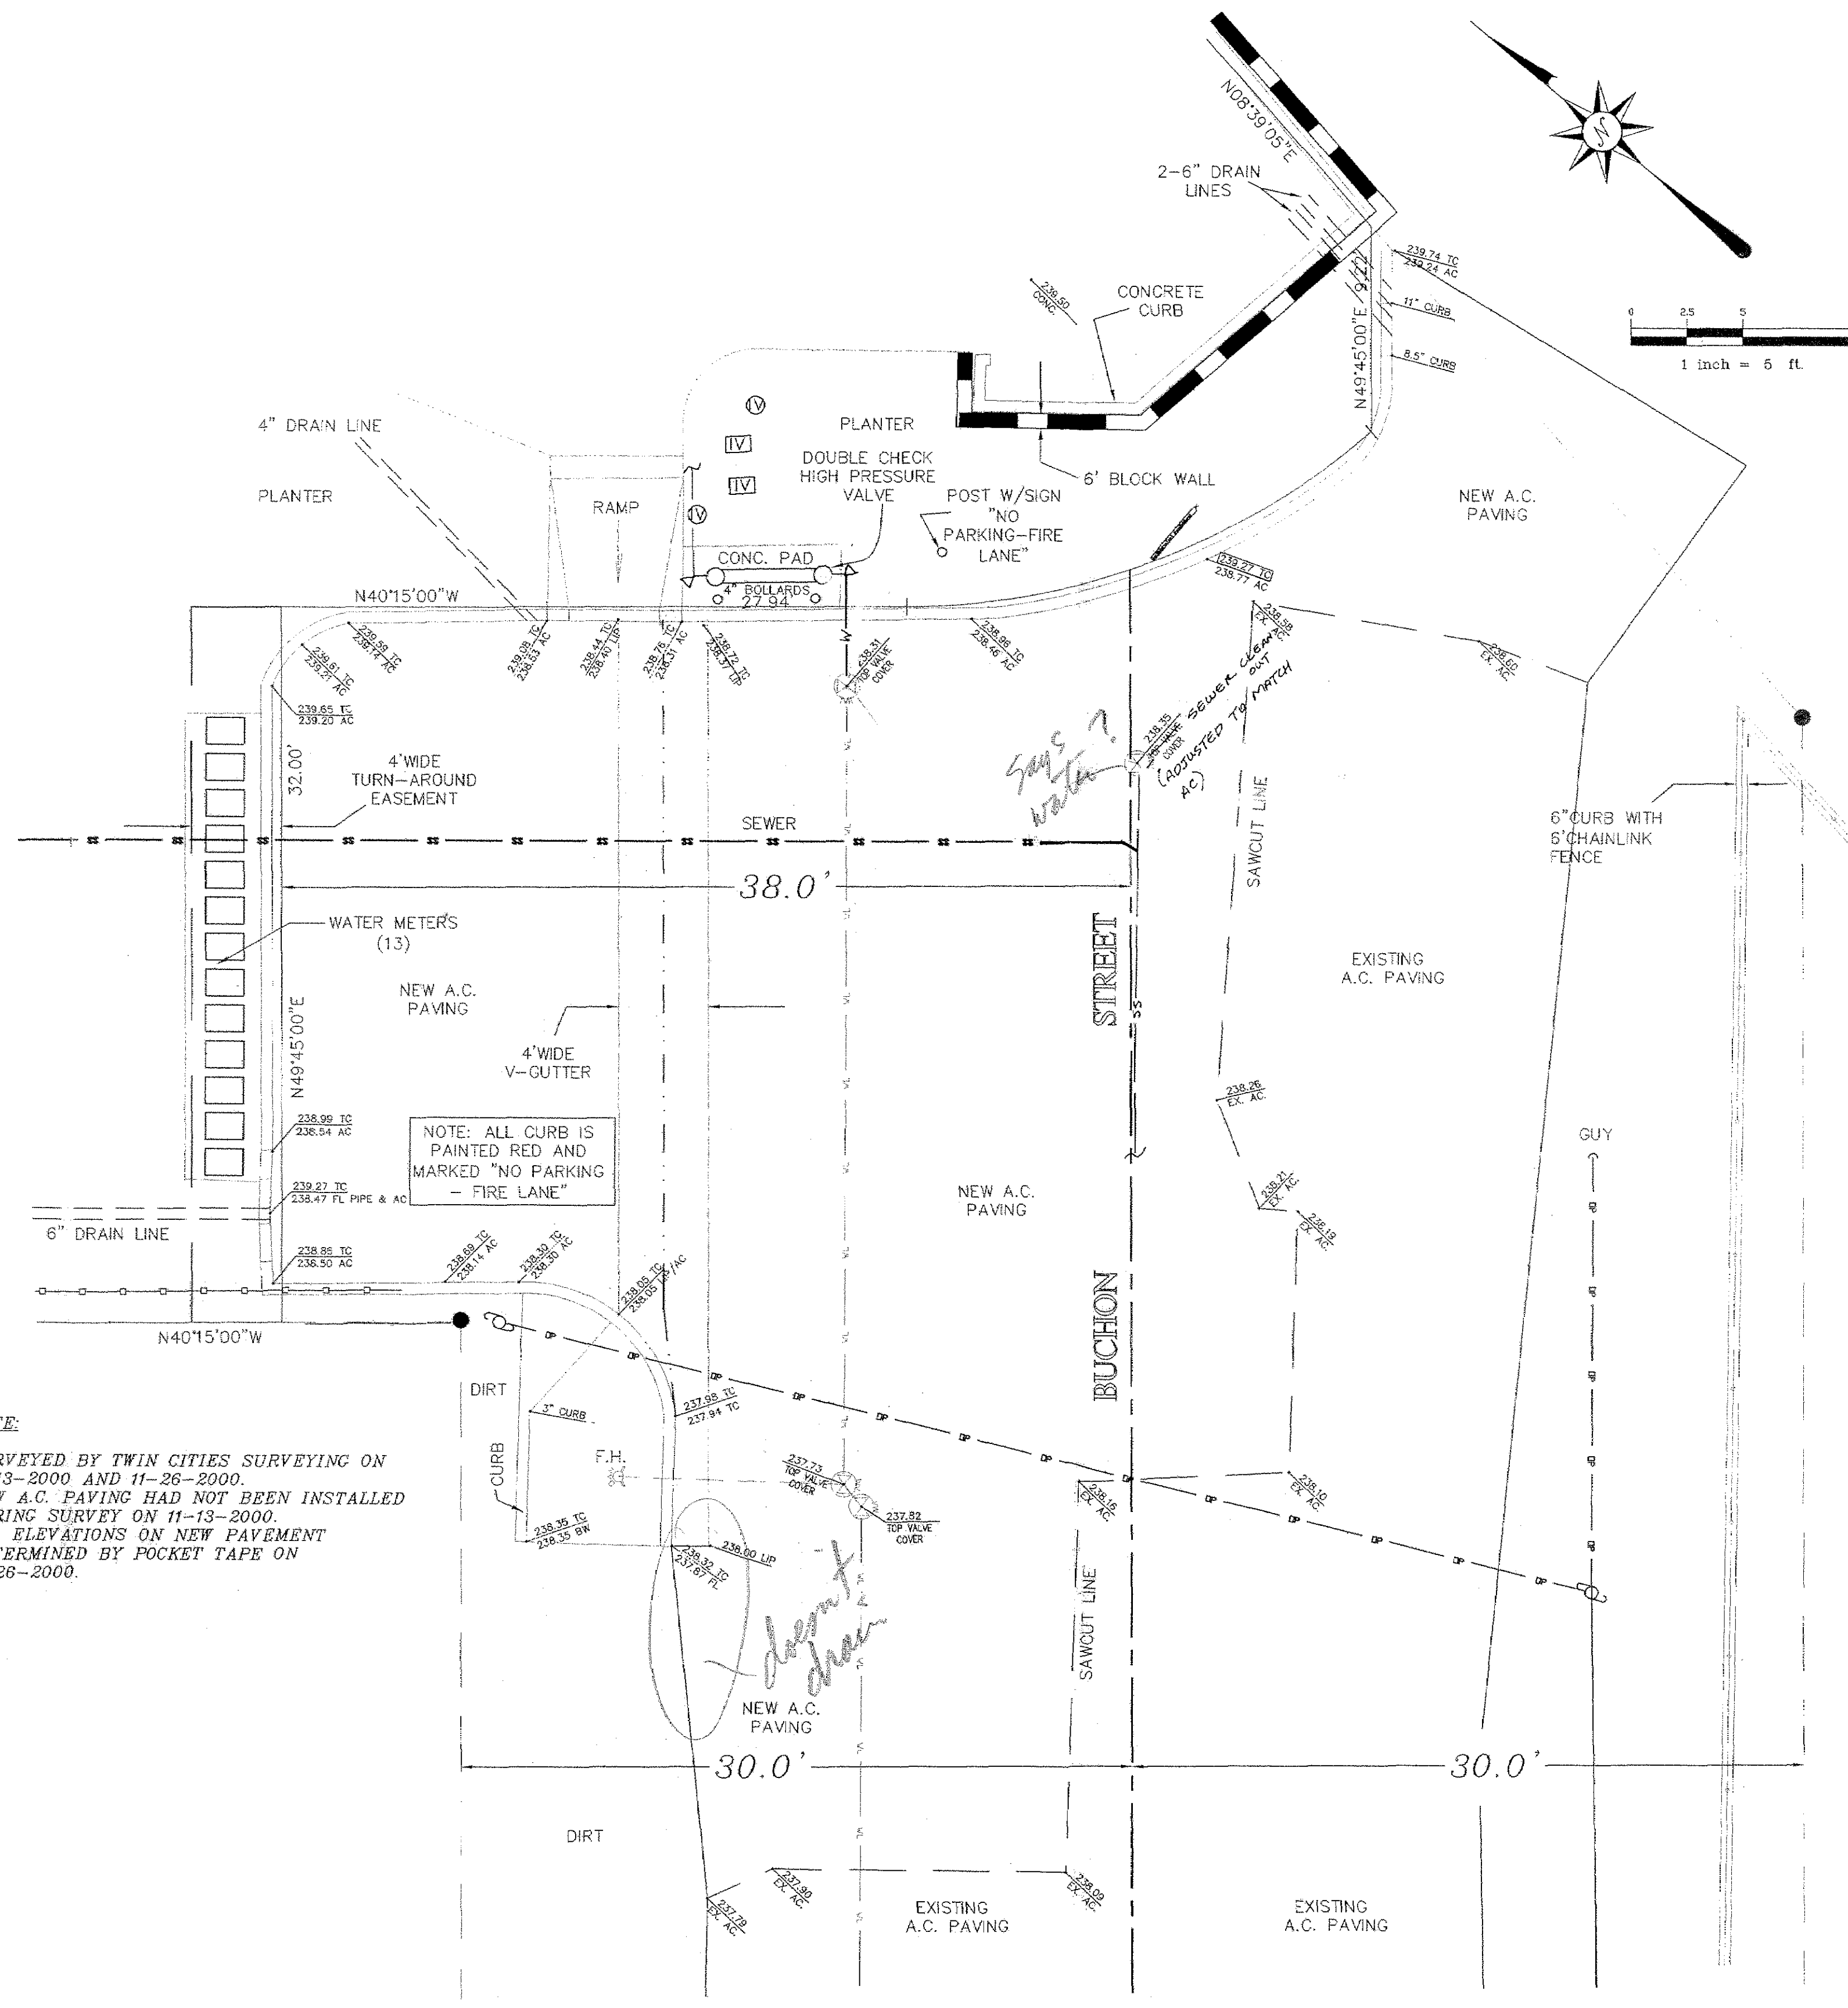

**NOTE:**  
 SURVEYED BY TWIN CITIES SURVEYING ON 11-13-2000 AND 11-26-2000.  
 NEW A.C. PAVING HAD NOT BEEN INSTALLED DURING SURVEY ON 11-13-2000.  
 A.C. ELEVATIONS ON NEW PAVEMENT DETERMINED BY POCKET TAPE ON 11-26-2000.

**LEGEND**

- — — — — = SANITARY SEWER LINE
- — — — — = WATERLINE
- — — — — = OVERHEAD POWER
- ☒ = IRRIGATION VALVE
- ⊗ = FIRE HYDRANT
- ⊗ ⊗ ⊗ = WATER VALVE
- ⊗ ⊗ ⊗ ⊗ = GAS VALVE
- ⊗ = PP

See Proj PTH