



general notes

1. IT SHALL BE THE RESPONSIBILITY OF THE CONTRACTOR OR PERMITEE TO CONTACT "UNDERGROUND SERVICE ALERT U.S.A." TOLL FREE AT 1-800-227-2600 FORTY-EIGHT (48) HOURS PRIOR TO START OF CONSTRUCTION, FOR LOCATION OF POWER, TELEPHONE, OIL AND NATURAL GAS UNDERGROUND FACILITIES. CONTRACTOR OR PERMITEE SHALL ALSO CONTACT THE APPROPRIATE AGENCY FOR THE LOCATION OF CABLE T.V., WATER, SEWER, DRAINAGE OR UNDERGROUND FACILITIES.
2. THE CONTRACTOR SHALL POSSESS A CLASS "A" LICENSE AT THE TIME THE CONTRACT IS AWARDED.

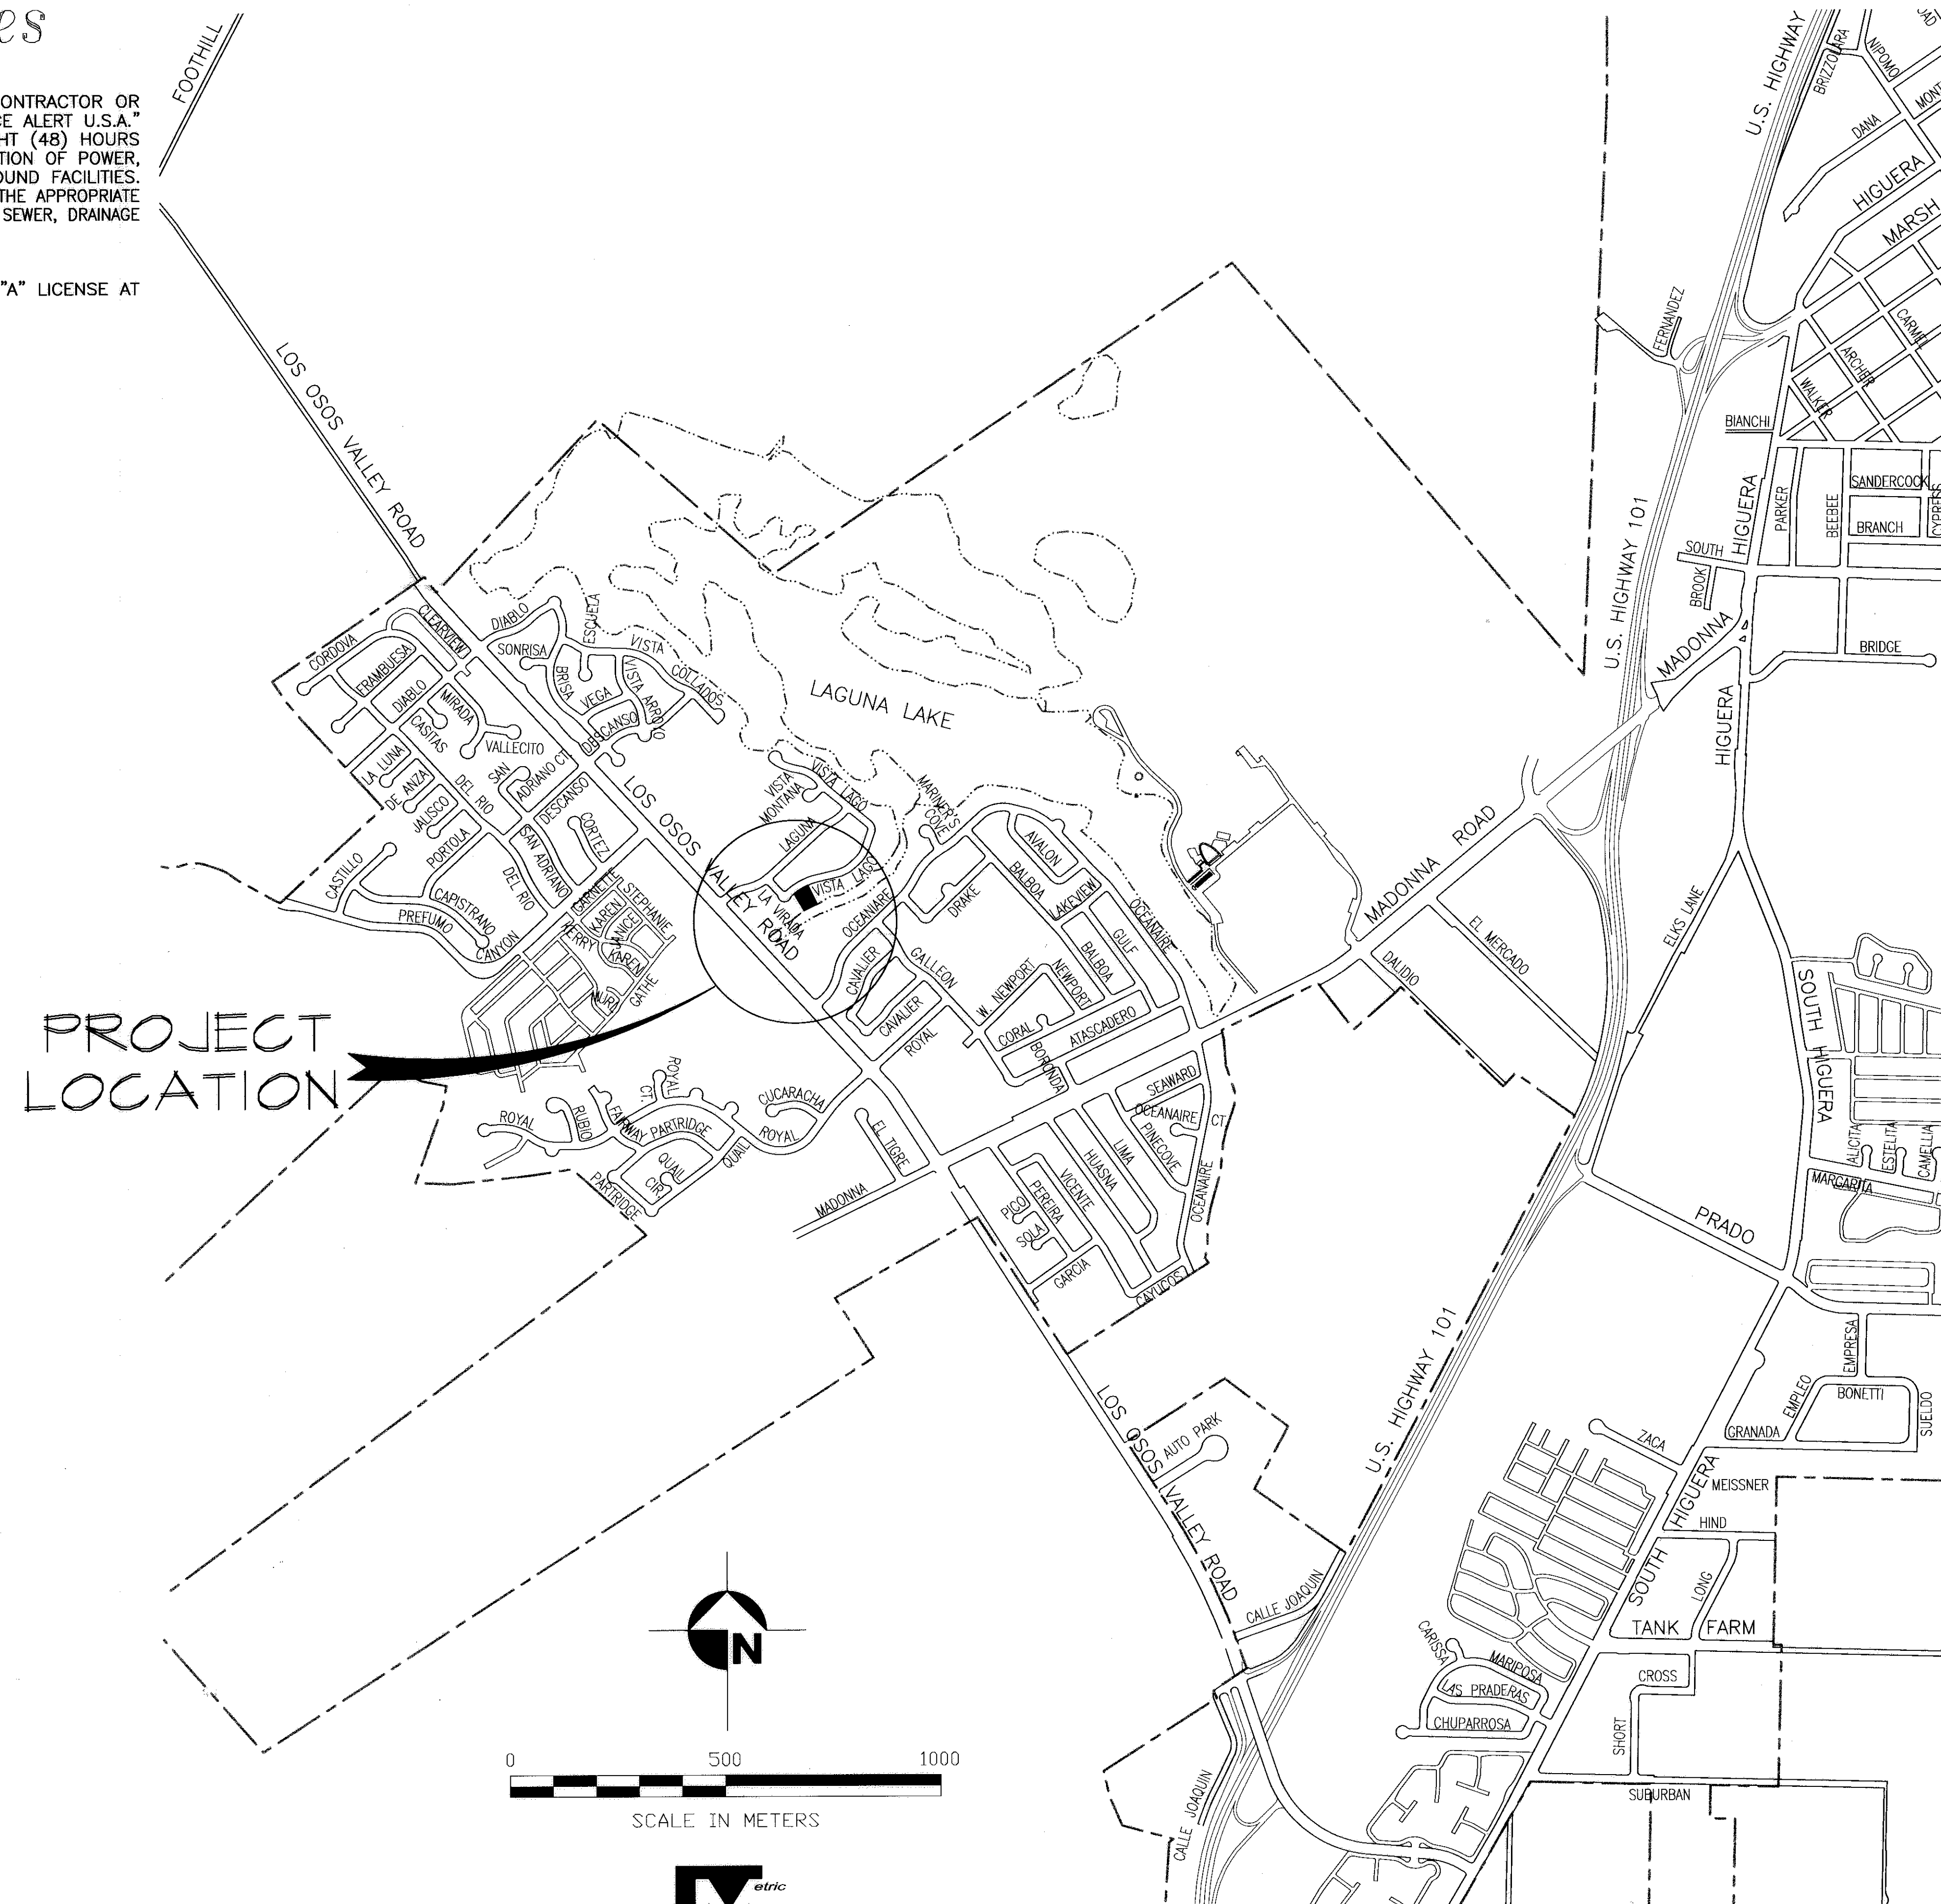

index to plans

sheet no.	description
T1	Cover Sheet
L1	Call Out Plan
L2	Dimension Plan
L3	Grading & Drainage
L4	Planting & Irrigation Plan

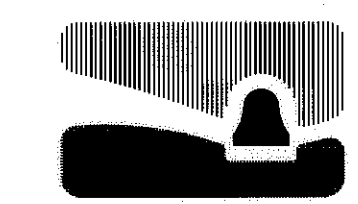
 **city of**
san luis obispo
san luis obispo county, california




RECORD DRAWING
DATE: JULY 2002 BY: JENN.

SPECIFICATION NO. 90095

APPROVED BY


Wayne A. Peterson
City Engineer

R.C.E. 18598

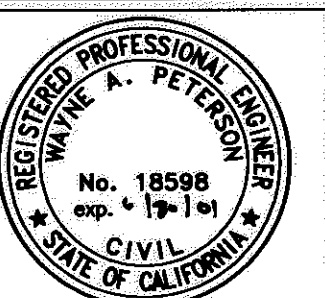

DATE: 04/2000
FILE NO./LOCATION:
SHEET **T1**
OF **5**








CITY OF
san luis obispo

REVISIONS: 4-4-00
Record Drawing
Graphic Scale: 1:100

VISTA LAGO PARK
CALL-OUT PLAN

PROJECT TITLE:
DESIGNED BY: SPC
DRAWN BY: SPC
CHECKED BY: BOF
APPROVED BY: BOF
DATE: 1-25-2000
CITY SPECIFICATION NO. 400.15
SHEET NO. L-1

Vista Lago

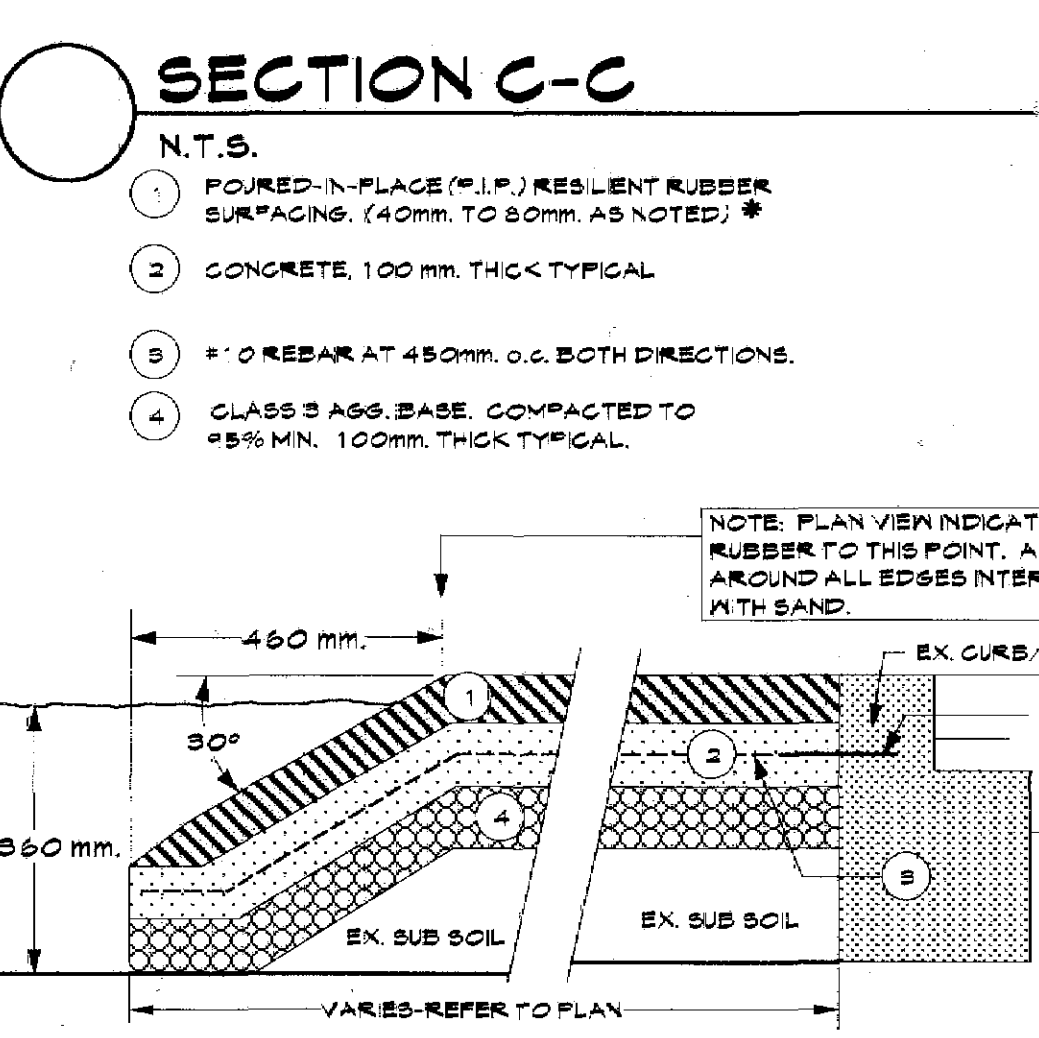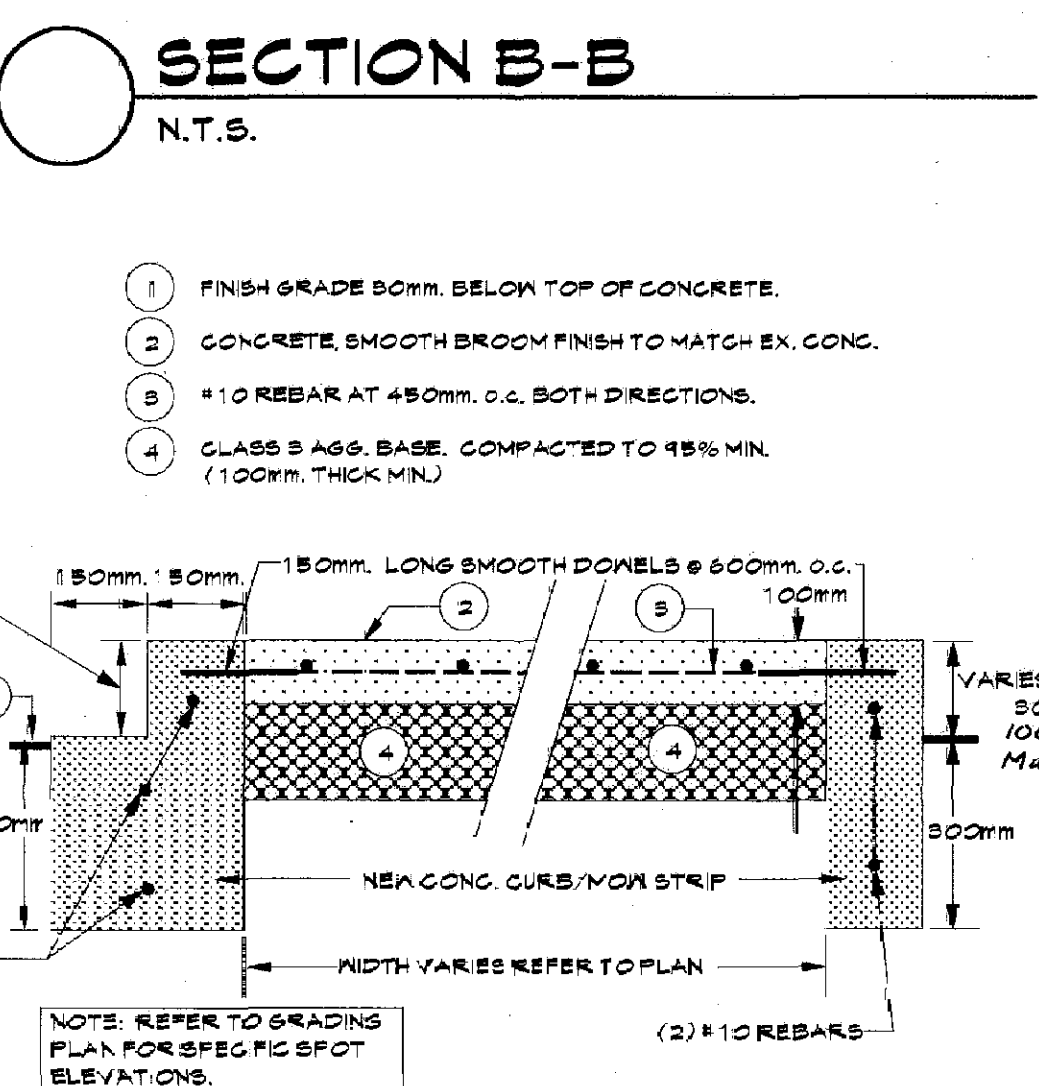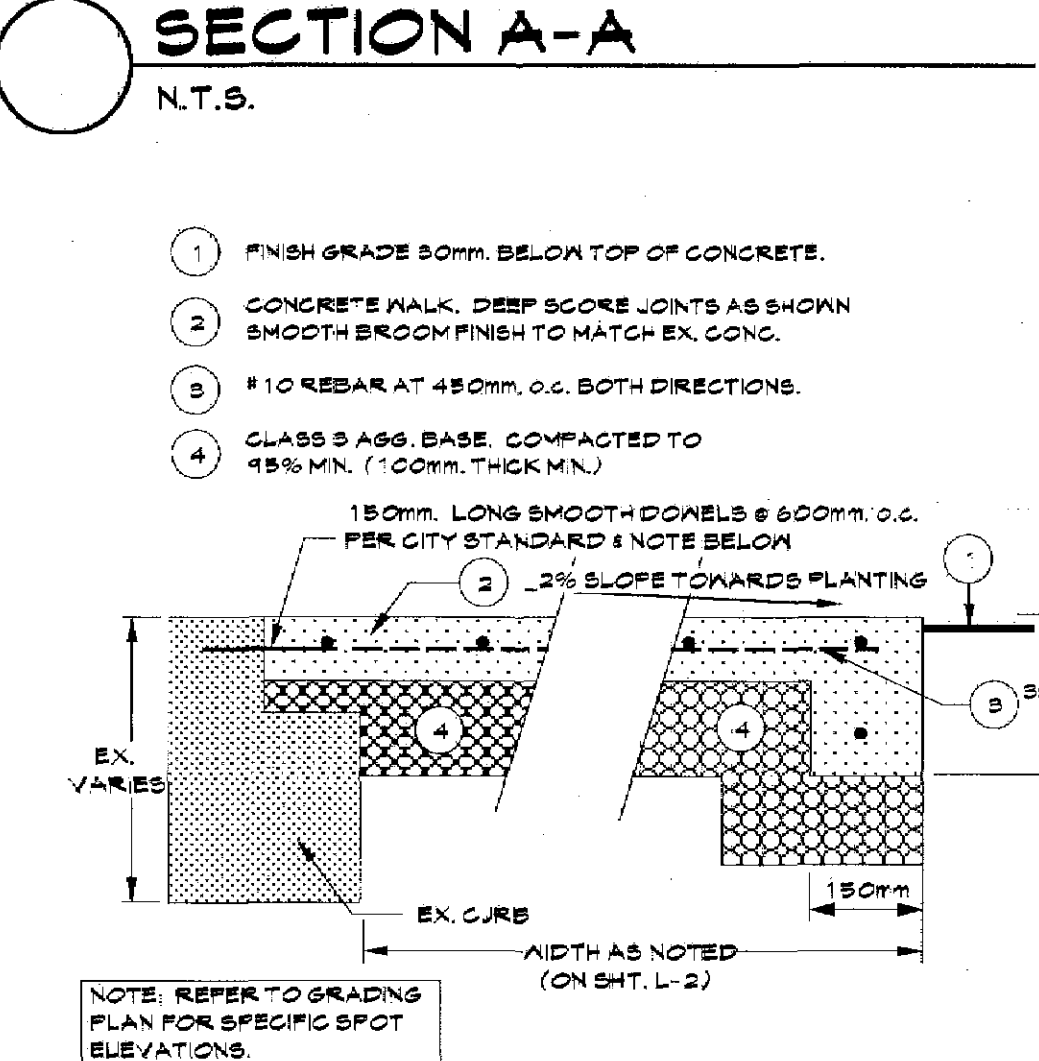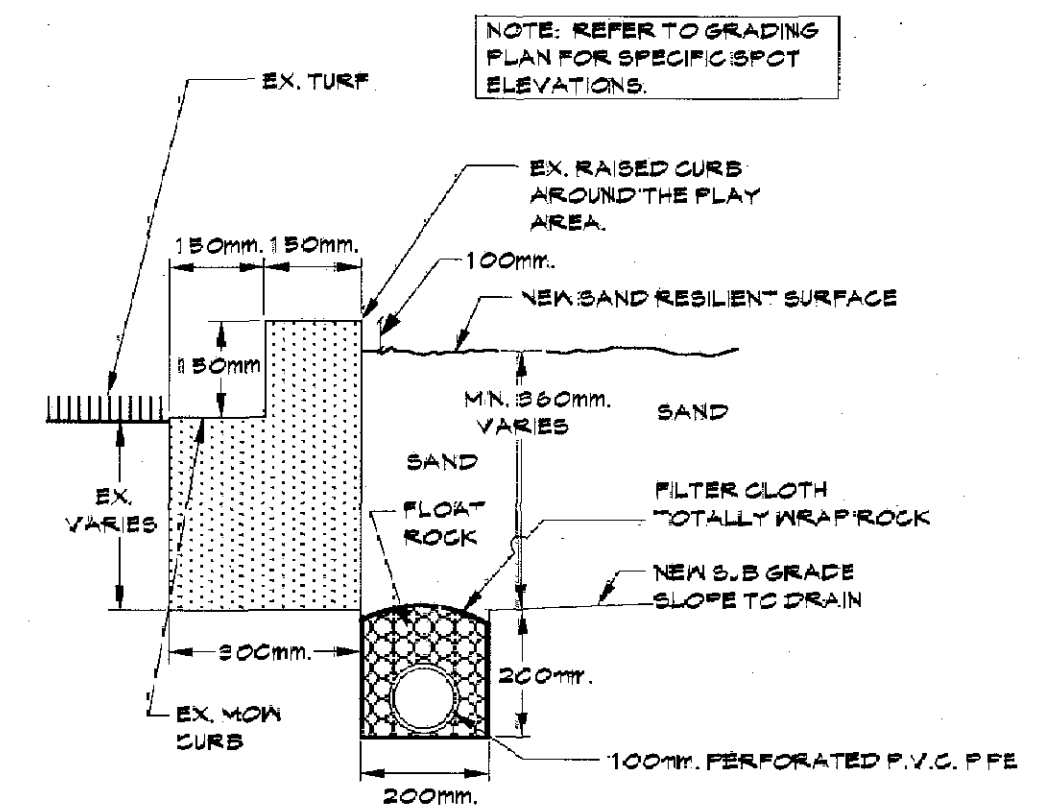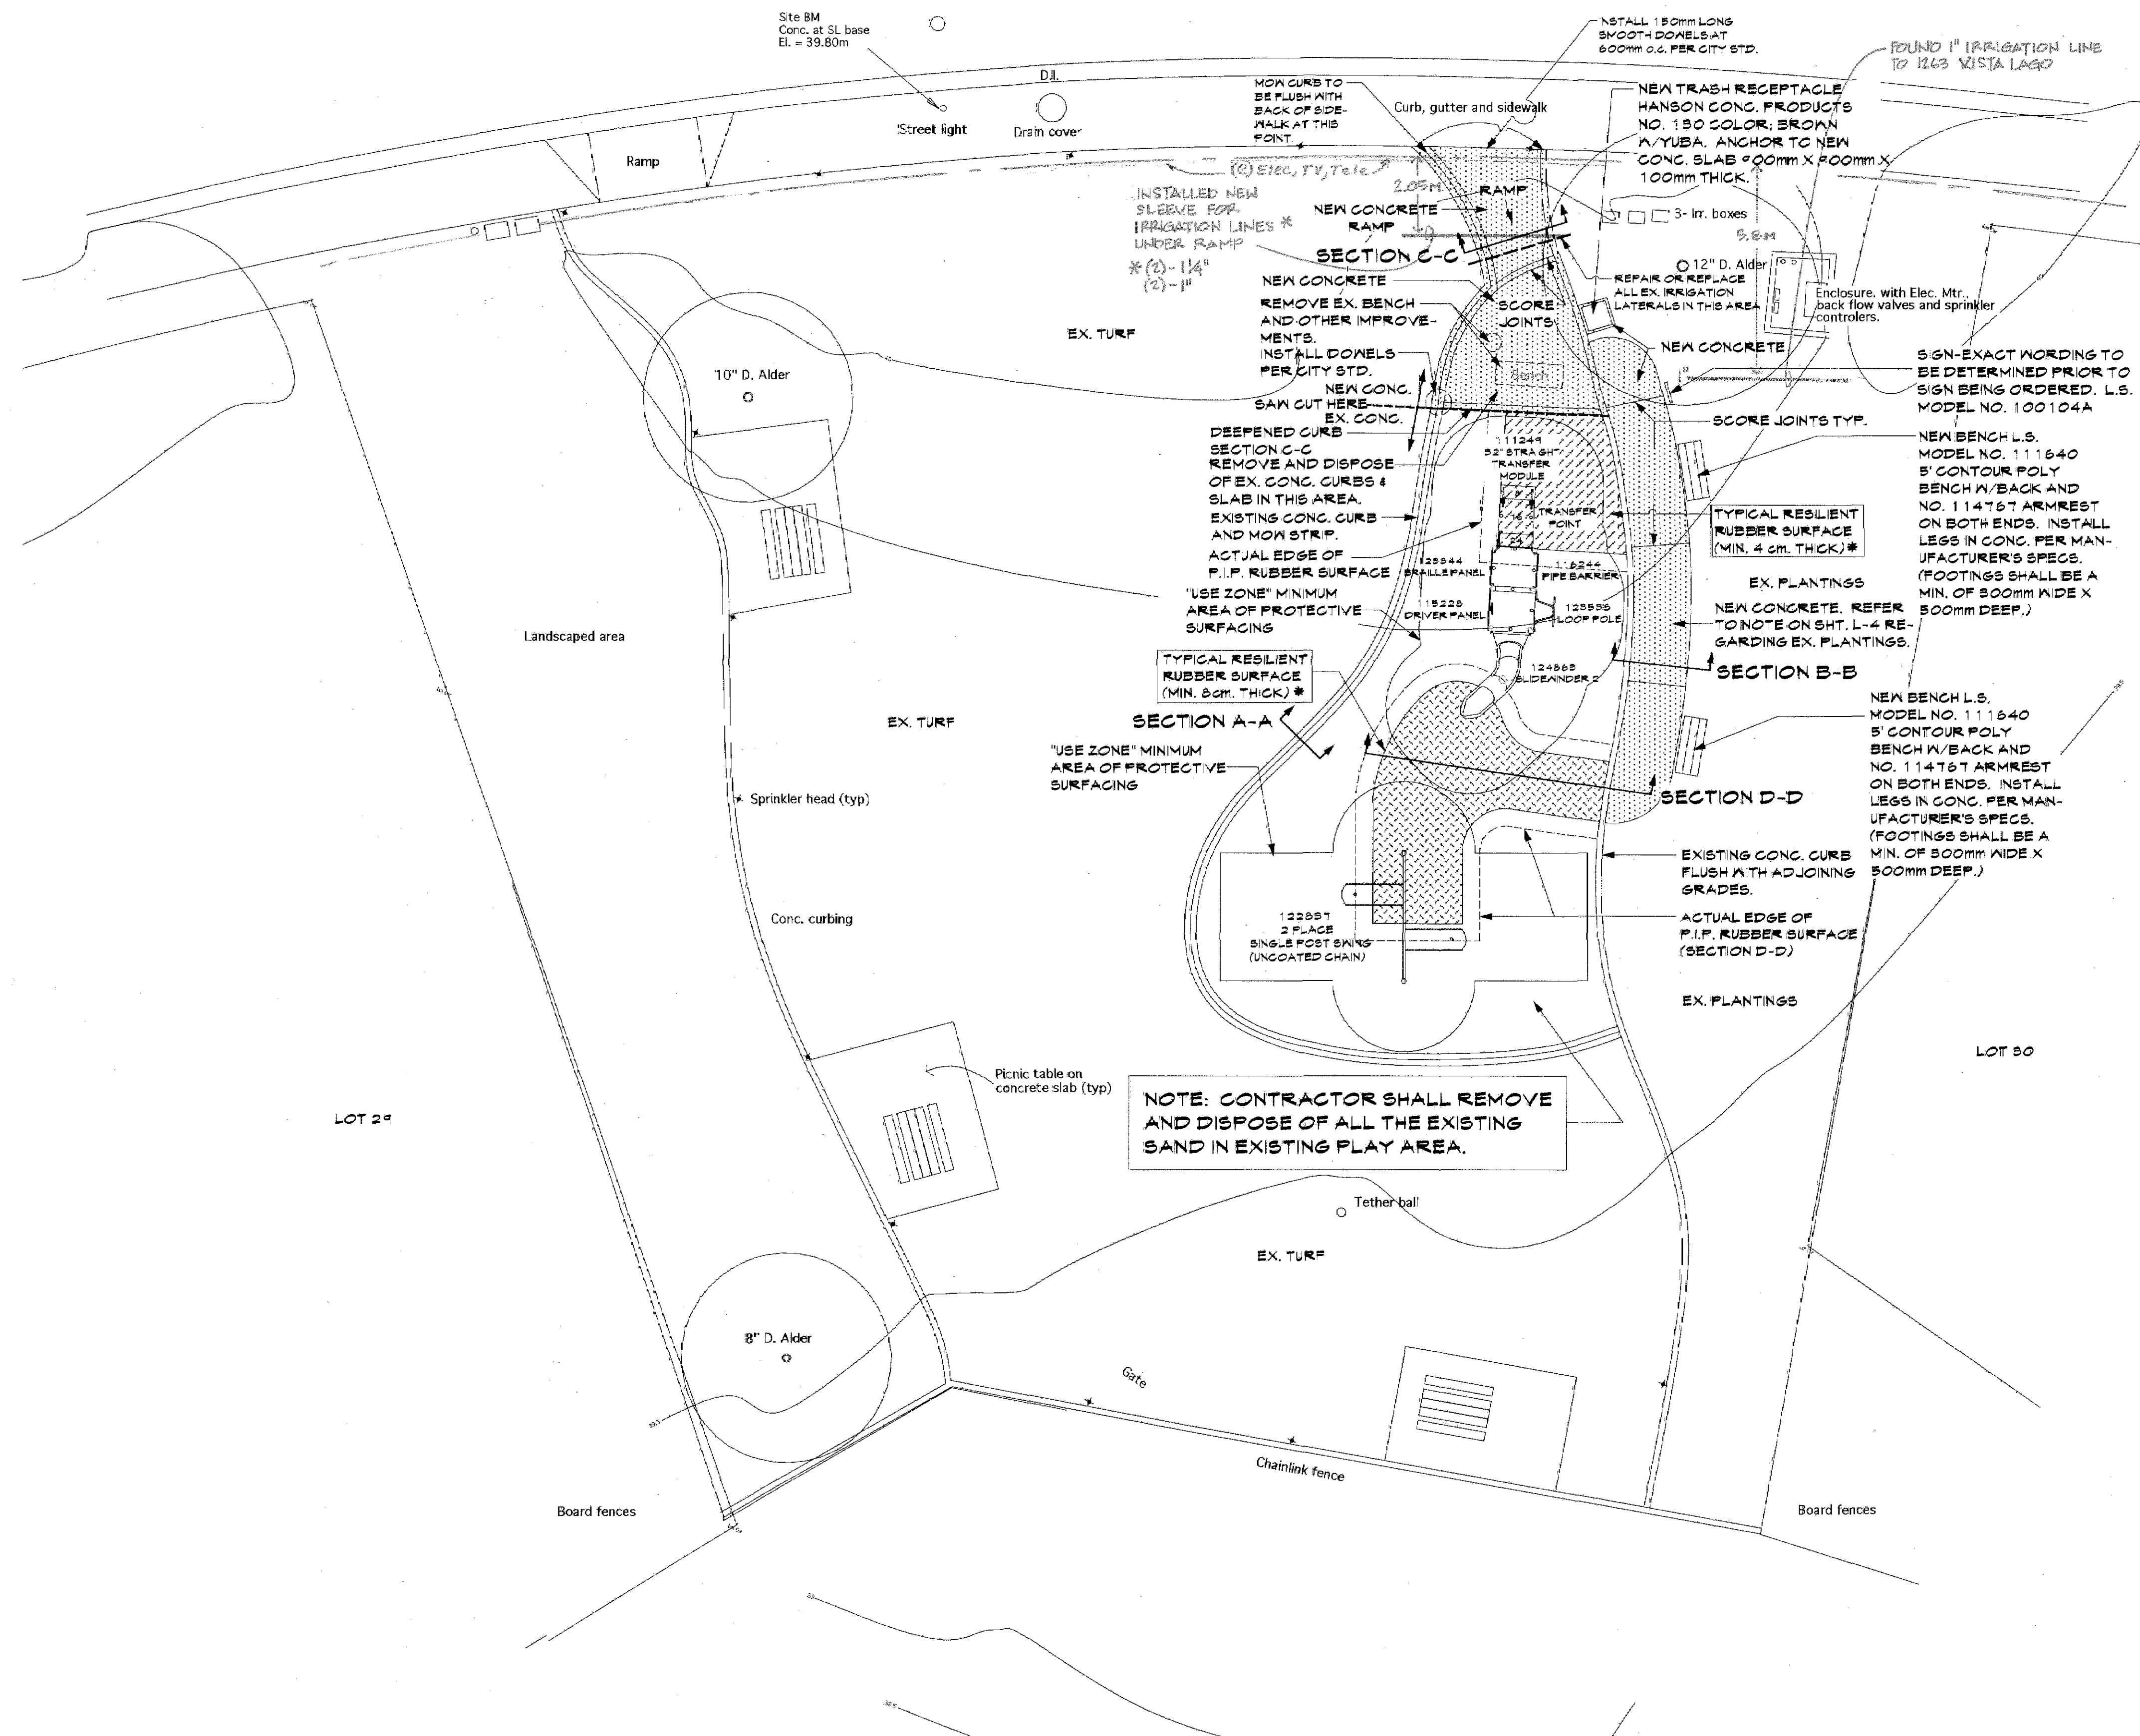


NOTE: CONTRACTOR SHALL REMOVE AND DISPOSE OF ALL THE EXISTING SAND IN EXISTING PLAY AREA.

*** NOTE: IF CONTRACTOR DECIDES TO SUBSTITUTE THE SPECIFIED "POURED-IN-PLACE" RUBBER SURFACE, HE/SHE WILL NEED TO ADDRESS CRITICAL HEIGHTS AND MANUFACTURER'S RATINGS FOR PROPOSED SURFACES REGARDING REQUIRED THICKNESS.**

NOTE: WHERE DOWELING IS SPECIFIED, USE 150mm. LONG SMOOTH DOWELS @ 600mm. O.C. (REFER TO CITY STD.)

SECTION D-D
N.T.S.
RECORD DRAWING
DATE: JULY 2002 BY: JENN.

Vista Lago

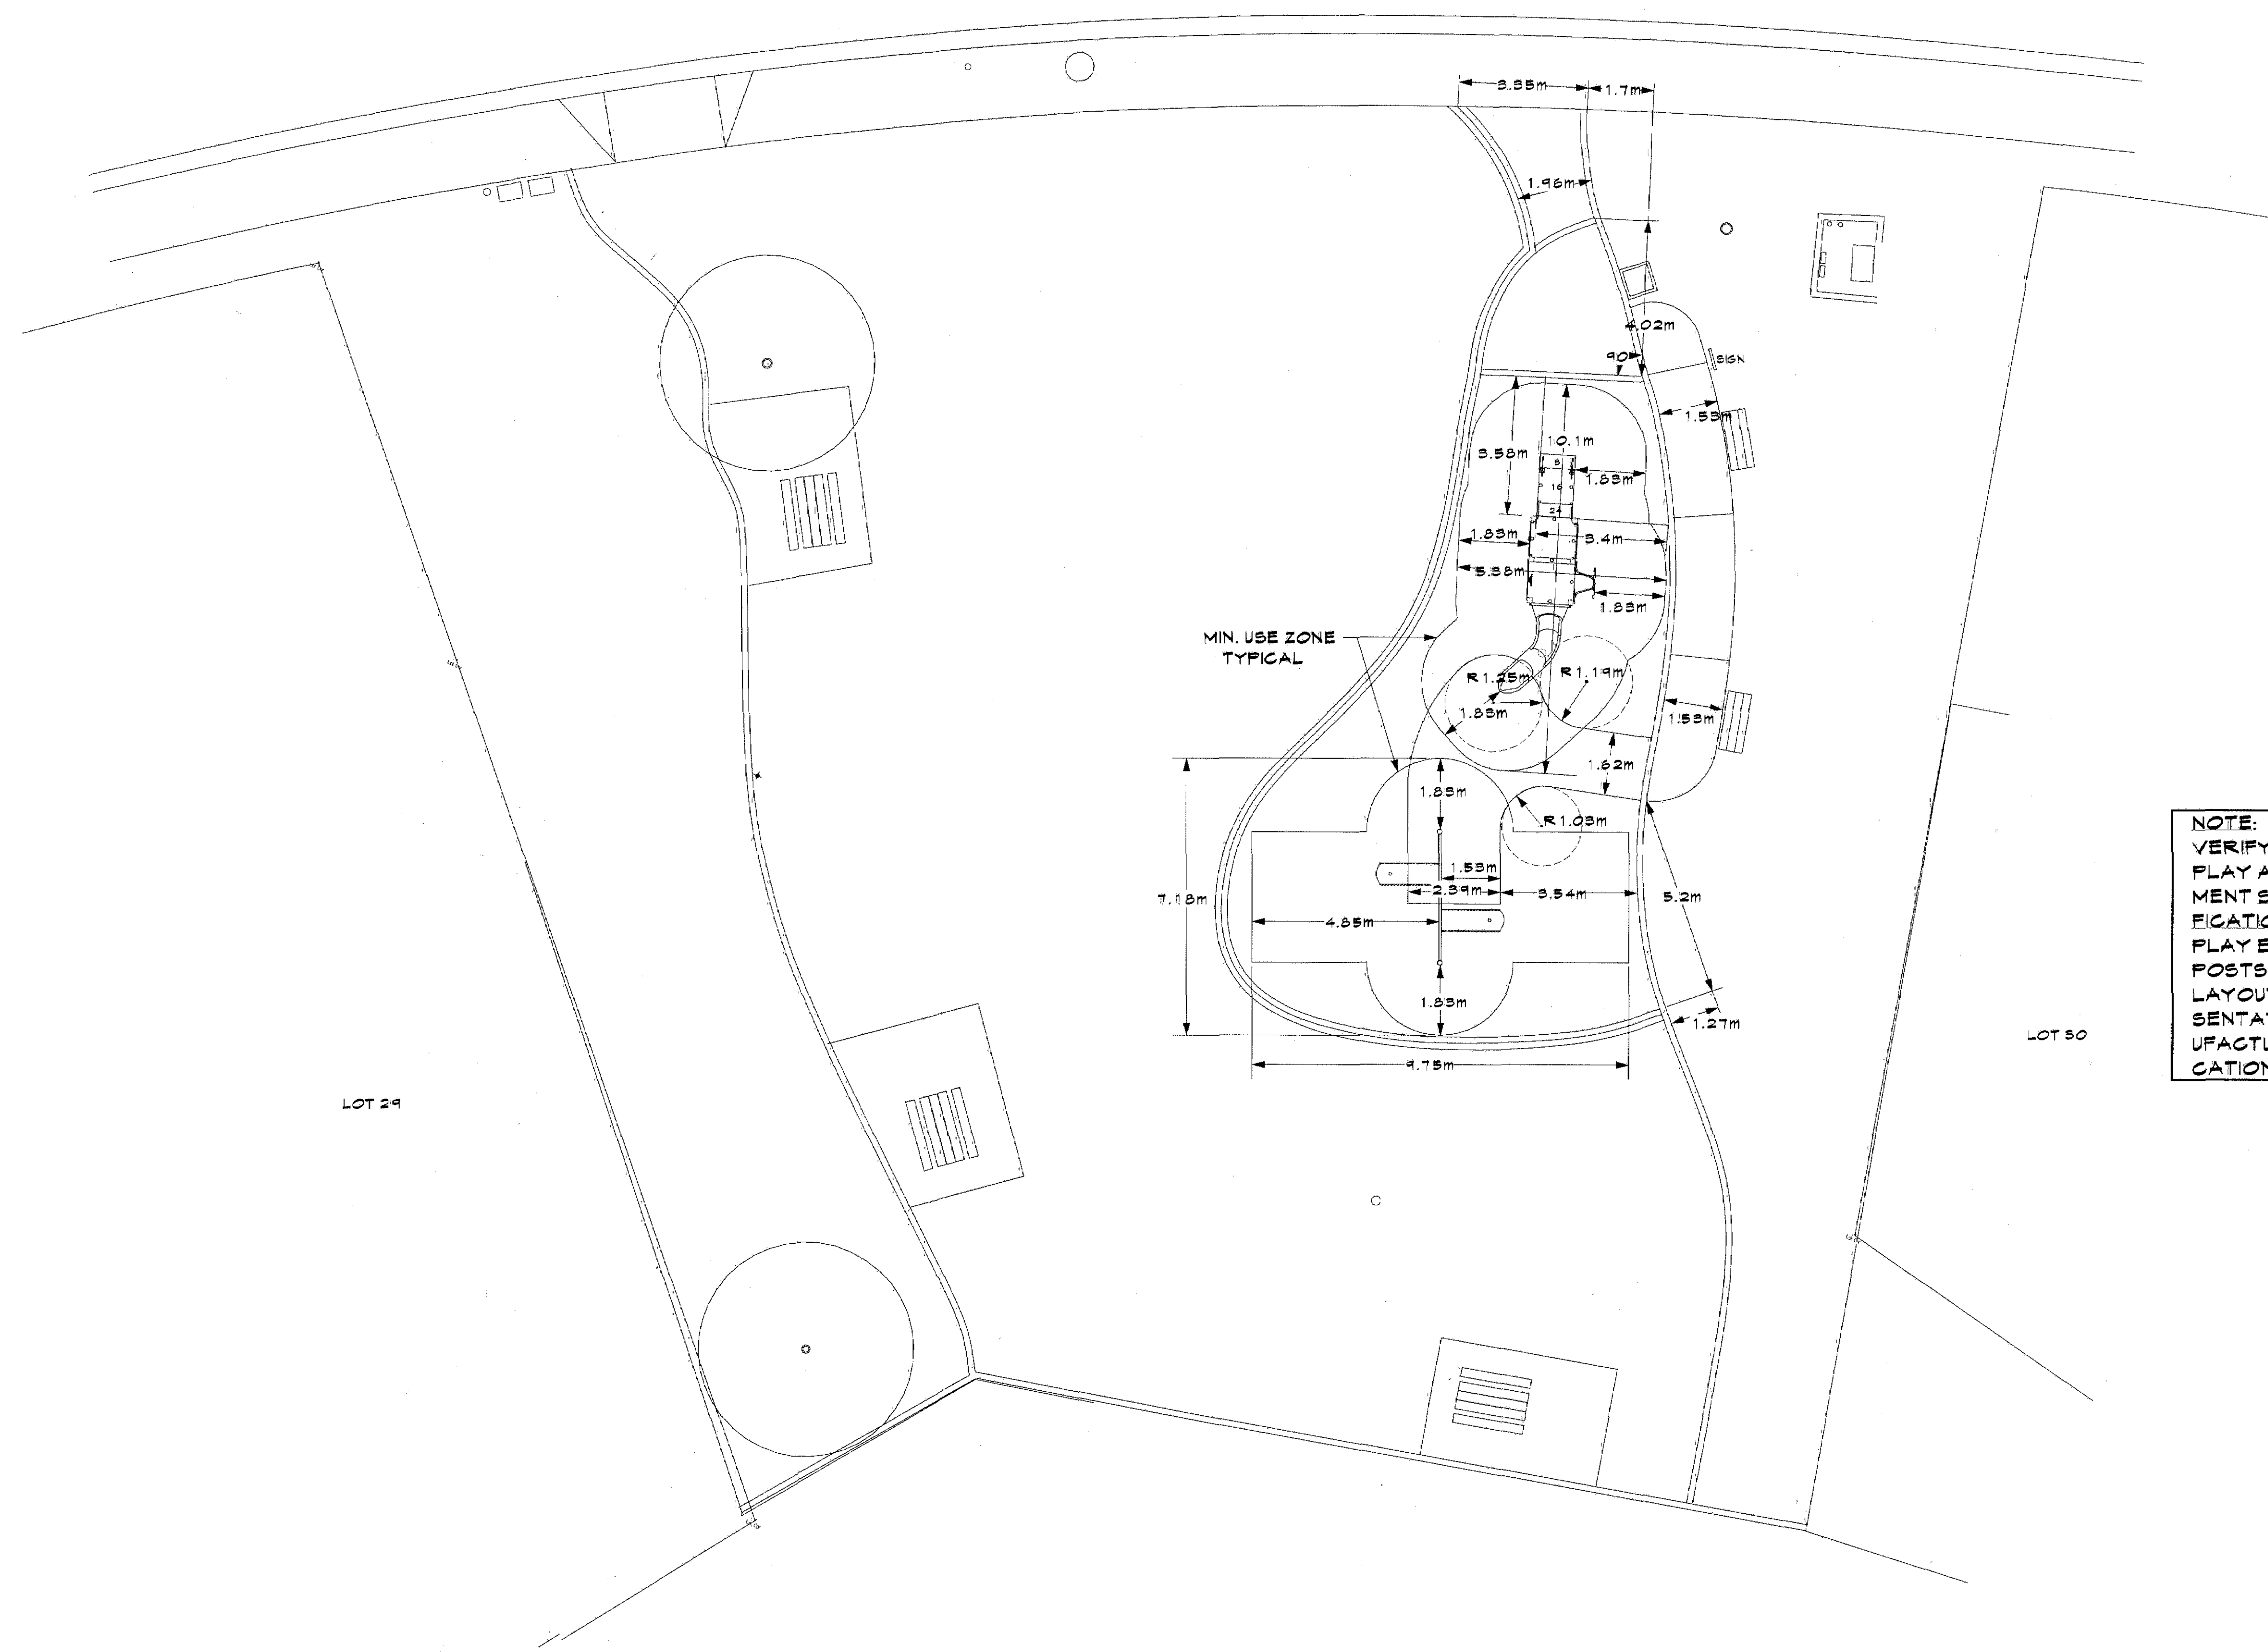

LOT 24

LOT 50



CITY OF
san luis obispo


REVISIONS: 4-4-00
Record Drawing
Graphic Scale: 1:100

PROJECT TITLE:
VISTA LAGO PARK

SHEET TITLE:
DIMENSION PLAN

DESIGNED BY: SPC
DRAWN BY: SPC
CHECKED BY: 80F
APPROVED BY: 80F
DATE: 1-25-2000
CITY SPECIFICATION NO. 90095
SHEET NO. **L-2**

Vista Lago

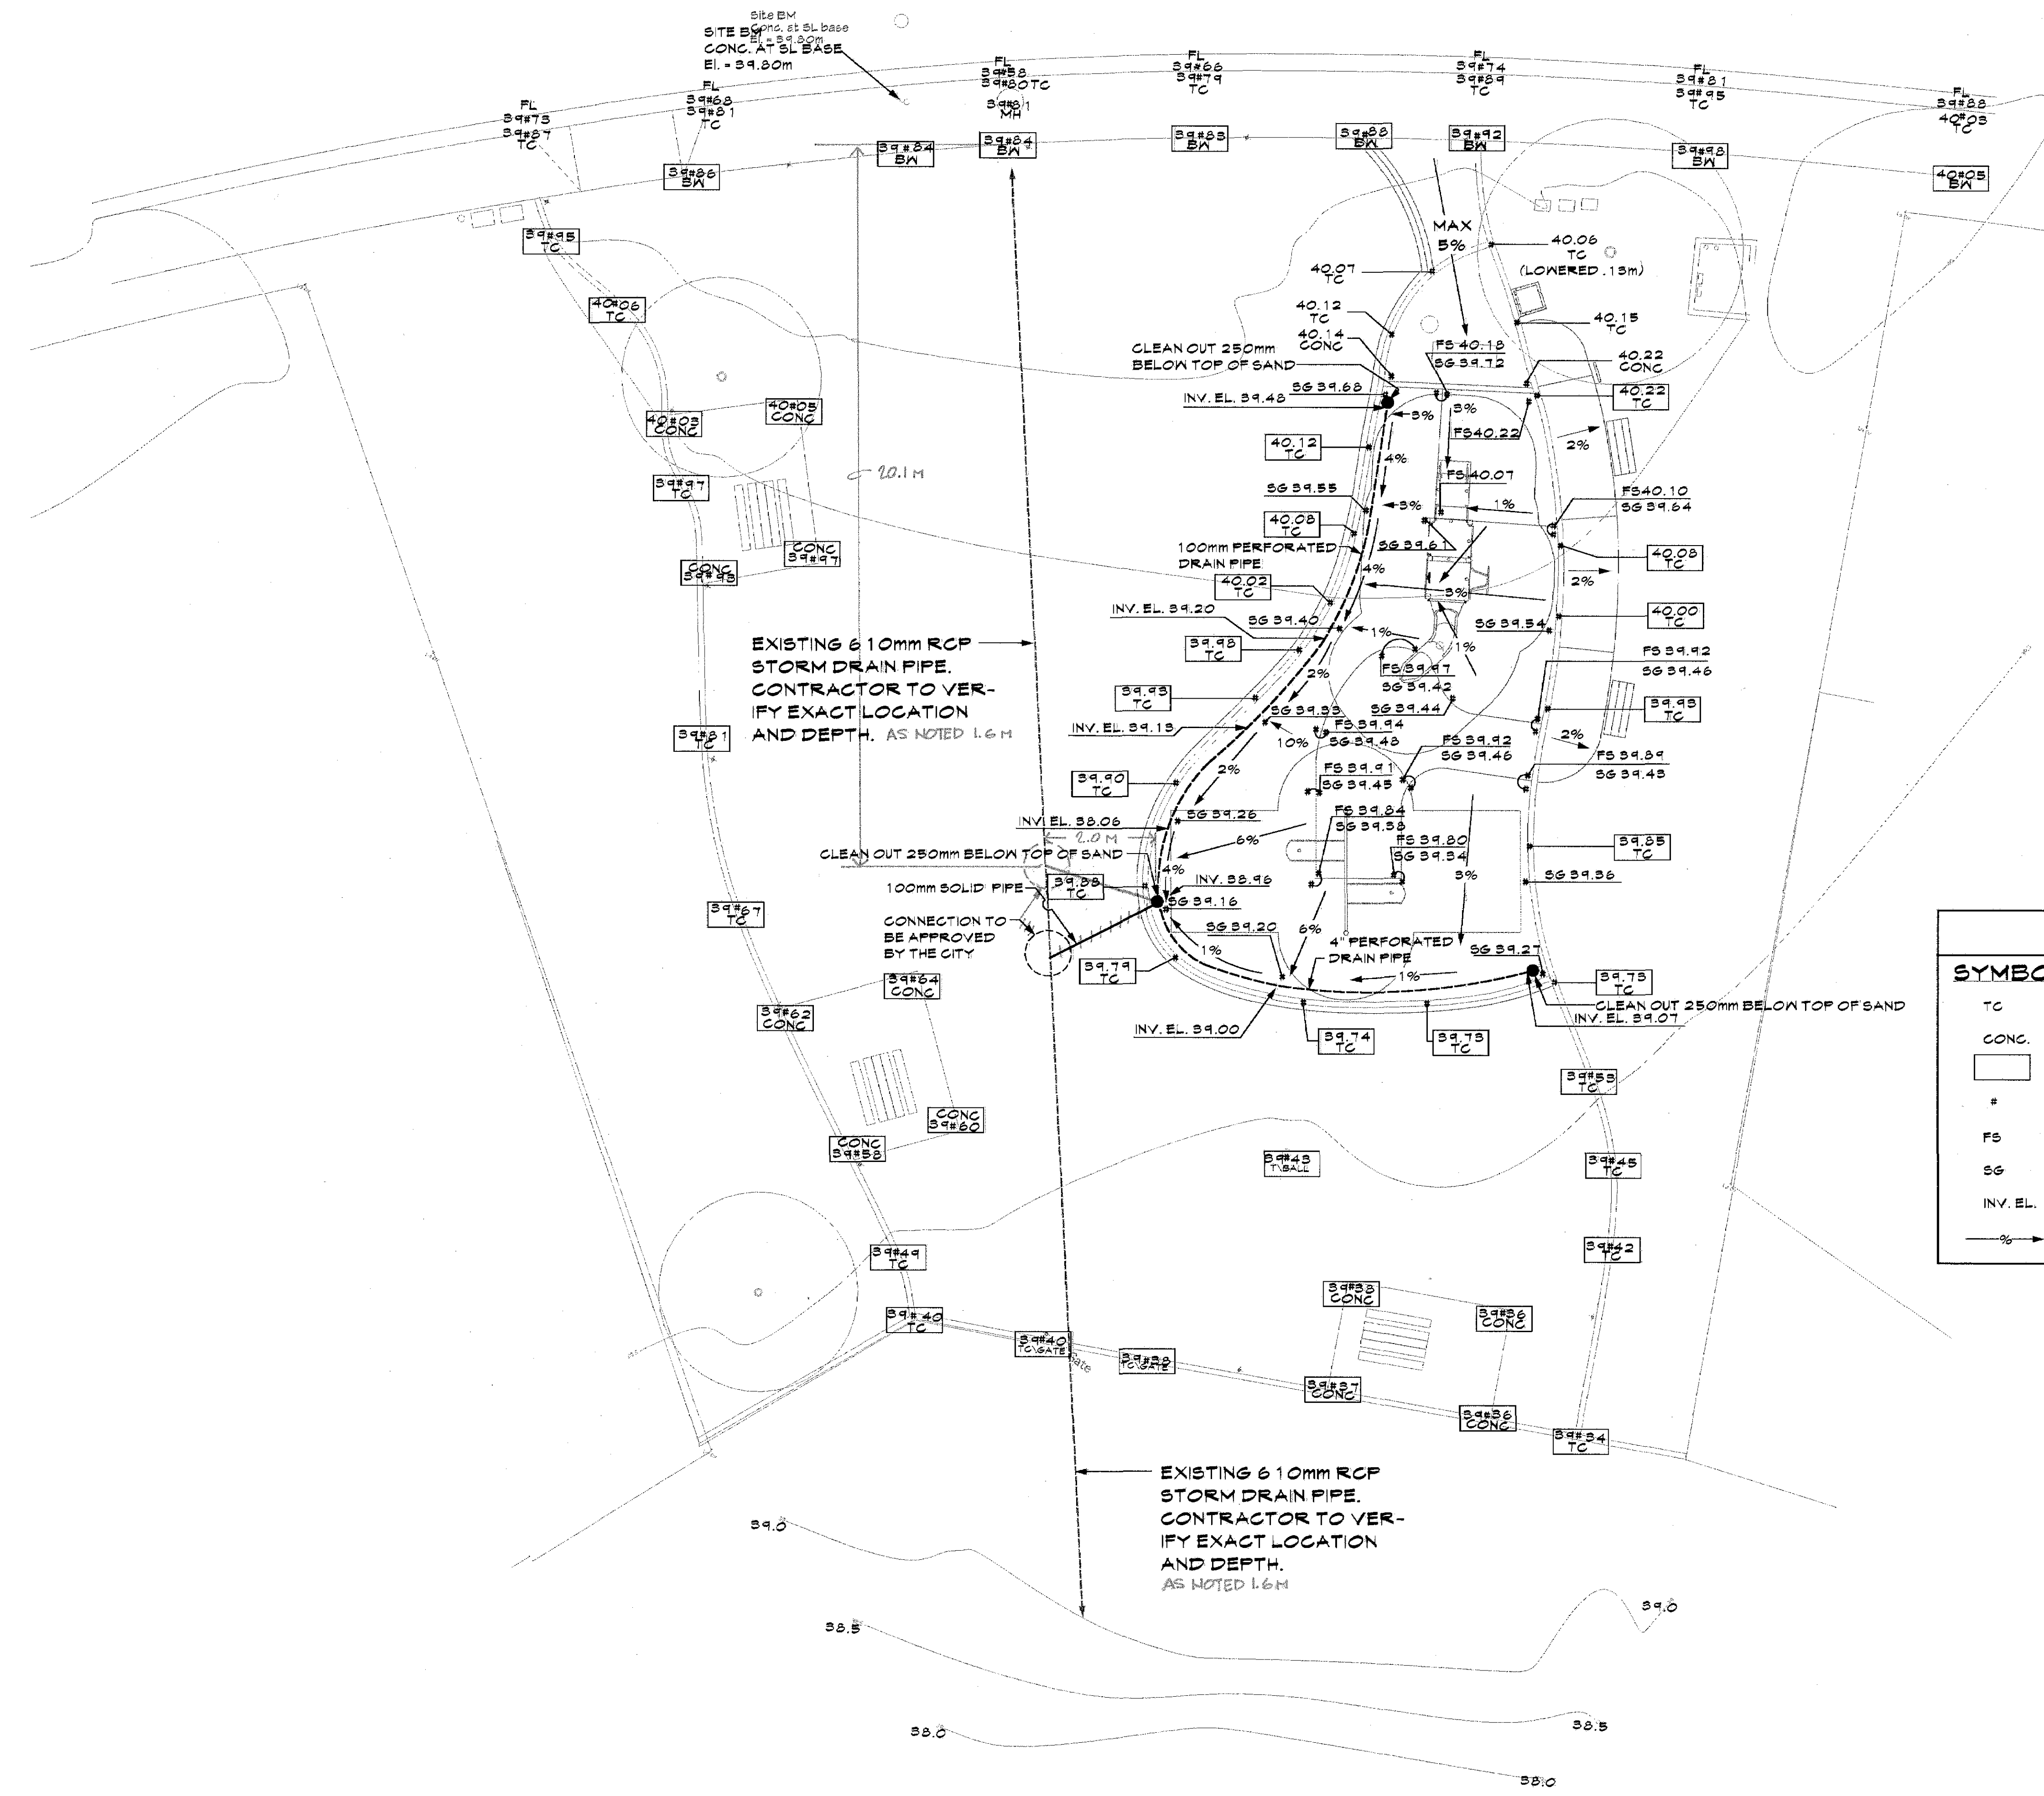


LEGEND	
SYMBOL	DESCRIPTION
TC	TOP OF CURB
CONC.	TOP OF CONCRETE
□	EX. ELEVATIONS
*	POINT
FS	NEW FINISH SURFACE
SG	NEW SUB-GRADE
INV. EL.	PIPE INVERTED ELEV.
—%→	DIRECTION OF SLOPE (% INDICATED)

DESIGNED BY:	SPC
DRAWN BY:	SPC
CHECKED BY:	80F
APPROVED BY:	80F
DATE:	1-25-2000
CITY SPECIFICATION NO.	90085
SHEET NO.	L-3

RECORD DRAWING
DATE: JULY 2001 BY: JBNN.



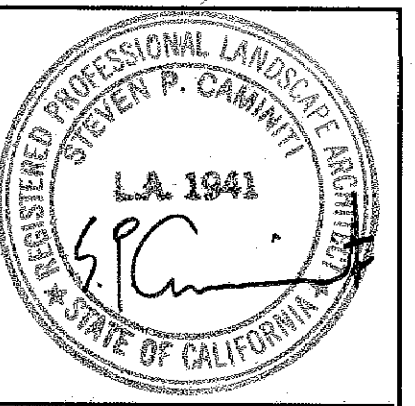


CITY of
san luis obispo

REVISIONS: 4-4-00
Record Drawing
Graphic scale: 1:100
M

PROJECT TITLE: VISTA LAGO PARK
SHEET TITLE: PLANTING & IRRIGATION PLAN
DESIGNED BY: SPC
DRAWN BY: SPC
CHECKED BY: BOF
APPROVED BY: BOF
DATE: 1-25-2000
CITY SPECIFICATION NO. 90095
SHEET NO. L-4

Vista Lago

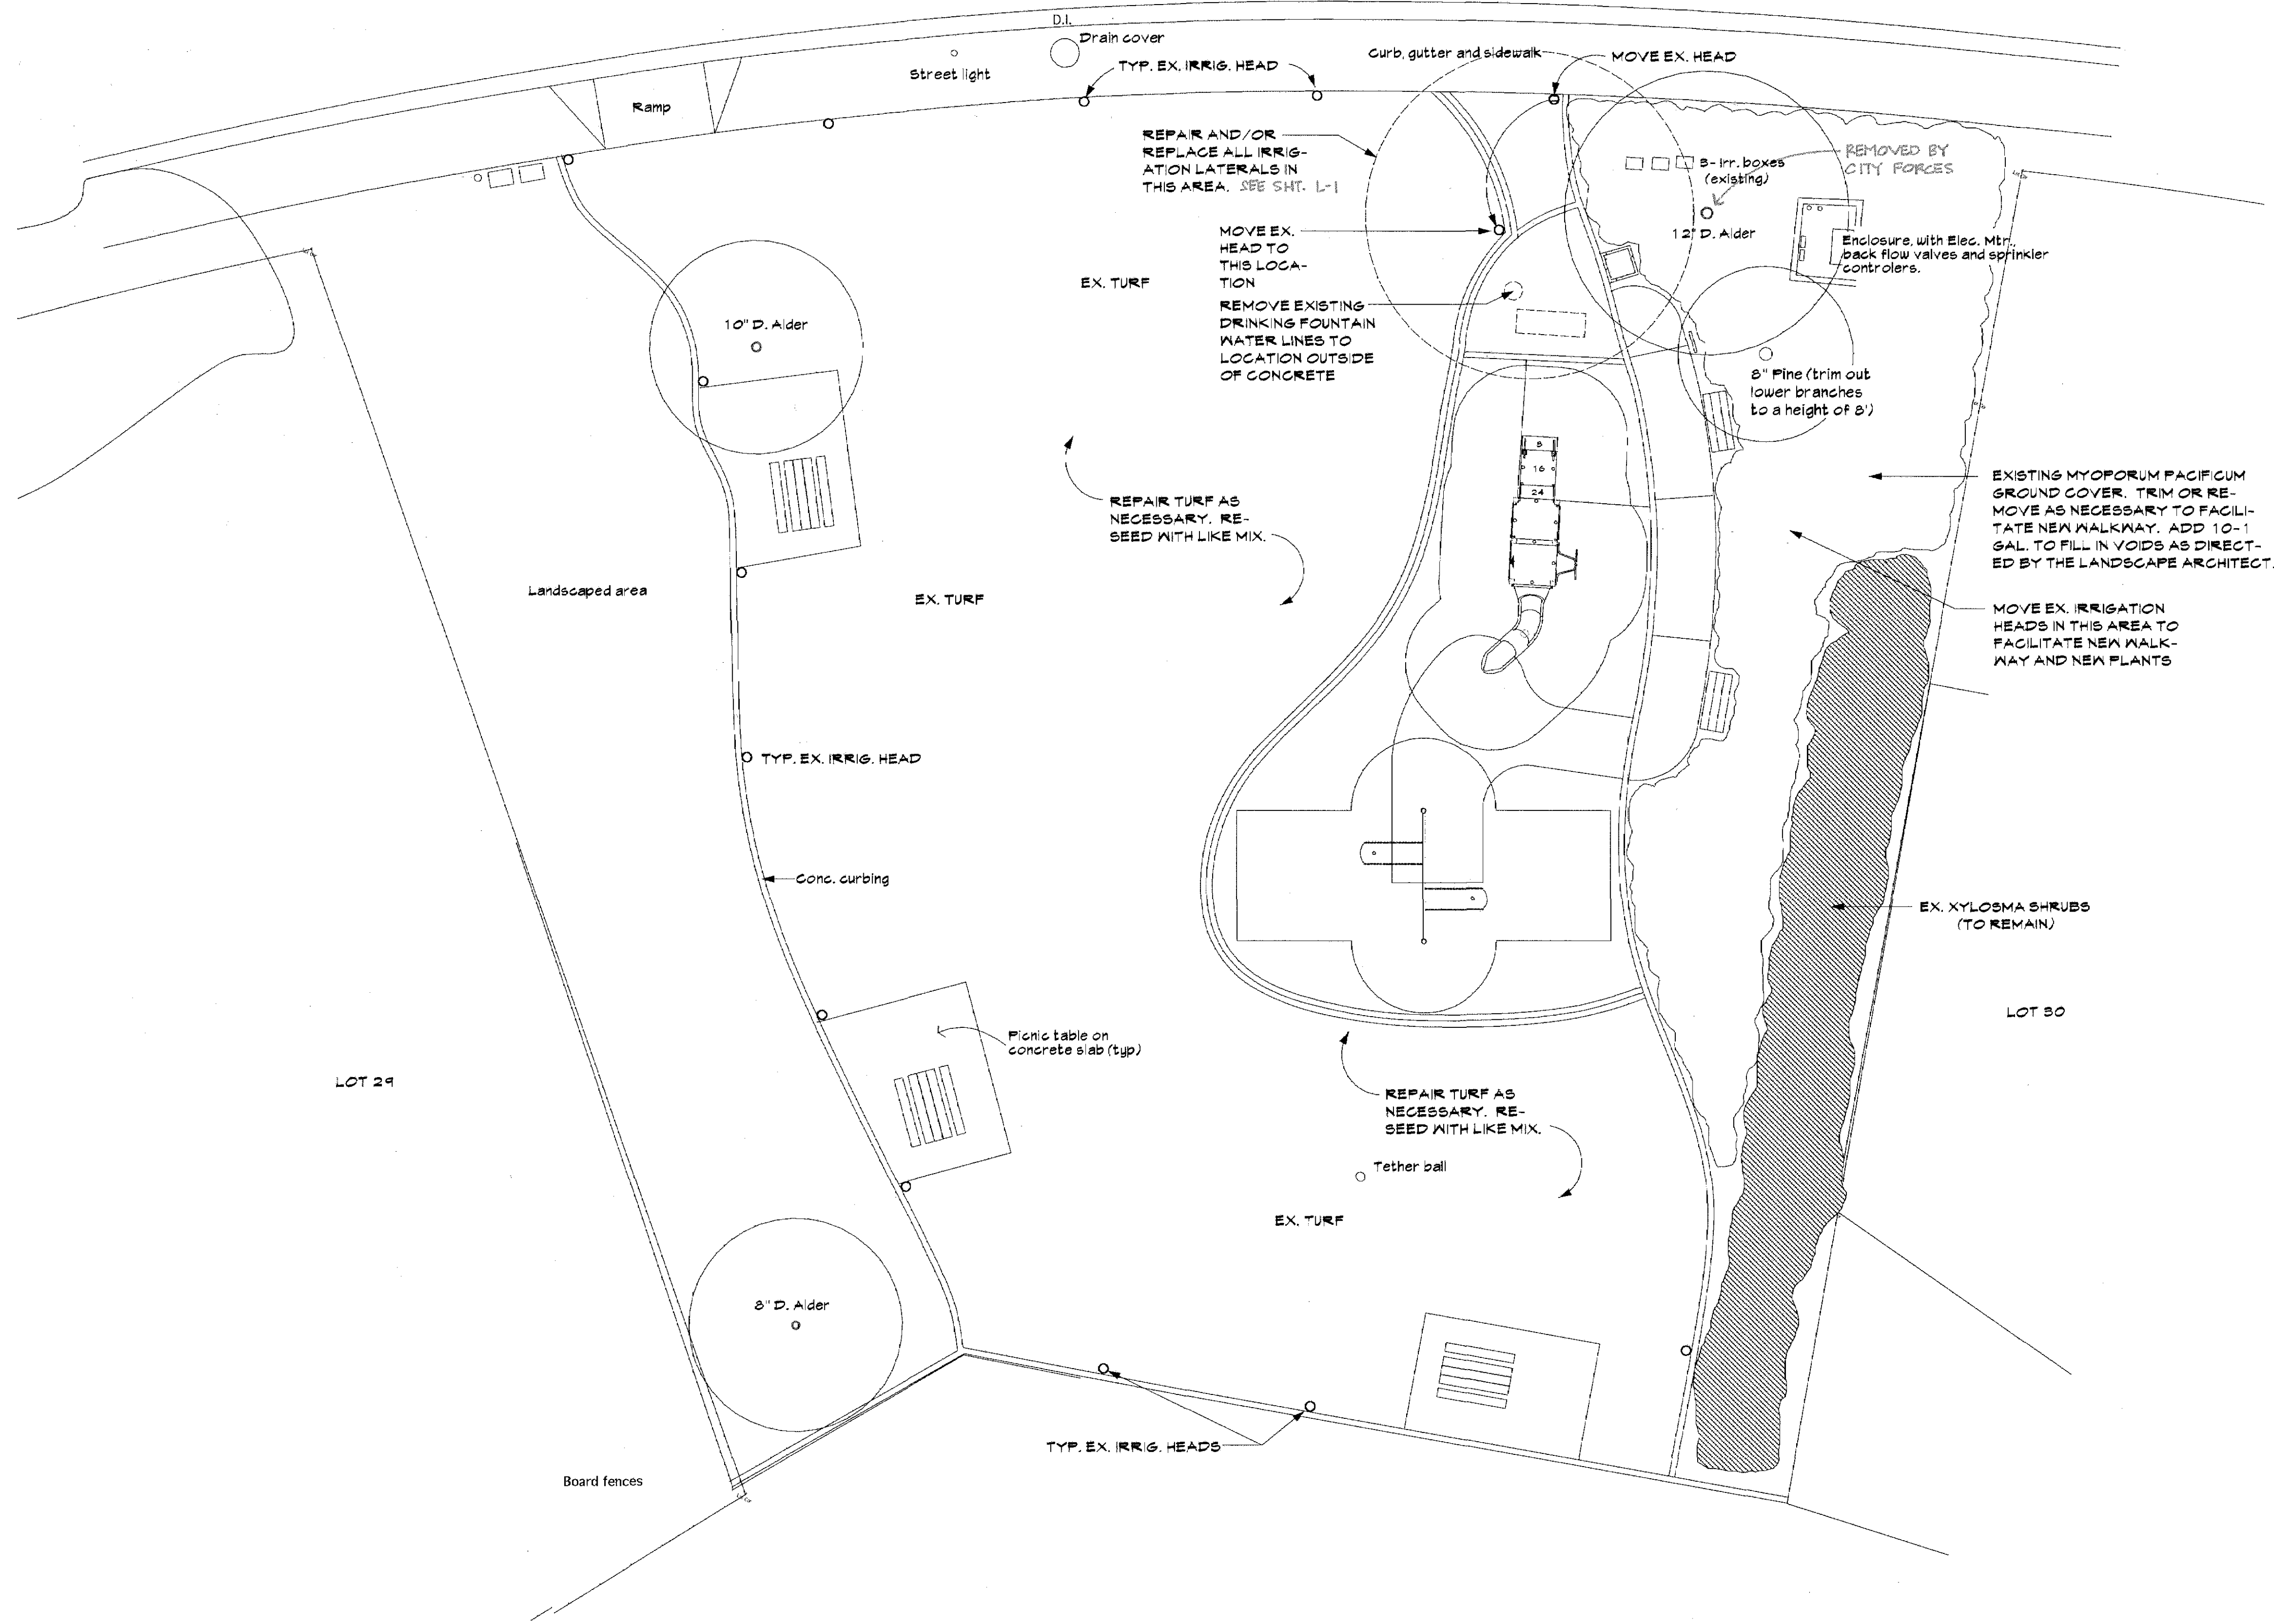

RECORD DRAWING
DATE: JULY 2002 BY: JENN.